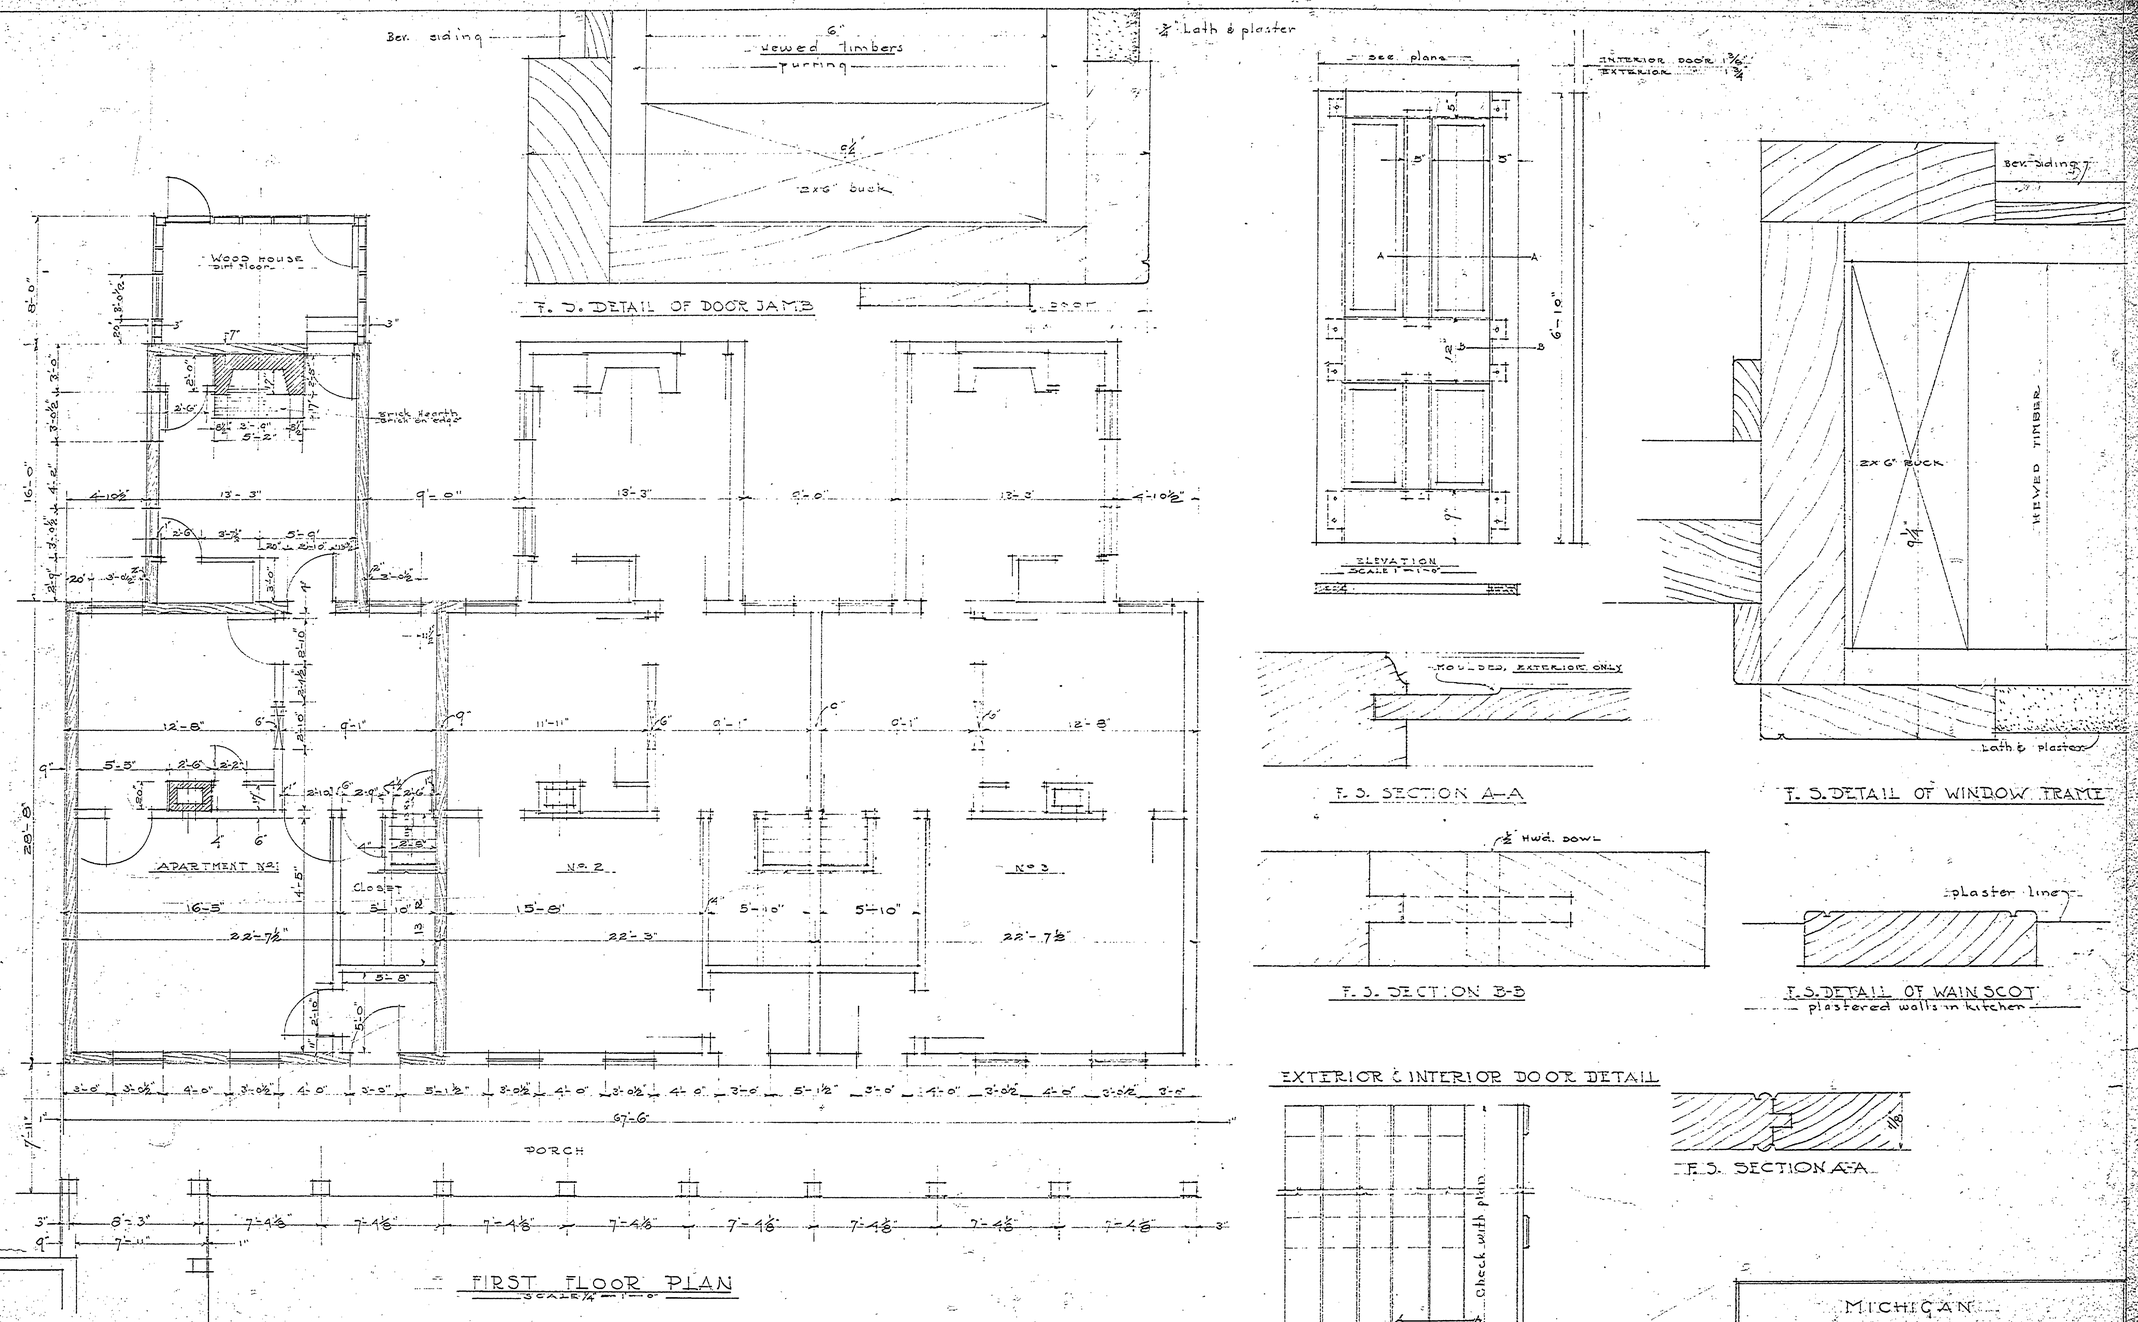

NOTE: Exterior walls & division walls shown
Hewed timbers 6" x 10 to 12" dovetailed at corners
Furring both sides with wood lath & plaster inside
All interior trim set on furring strips with lath & plaster butted into trim

INSURANCE No. 14

A-108-e

MICHIGAN
DEPARTMENT OF CONSERVATION
PARKS DIVISION

DRAWN BY C.F.H.	FORT WILKINS	PLAN No. 4 sheet no. 2 of 7
TRACED BY	MEASURED DRAWINGS FAMILY LIVING QUARTERS FOR OFFICERS	SCALE
		DATE
APPROVED BY		DATE
APPROVED BY	DIRECTOR, PARKS DIVISION	DATE