




SECTION A-A
SCALE 1/4" = 1'-0"

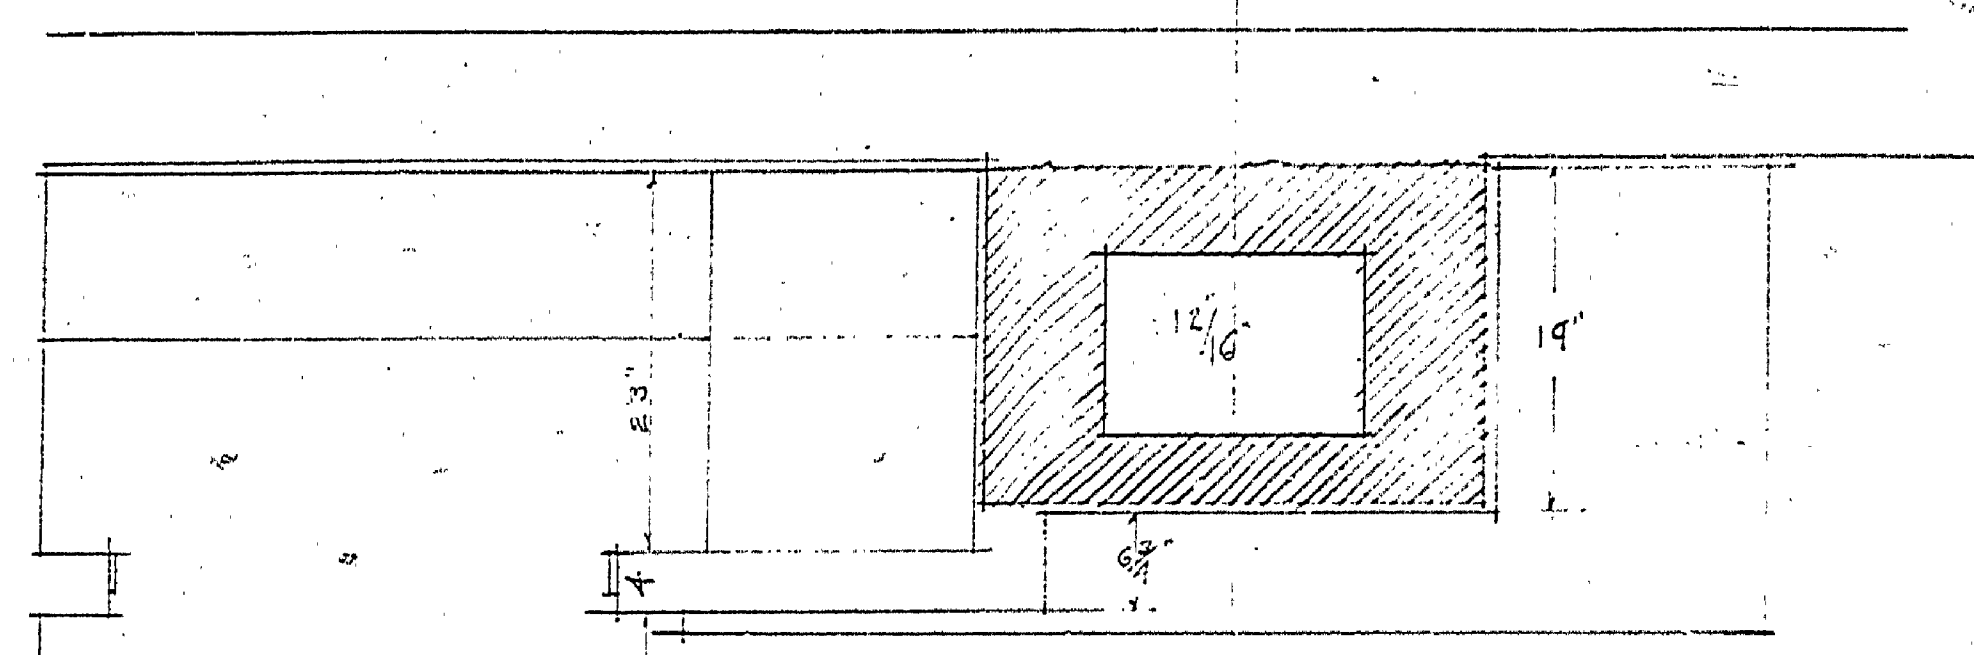


SECTION B-B
SCALE 1/4" = 1'-0"

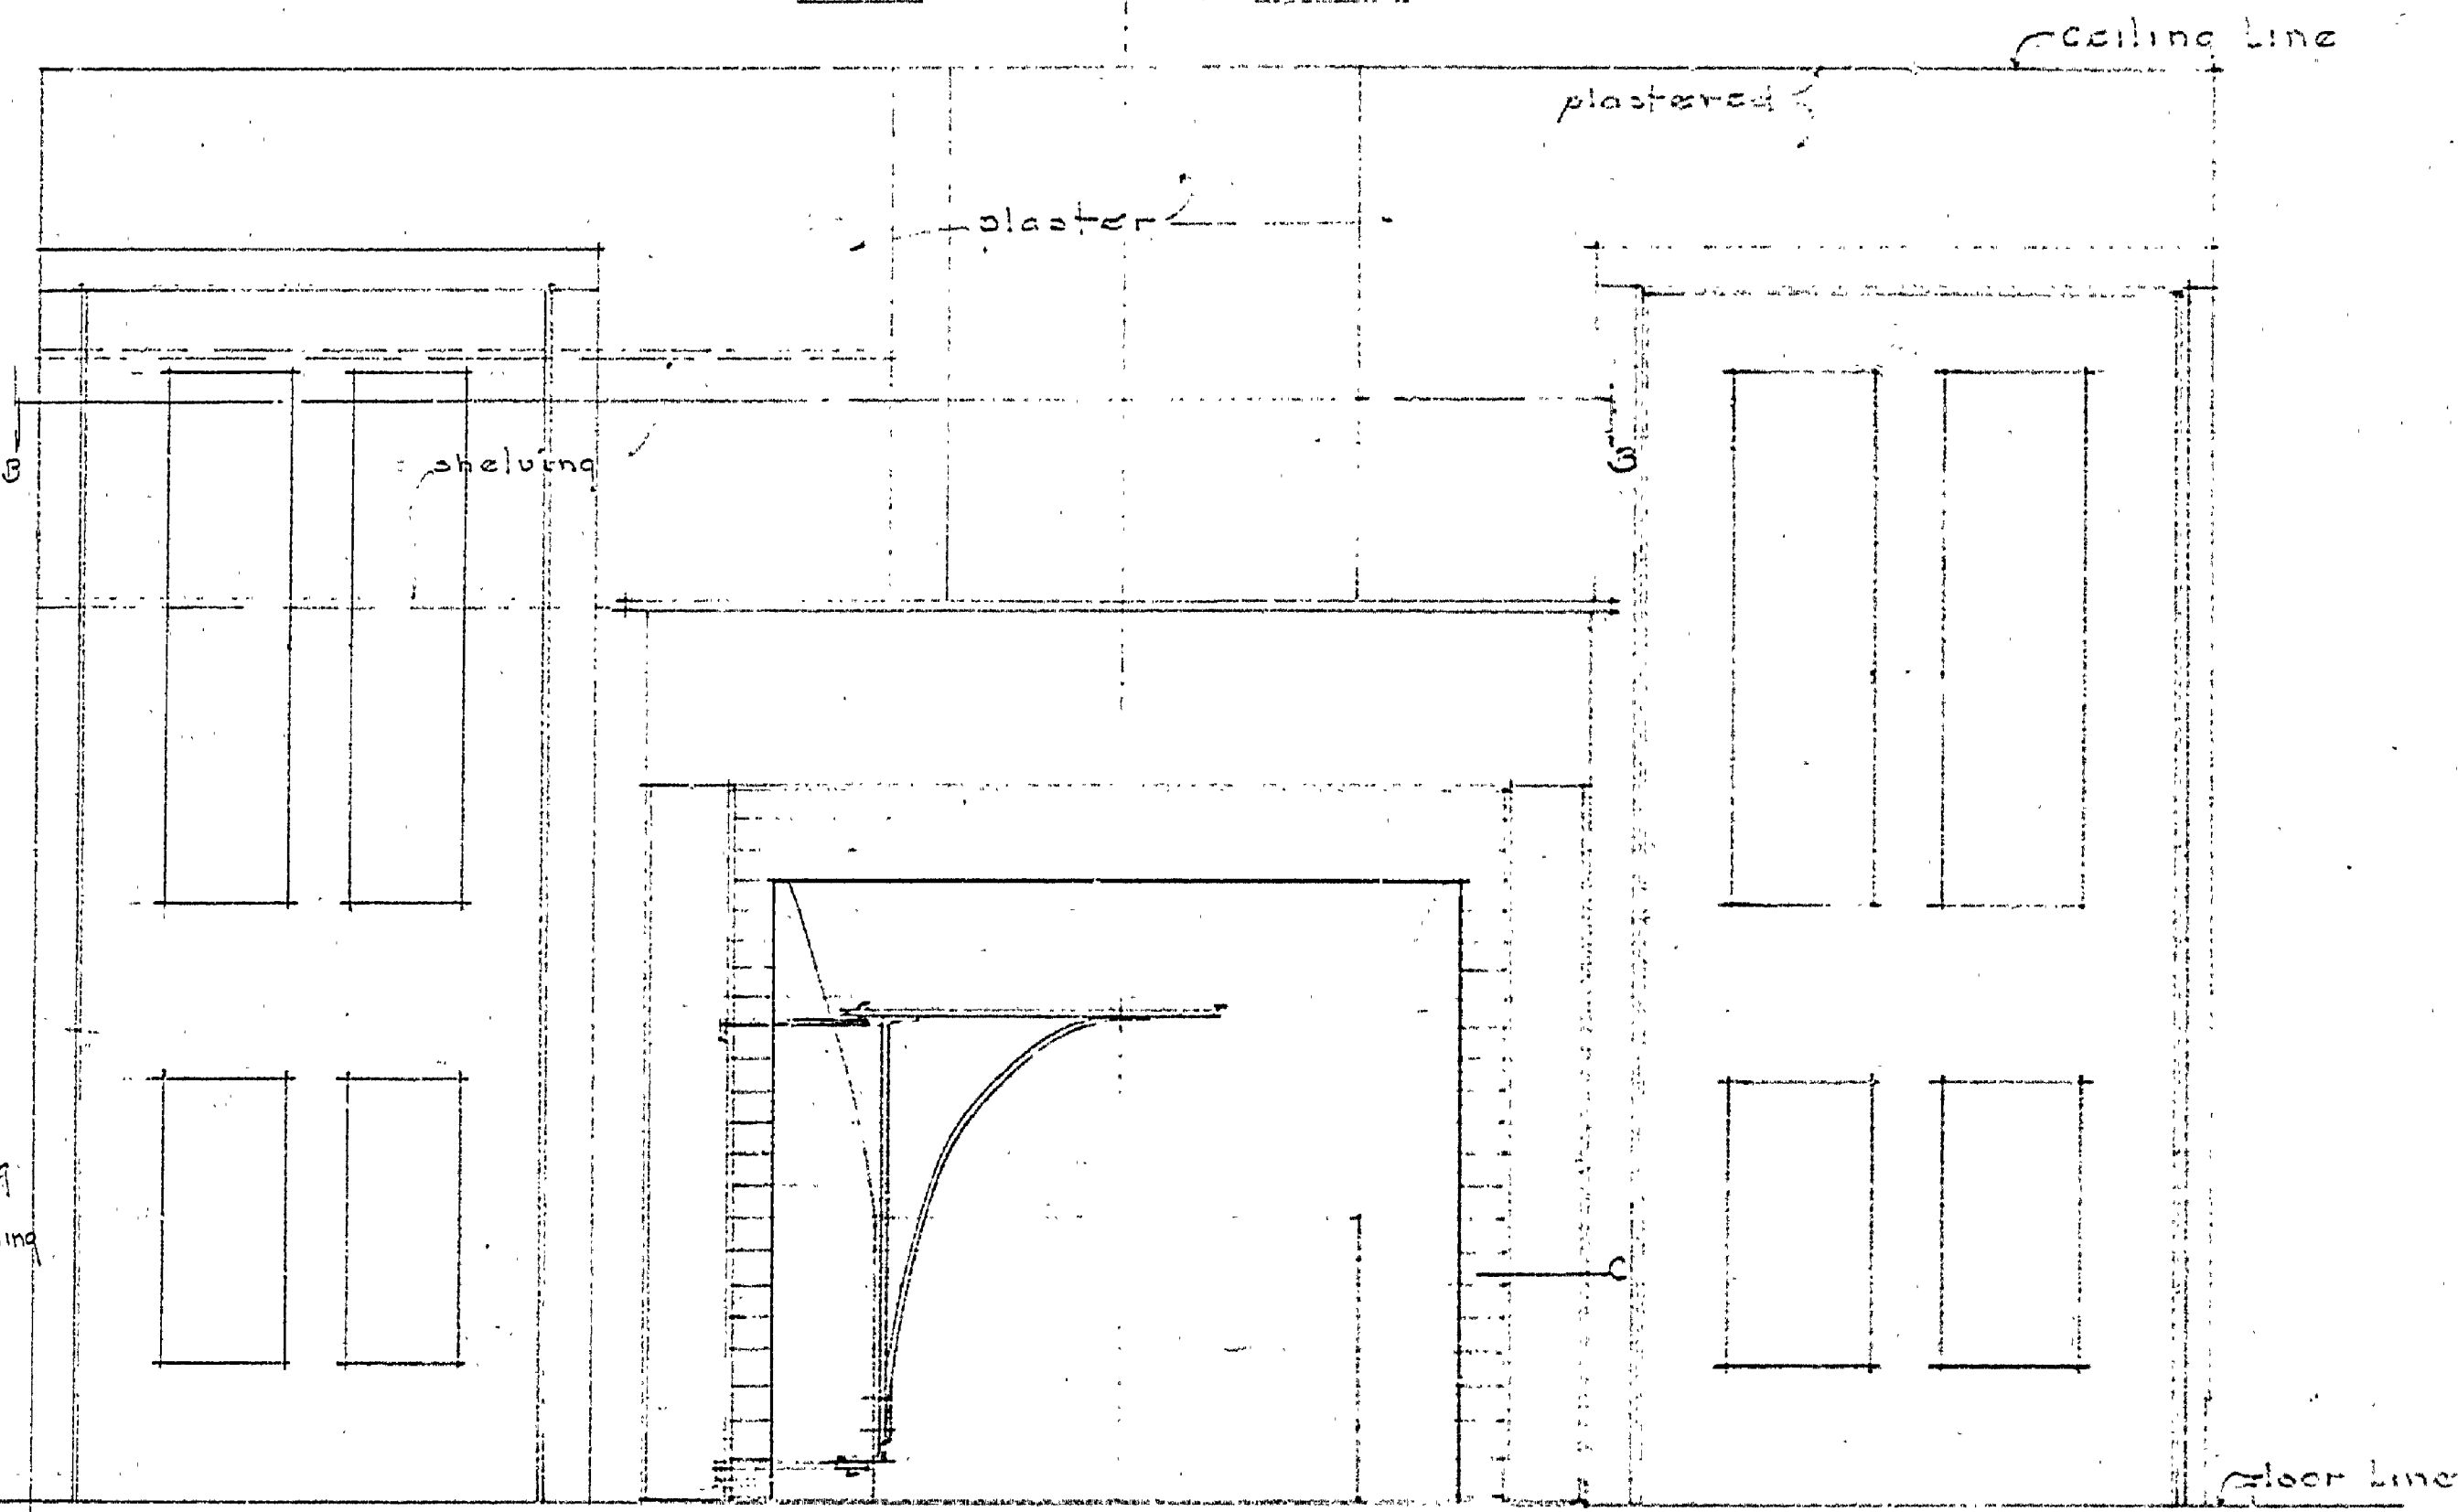


ELEVATION
SCALE 1/4" = 1'-0"

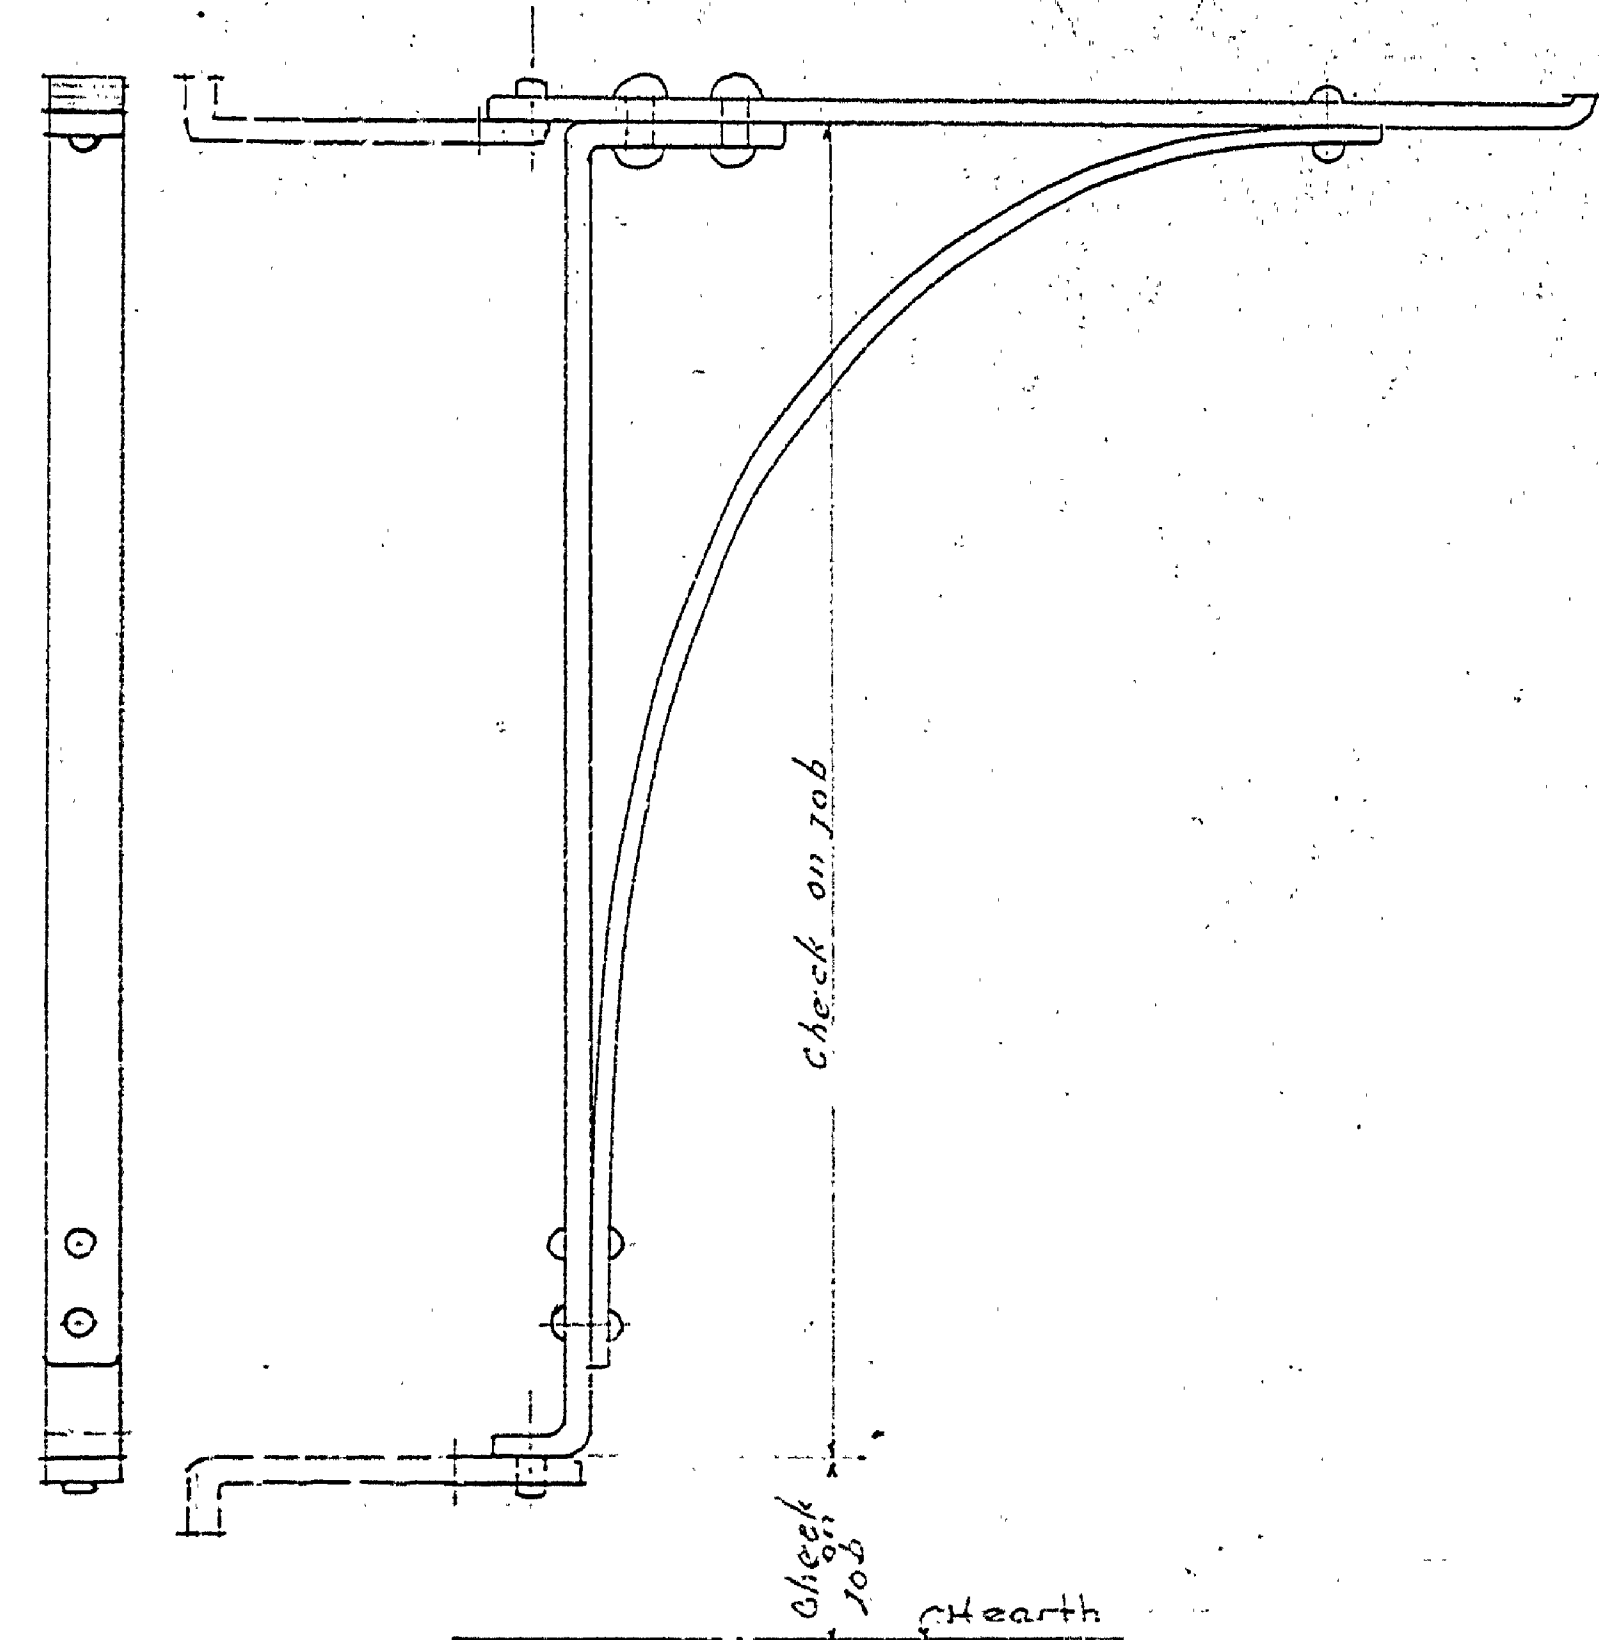

DETAIL OF CRANE
SCALE 3/4" = 1'-0"

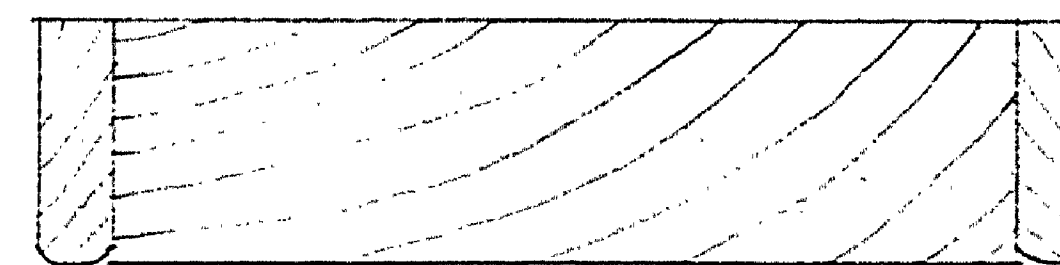

SECTION C
SCALE 3/4" = 1'-0"

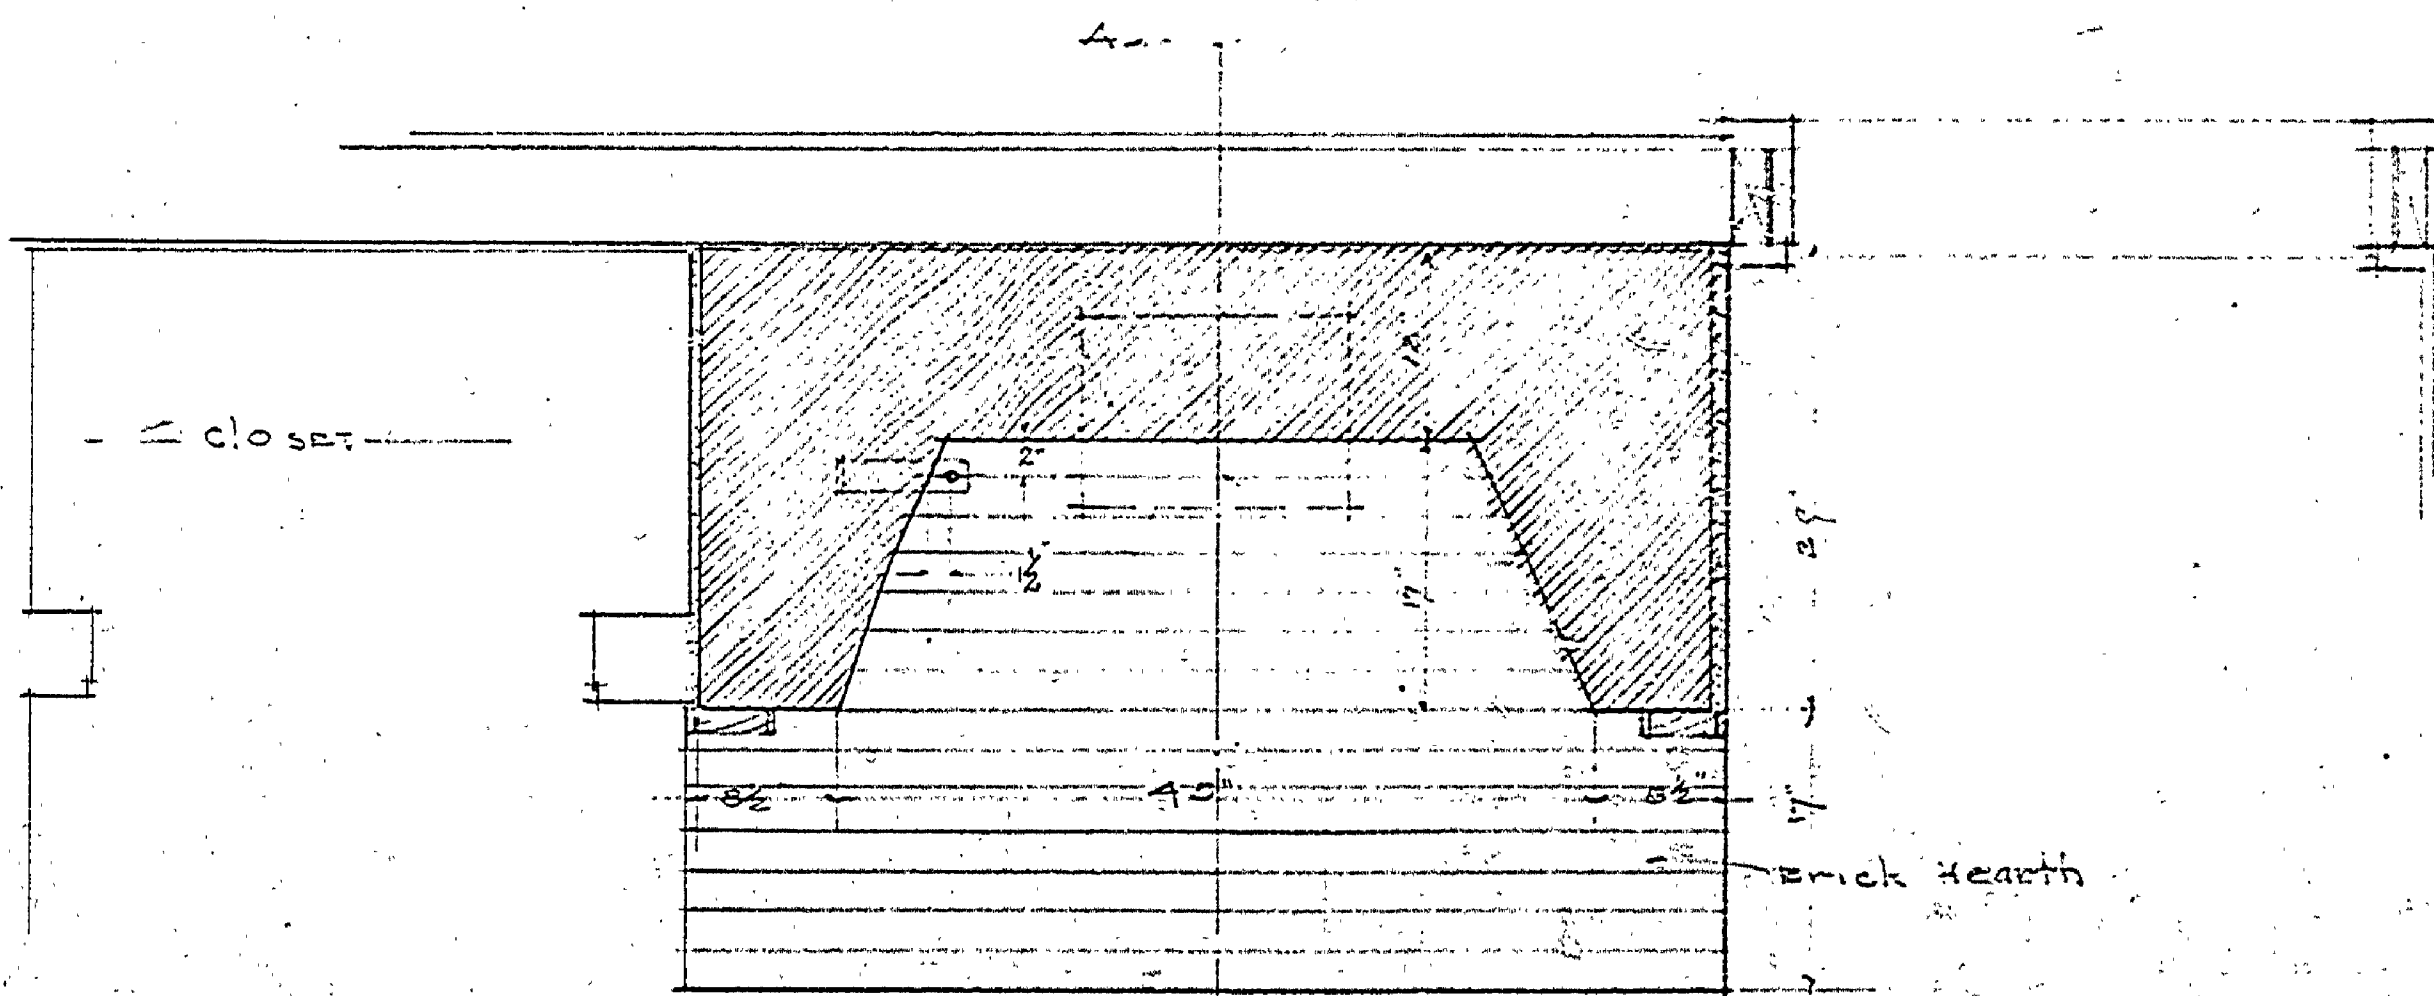

PLAN AT FLOOR
SCALE 1/4" = 1'-0"

MICHIGAN DEPARTMENT OF CONSERVATION PARKS DIVISION		
DRAWN BY C.F.H.	FORT WILKINS MEASURED DRAWINGS TYPICAL DETAILS FIREPLACE	PLAN NO. 4 Sheet No. 7 DATE 3/3/42
CHECKED BY C.F.H.	APPROVED CHIEF OF PARKS DIVISION	DATE

INSURANCE No. 14

A-108-e