




FRONT ELEVATION  
SCALE 1/4" = 1'-0"

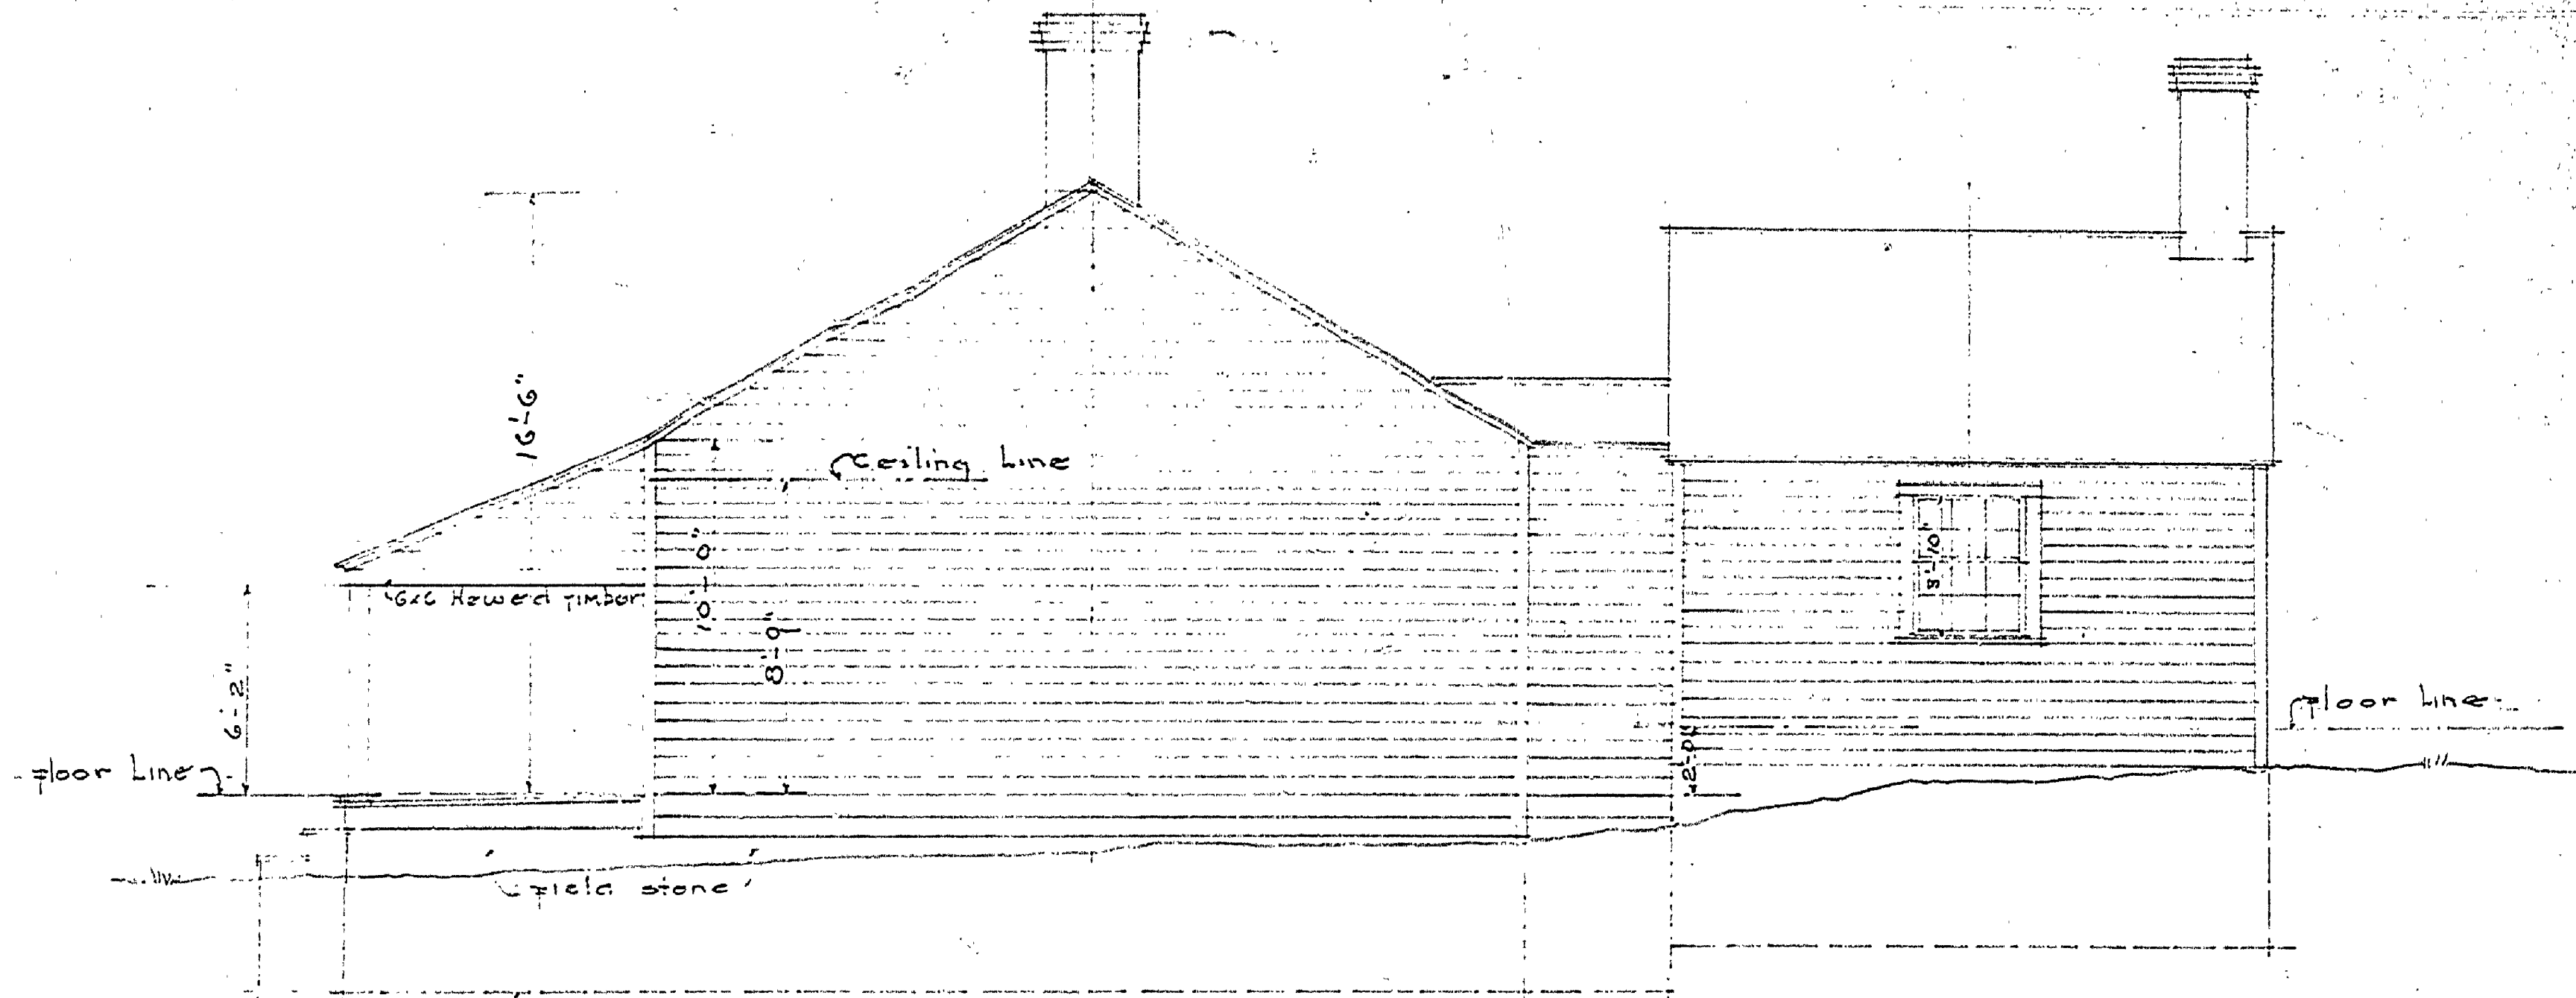


SOUTH ELEVATION  
SCALE 1/4" = 1'-0"  
SIMILAR

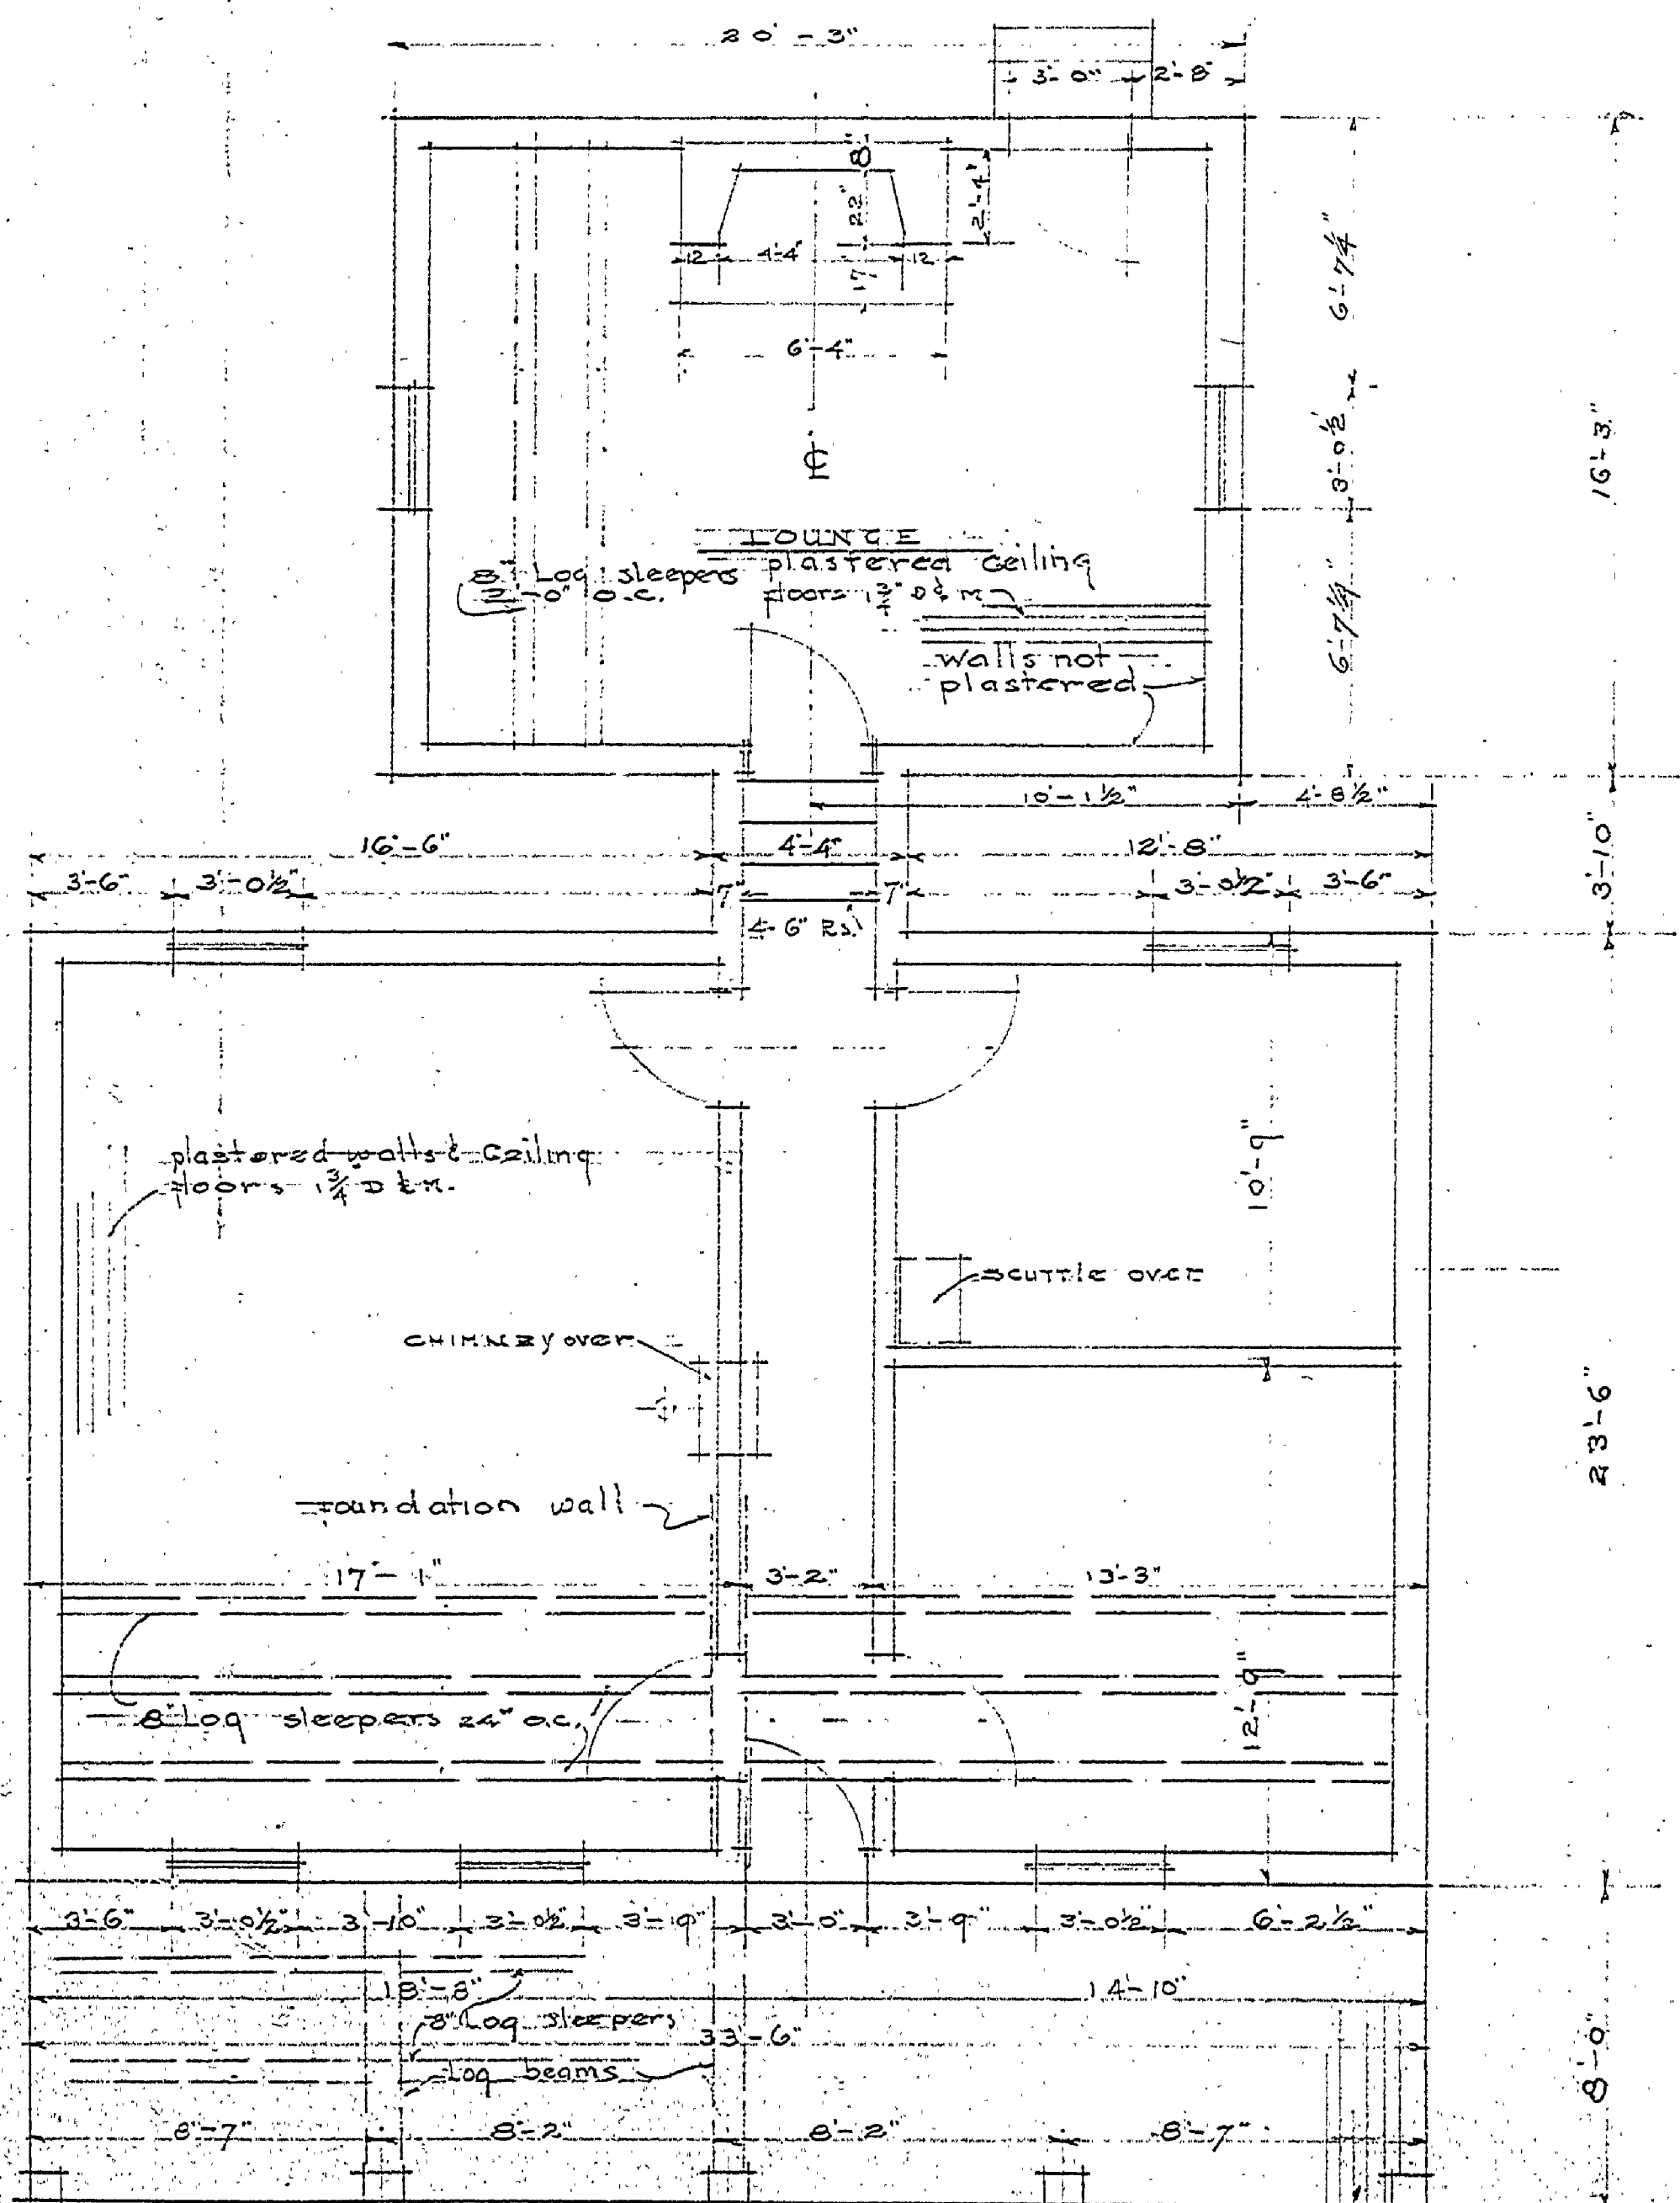

FLOOR PLAN  
SCALE 1/4" = 1'-0"

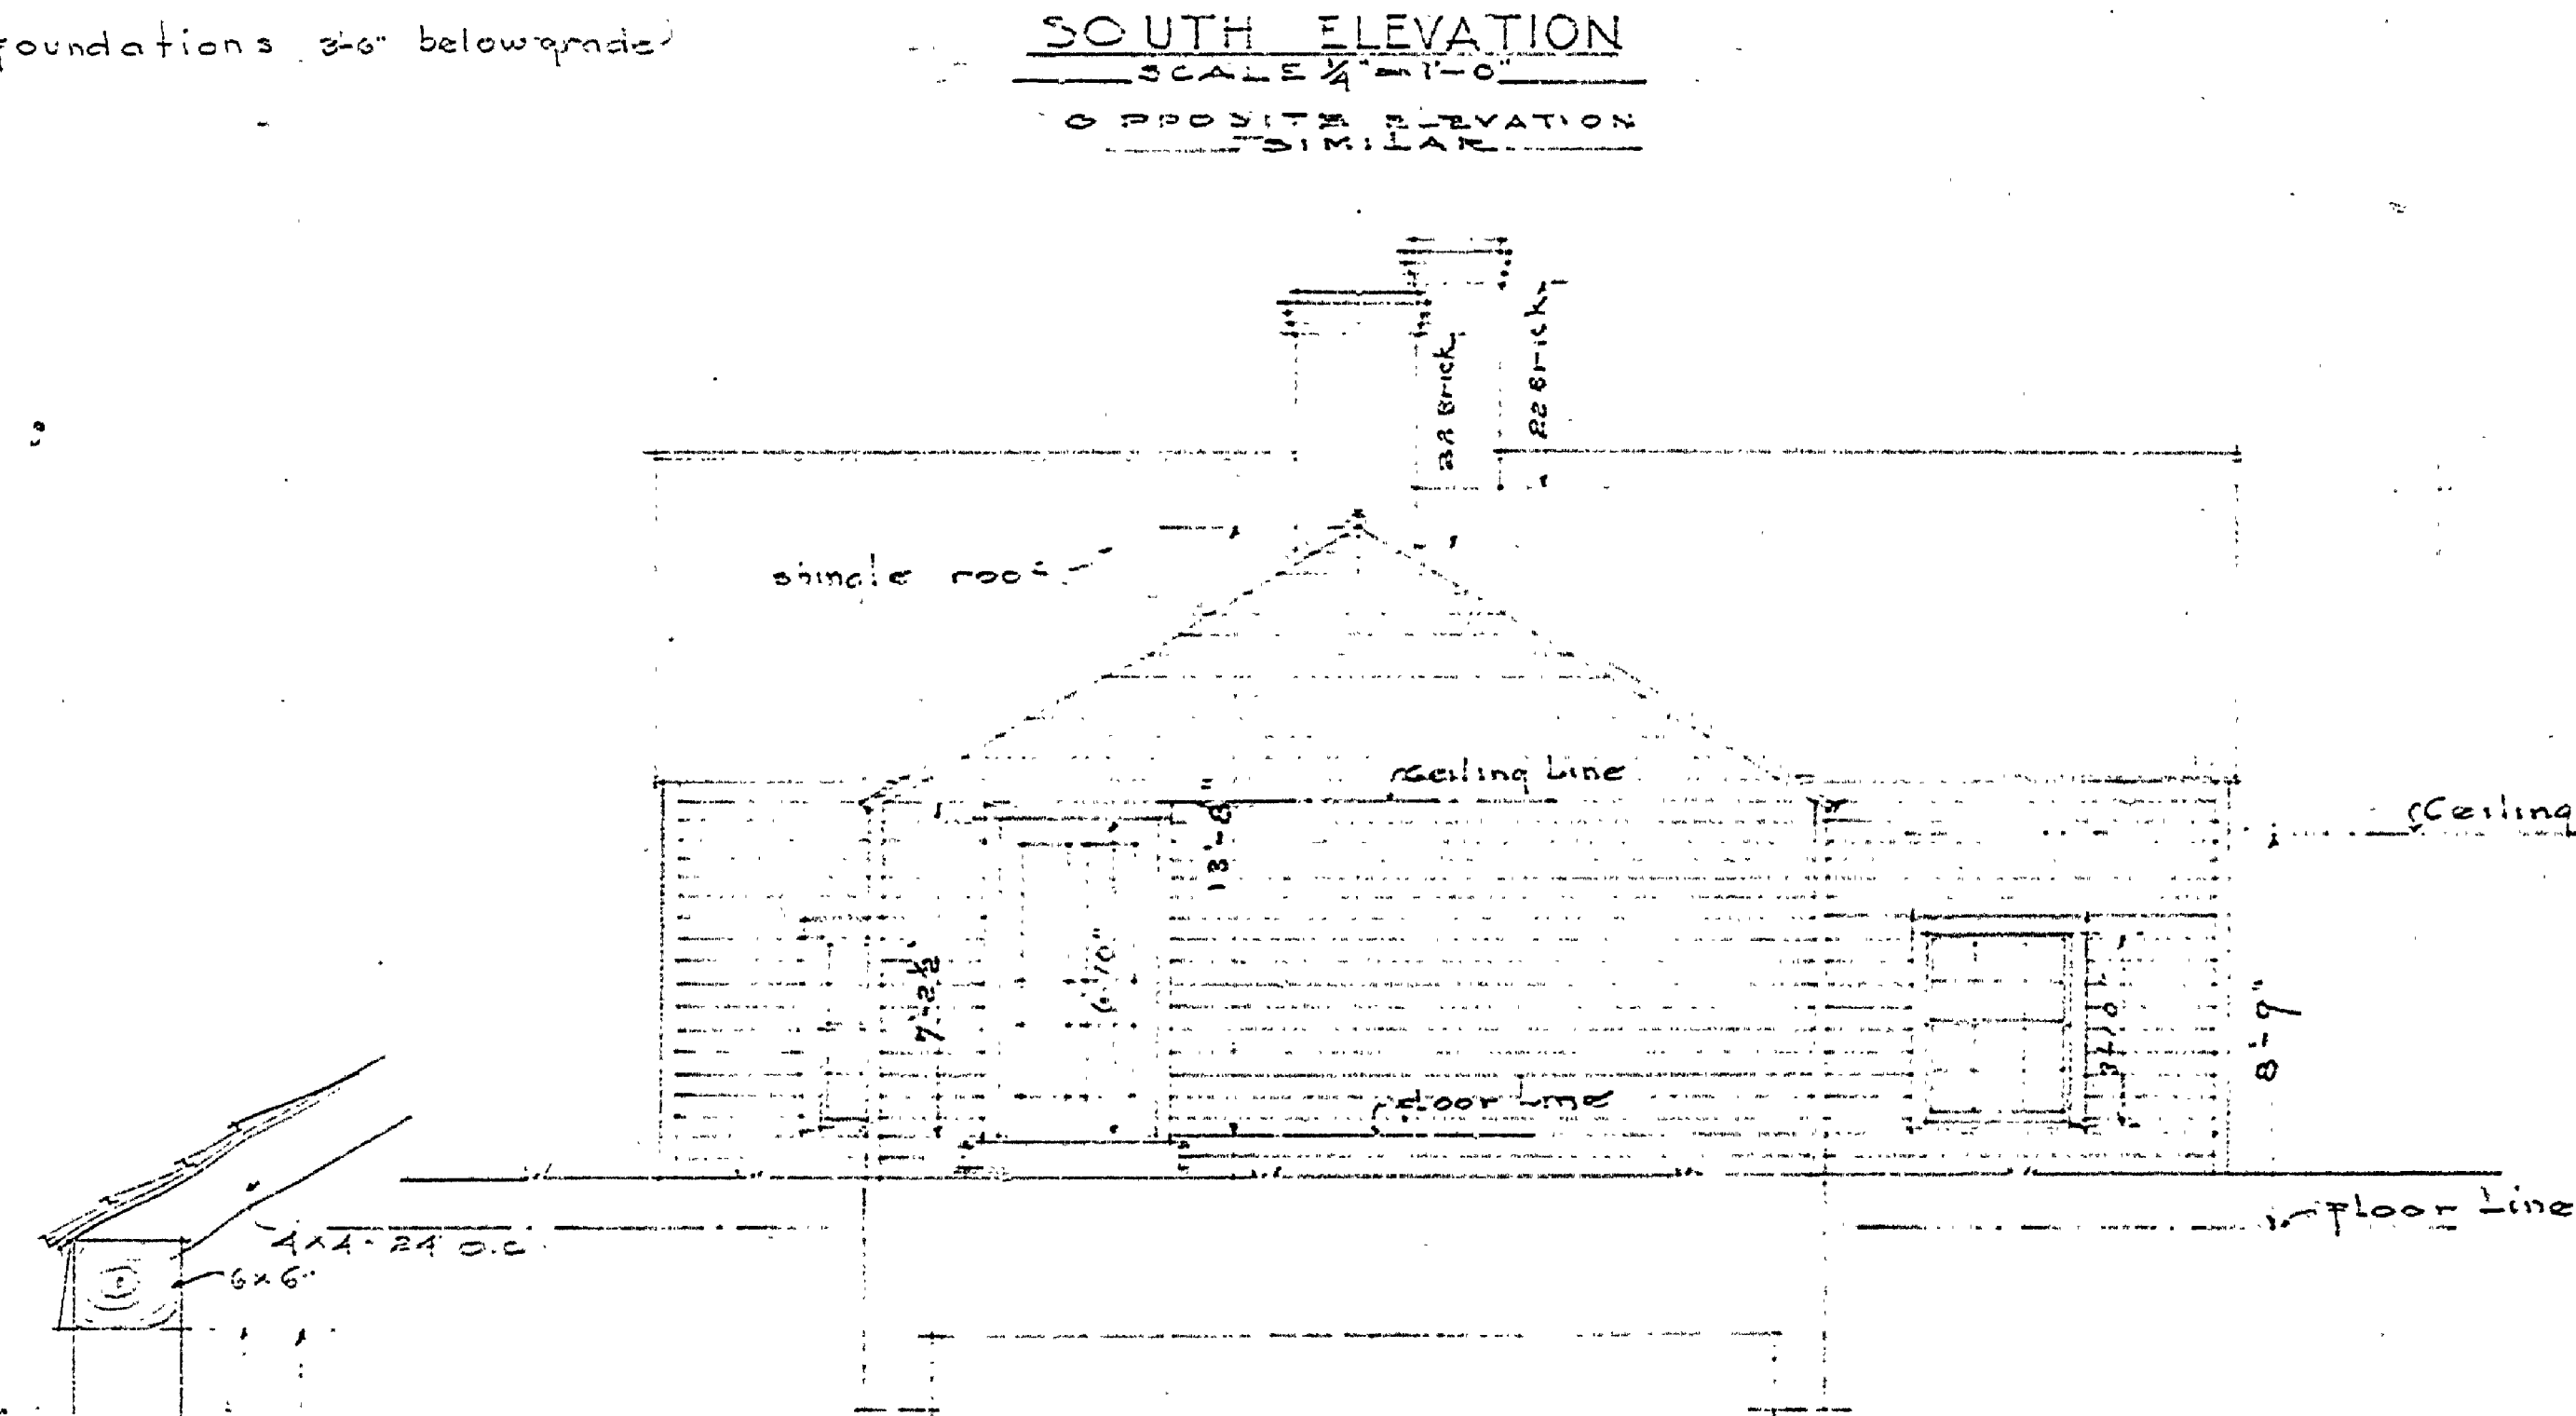

EAST ELEVATION  
SCALE 1/4" = 1'-0"

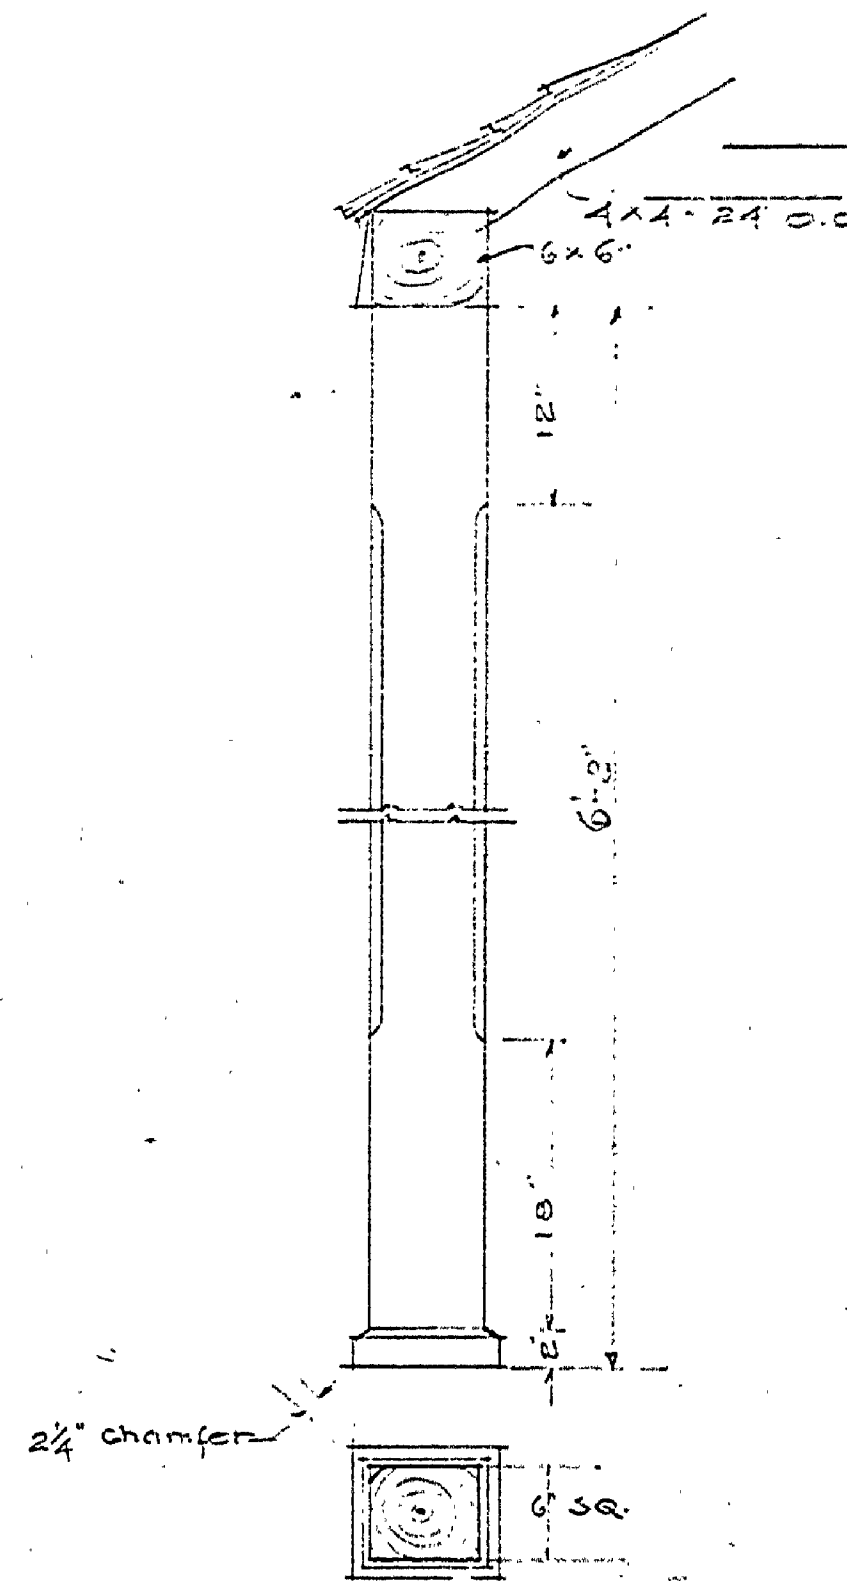

DETAIL OF POST  
SCALE 1/2" = 1'-0"

NOTE: All windows to be equipped with shutters see std. detail sheet for plan No 3, 4, 5 & 6

INSURANCE No. 16

A-108-9

MICHIGAN DEPARTMENT OF CONSERVATION PARKS DIVISION	
DRAWN BY E. F. H.	MEASURED DRAWINGS HOSPITAL BLDG.
CHECKED BY E. F. H.	DATE 3/6/42
APPROVED CHIEF OF PARKS DIVISION	SCALE AS SHOWN
APPROVED	DATE