



SECTION C  
F.S. DETAIL

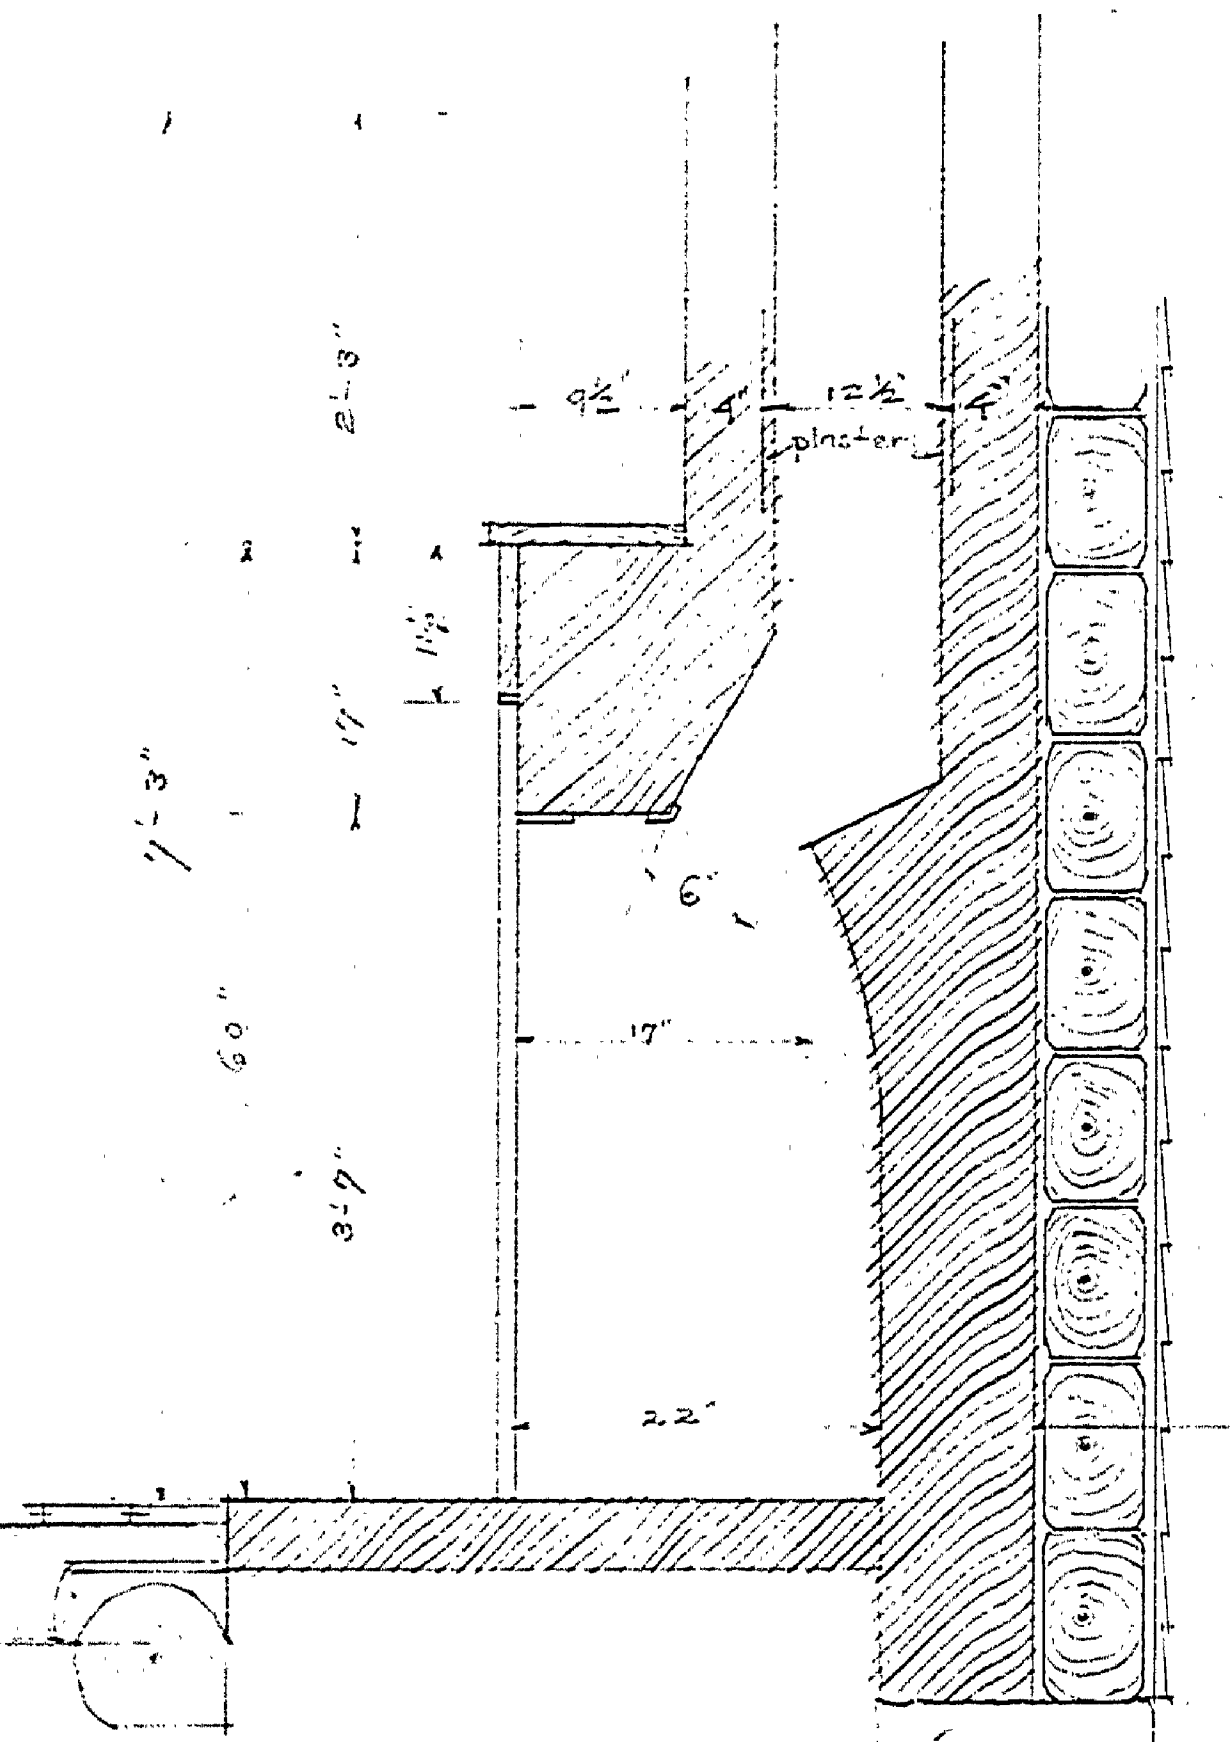

SECTION B-B  
SCALE 1/4"

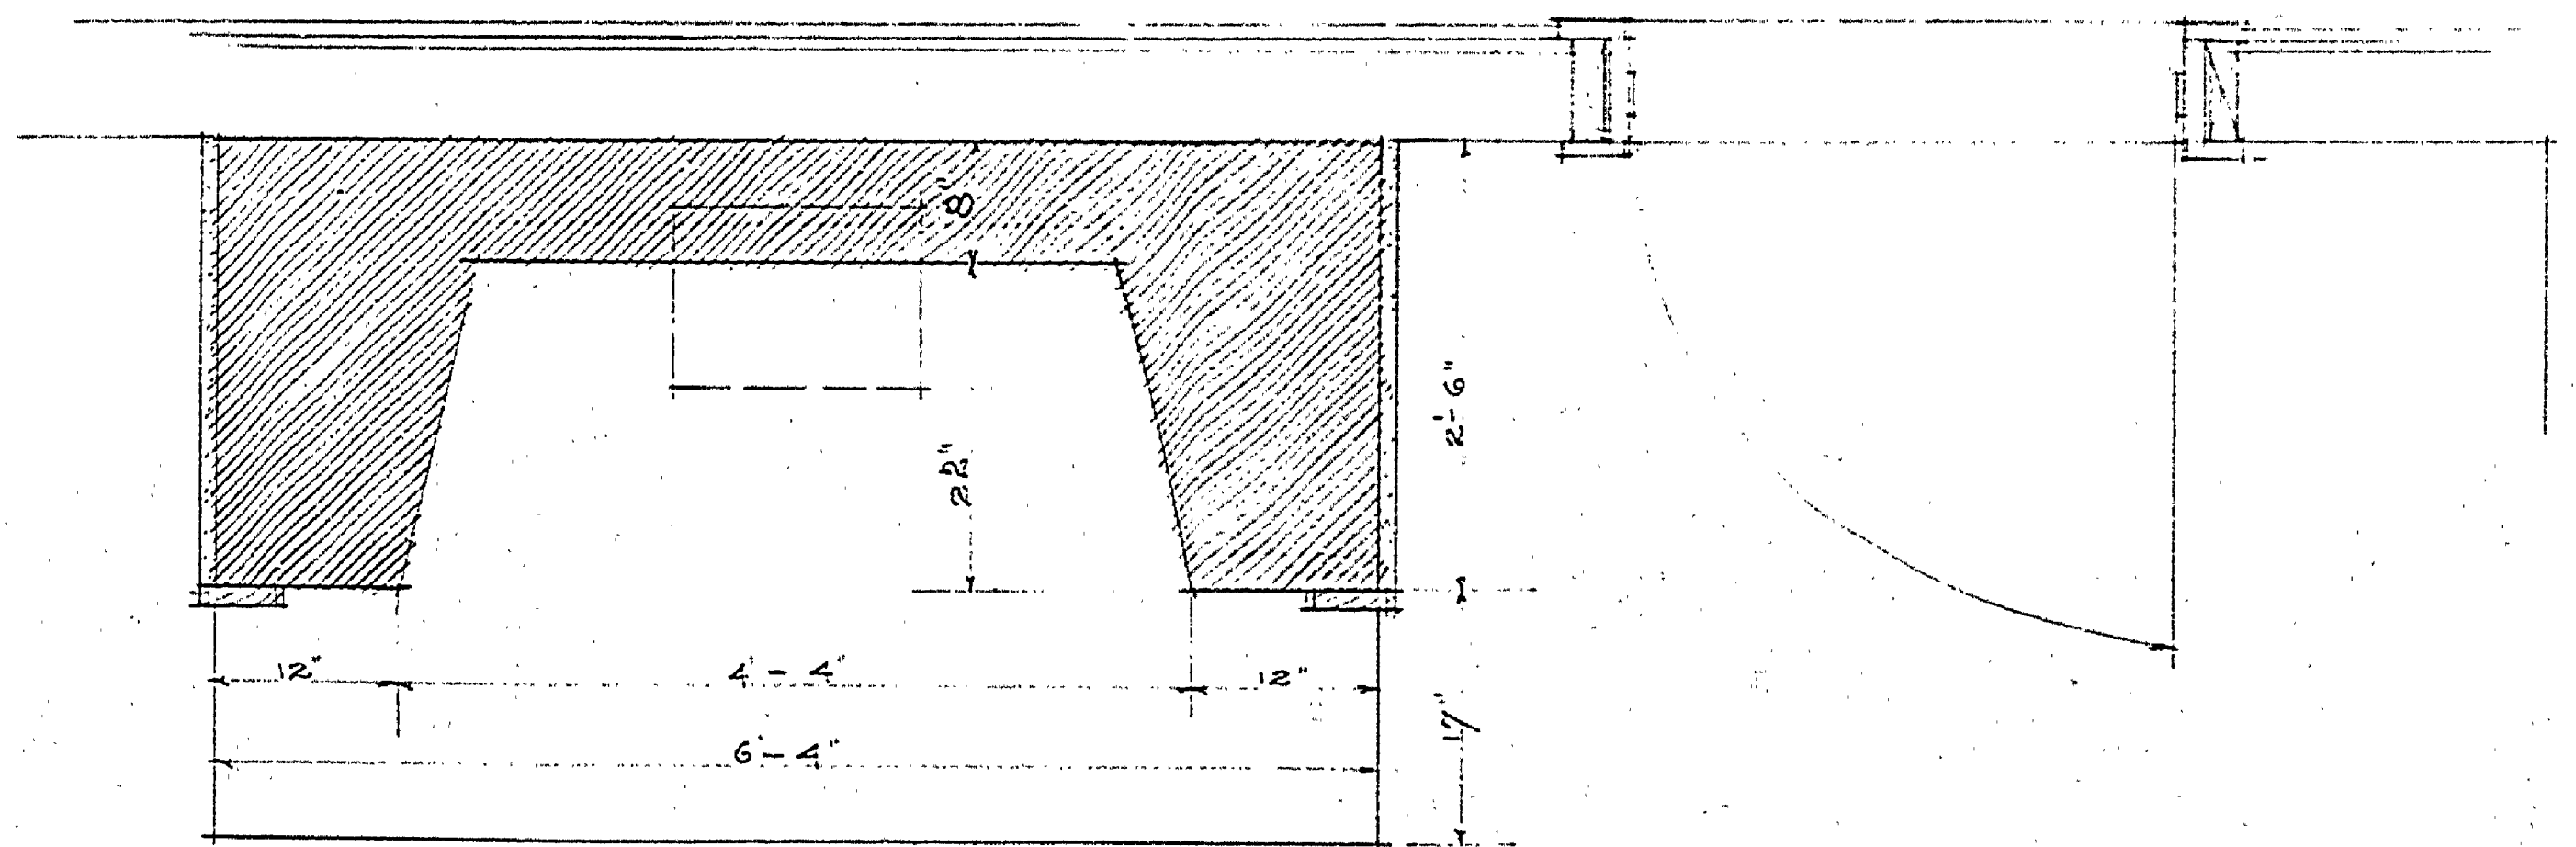

PLAN OF FIREPLACE

MICHIGAN DEPARTMENT OF CONSERVATION PARKS DIVISION	
DRAWN BY S.P.H. CHECKED BY S.P.H.	FORT WILKINS MEASURED DRAWINGS HOSPITAL BLDG. SCALE AS SHOWN DATE 3/10/45
APPROVED APPROVED	DATE OFFICE OF PARKS DIVISION DATE

INSURANCE No. 16

A-108 - 3