




SECOND FLOOR PLAN
SCALE 1/4" = 1'-0"

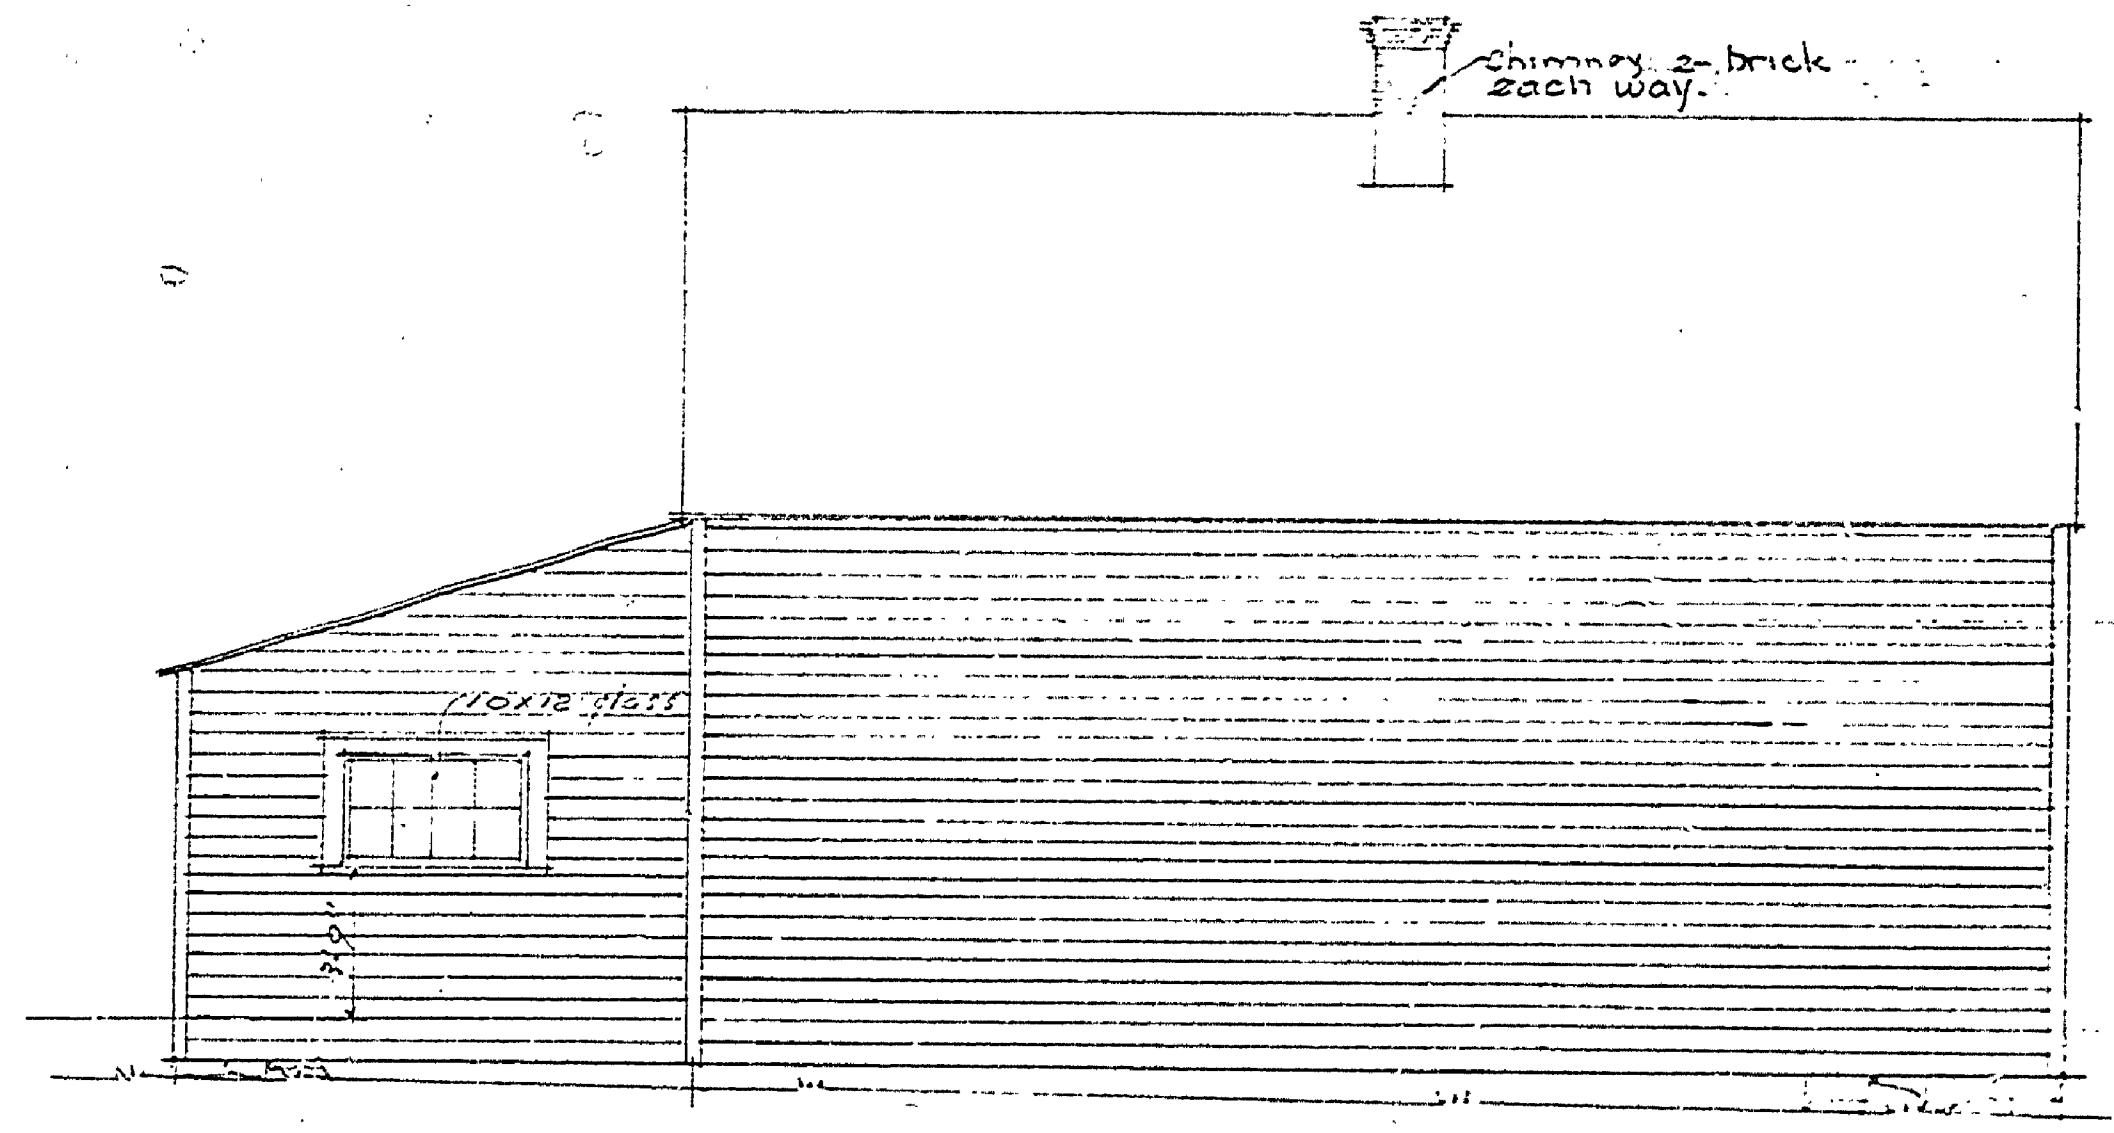


NORTH ELEVATION
SCALE 1/4" = 1'-0"

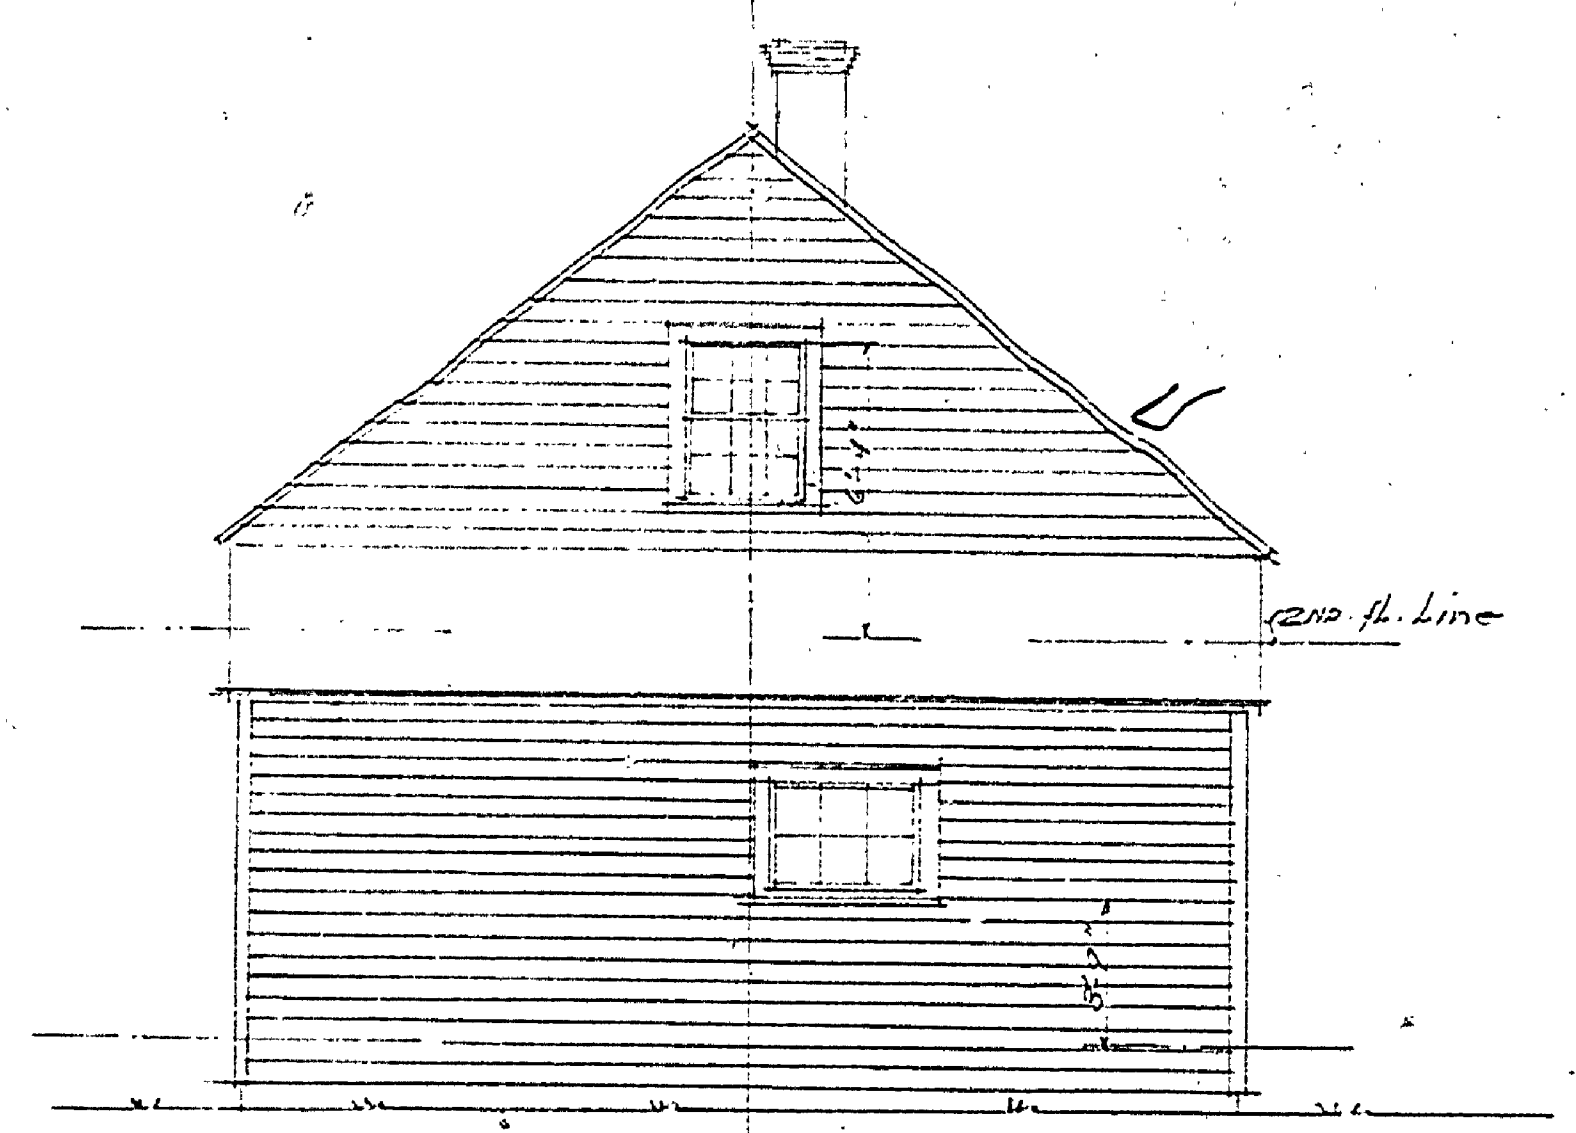


EAST ELEVATION
SCALE 1/4" = 1'-0"

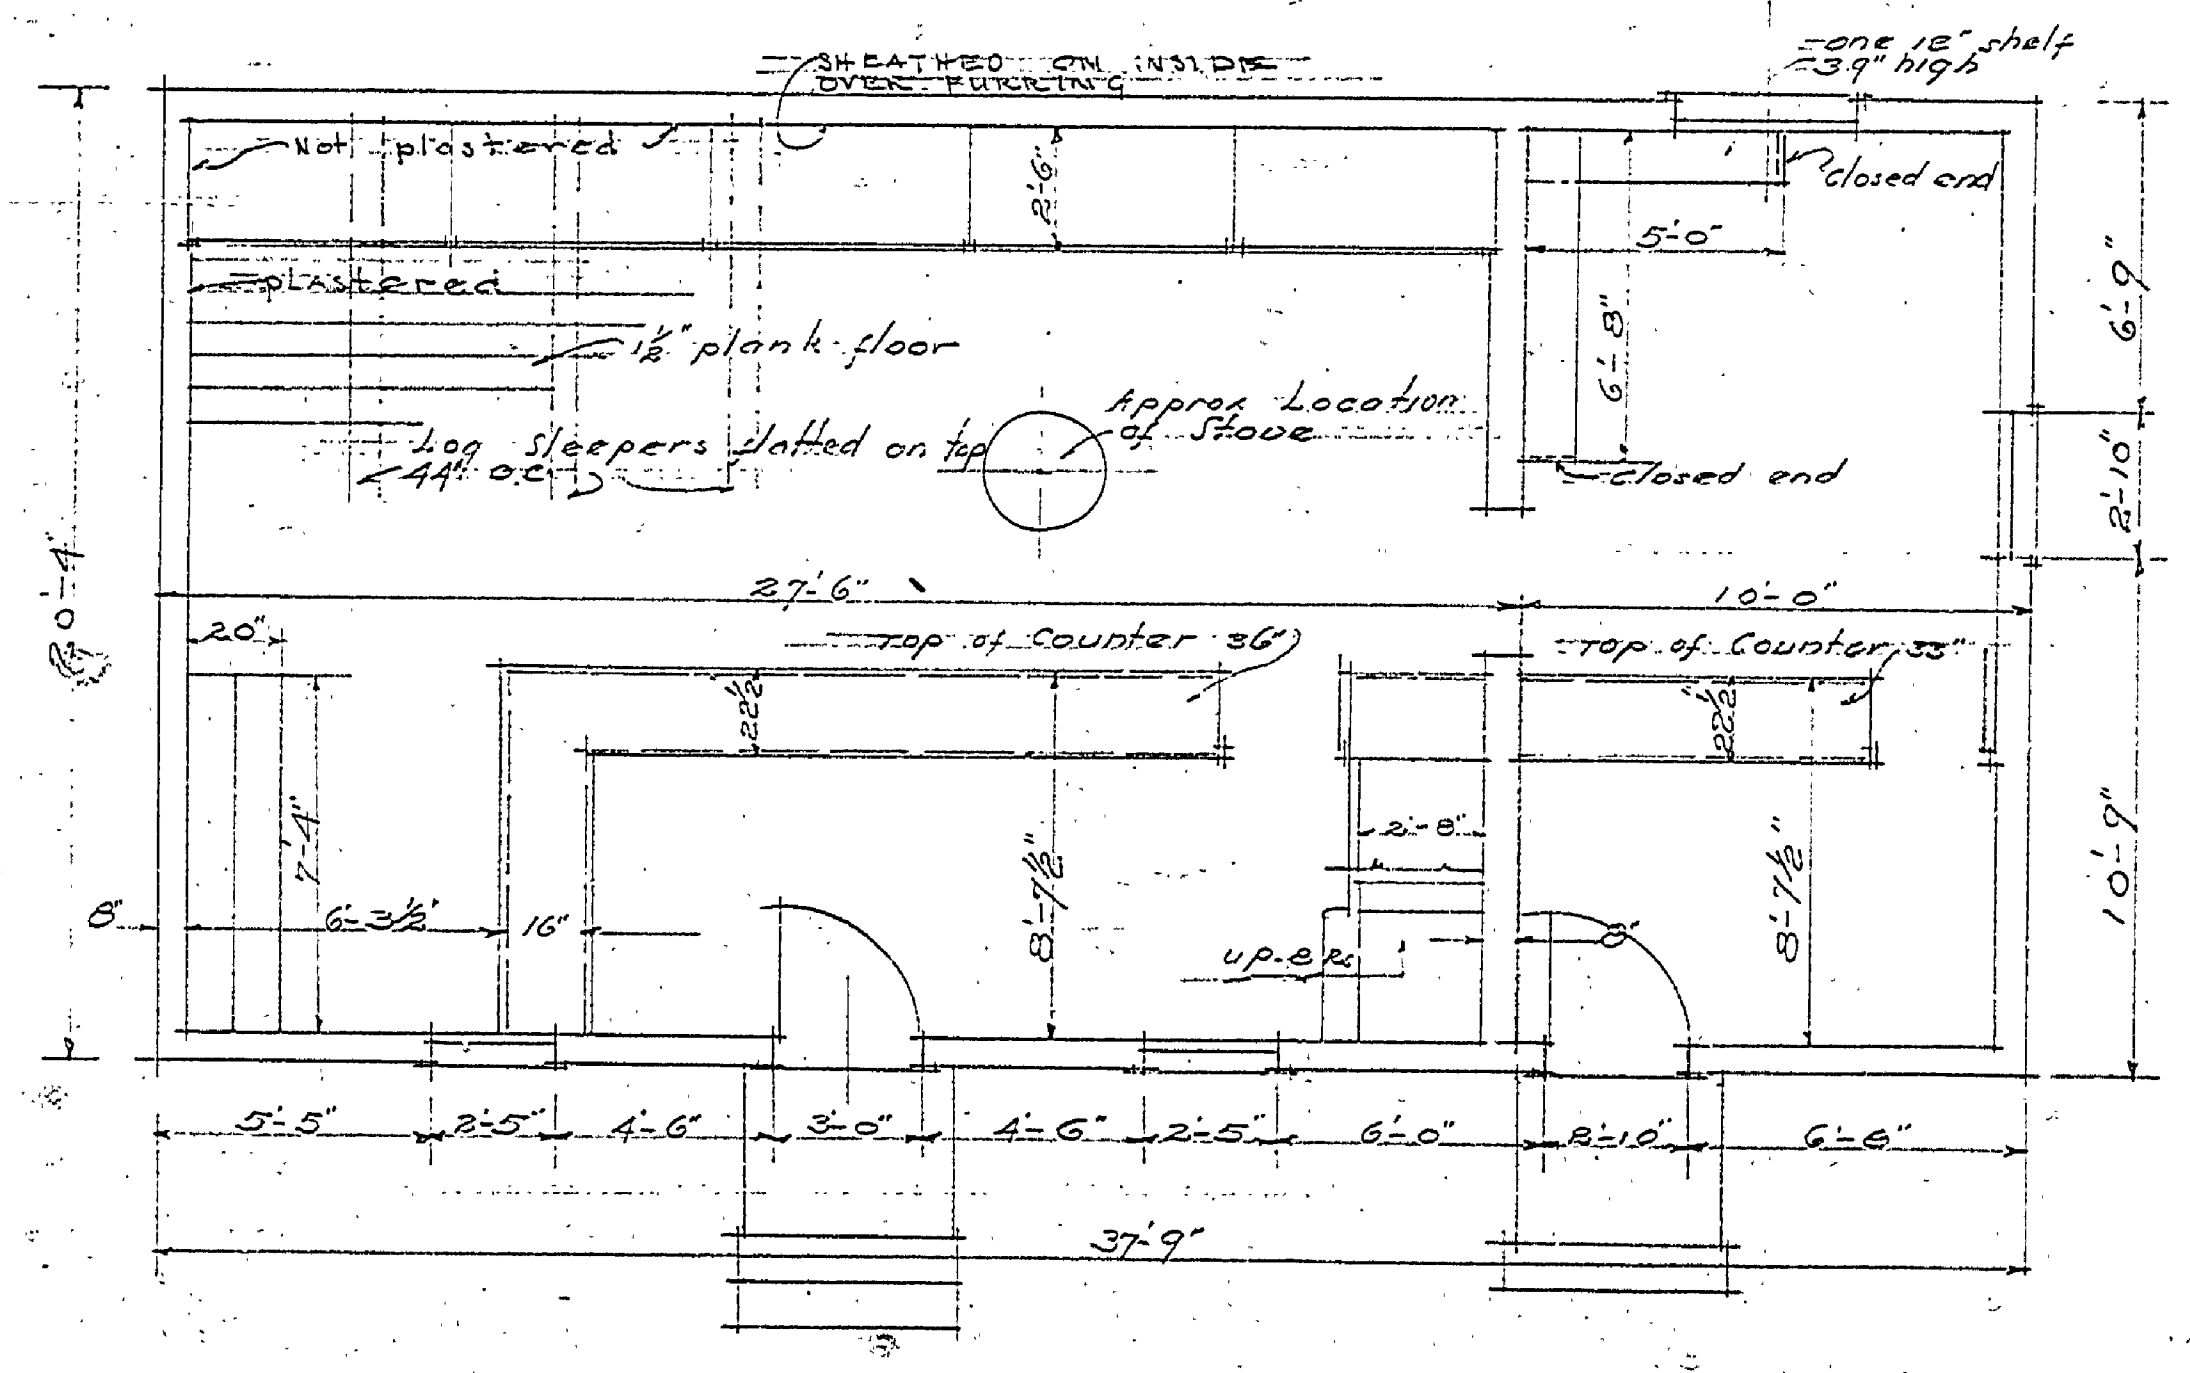

FIRST FLOOR PLAN
SCALE 1/4" = 1'-0"

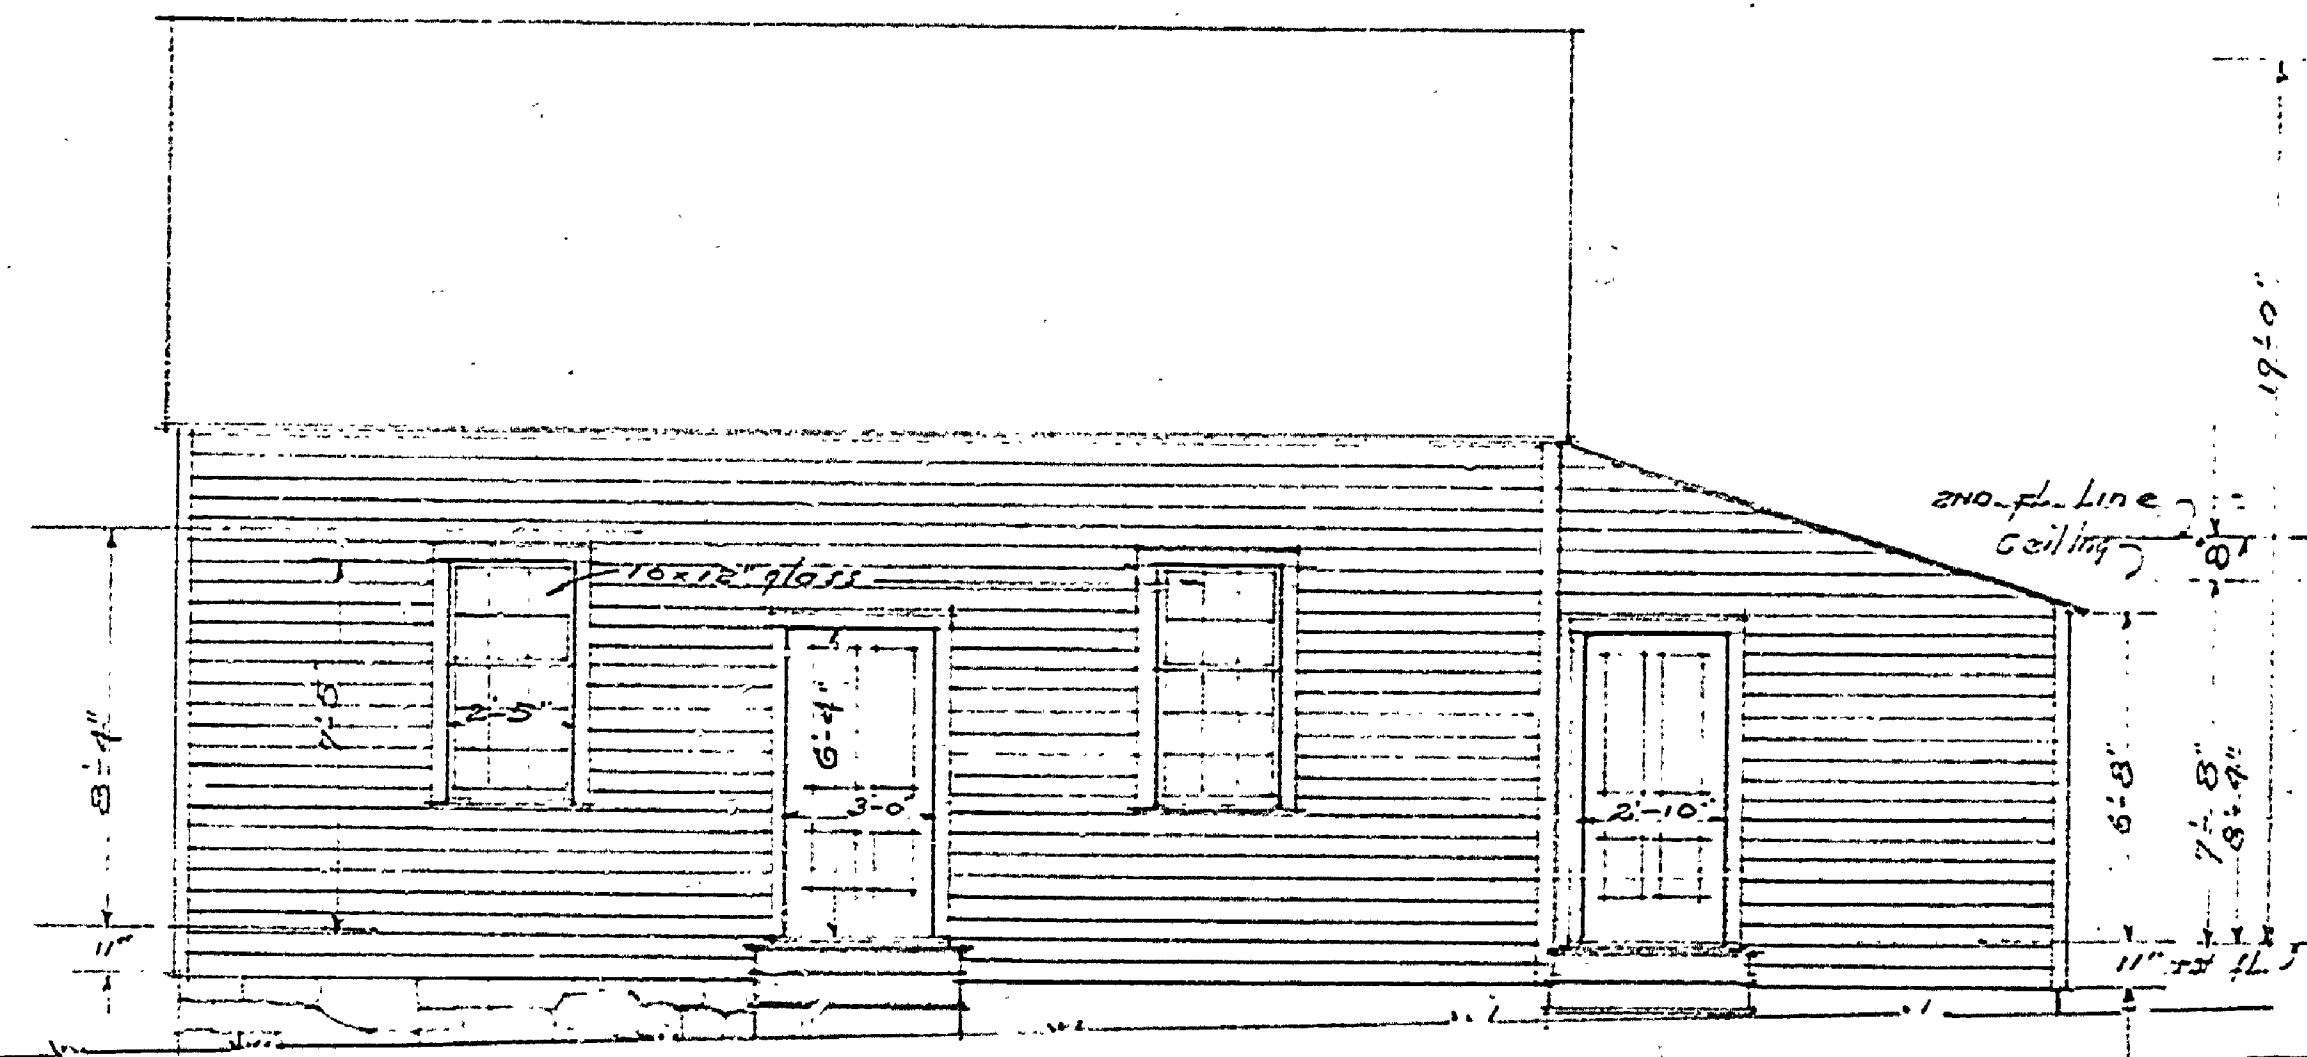

SOUTH ELEVATION
SCALE 1/4" = 1'-0"

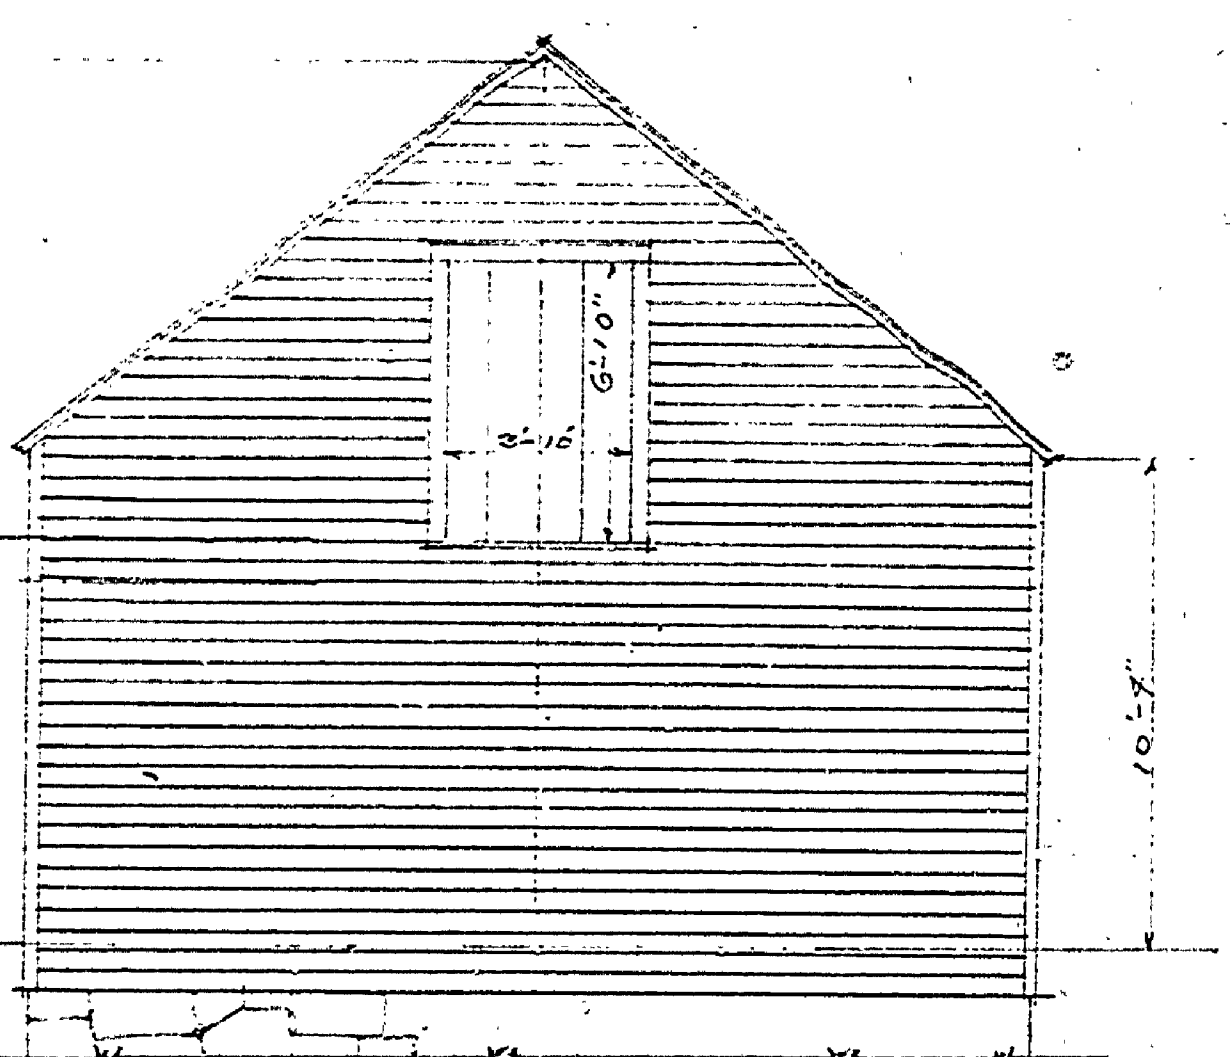

WEST ELEVATION
SCALE 1/4" = 1'-0"

NOTE: ALL INTERIOR TRIM WAS COMPLETED BEFORE PLASTERING. TRIM PROJECTS 1/4" FROM PLASTERED SURFACES.

FORT COMMISSARY

INSURANCE NO. 7

A-108-j

MEASURED DRAWINGS FOR THE RECONSTRUCTION OF THE COMMISSARY AT FORT WILKINS, MICHIGAN

MICHIGAN DEPARTMENT OF CONSERVATION PARKS DIVISION	
GENERAL COMMISSARY FORT WILKINS FORT WILKINS STATE PARK	
<i>[Signature]</i>	<i>[Signature]</i>