




SOUTH ELEVATION
NORTH ELEVATION SIMILAR
SCALE 1/4" = 1'-0"

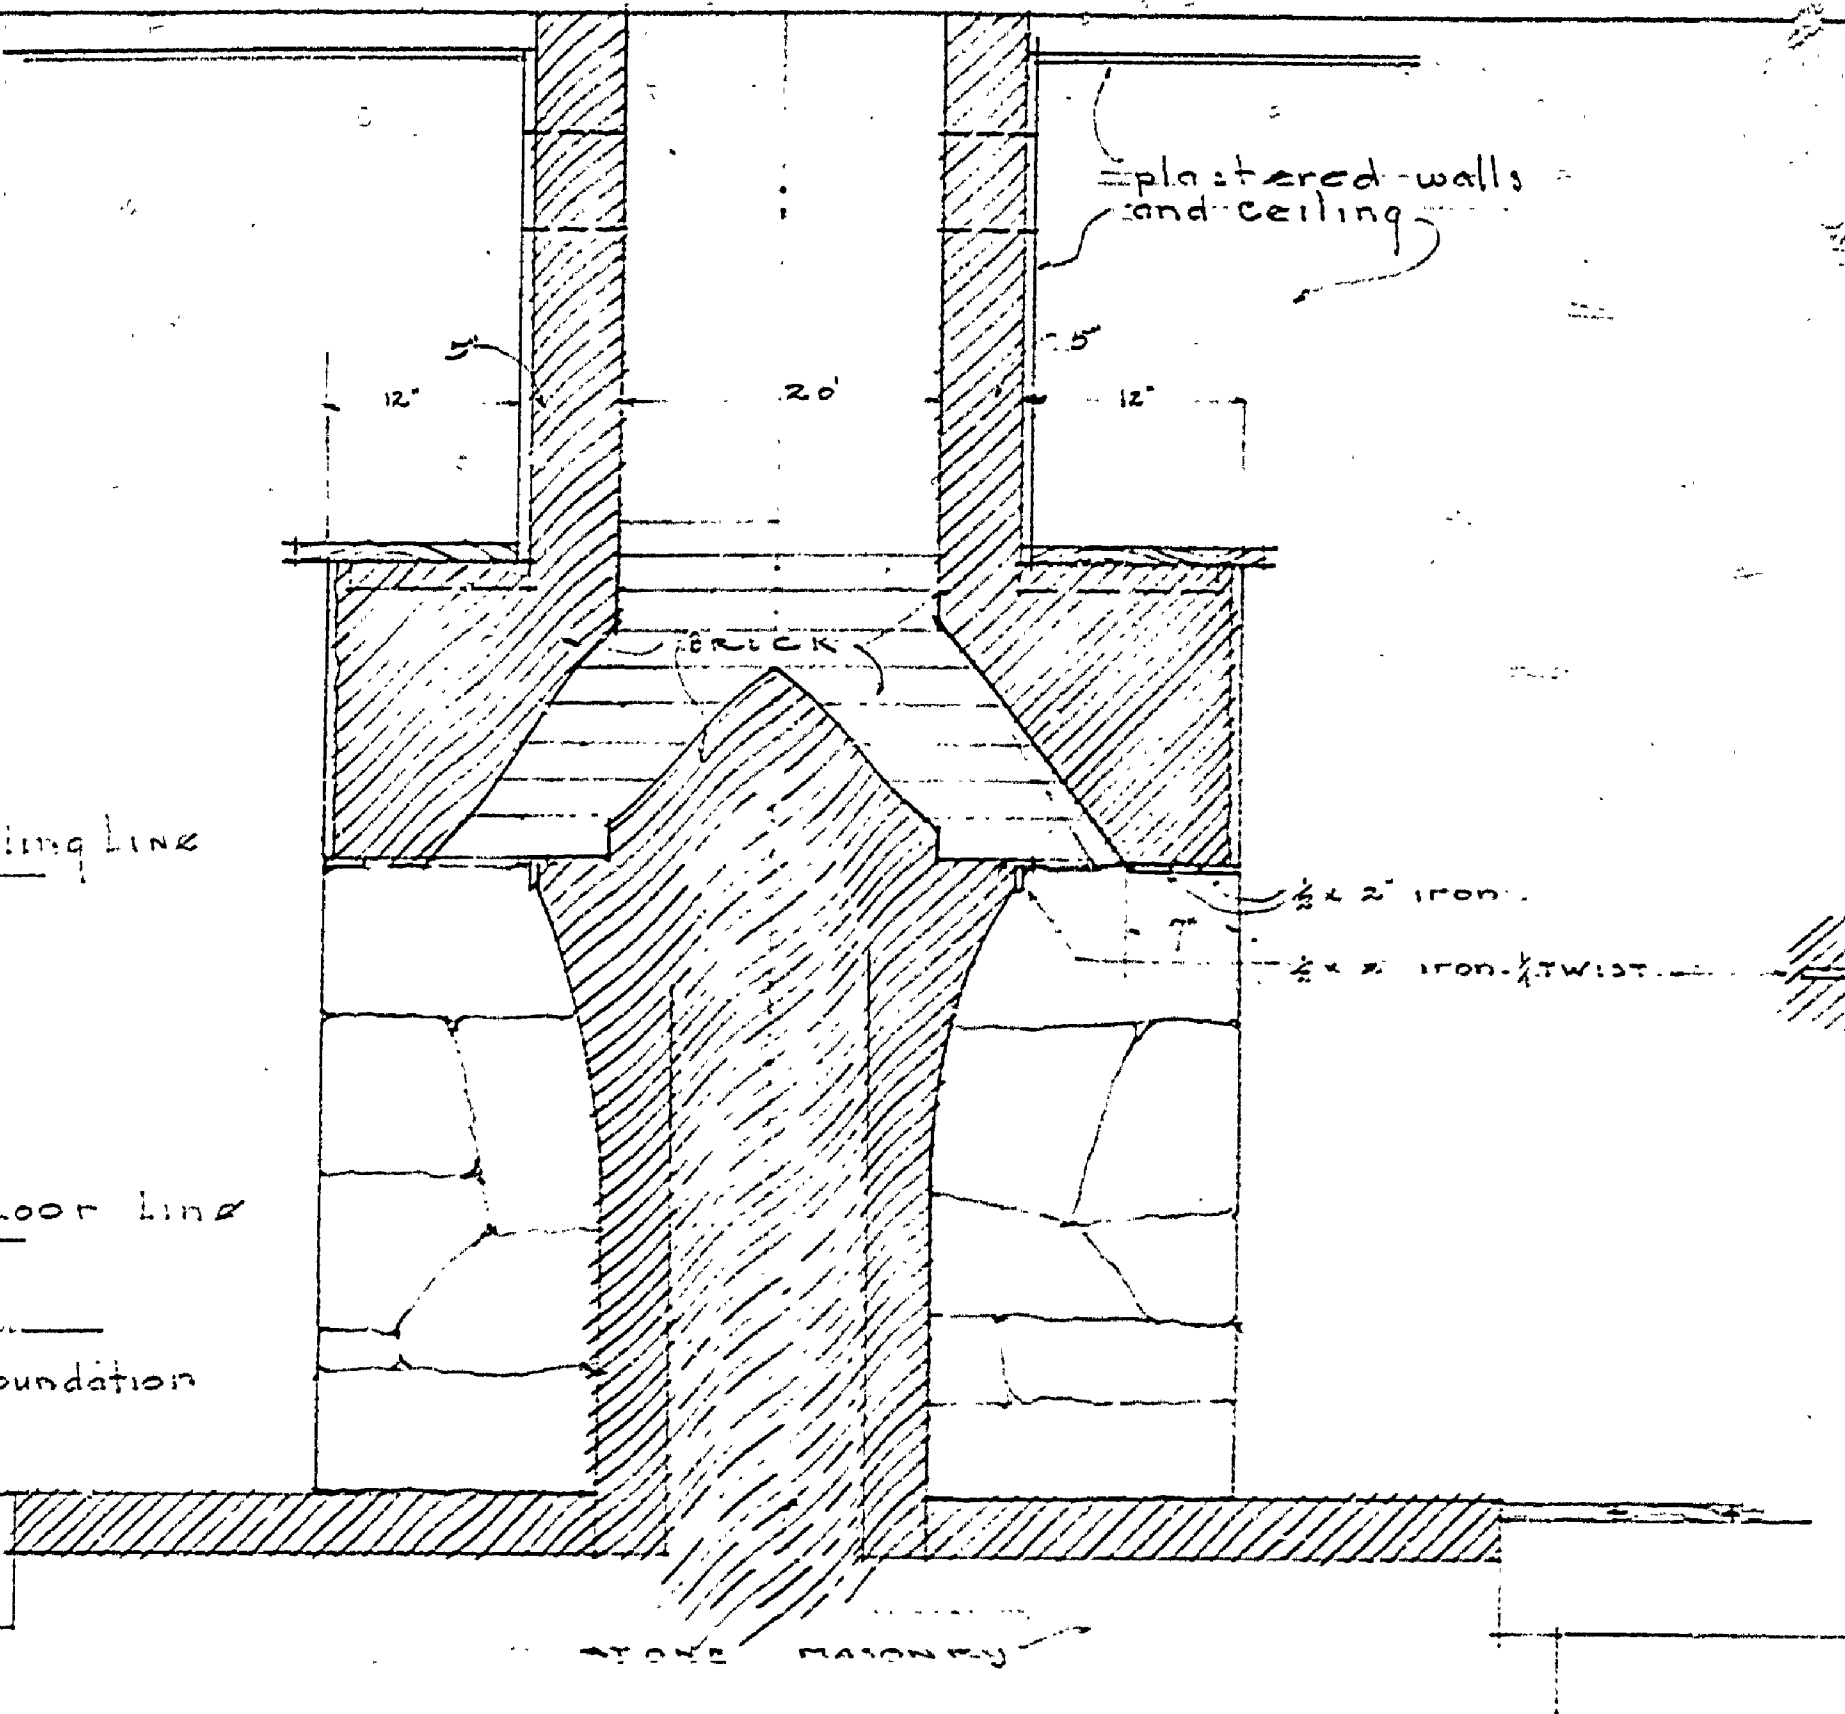


SECTION A-A
SCALE 1/4" = 1'-0"

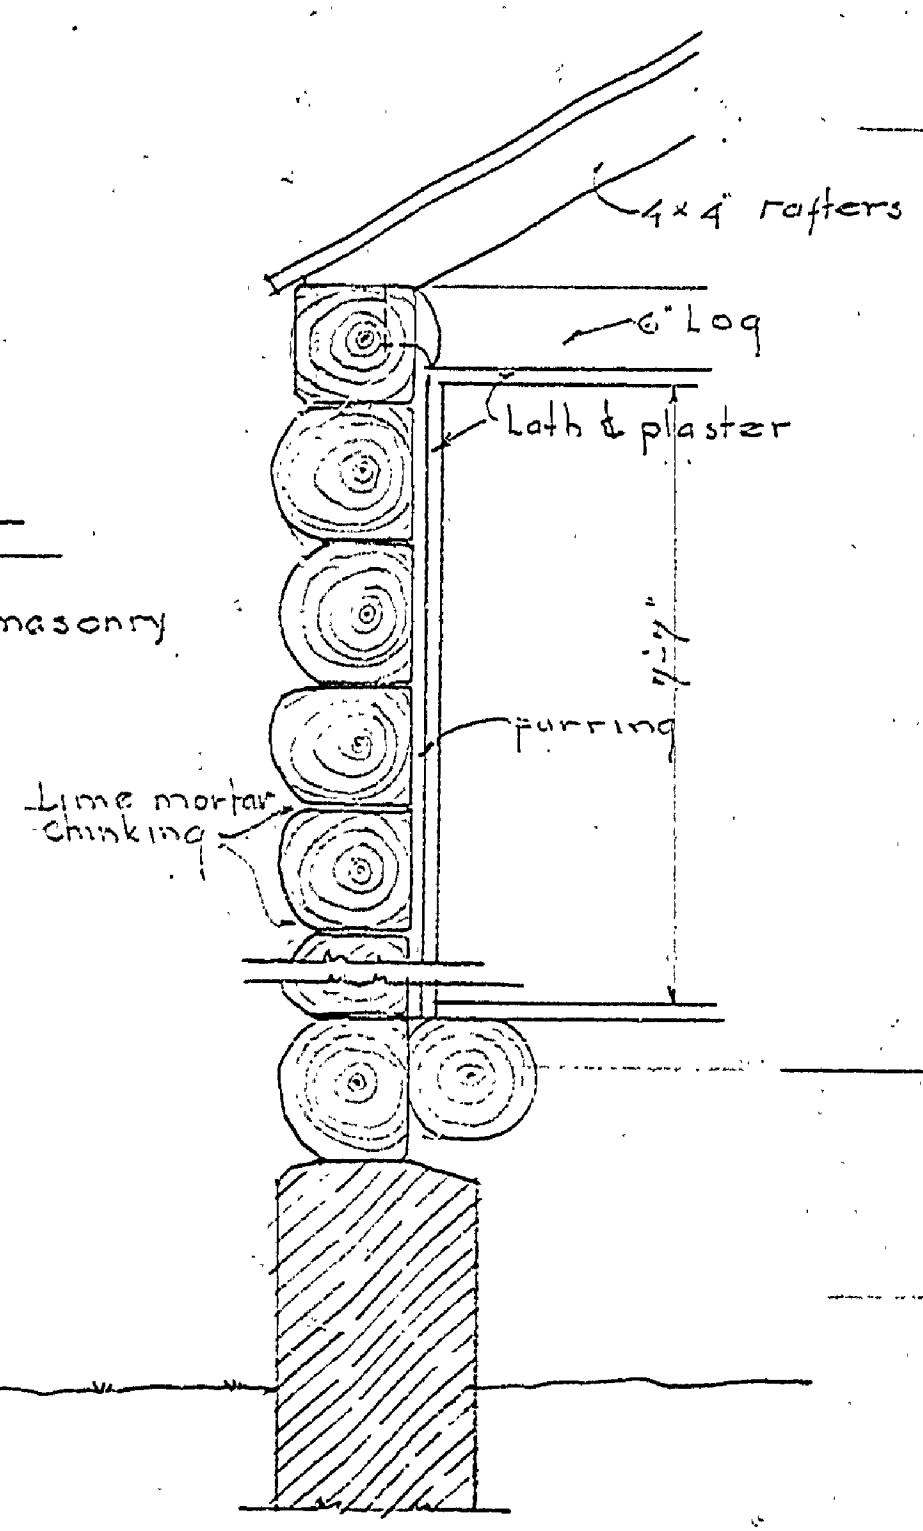


TYPICAL WALL SECTION
SCALE 1/4" = 1'-0"

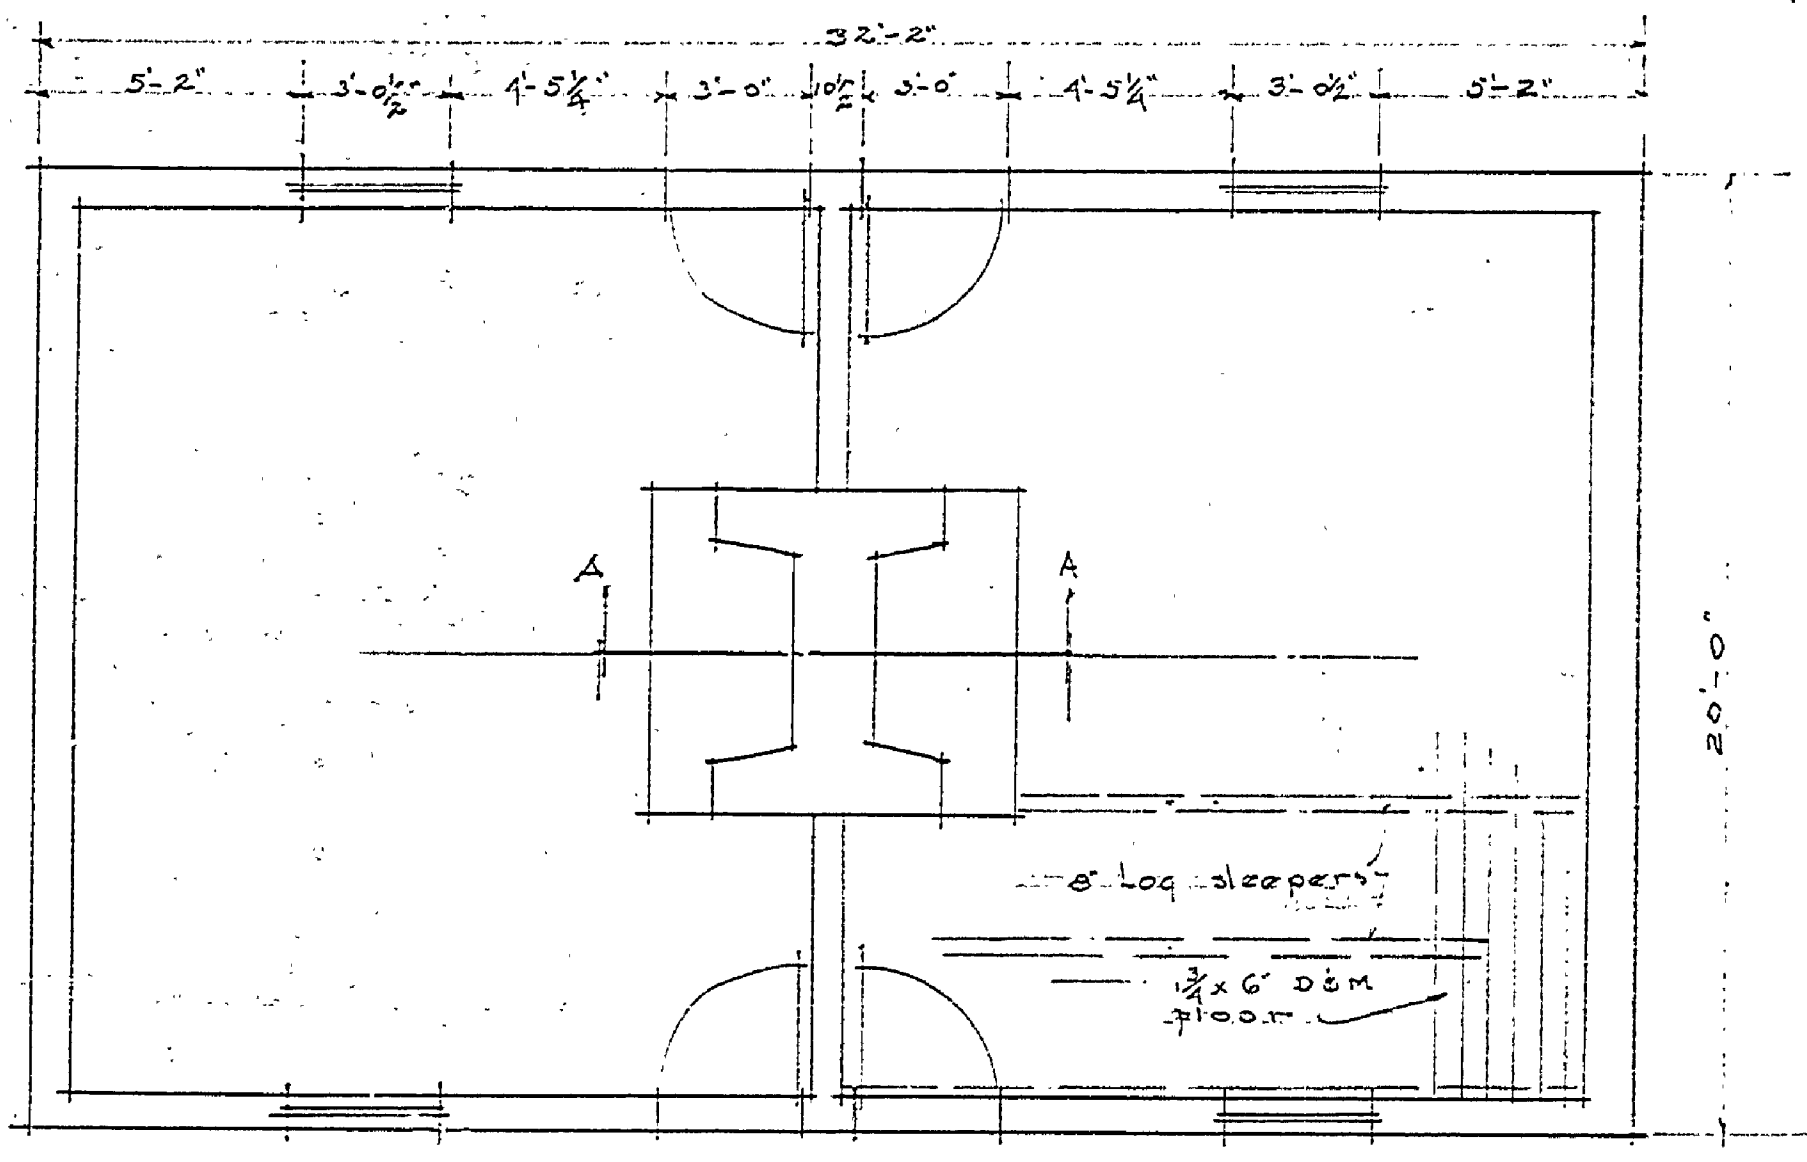


FLOOR PLAN
SCALE 1/4" = 1'-0"

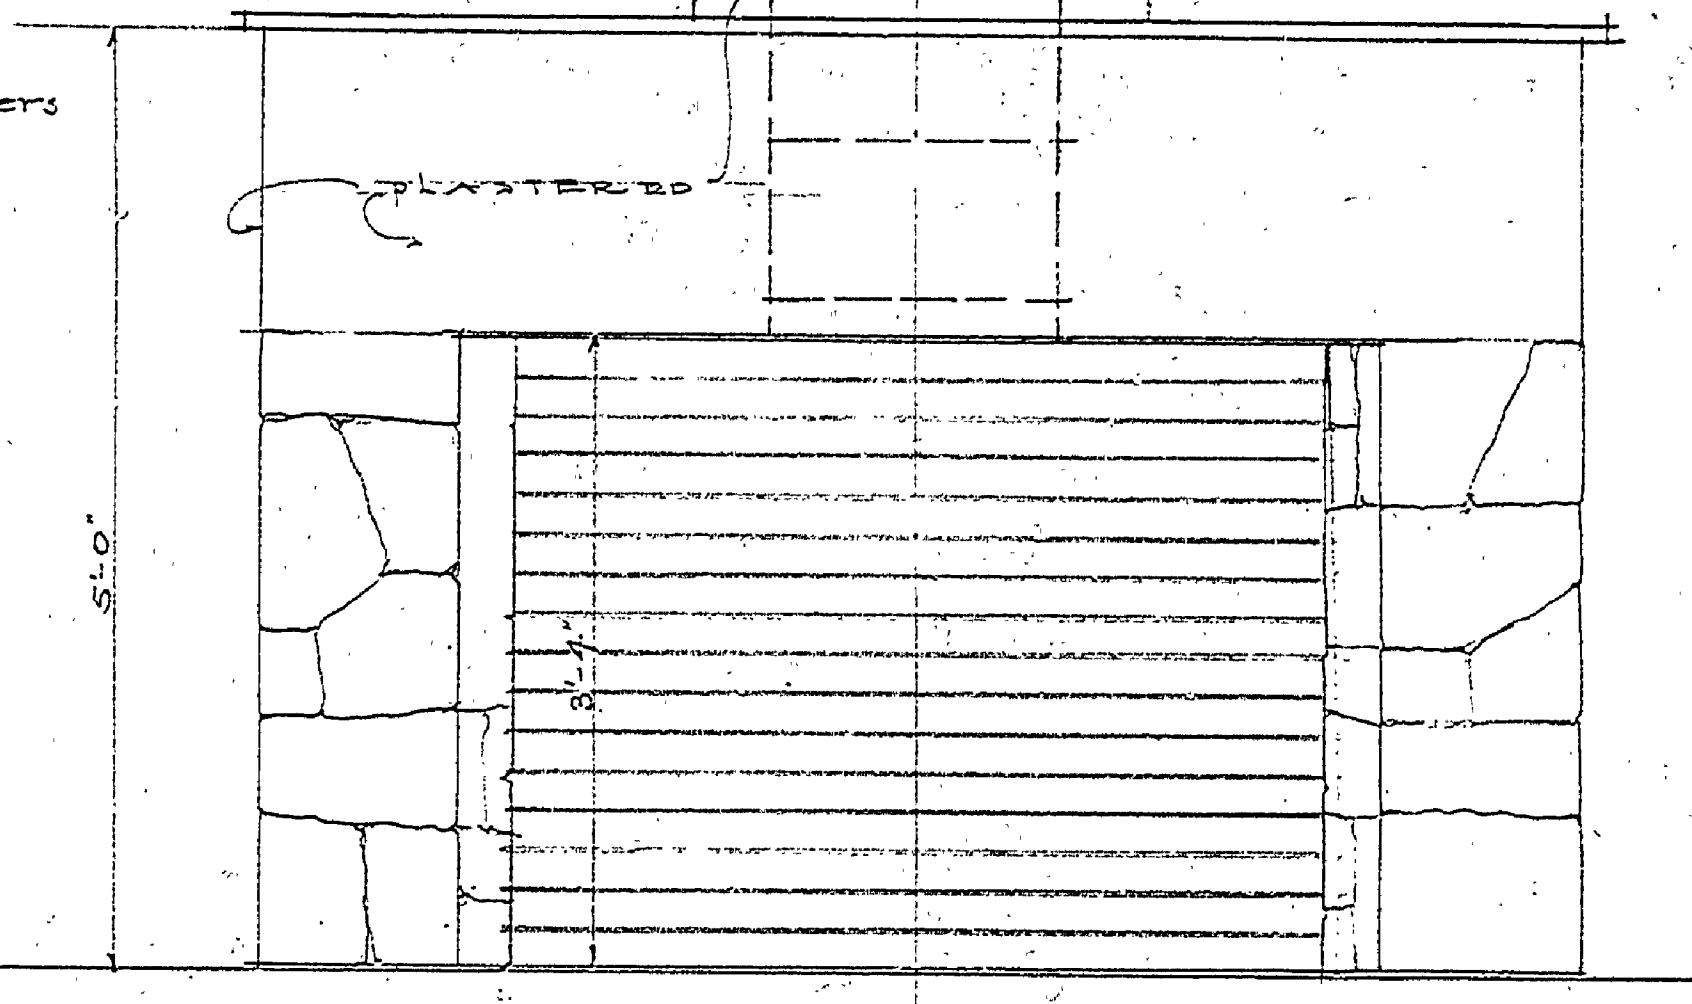

ELEVATION OF FIREPLACE
SCALE 1/4" = 1'-0"

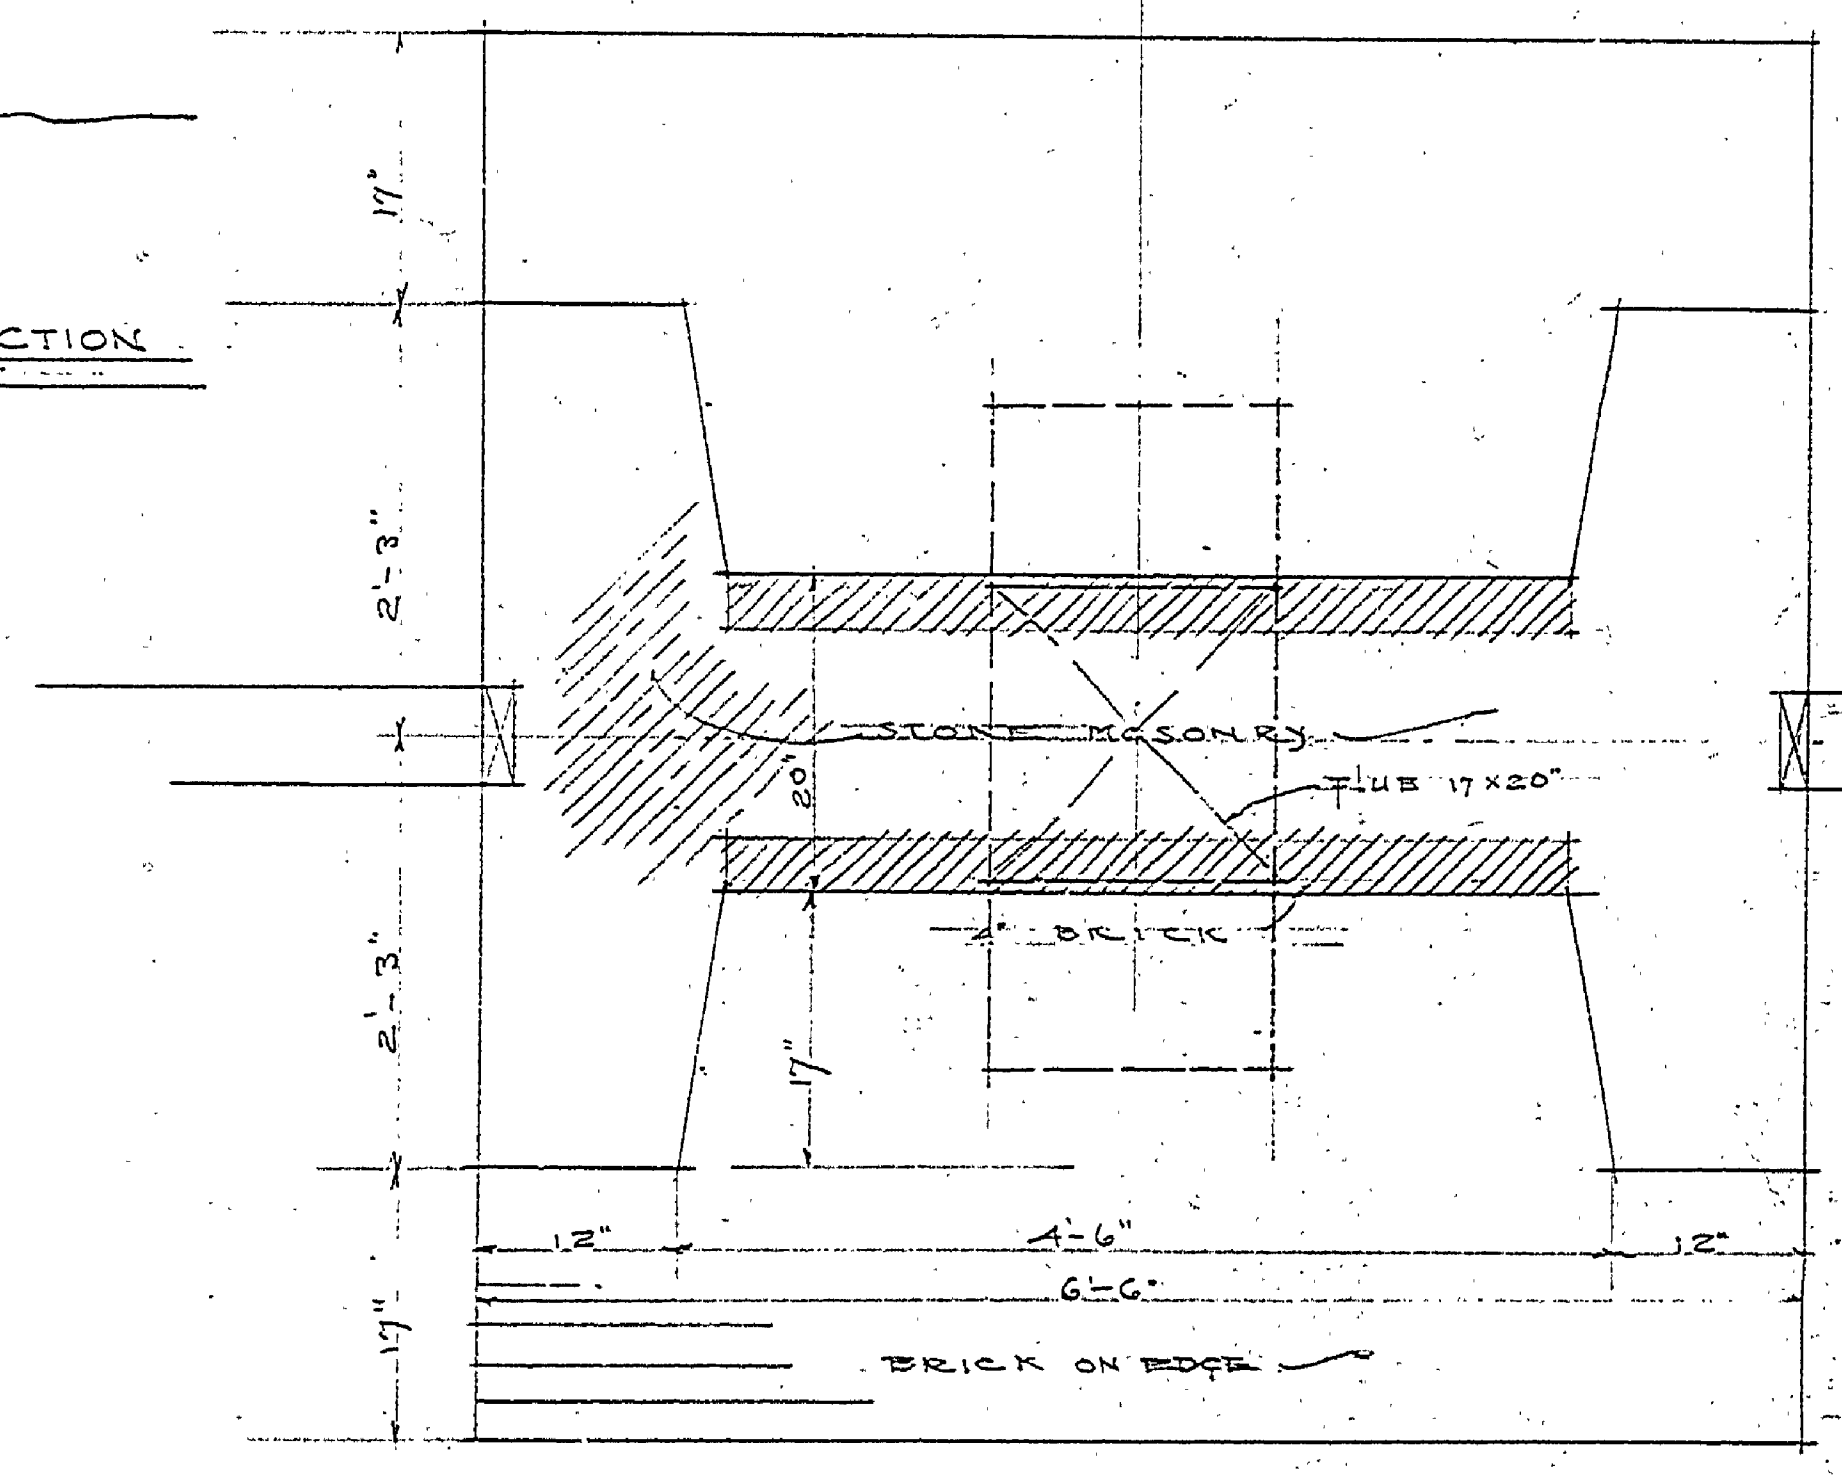

PLAN OF FIREPLACE
SCALE 1/4" = 1'-0"

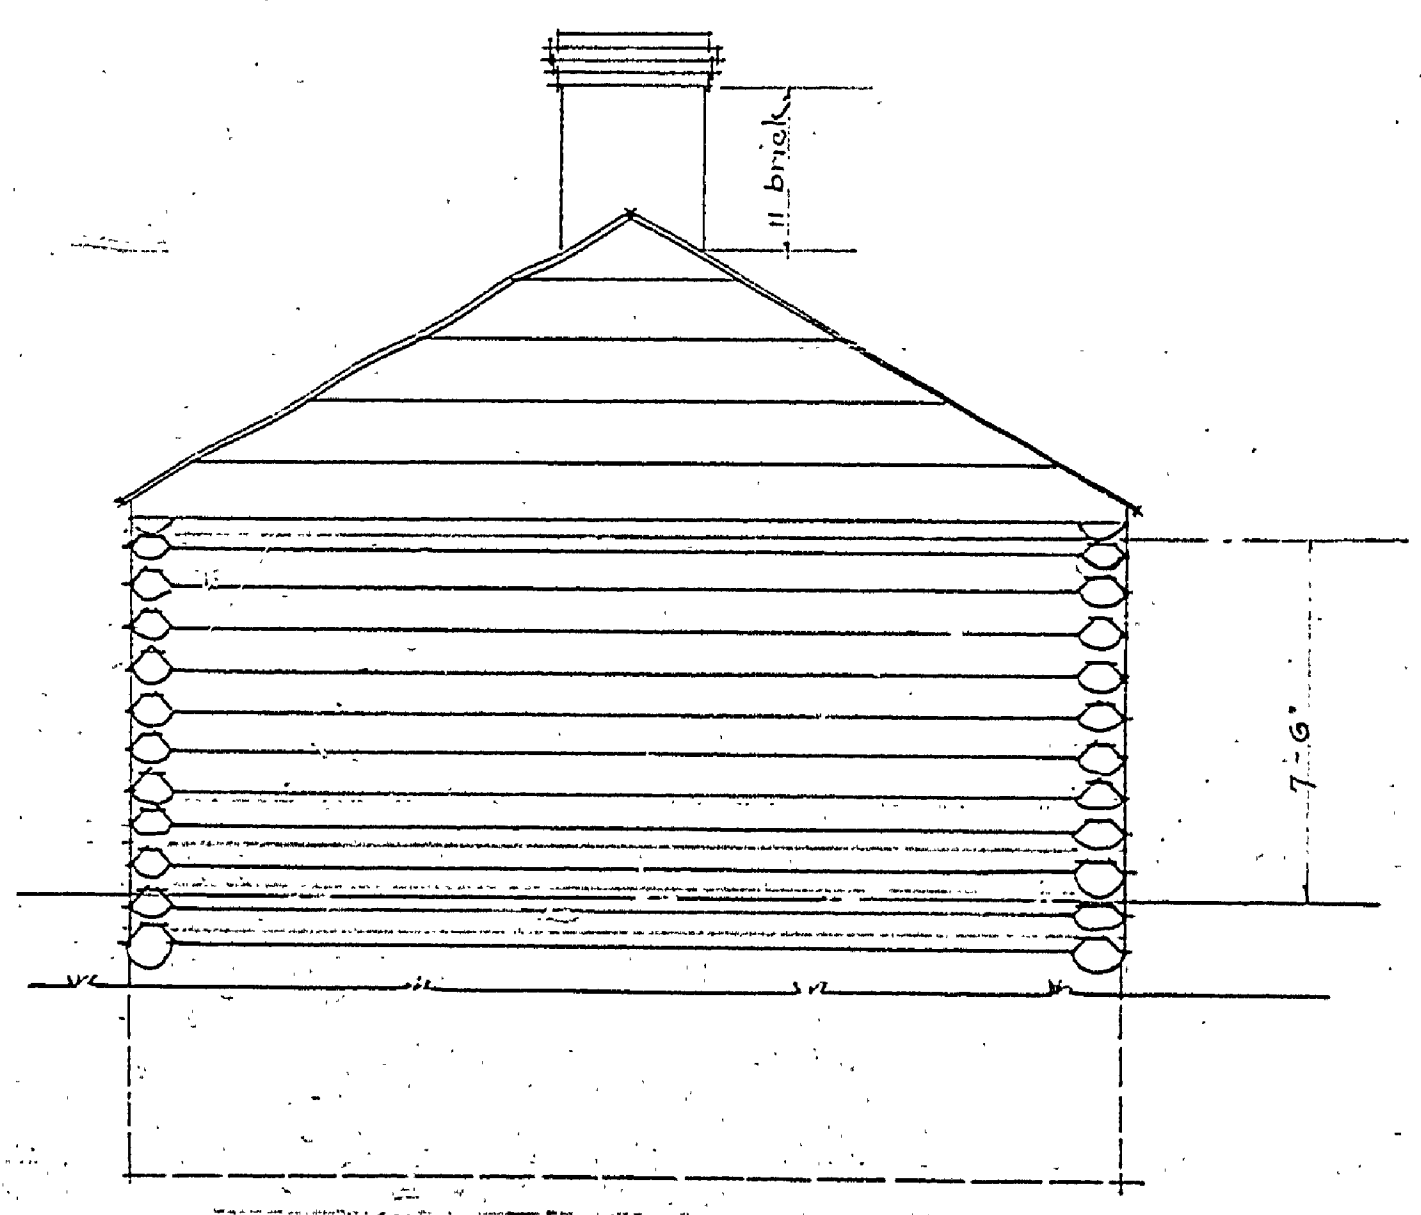

WEST ELEVATION
EAST ELEVATION SIMILAR
SCALE 1/4" = 1'-0"

INSURANCE NOS. 4 & 5

A-108-k

MICHIGAN		DATE
DEPARTMENT OF CONSERVATION		SCALE
DARKS DIVISION		NO.
FORT WALKINS		DATE
DRAWN BY	MEASURED DRAWINGS	SCALE
C.F.N.	SOLDIER'S QUARTERS	NO.
C.F.N.	GARGENT'S BARRACKS	DATE
APPROVED BY		DATE
APPROVED BY	CHEF OF BARRACKS DIVISION	DATE