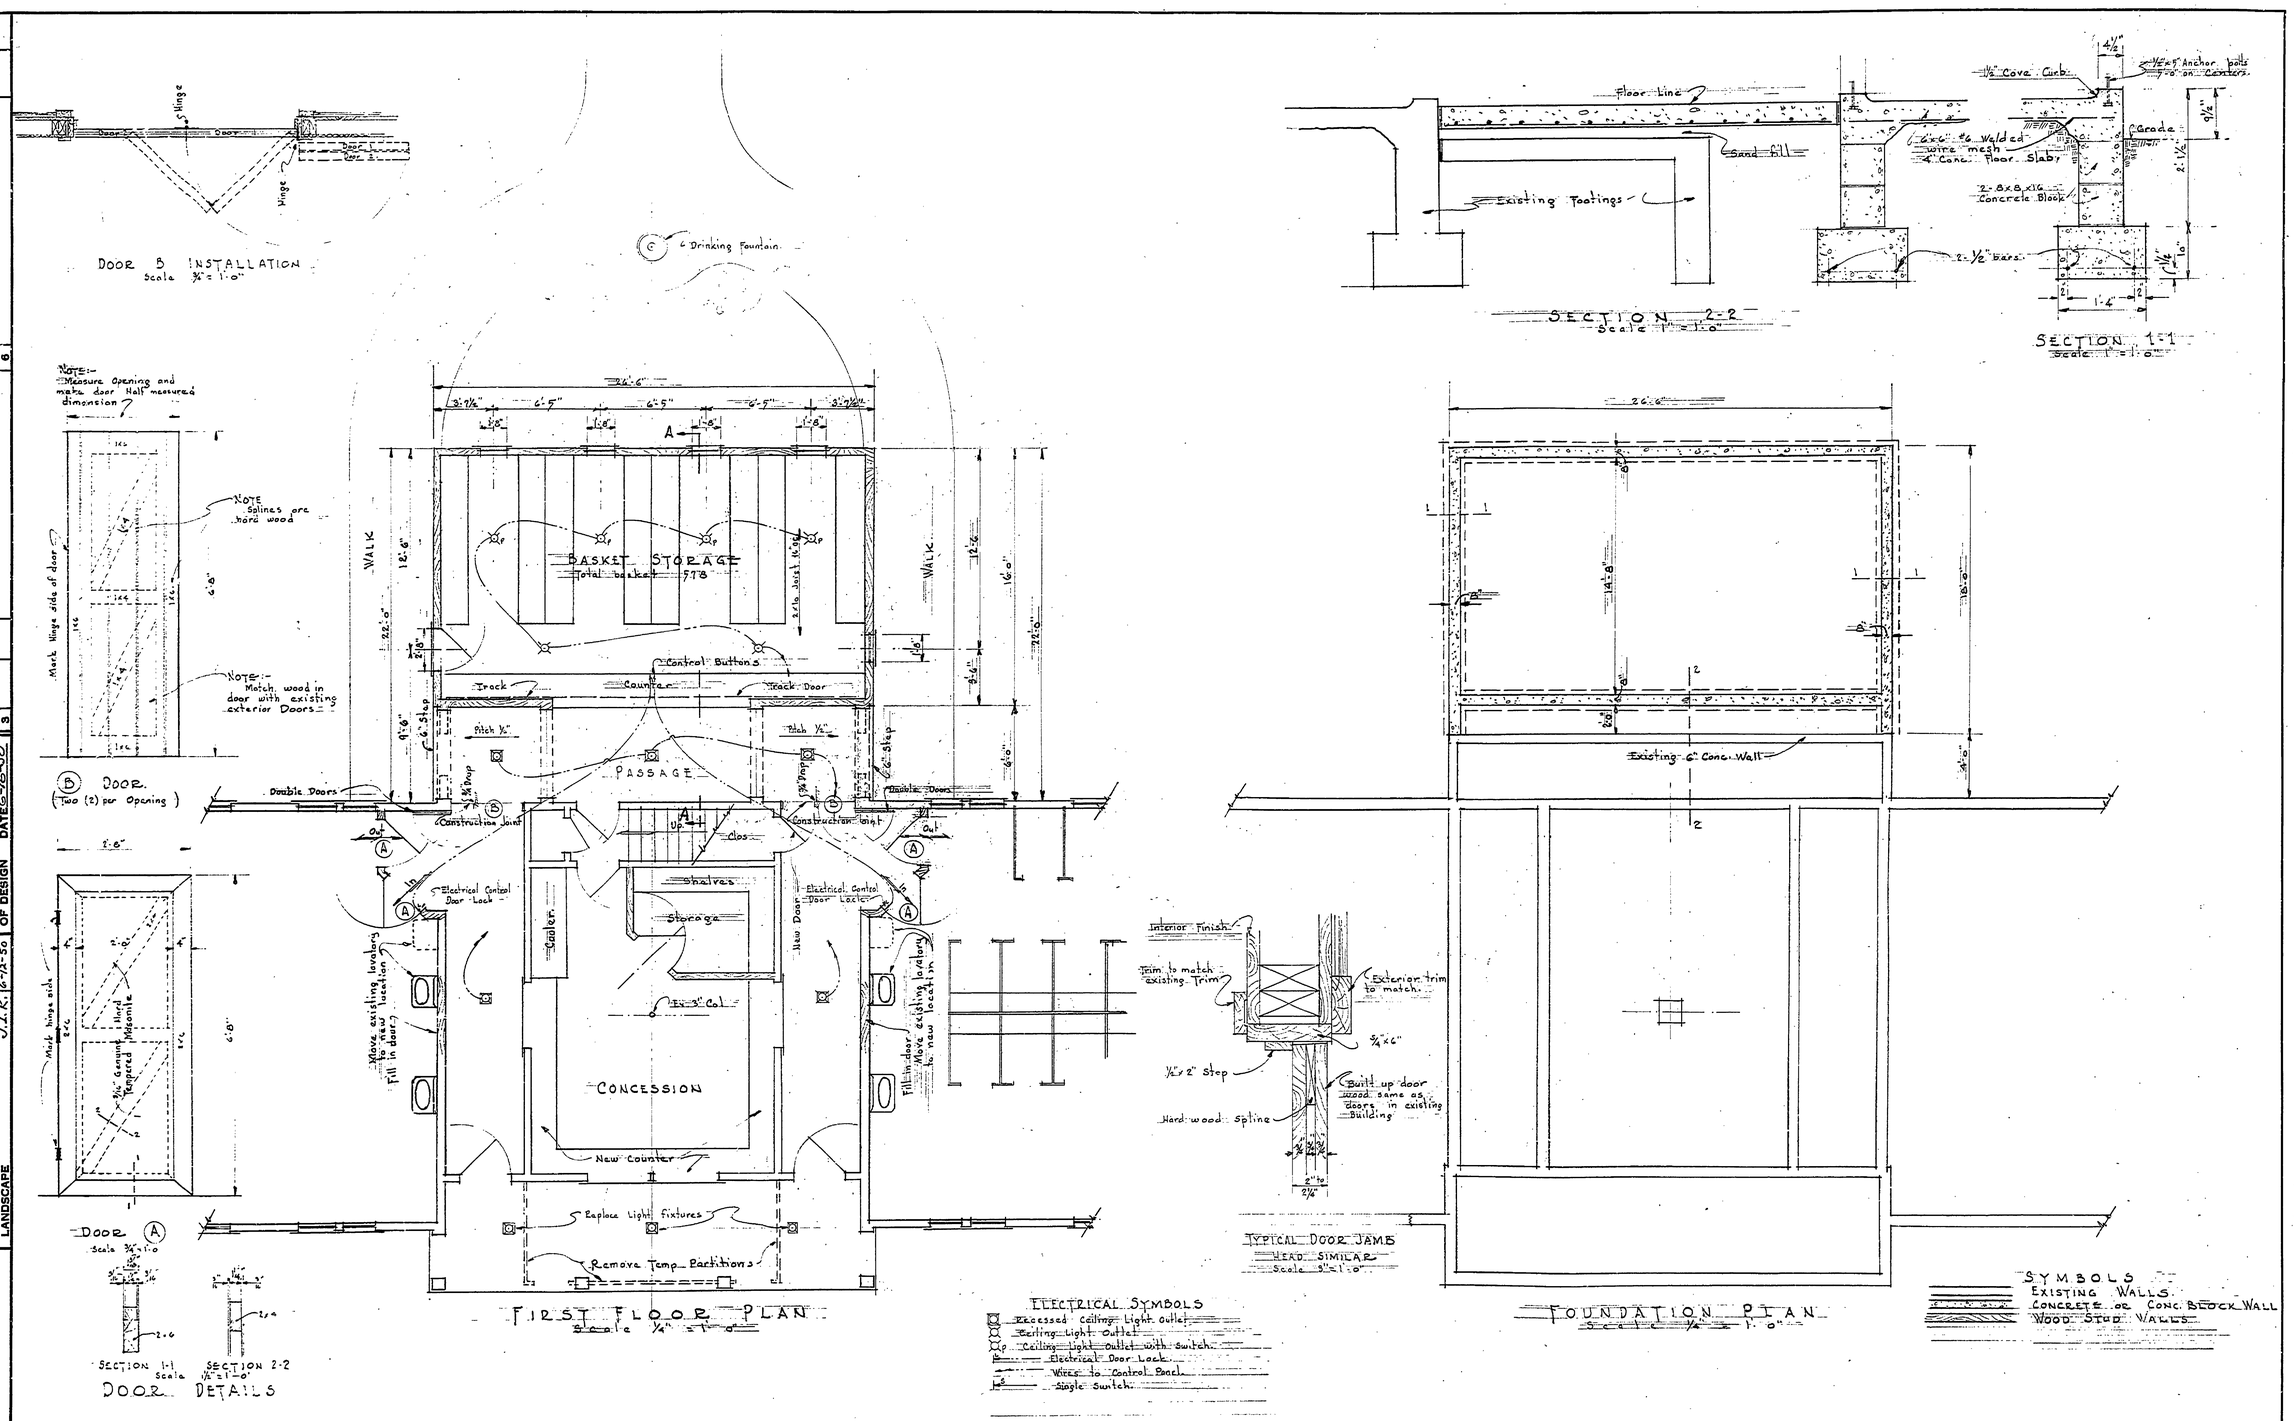

NO.	DATE	BY	REVISIONS
1	1/10/52	J.I.R. J.W.F.	Doors, Door Frames, Details and Electrical Light outlets added, see this sheet.
2			
3			
4			
5			
6			

		DATE
APPROVED BY		
ASSISTANT CHIEF IN CHARGE OF DESIGN		DATE 6-12-50

REVIEWED BY SECTIONS		DATE
ARCHITECTURAL	J.I.R.	6-12-50
ENGINEERING	H.C.M.	1.26.50
LANDSCAPE	J.I.R.	6-12-50

DESIGNED BY J. Wm. Greenwood
DRAWN BY J.W.F.
TRACED BY
CHECKED BY
DATE

MICHIGAN
DEPARTMENT OF CONSERVATION
PARKS AND RECREATION DIVISION

SLEEPER STATE PARK
ENLARGING CONCESSION
BATH HOUSE BLDG.

SHEET NO. 1 OF 2

PLAN NO. A105