COMMERCIAL BLUEPRINT SERVICE 600 6-59

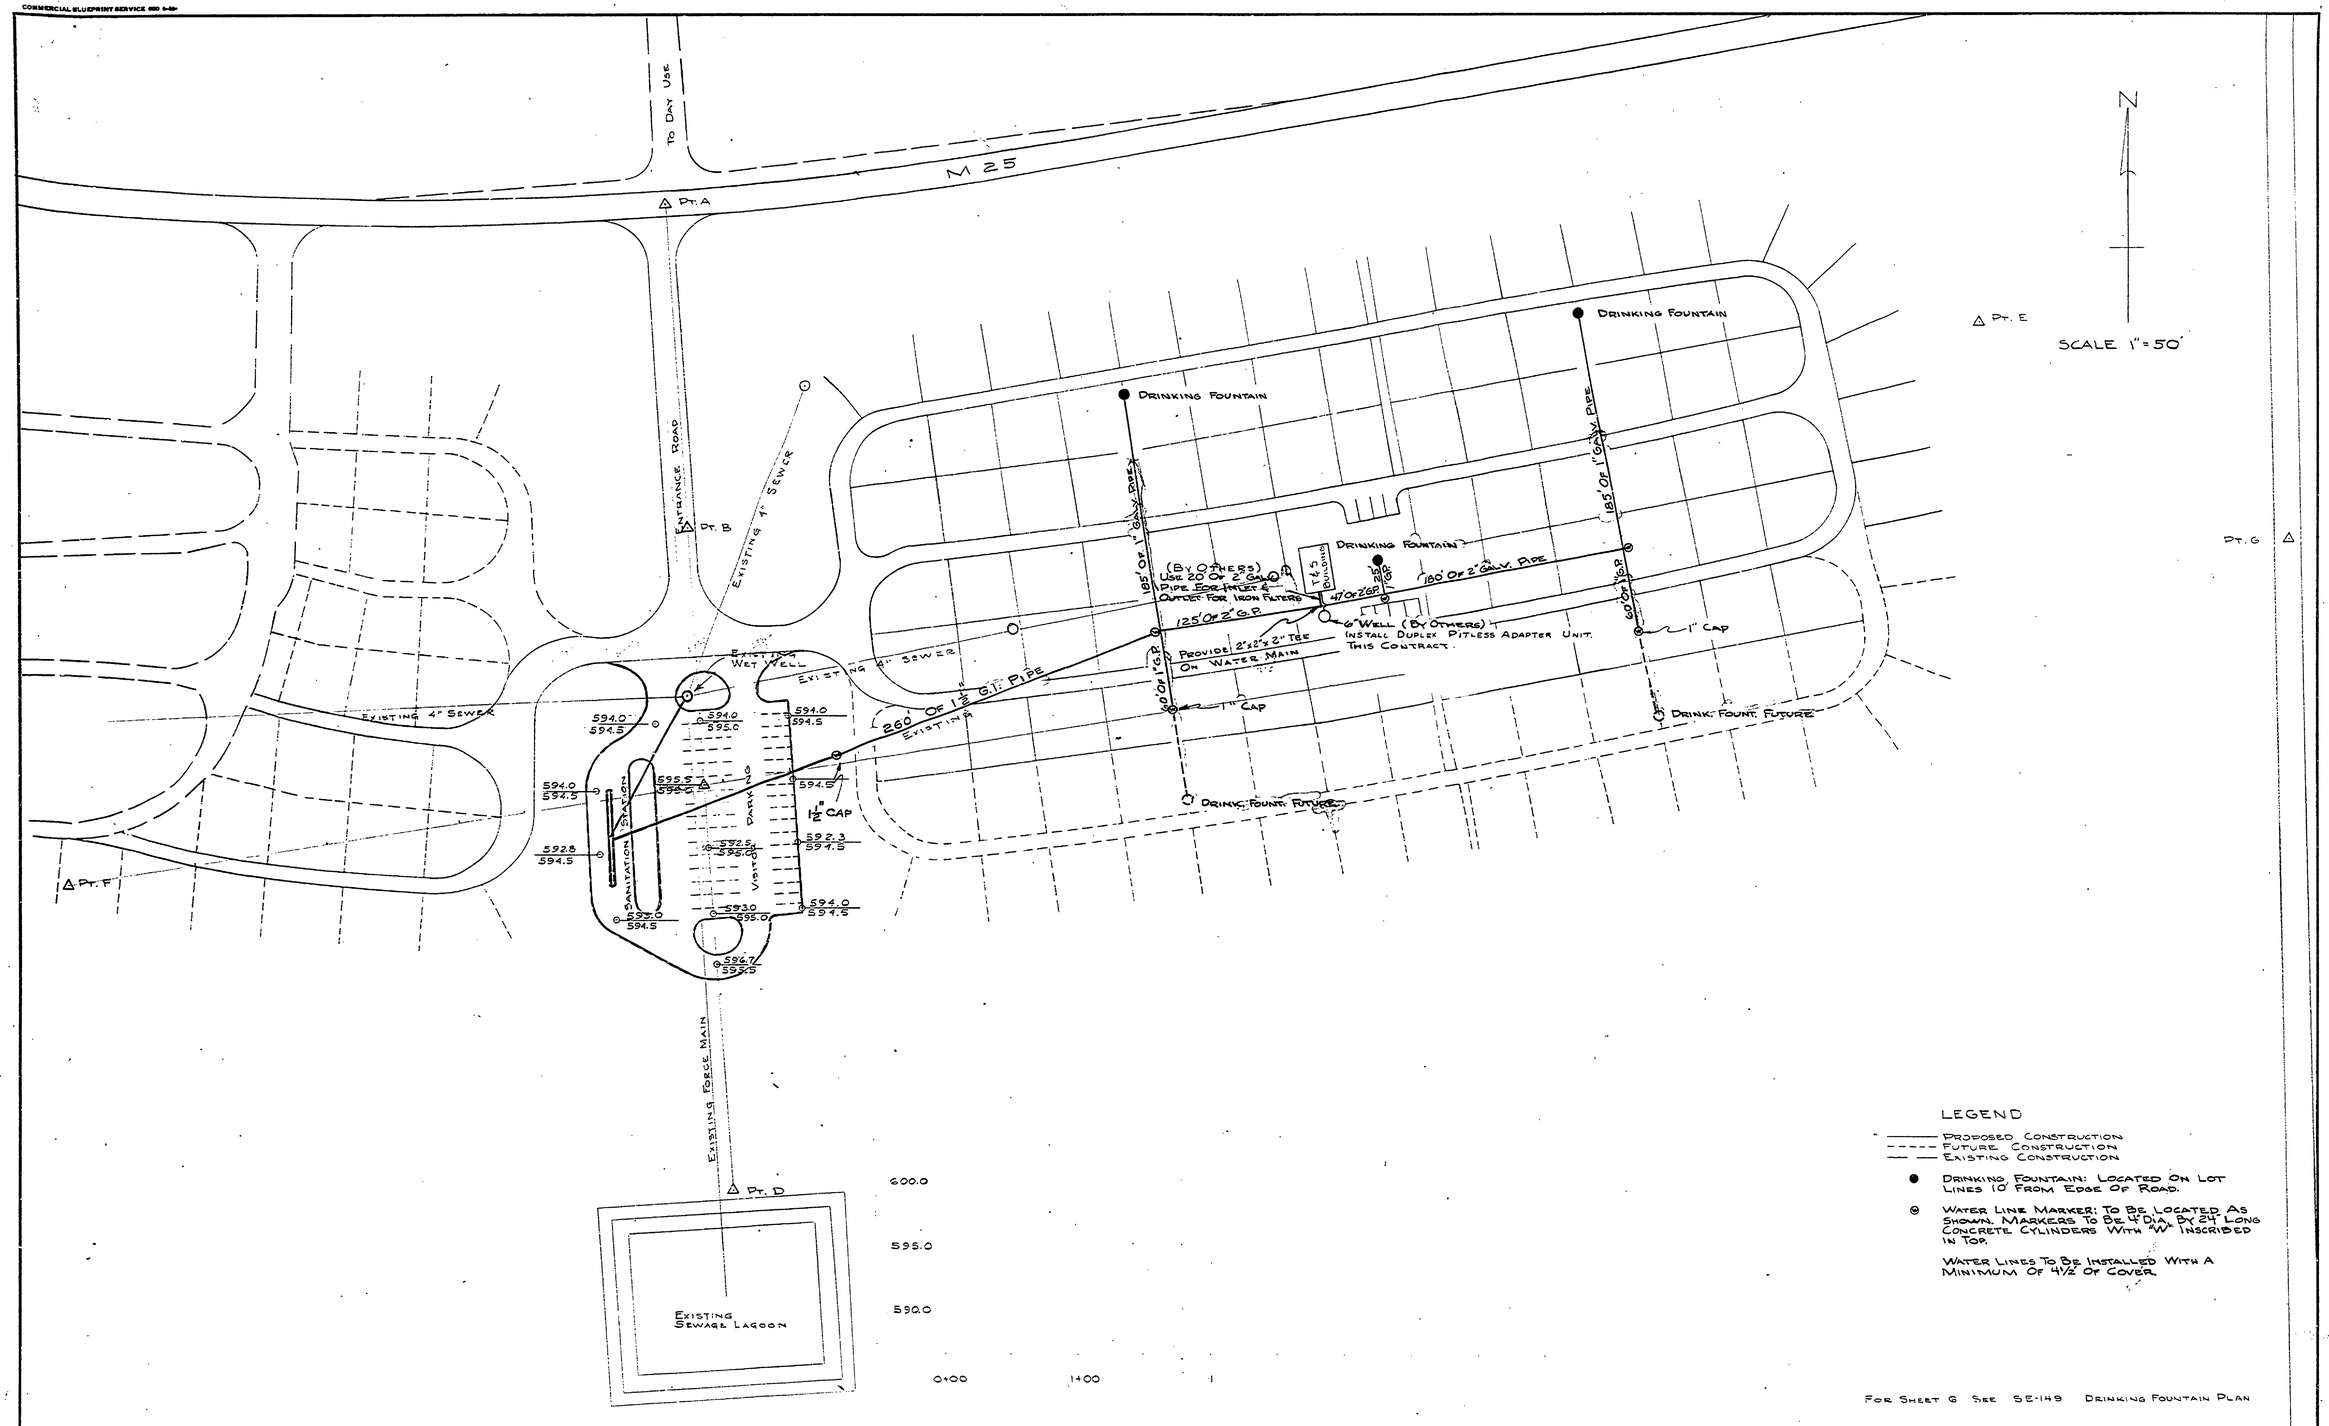

SURVEYED BY		DRAWN BY R.H.M.	6-67	NO.	DATE	BY	REVISIONS	NO.	DATE	BY	REVISIONS
DESIGNED BY R.H.M.	6-67	CHECKED BY		1.	9-68	EHB	ADDED GRADES TO PARKING LOT	3.			
	DATE		DATE	2.				4.			

MICHIGAN
DEPARTMENT OF CONSERVATION

WATER SYSTEM

SHEET NO. ____ OF ____
FOR PROJECT NO. ~~A999-9972-976-031~~ C2.562

SLEEPER STATE PARK
SHEET 5 OF 8 | PLAN NO. E-118