


DESIGNED BY	DATE	REVIEWED	DATE	APPROVED	DATE	NO.	DATE	BY	REVISIONS	DATE	BY
DRAWN BY	S.S.	ARCHITECTURAL				1			4		
CHECKED BY		ENGINEERING				2			5		
		LANDSCAPE				3			6		

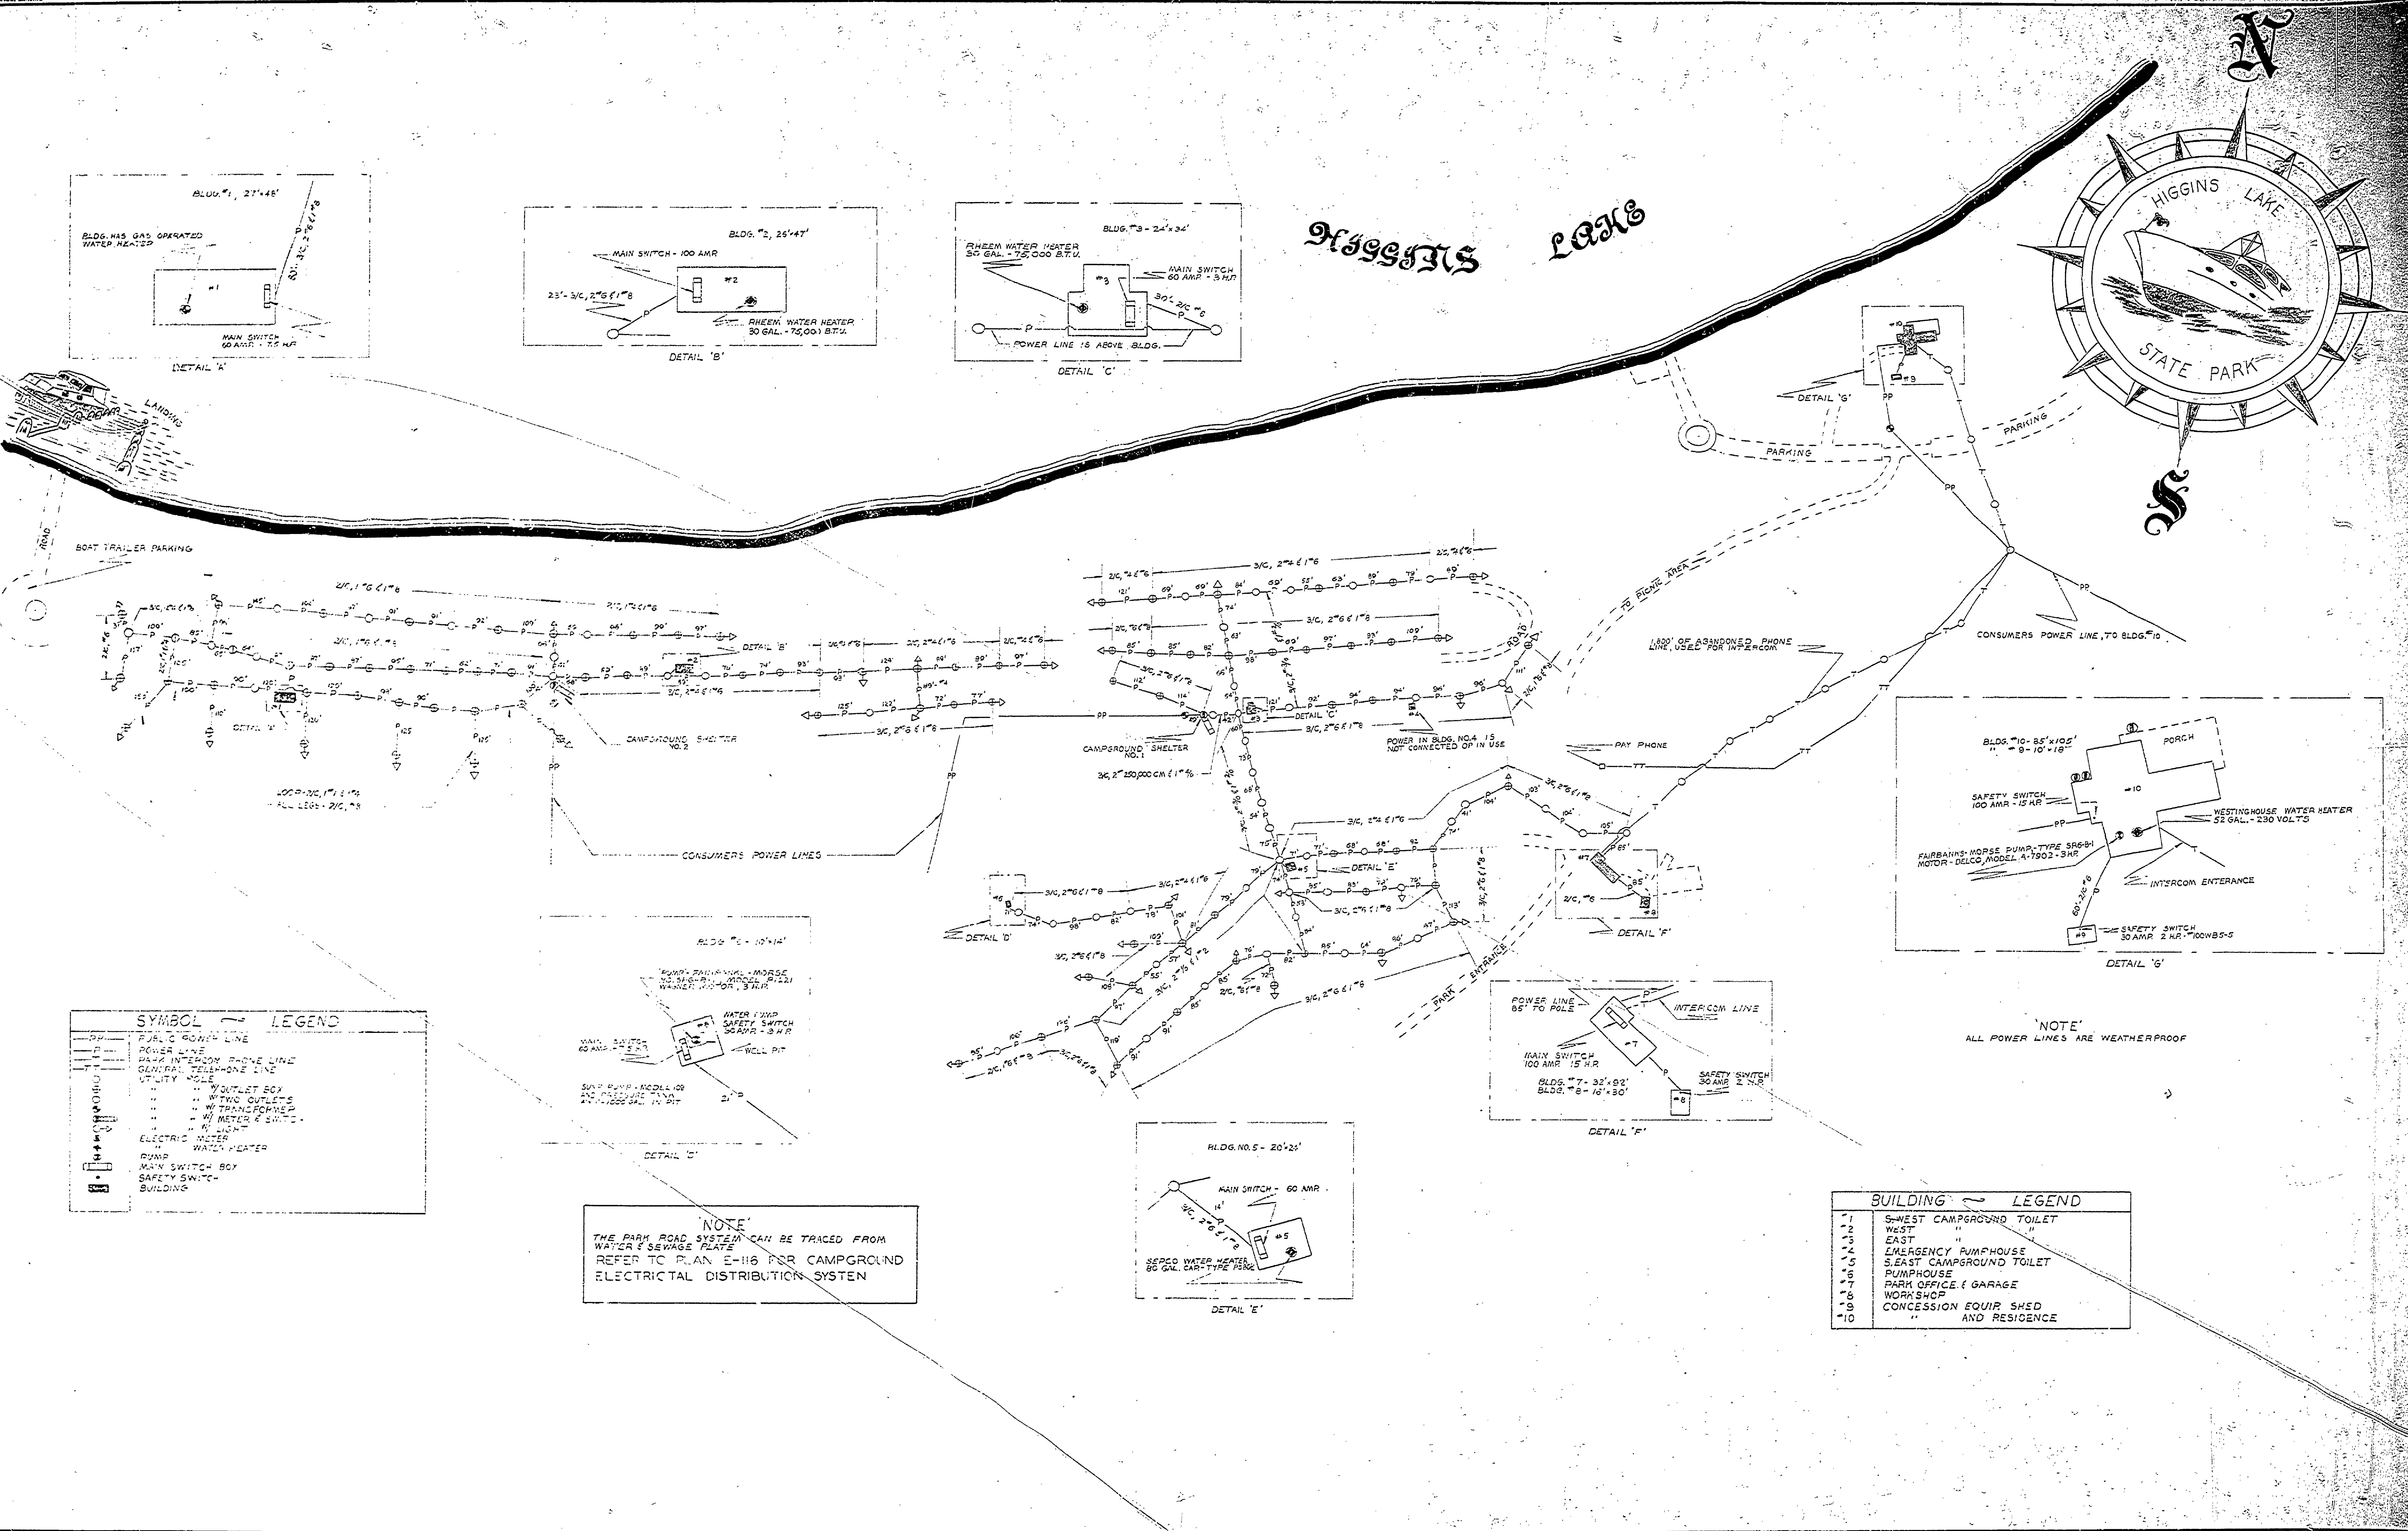

# HIGGINS LAKE STATE PARK

SCALE: 1" = 200'

MICHIGAN DEPARTMENT OF CONSERVATION PARKS AND RECREATION DIVISION

HIGGINS LAKE STATE PARK UTILITY MAP ELECTRICAL DISTRIBUTION SYSTEM

SHEET NO. 1 OF 2 PLAN NO. U-1