



DATE BY	REVISIONS	NO.	DATE	BY
	1	1/15/51	E.J.P.	Plum. Inst. Division Electrical Revision
	2			
	3			
	4			
	5			
	6			

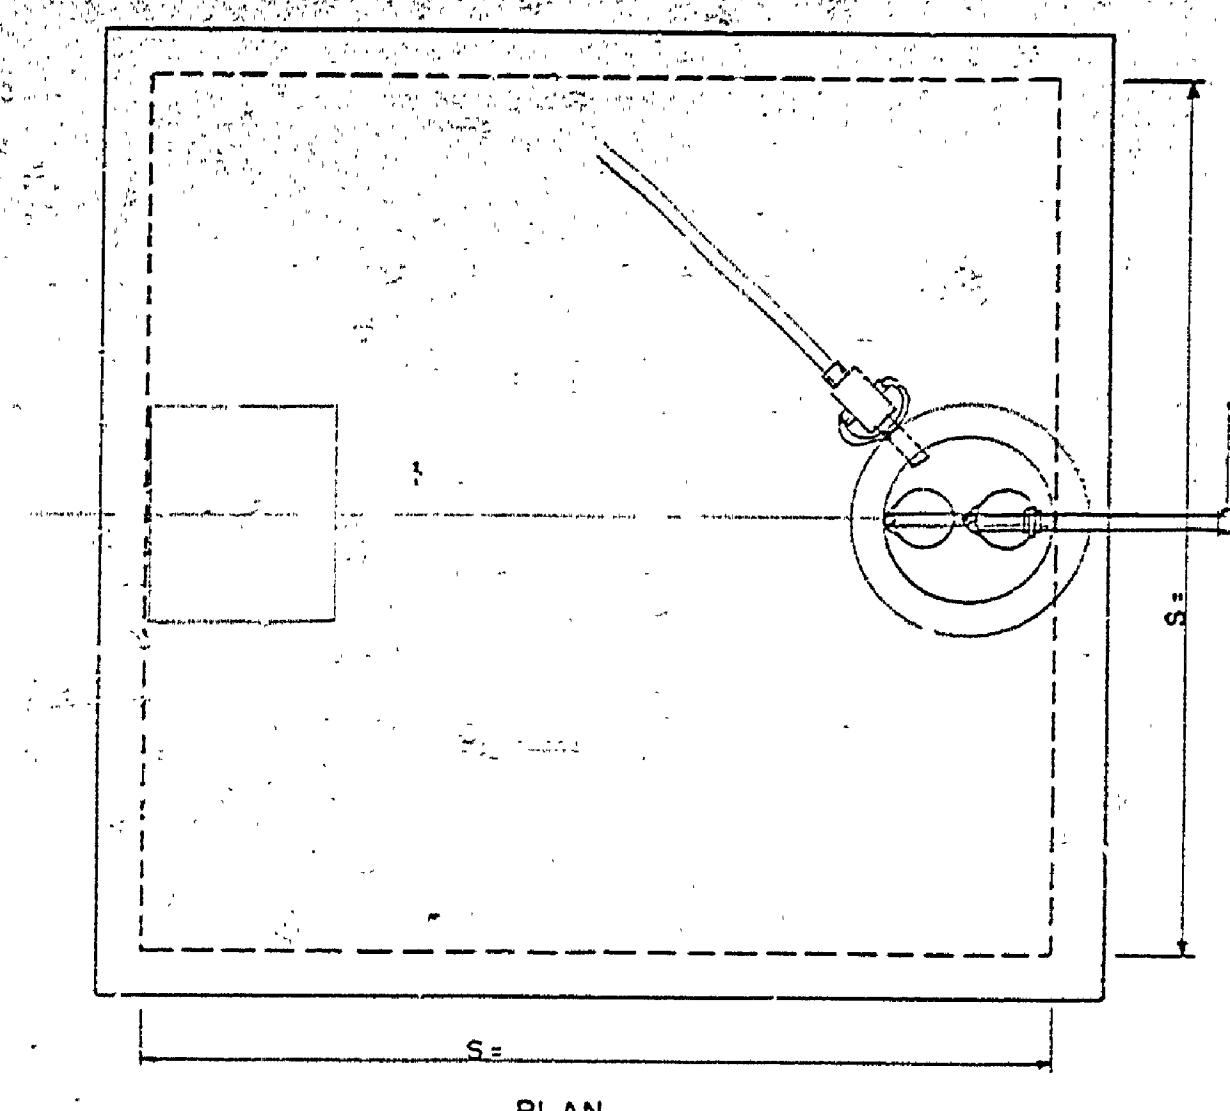


PLAN

NOTES FOR DOSING CHAMBER
SEE PLAN NO. SE-118 FOR STEEL REINFORCING DETAILS AND DETAIL DIMENSIONS OF DOSING CHAMBER BEAM.
USE SIPHON WITH DRAWDOWN.
USE S= H= K= H=

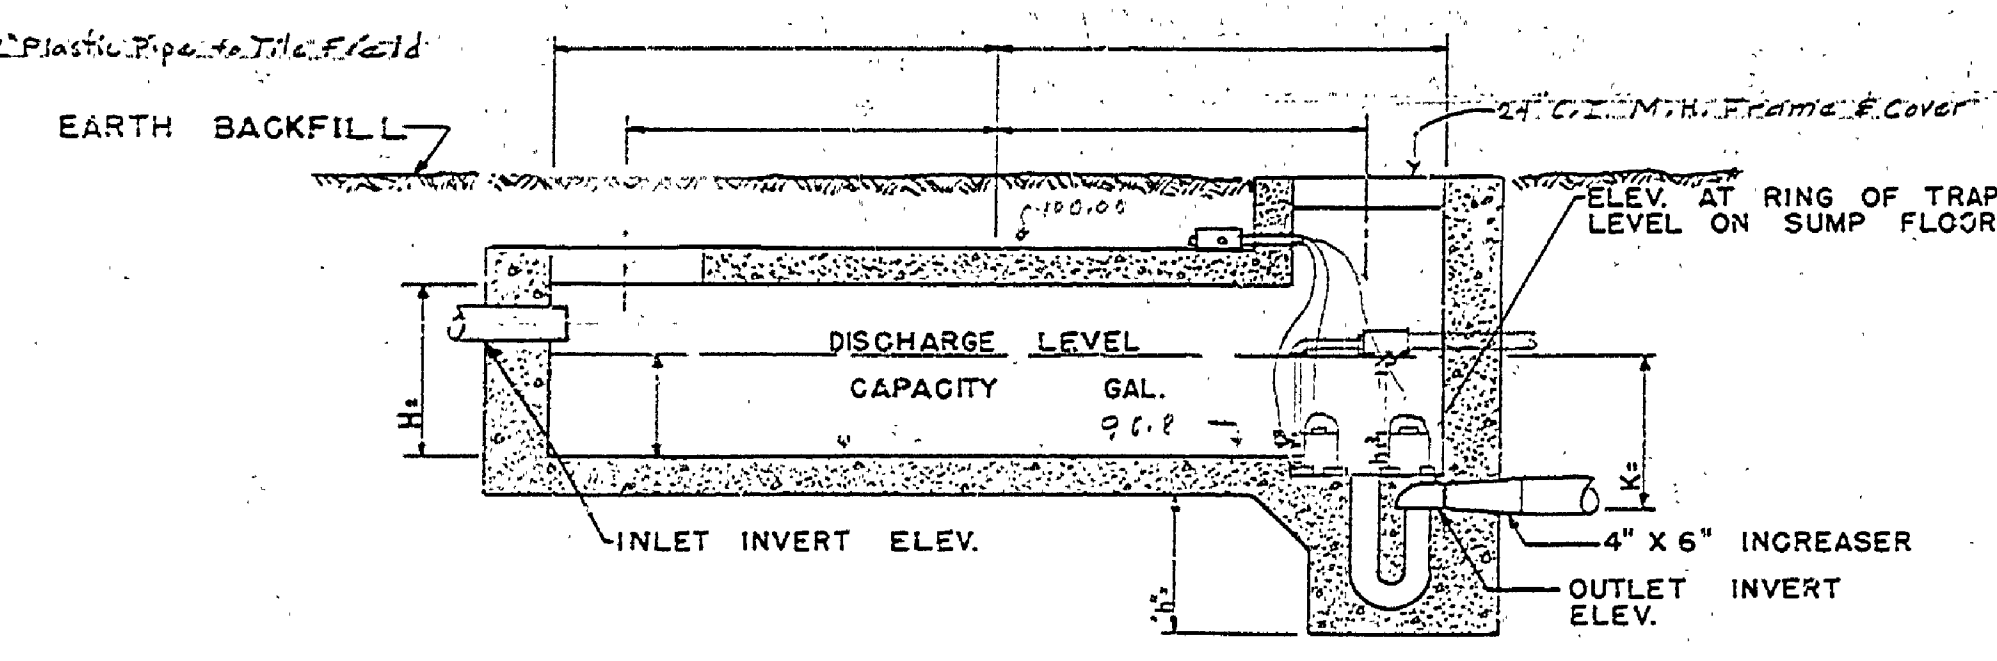


SECTION B-B

DOSING CHAMBER
NOT TO SCALE

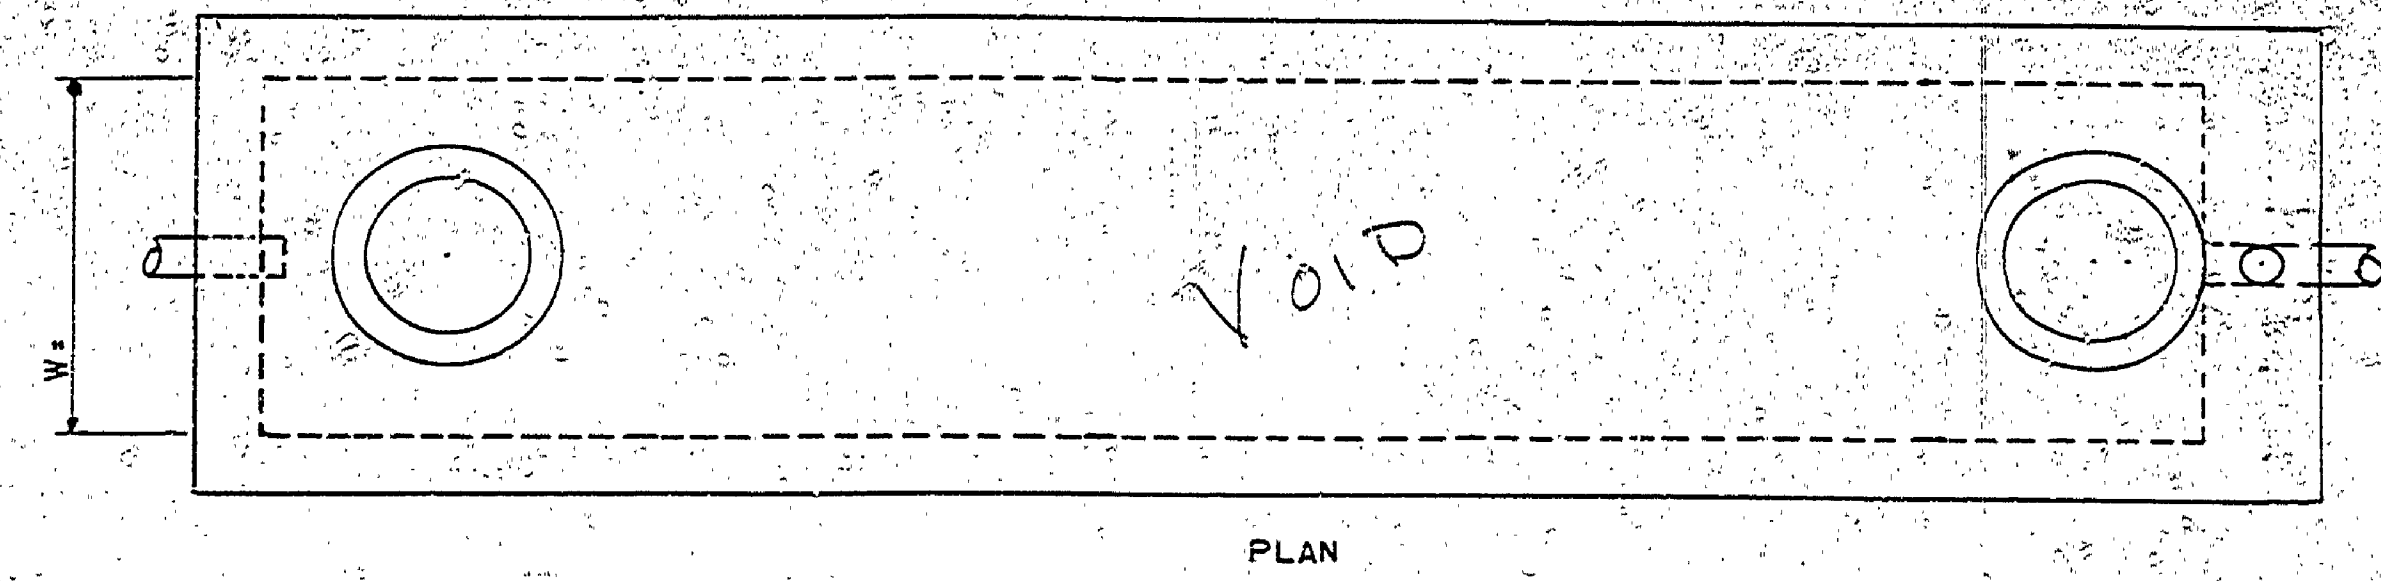


PLAN


NOTES FOR SEPTIC TANK
SEE PLAN NO. SE-118 FOR STEEL REINFORCING DETAILS AND DETAIL DIMENSIONS.
USE L= W= H=

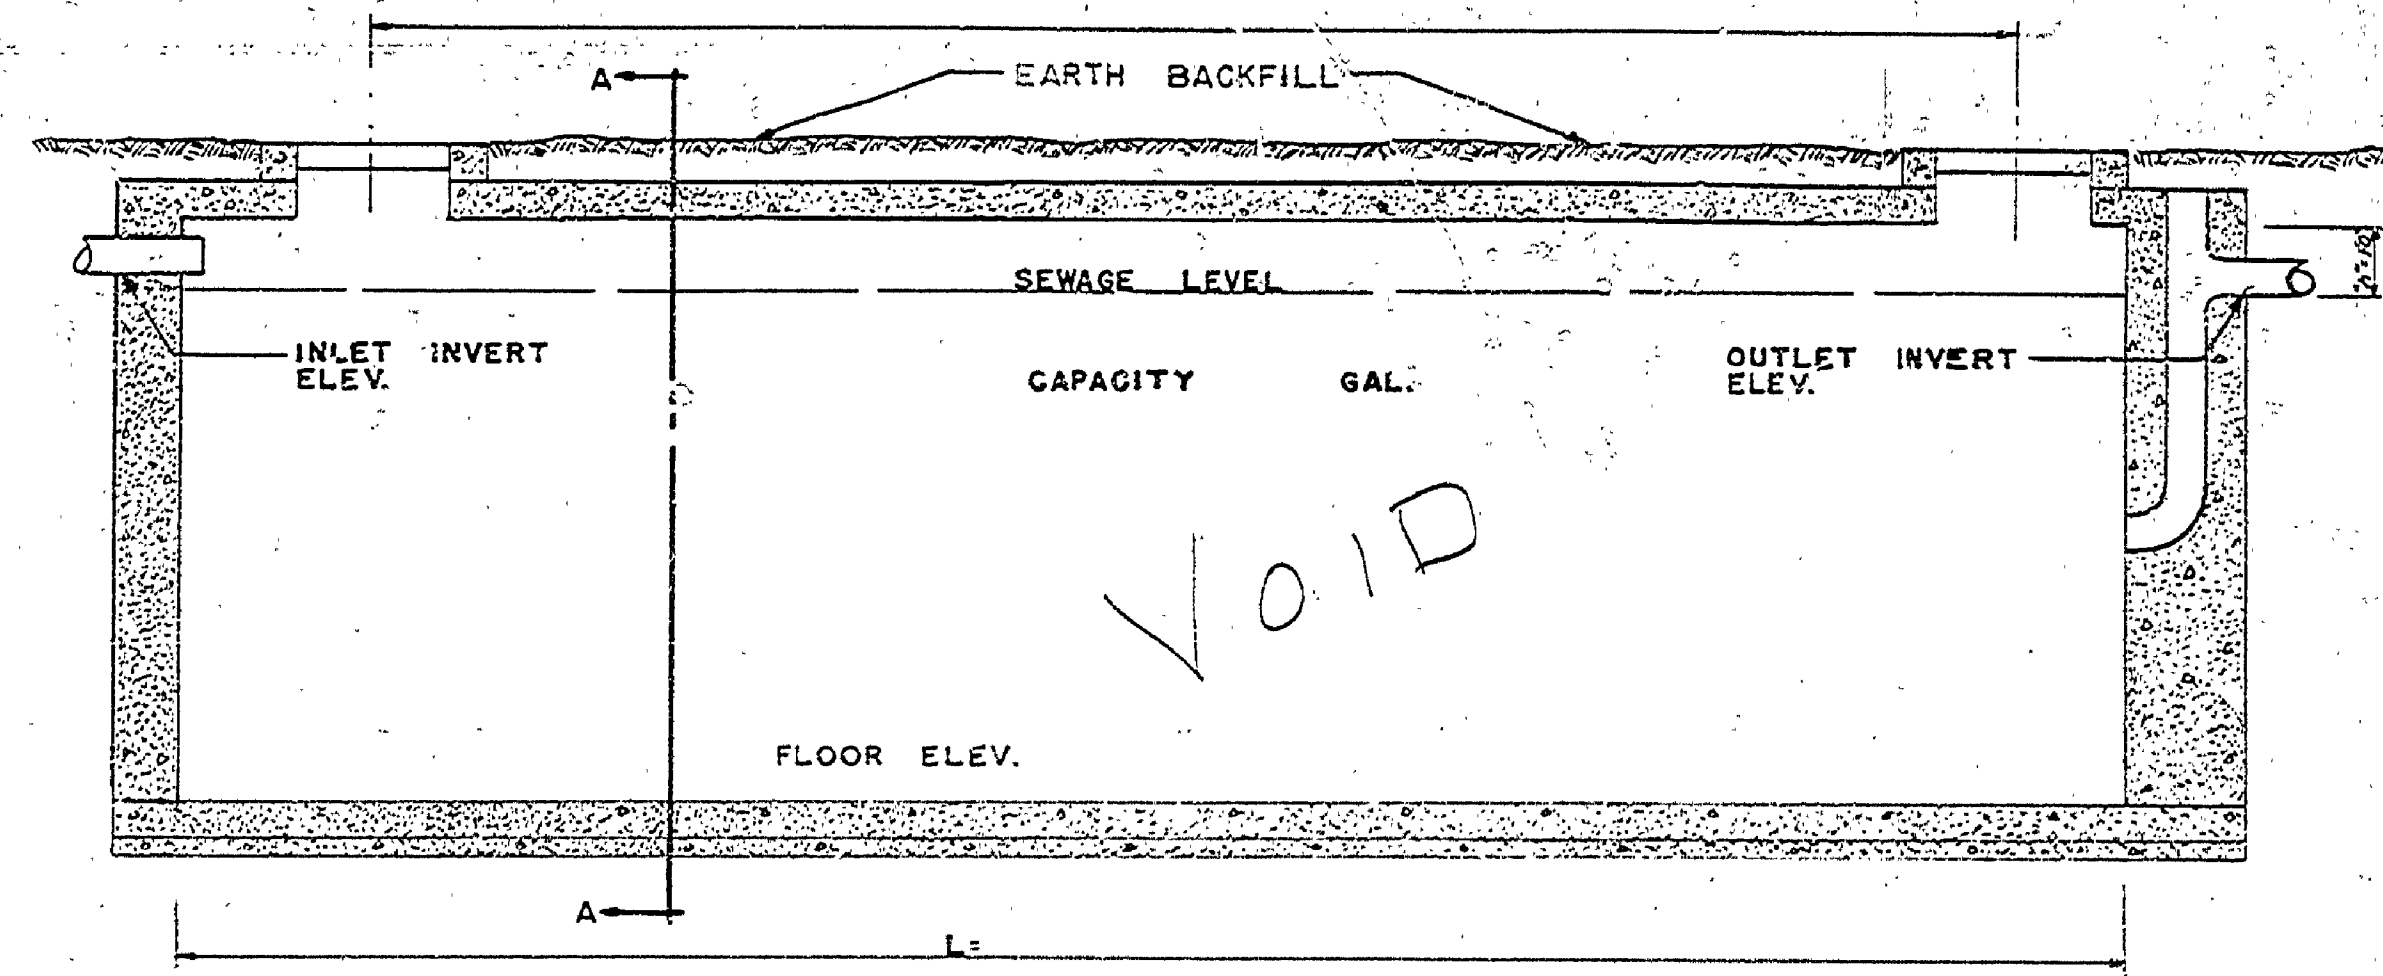

LONGITUDINAL SECTION
SEPTIC TANK
NOT TO SCALE

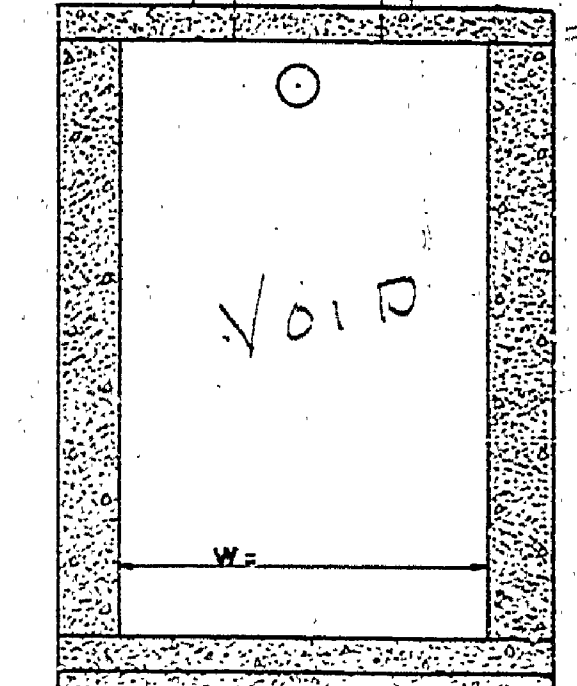


SECTION A-A

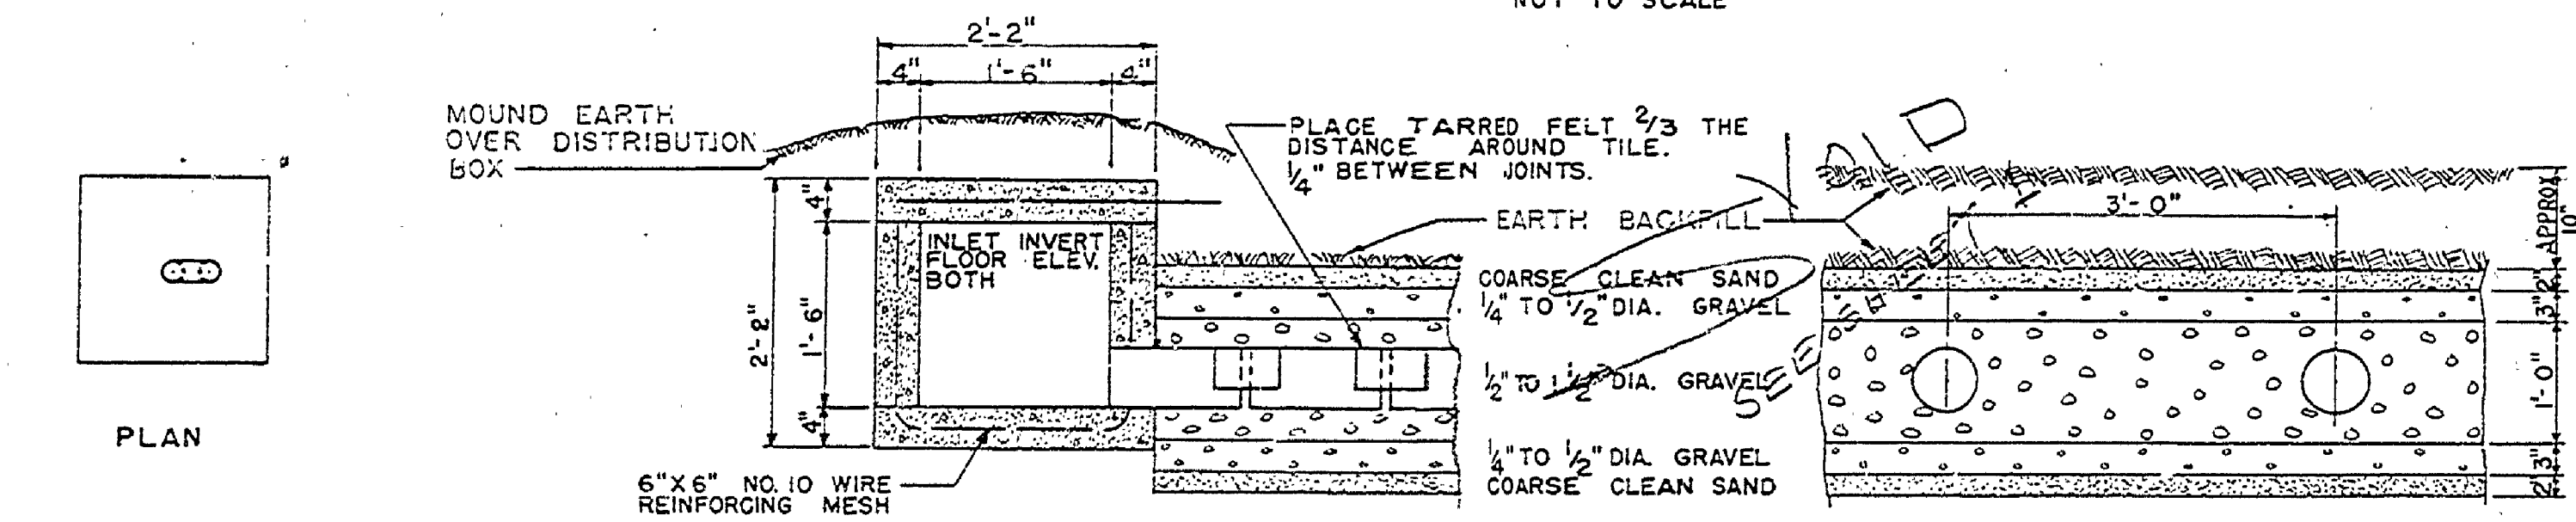


SECTION C-C

SECTION D-D


ELEVATION OF DISPOSAL FIELD
NOT TO SCALE

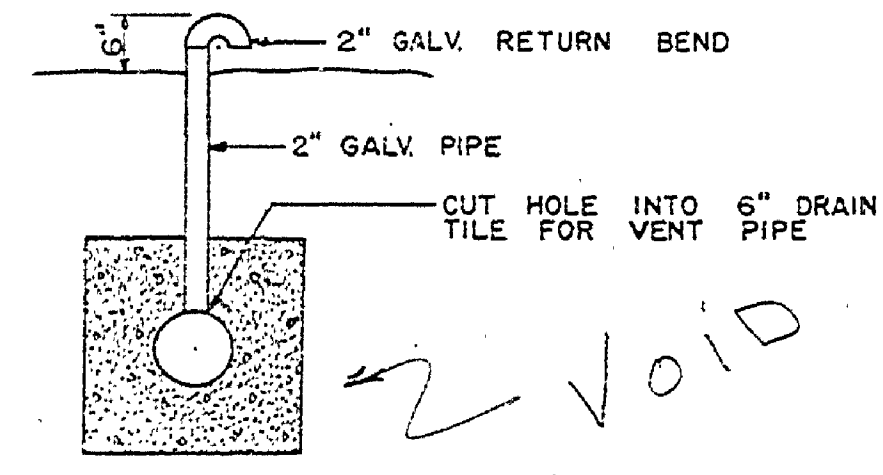


SECTION VENT DETAIL
NOT TO SCALE

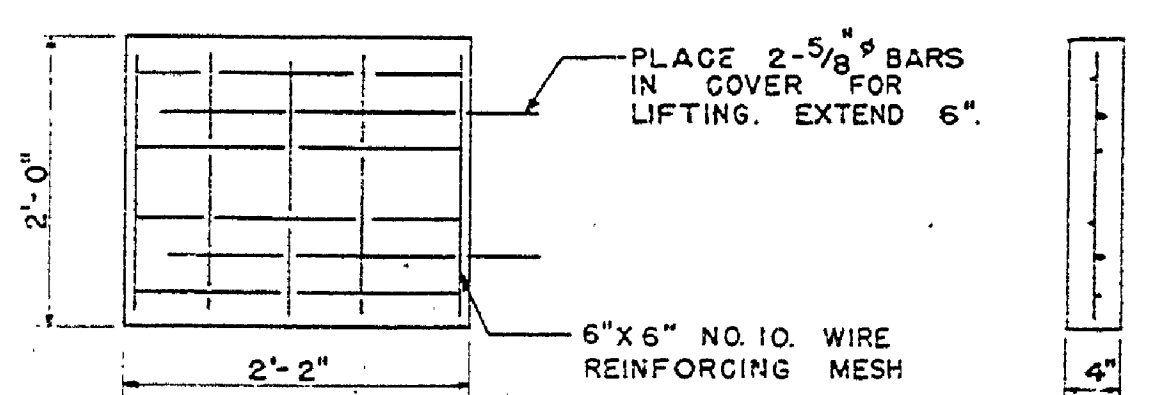


DISTRIBUTION BOX COVER
NOT TO SCALE

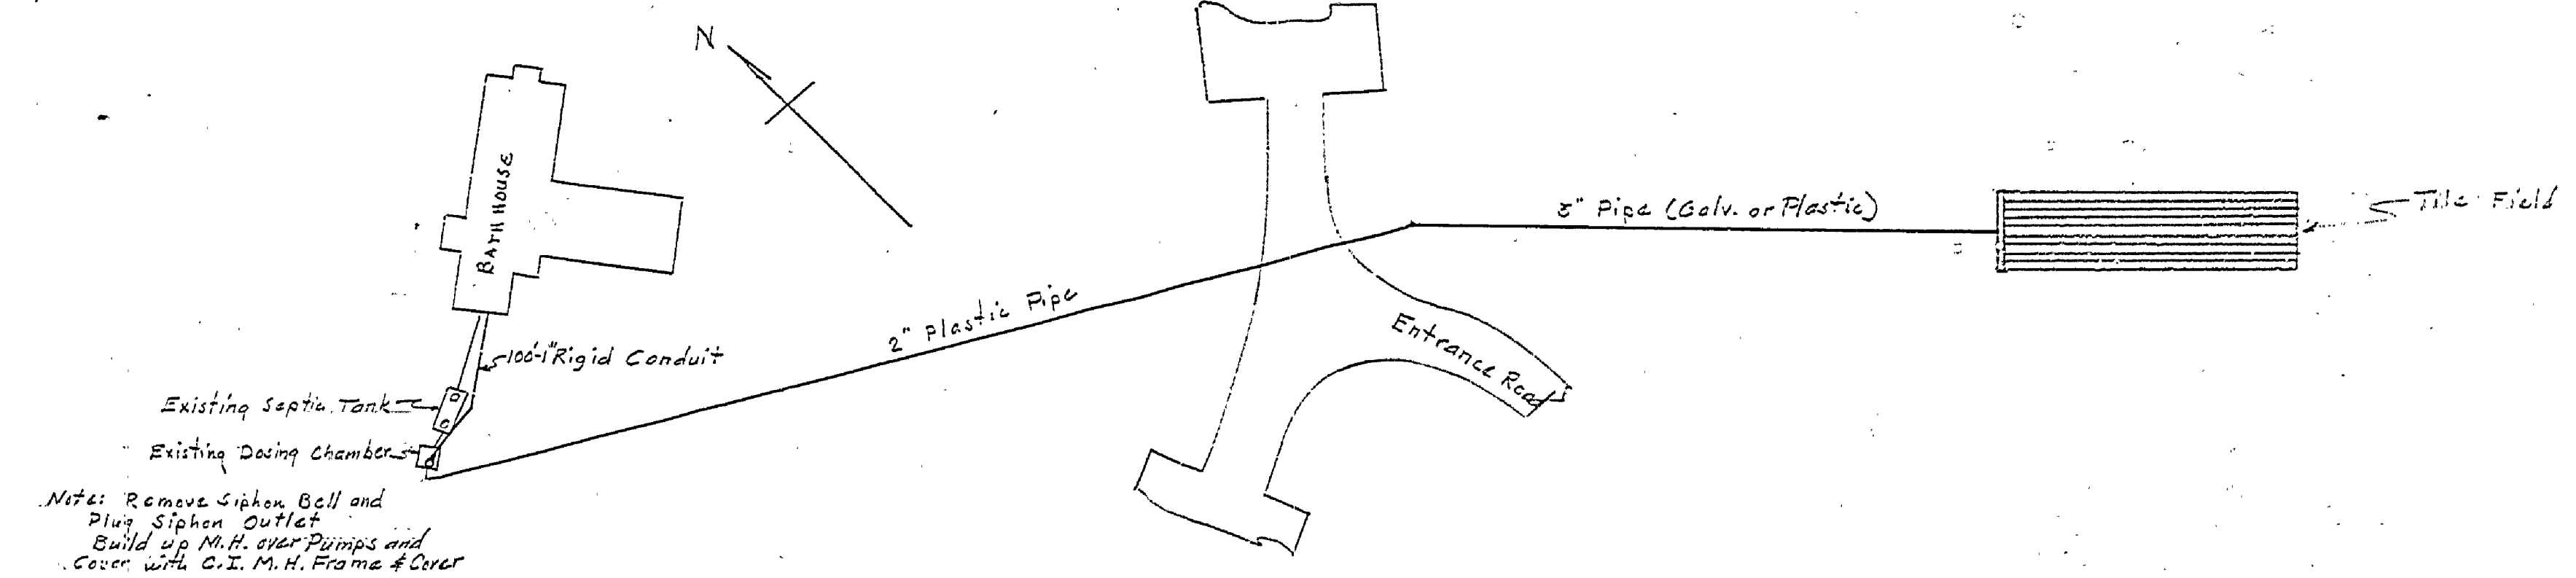


PLOT PLAN
SCALE 1"=50'

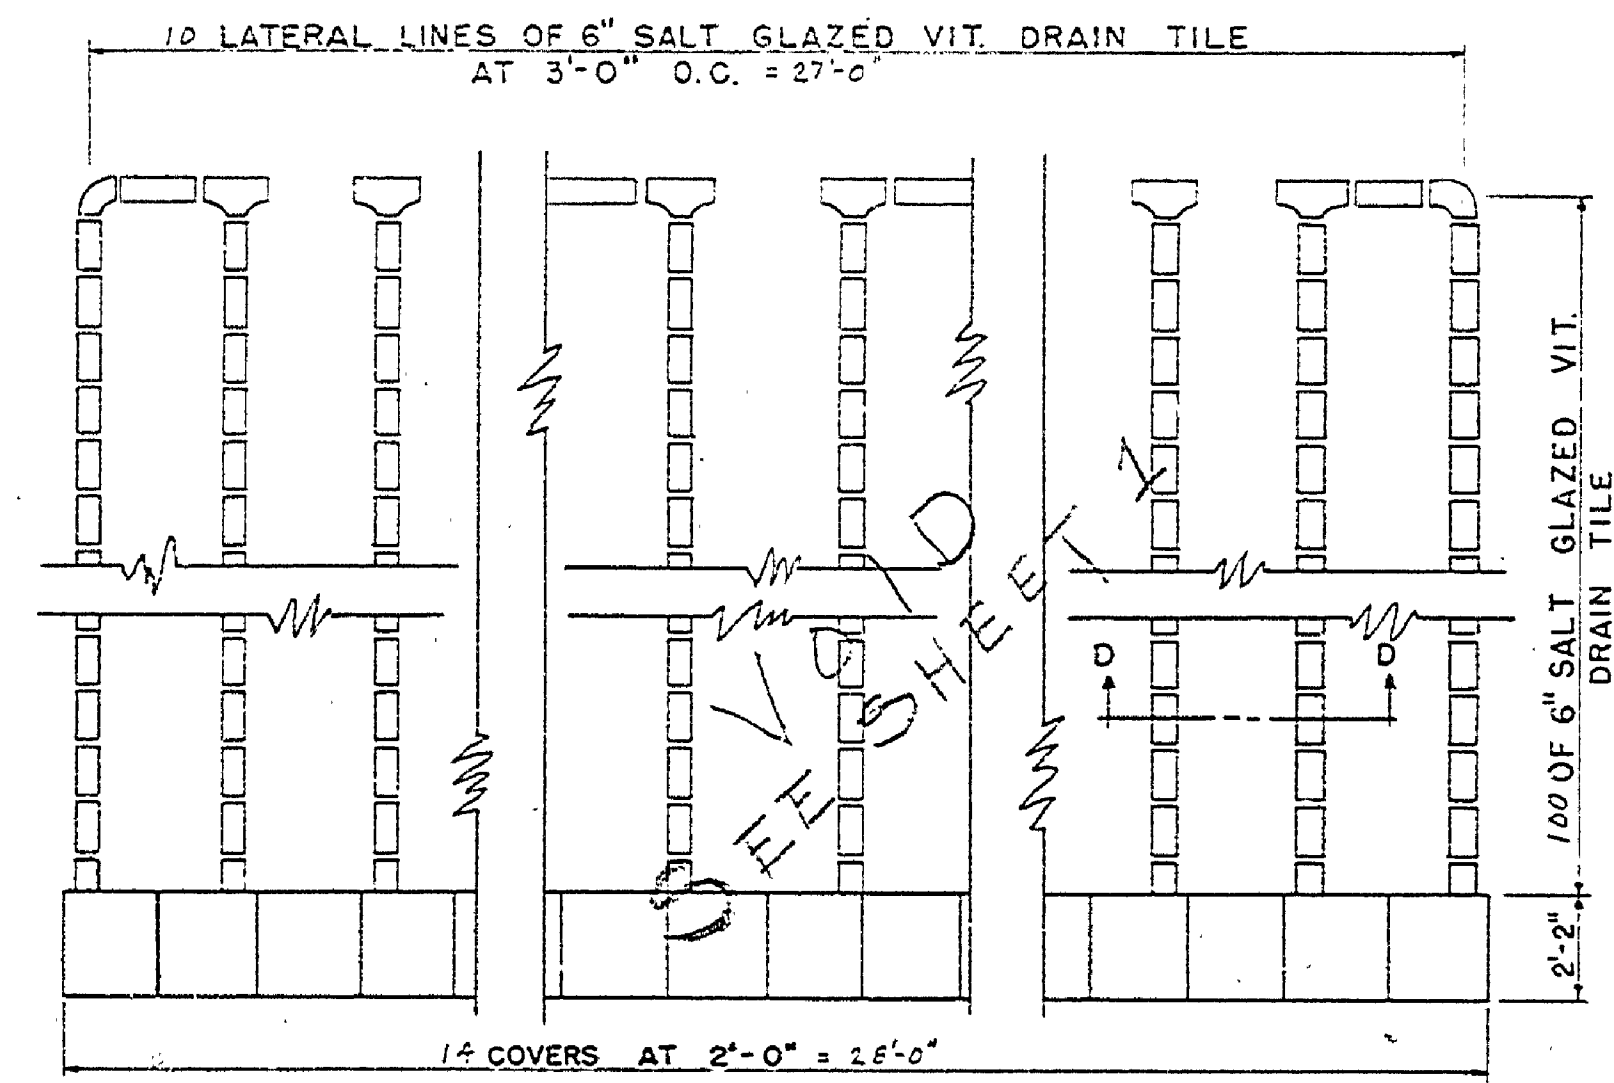


PLAN DISPOSAL FIELD
NOT TO SCALE

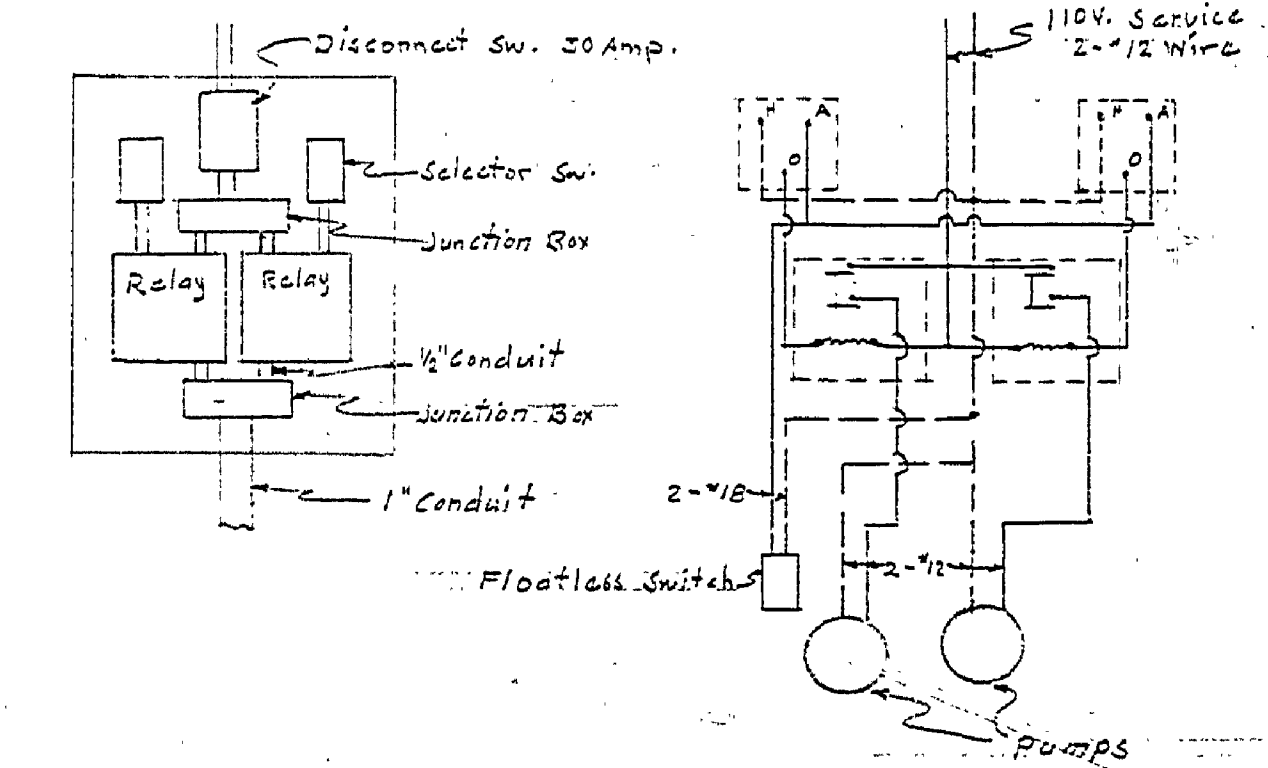

ELECTRICAL DETAILS
No Scale

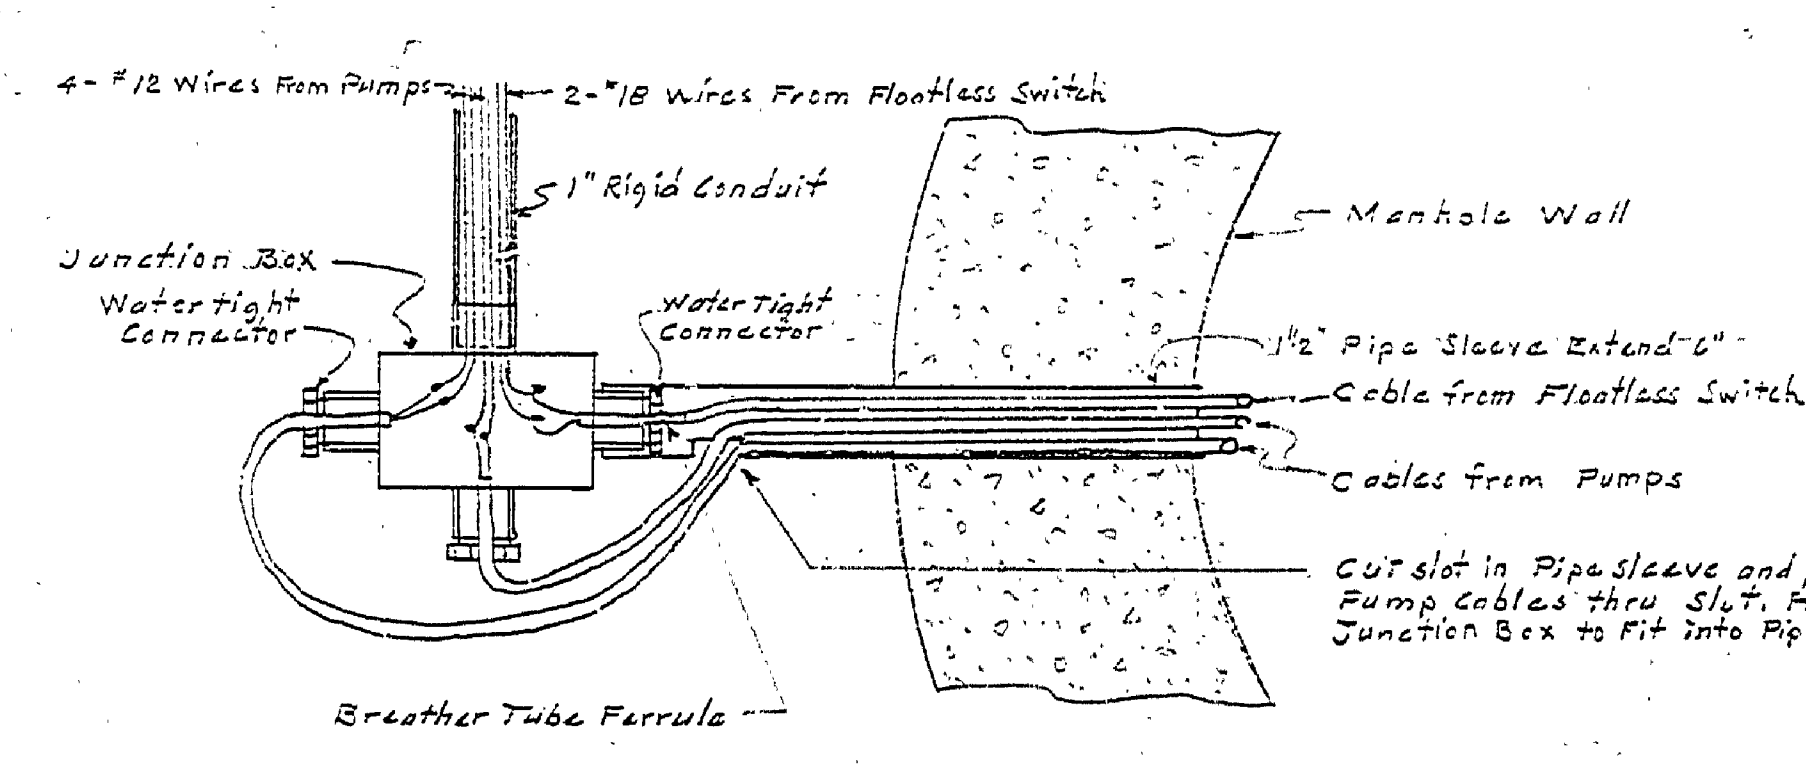

JUNCTION BOX DETAILS
SCALE 3"=1'0"

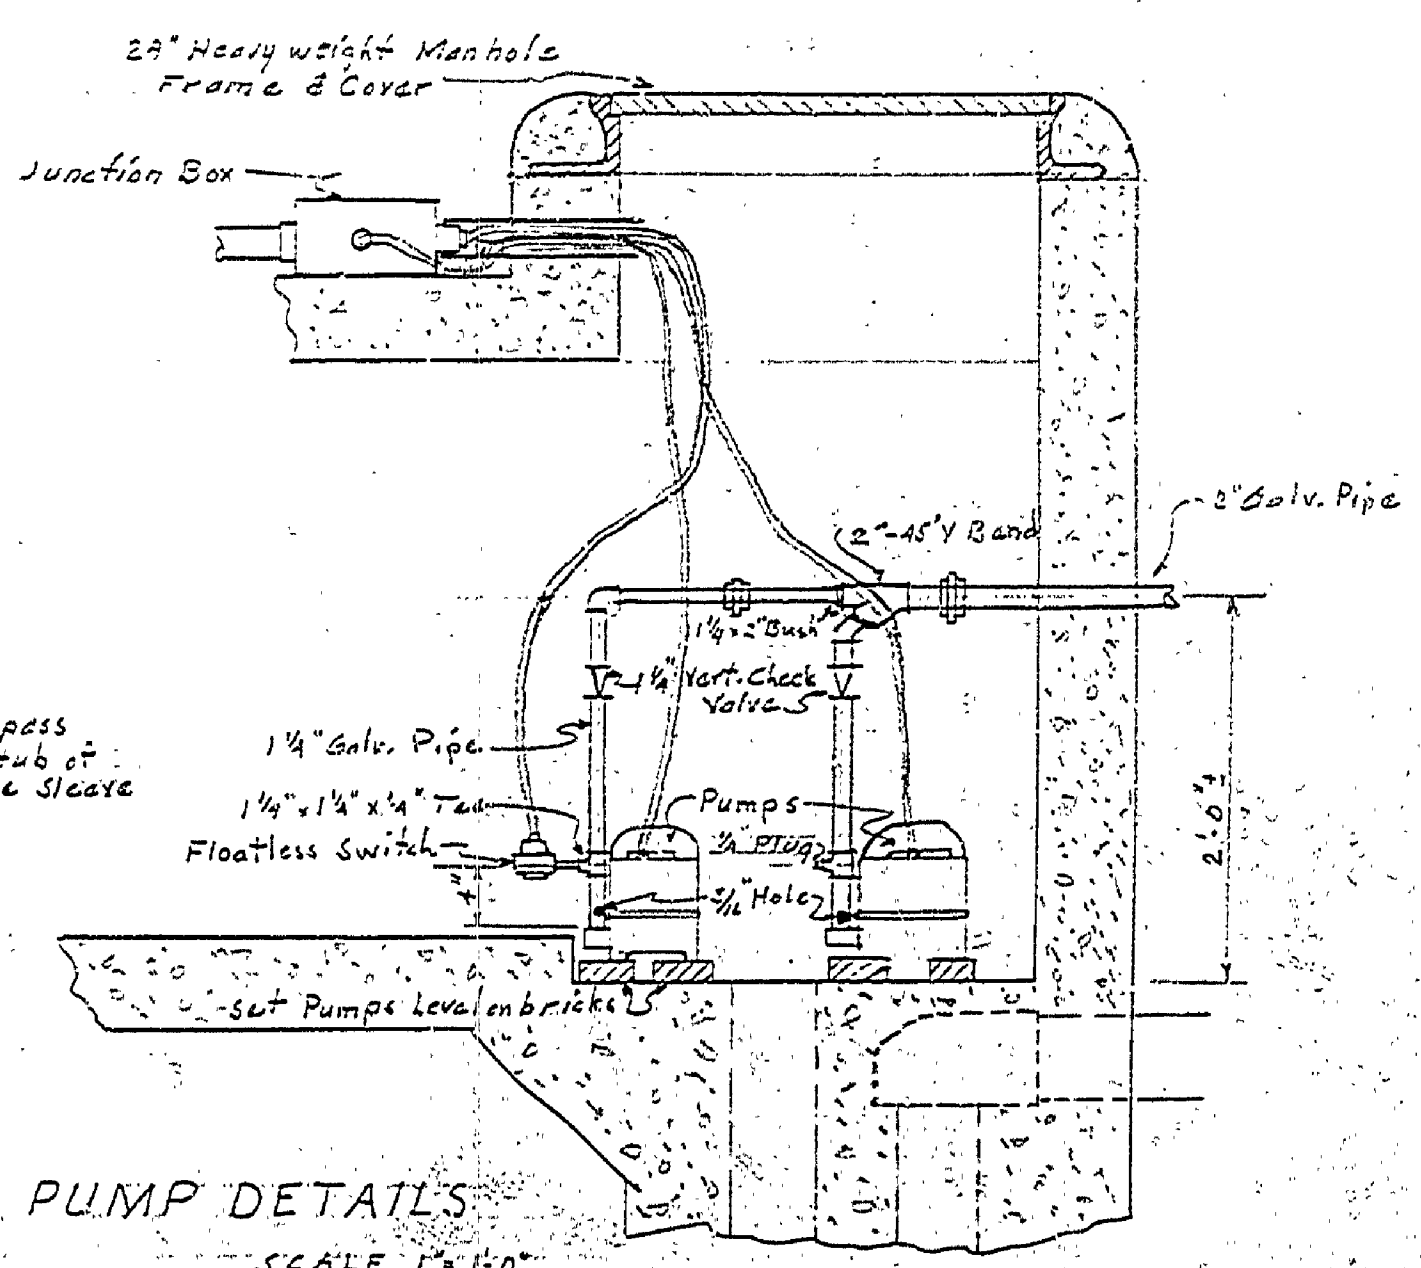

PUMP DETAILS
SCALE 1"=1'0"

MICHIGAN DEPARTMENT OF CONSERVATION
PARKS AND RECREATION DIVISION

HTG GINS LAKE STATE PARK
BATHHOUSE SEWAGE DISPOSAL SYSTEM
SCALE AS SHOWN

SHEET NO. 2 OF 2
PLAN NO. E-1108

STANDARD DISPOSAL SYSTEM