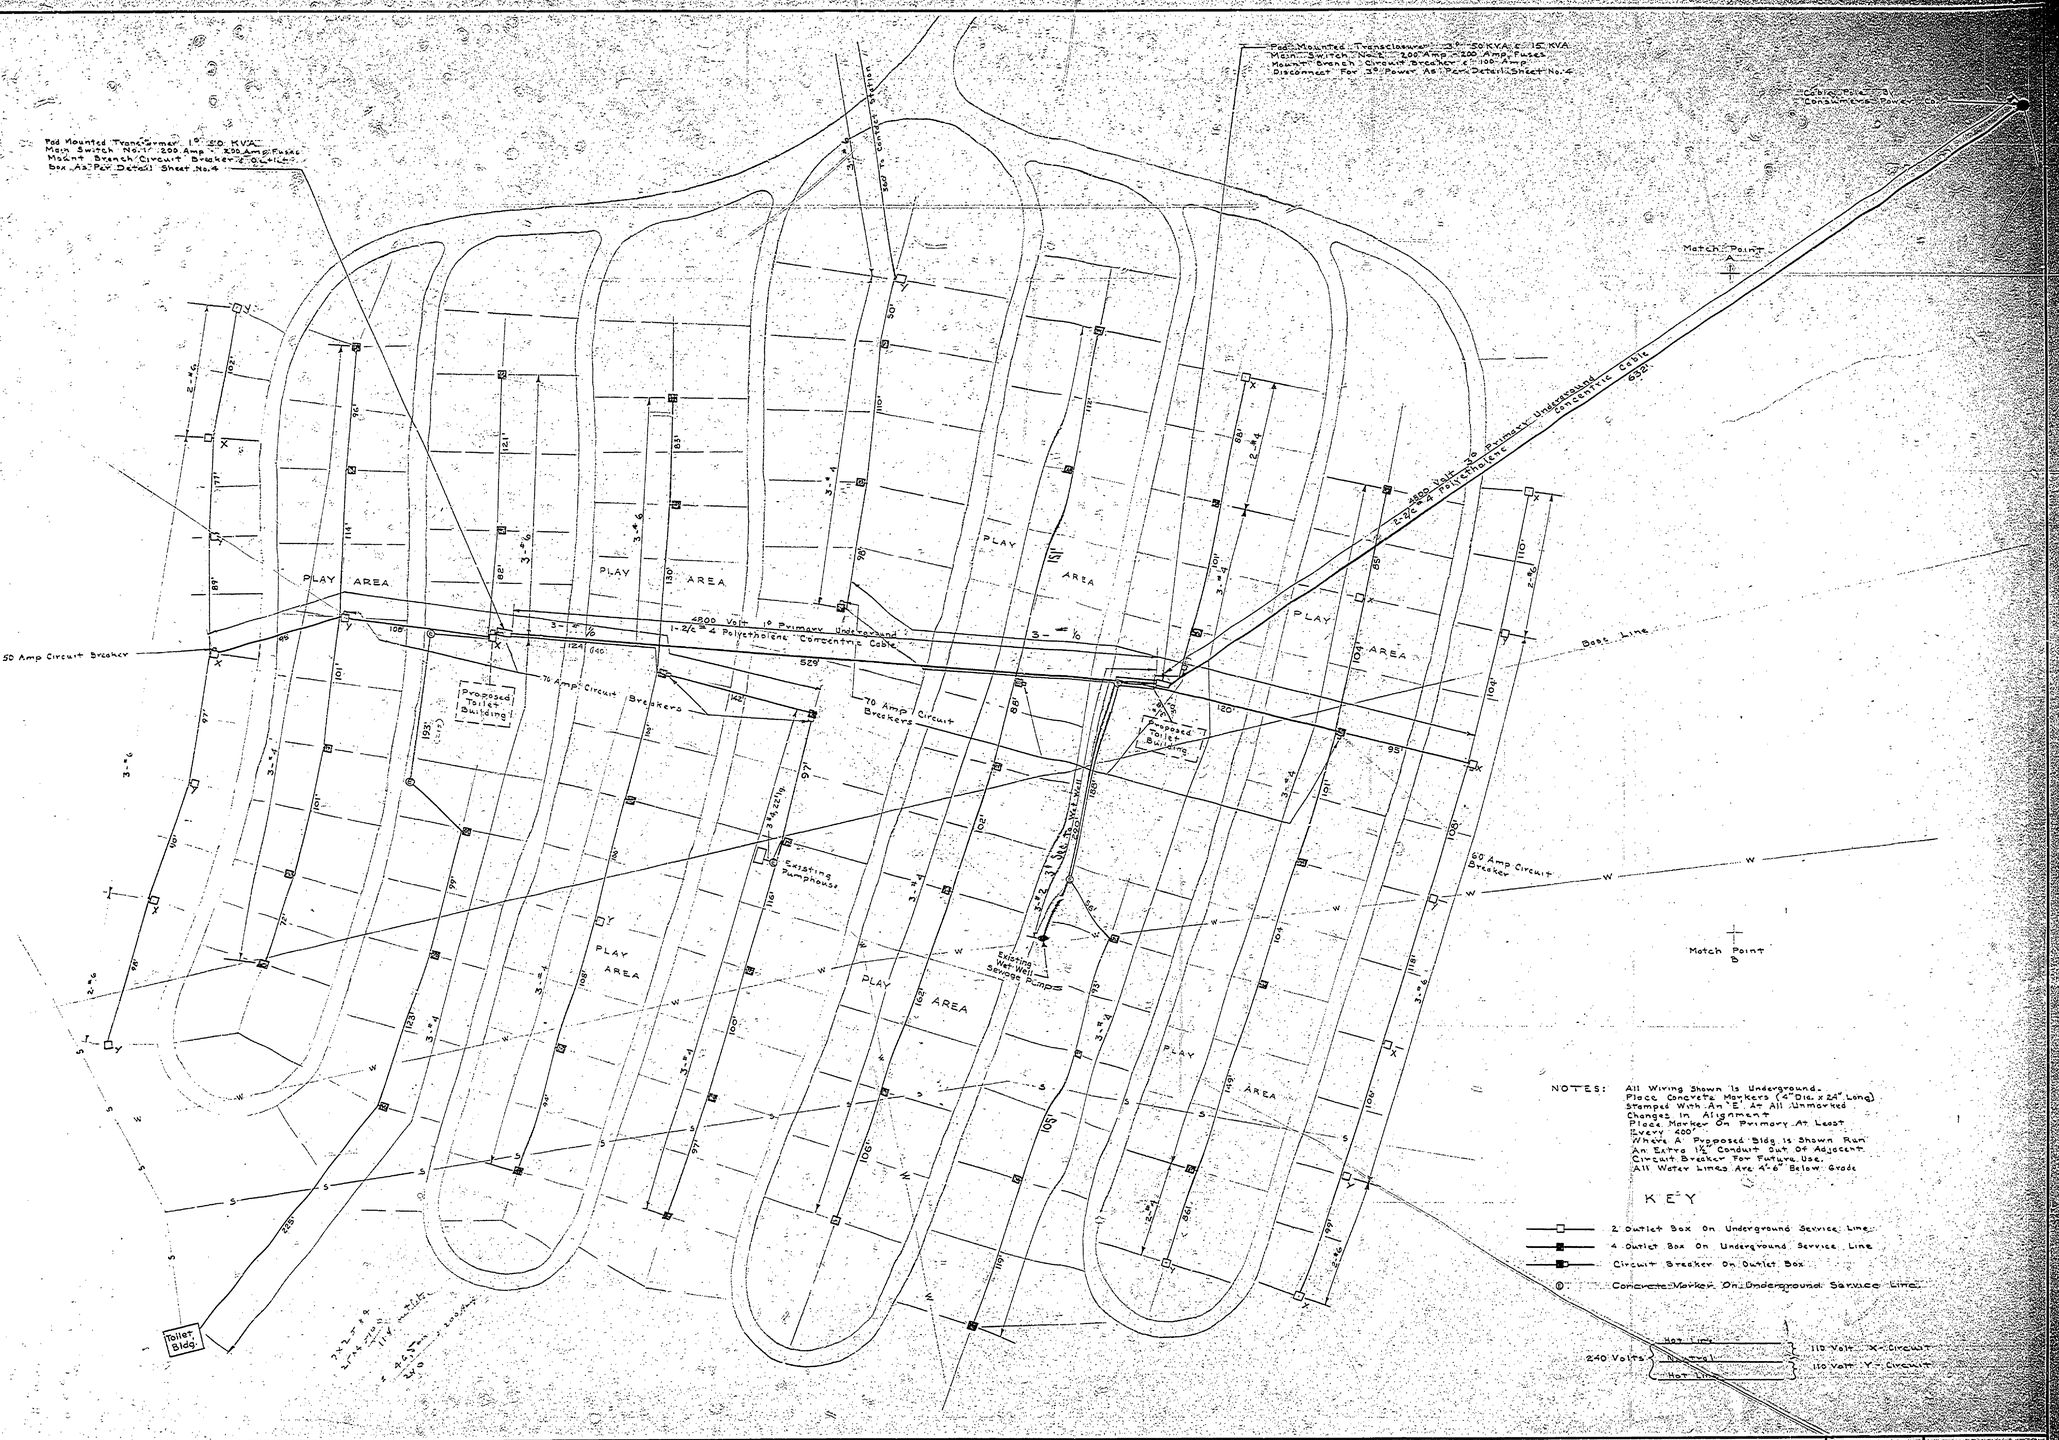

DATE	NO.	DATE	BY	REVISIONS			DATE	BY
8-31-63	1	5-17-63	DWC	Line as staked	4			
10-3-63	2	10-3-63	J.V.	Rev. As Constructed	5			
1-3-63	3				6			

	DATE		REVIEWED	DATE	APPROVED	DATE
DESIGNED BY		B.H.G.	ARCHITECTURAL	4-9-63	Robert L. Moore, Chief, Design Division	4-12-63
DRAWN BY		B.H.G.	ENGINEERING	4-2-63	Alan S. Nagel, Assistant Chief of Division, Design Division	4-23-63
CHECKED BY			LANDSCAPE	4-26-63	Alan S. Nagel, Chief, Engineering and Construction	4-23-63

MICHIGAN
DEPARTMENT OF CONSERVATION
PARKS AND RECREATION DIVISION

HIGGINS LAKE STATE PARK
ELECTRICAL DISTRIBUTION SYSTEM
Scale 1" = 50'

SHEET NO. OF

PLAN NO. E-116