


# HIGGINS

# LAKE

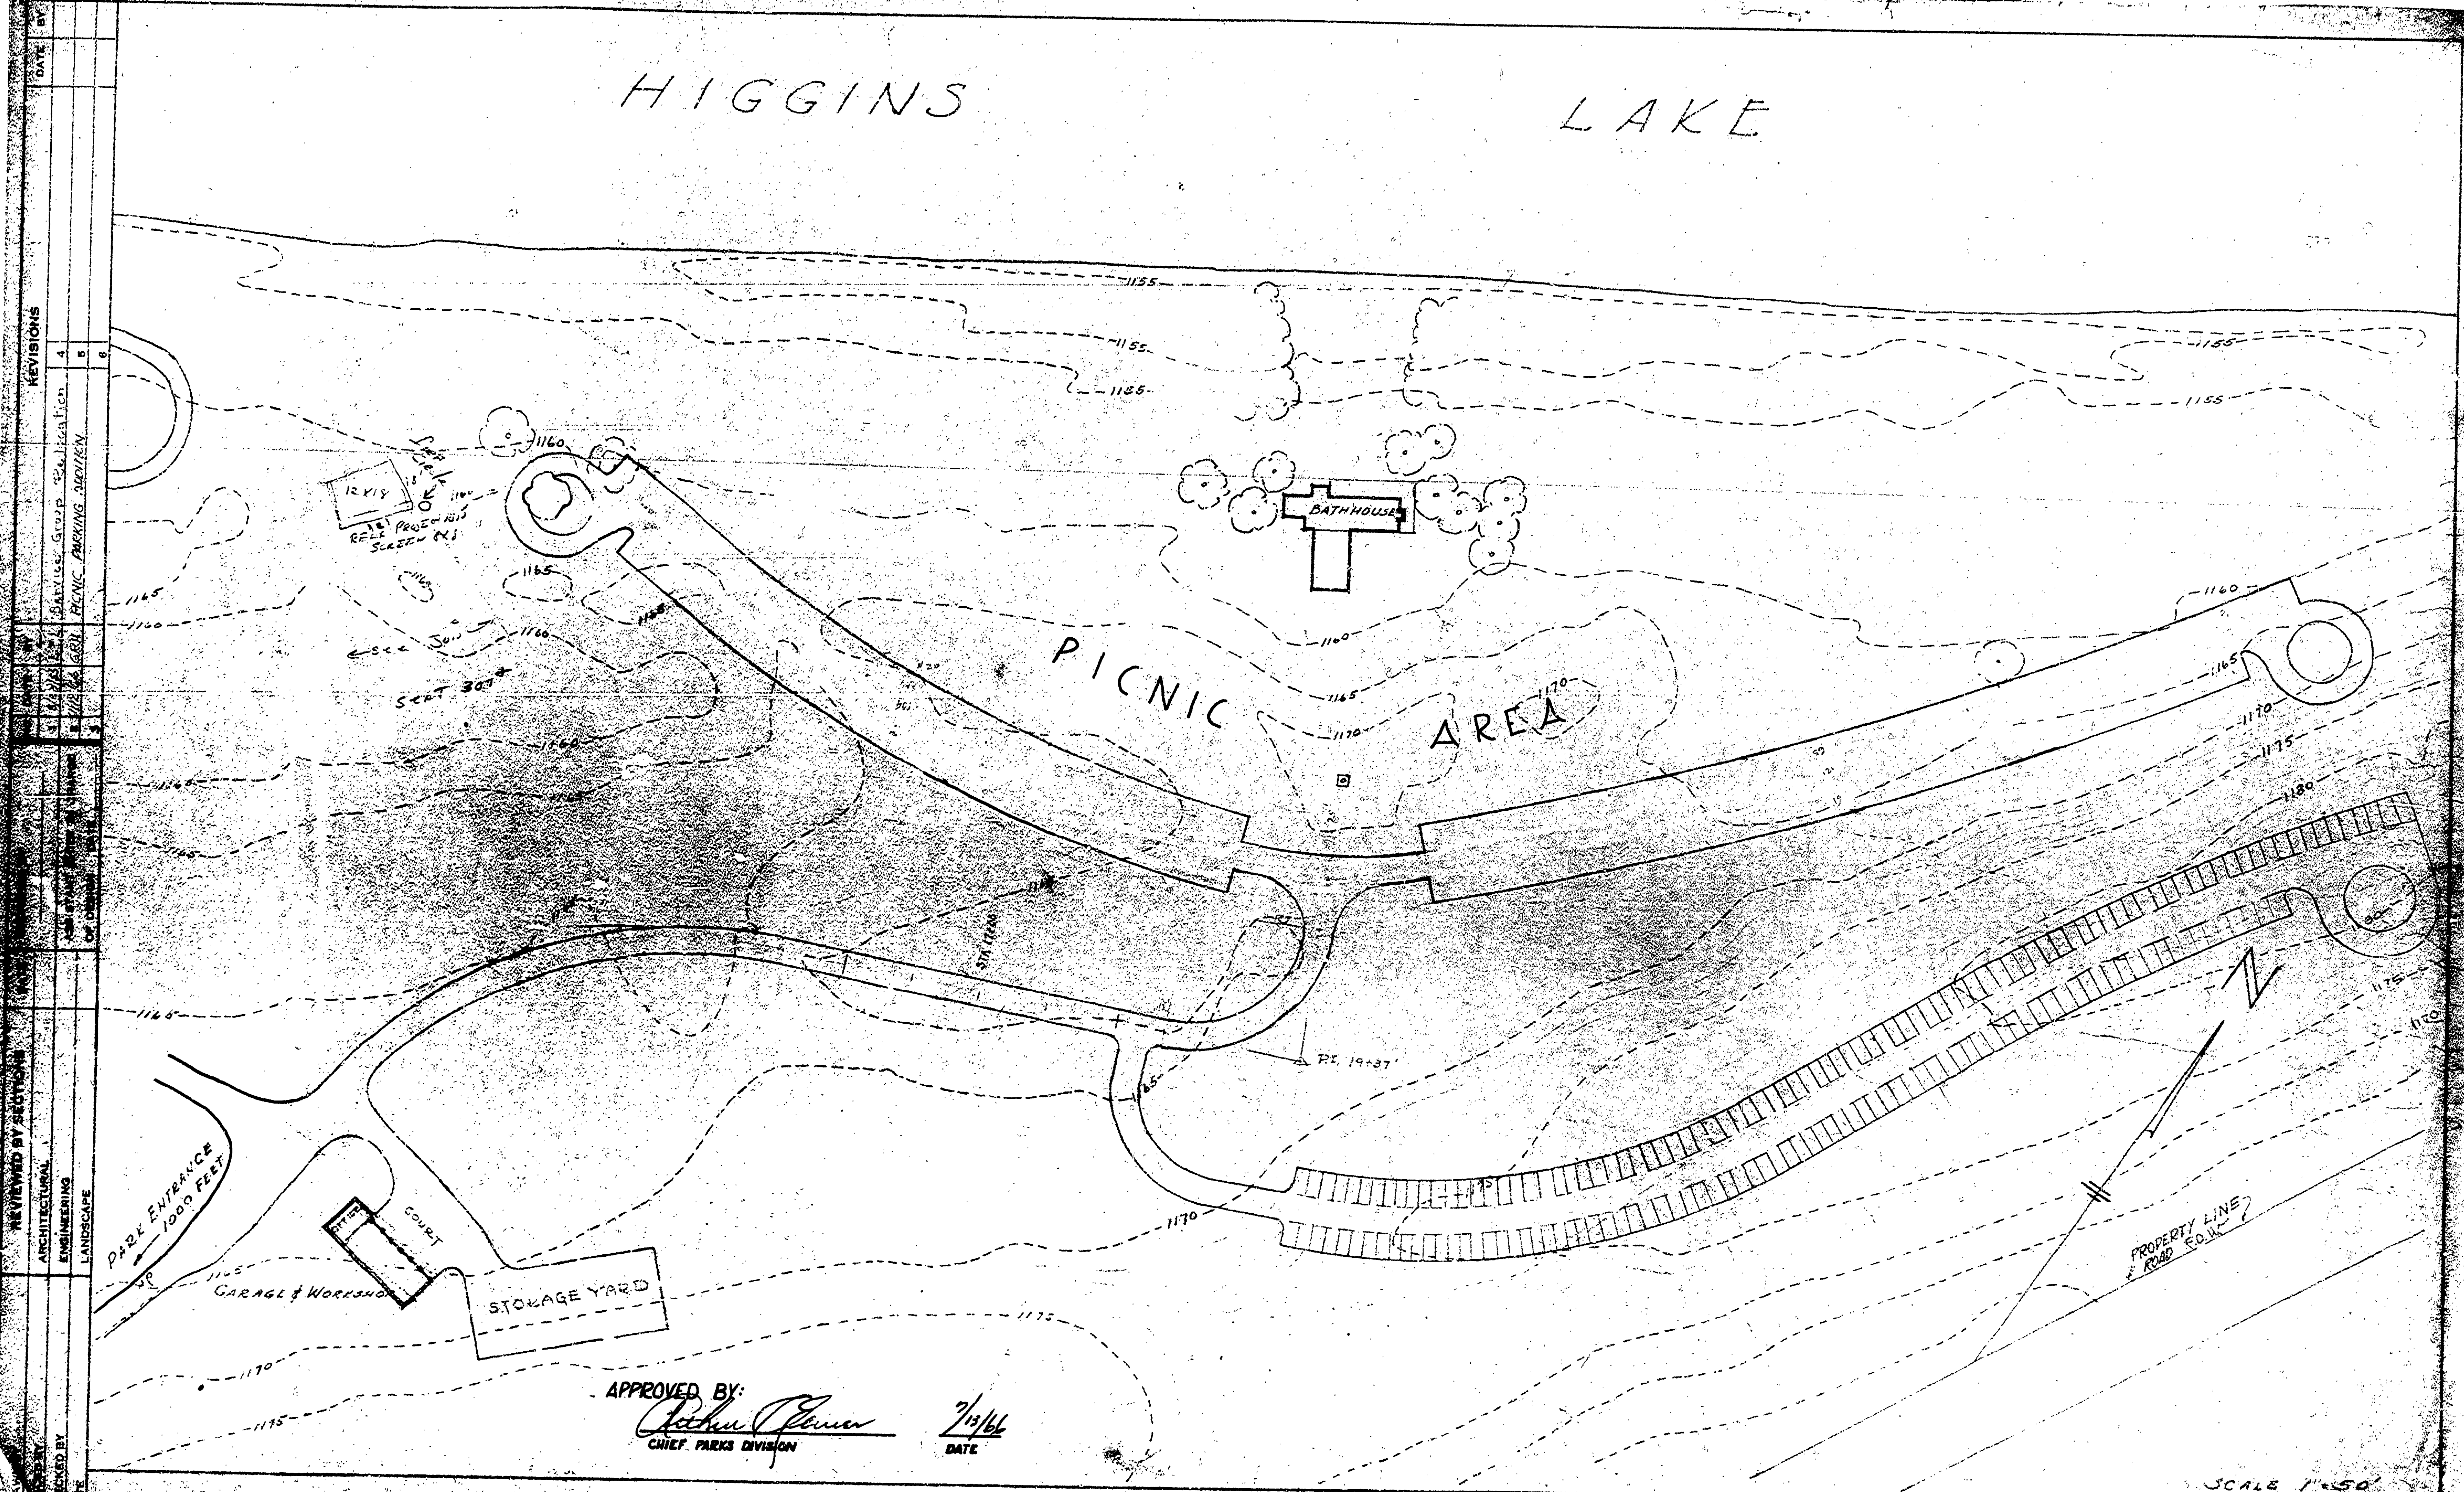

NO.	DATE	REVISIONS
1		
2		
3		
4		
5		
6		

APPROVED BY:  
*Robert J. Brown*  
CHIEF, PARKS DIVISION  
DATE: 7/13/66

MICHIGAN DEPARTMENT OF CONSERVATION PARKS AND RECREATION DIVISION	SOUTH HIGGINS LAKE PARKING AREA ADDITION	SCALE 1"=50'	SHEET NO. 1	PLAN NO. 4-111
			OF 5	