
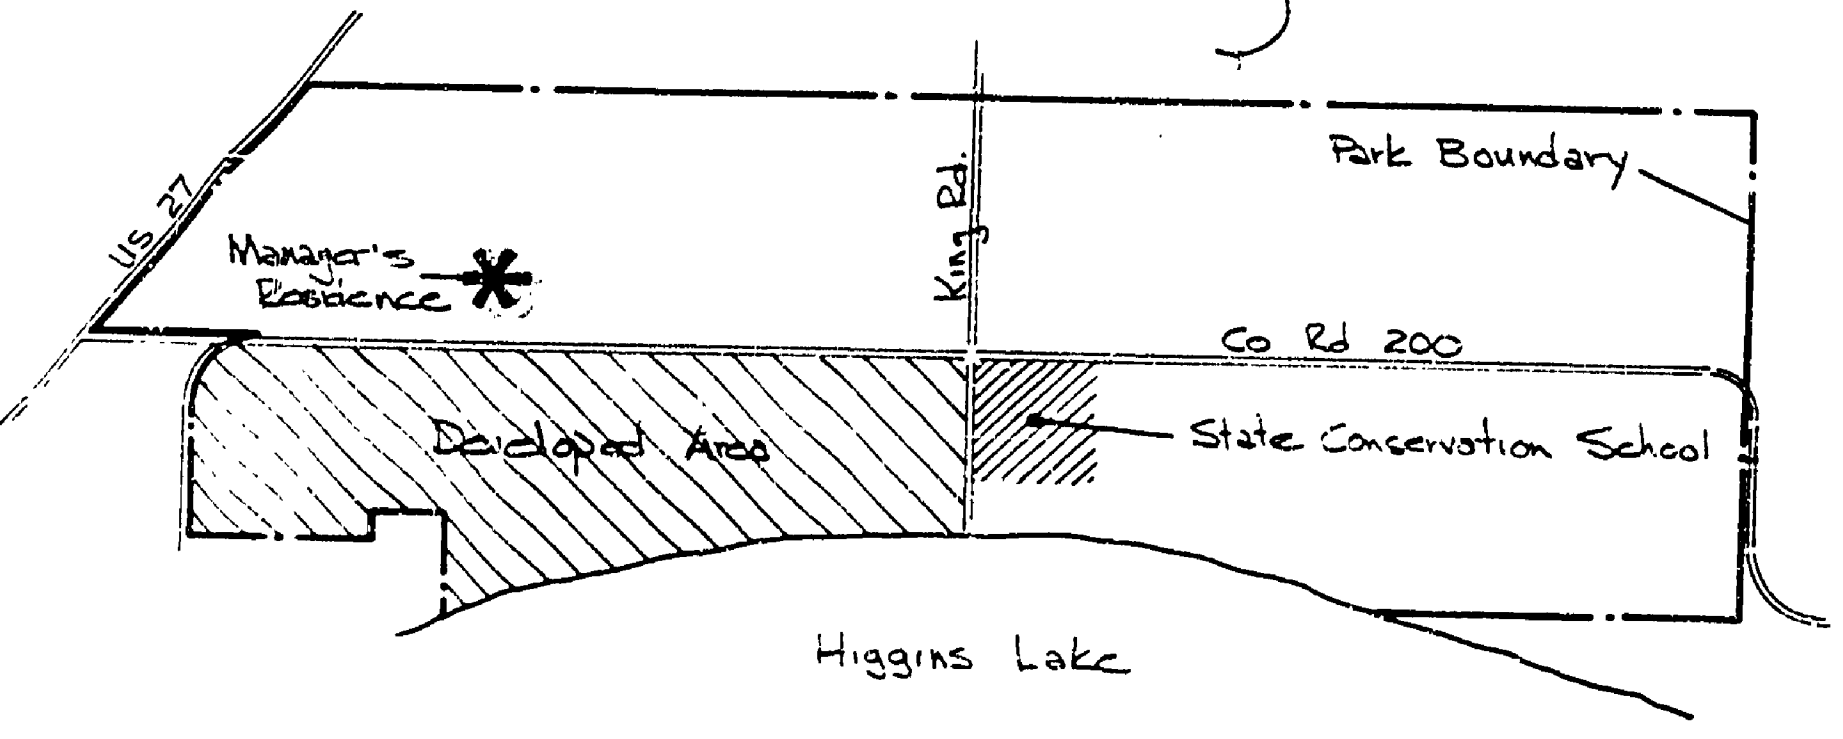


REVIEWED BY: Jim Hane 9-2-71  
IN CHARGE, PARK DESIGN DATE

APPROVED BY: [Signature] 9-2-71  
CHIEF, PARKS DIVISION DATE

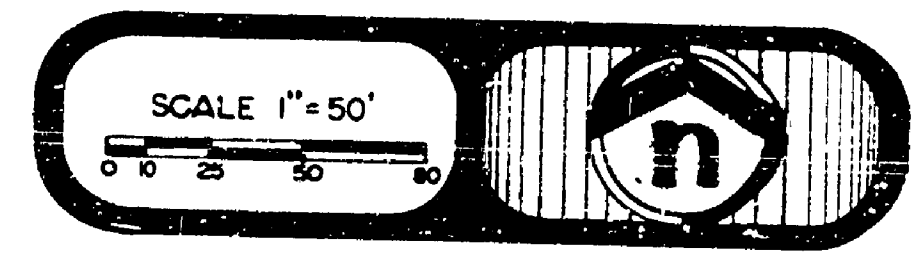

SURVEYED BY	DRAWN BY R. G. WHITENER	9-2-71	NO.	DATE	BY	REVISIONS	NO.	DATE	BY	REVISIONS	MICHIGAN DEPARTMENT OF NATURAL RESOURCES	<b>NORTH HIGGINS LAKE</b>	AREA OR PARK	PROJECT NO.
DESIGNED BY	CHECKED BY R. G. H. L.C.M.	9-2-71	1.	7-9-79	PRICE	RELOCATED SERVICE AREA	3.					SHEET TITLE	RESIDENCE SERVICE AREA	SHEET 1 OF 1
DATE			2.				4.						PROJECT	PLAN NO. L-105