R-1256 COMMERCIAL BLUEPRINT SERVICE

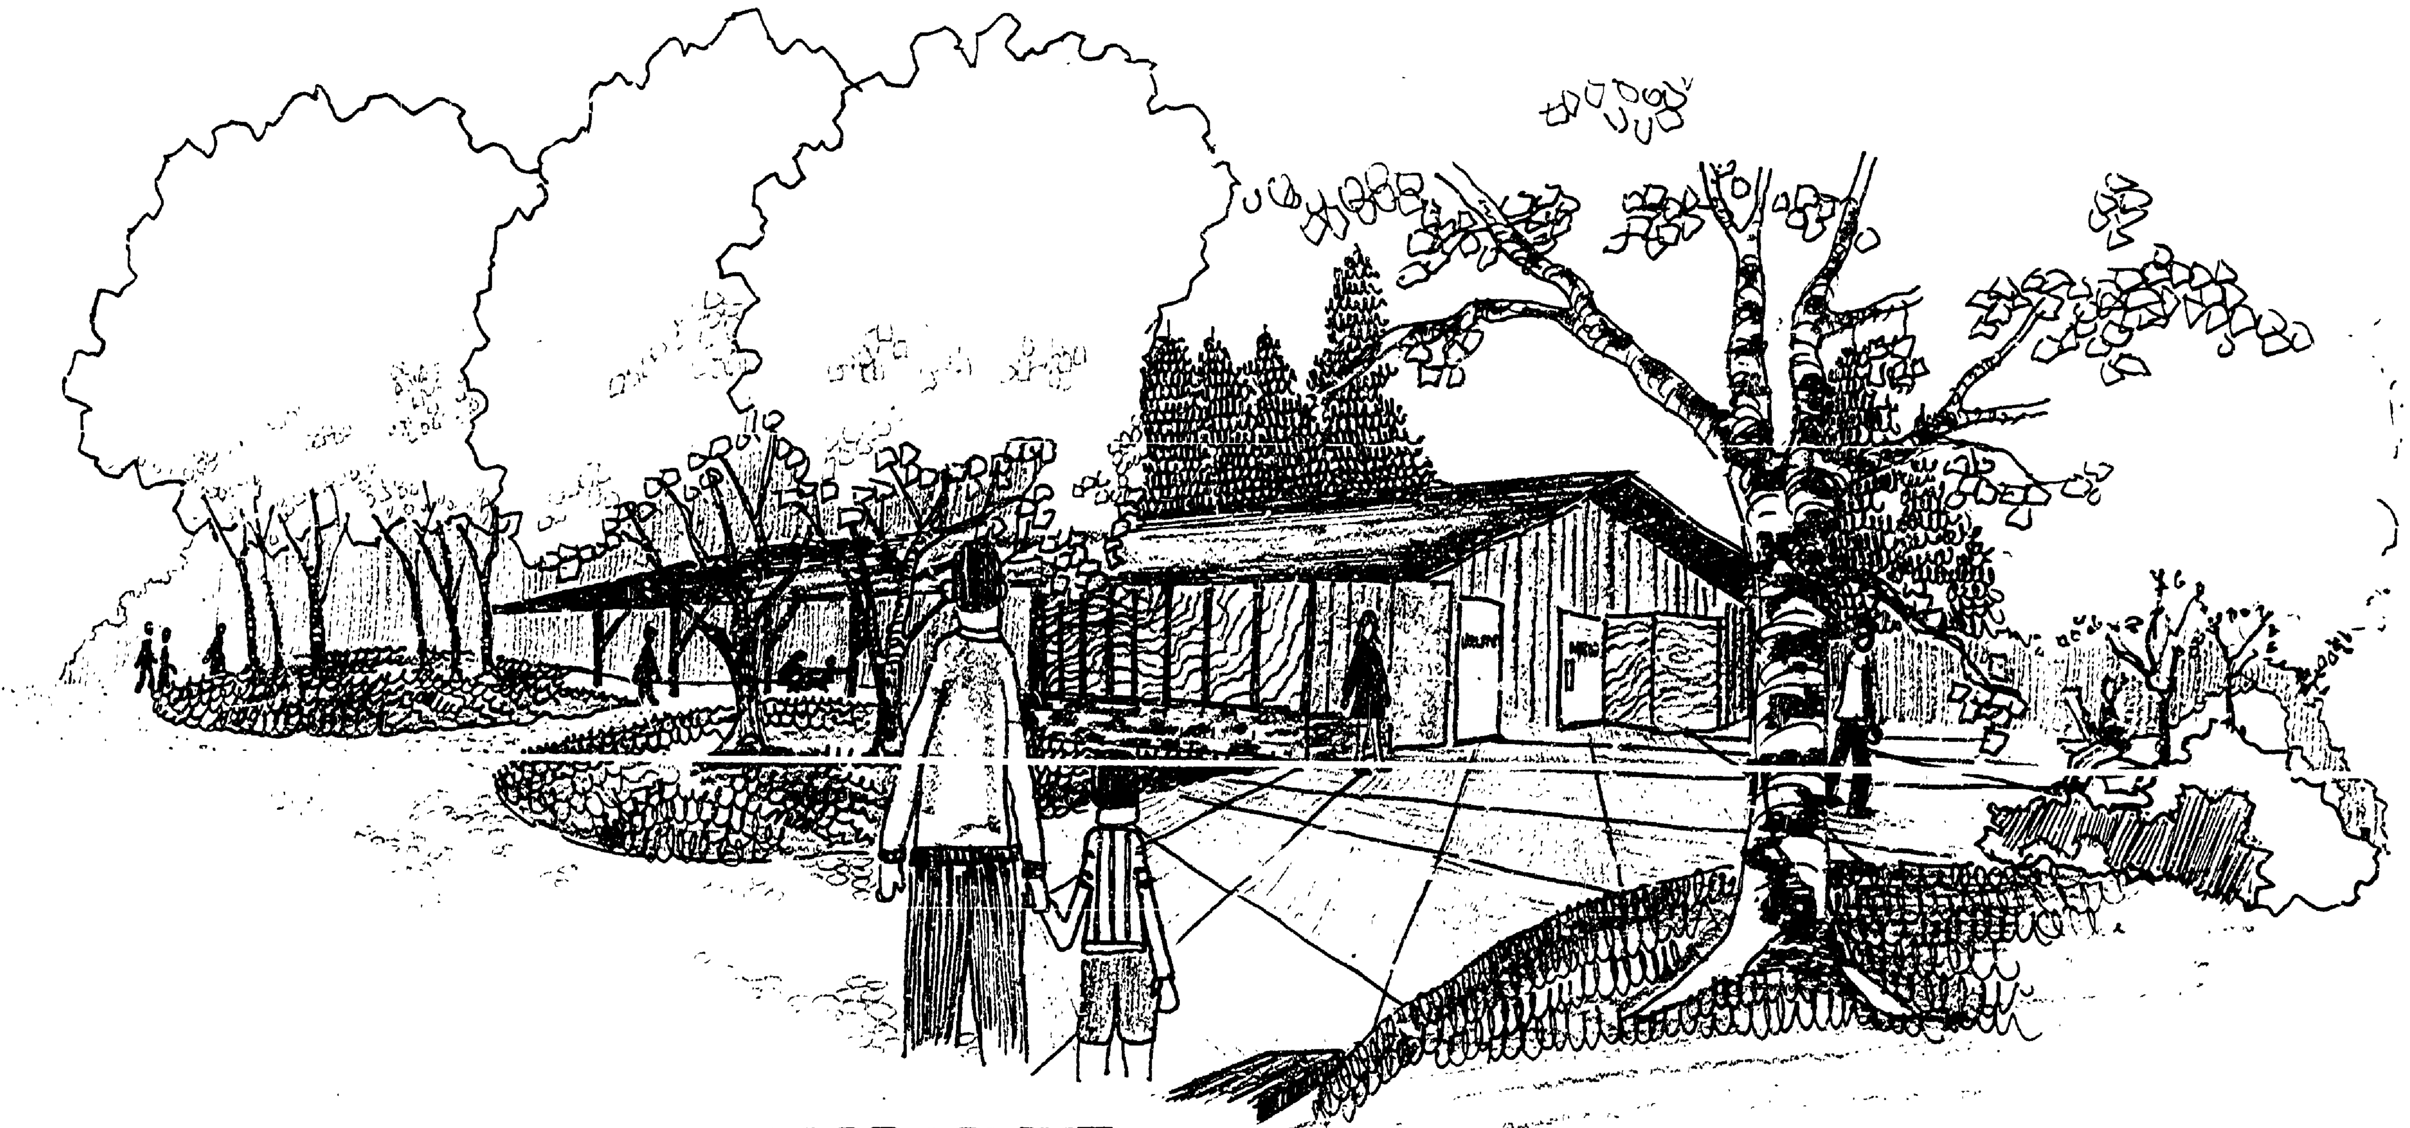

PERSPECTIVE

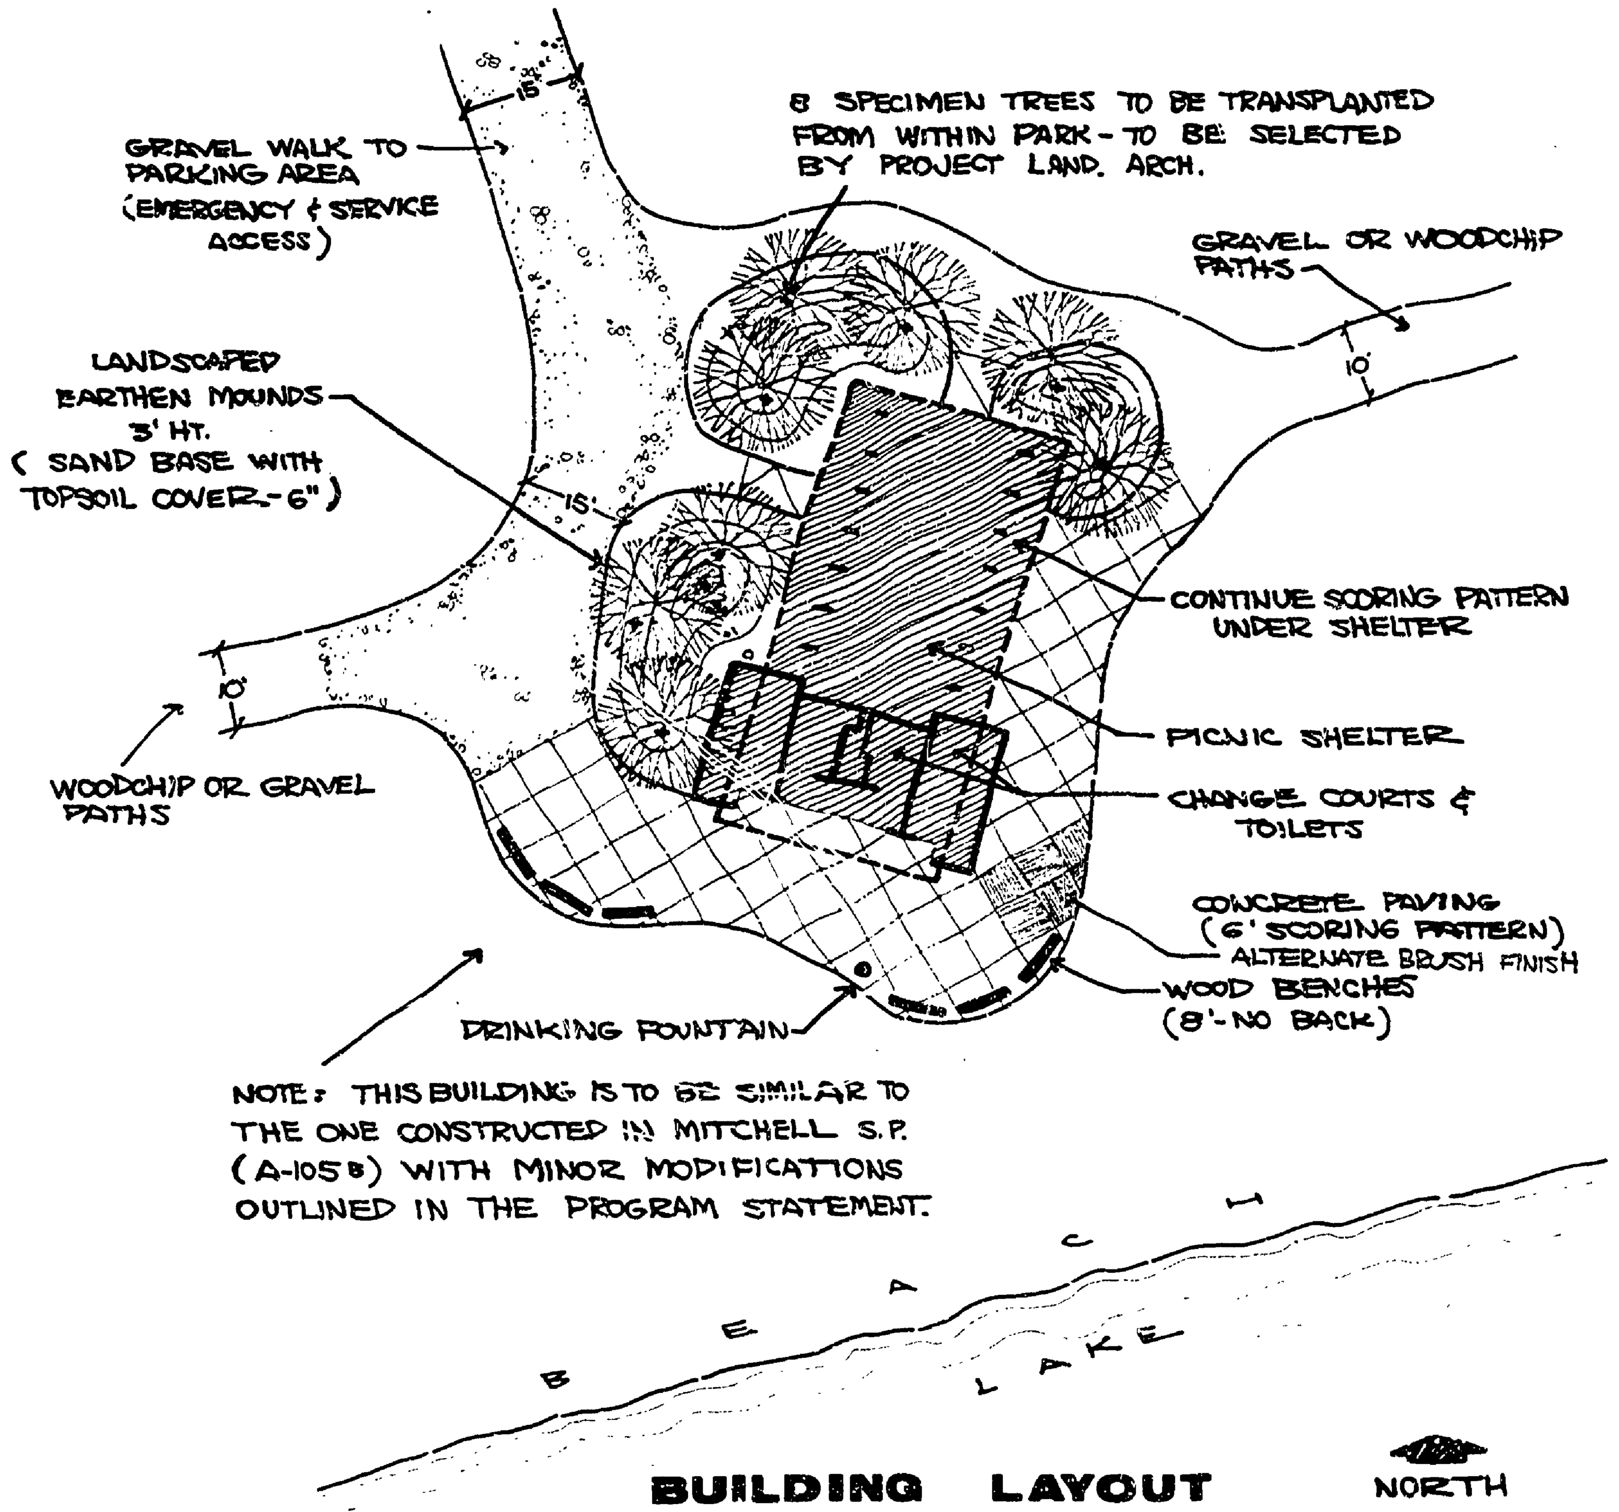

NOTE: THIS BUILDING IS TO BE SIMILAR TO THE ONE CONSTRUCTED IN MITCHELL S.P. (A-105 B) WITH MINOR MODIFICATIONS OUTLINED IN THE PROGRAM STATEMENT.

BUILDING LAYOUT
SCALE - 1" = 20'
NORTH

CONCEPT

THIS BEACH AREA IS INTENDED TO SERVE BOTH CAMPERS FROM THE ADJACENT 200 SITE CAMPGROUNDS AND, TO A LESSER EXTENT, DAY-USERS. NO FUTURE EXPANSION OF THIS UNIT IS PLANNED OR CONTEMPLATED.

THE ENTRANCE ROAD AND PARKING AREAS ARE TO EVENTUALLY BE HARD SURFACED. THE EMERGENCY ACCESS ROUTE AND FOOT TRAILS ARE TO BE GRAVEL OR WOODCHIP (IF AVAILABLE).

THE BENCHES, CONCRETE PLAZA AREA, DRINKING FOUNTAIN, AND LANDSCAPED MOUNDS ARE TO BE CONSIDERED A PART OF THIS INITIAL PHASE OF CONSTRUCTION.

MINOR FIELD ADJUSTMENT MIGHT BE NECESSARY AS NO SURVEY INFORMATION IS PRESENTLY AVAILABLE FOR THIS SITE.

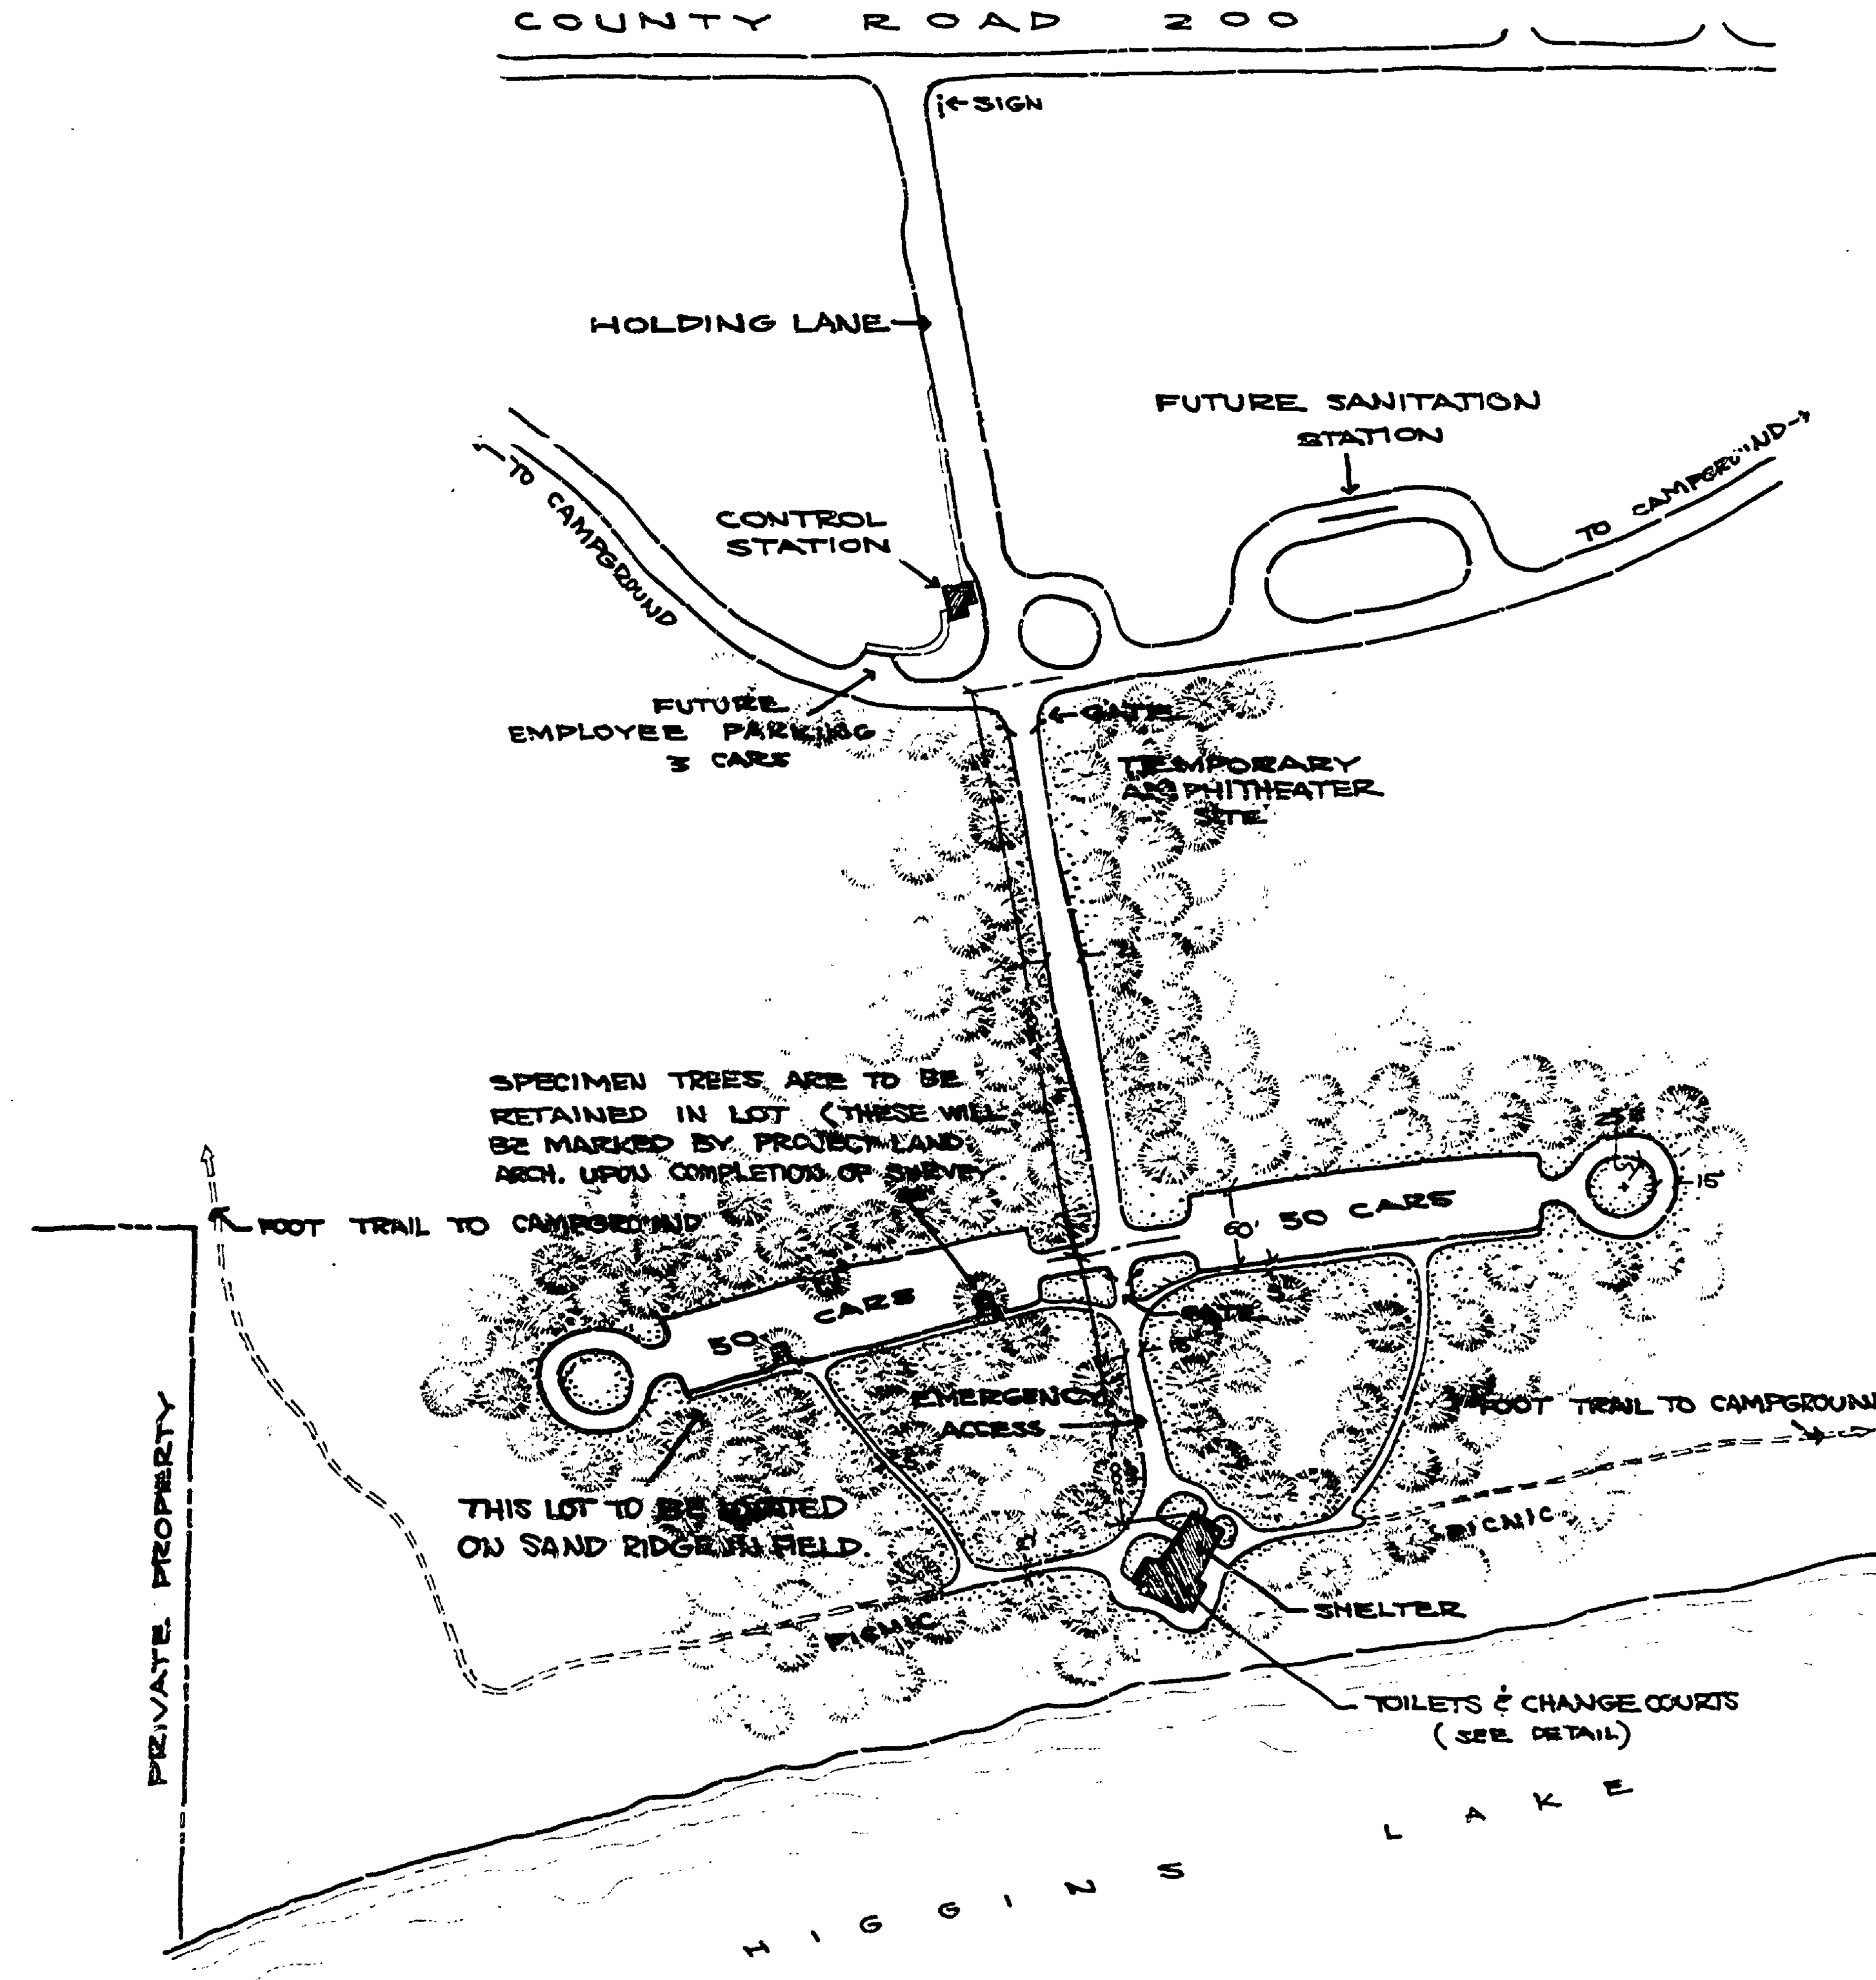

SITE PLAN
SCALE - 1" = 100'
NORTH

REVIEWED BY:
James M. Hani 7-1-74
IN CHARGE - PARK DESIGN DATE

APPROVED BY:
[signature] 7-3-74
CHIEF PARKS DIVISION DATE

Revised 4/76 to show water supply line location

SURVEYED BY		DRAWN BY KESSLER	5/74	NO.	DATE	BY	REVISIONS	NO.	DATE	BY	REVISIONS	MICHIGAN DEPARTMENT OF NATURAL RESOURCES	NORTH HIGGINS LAKE (SHEET TITLE)
DESIGNED BY KESSLER	5/74 DATE	CHECKED BY	DATE	1.				3.					
				2.				4.					

AREA OR PARK: NORTH HIGGINS LAKE STATE PARK	PROJECT NO.
PROJECT: BEACH DEVELOPMENT	SHEET 1 OF 1 — PLAN NO. L-~~106~~

R-22