# INDIAN LAKE

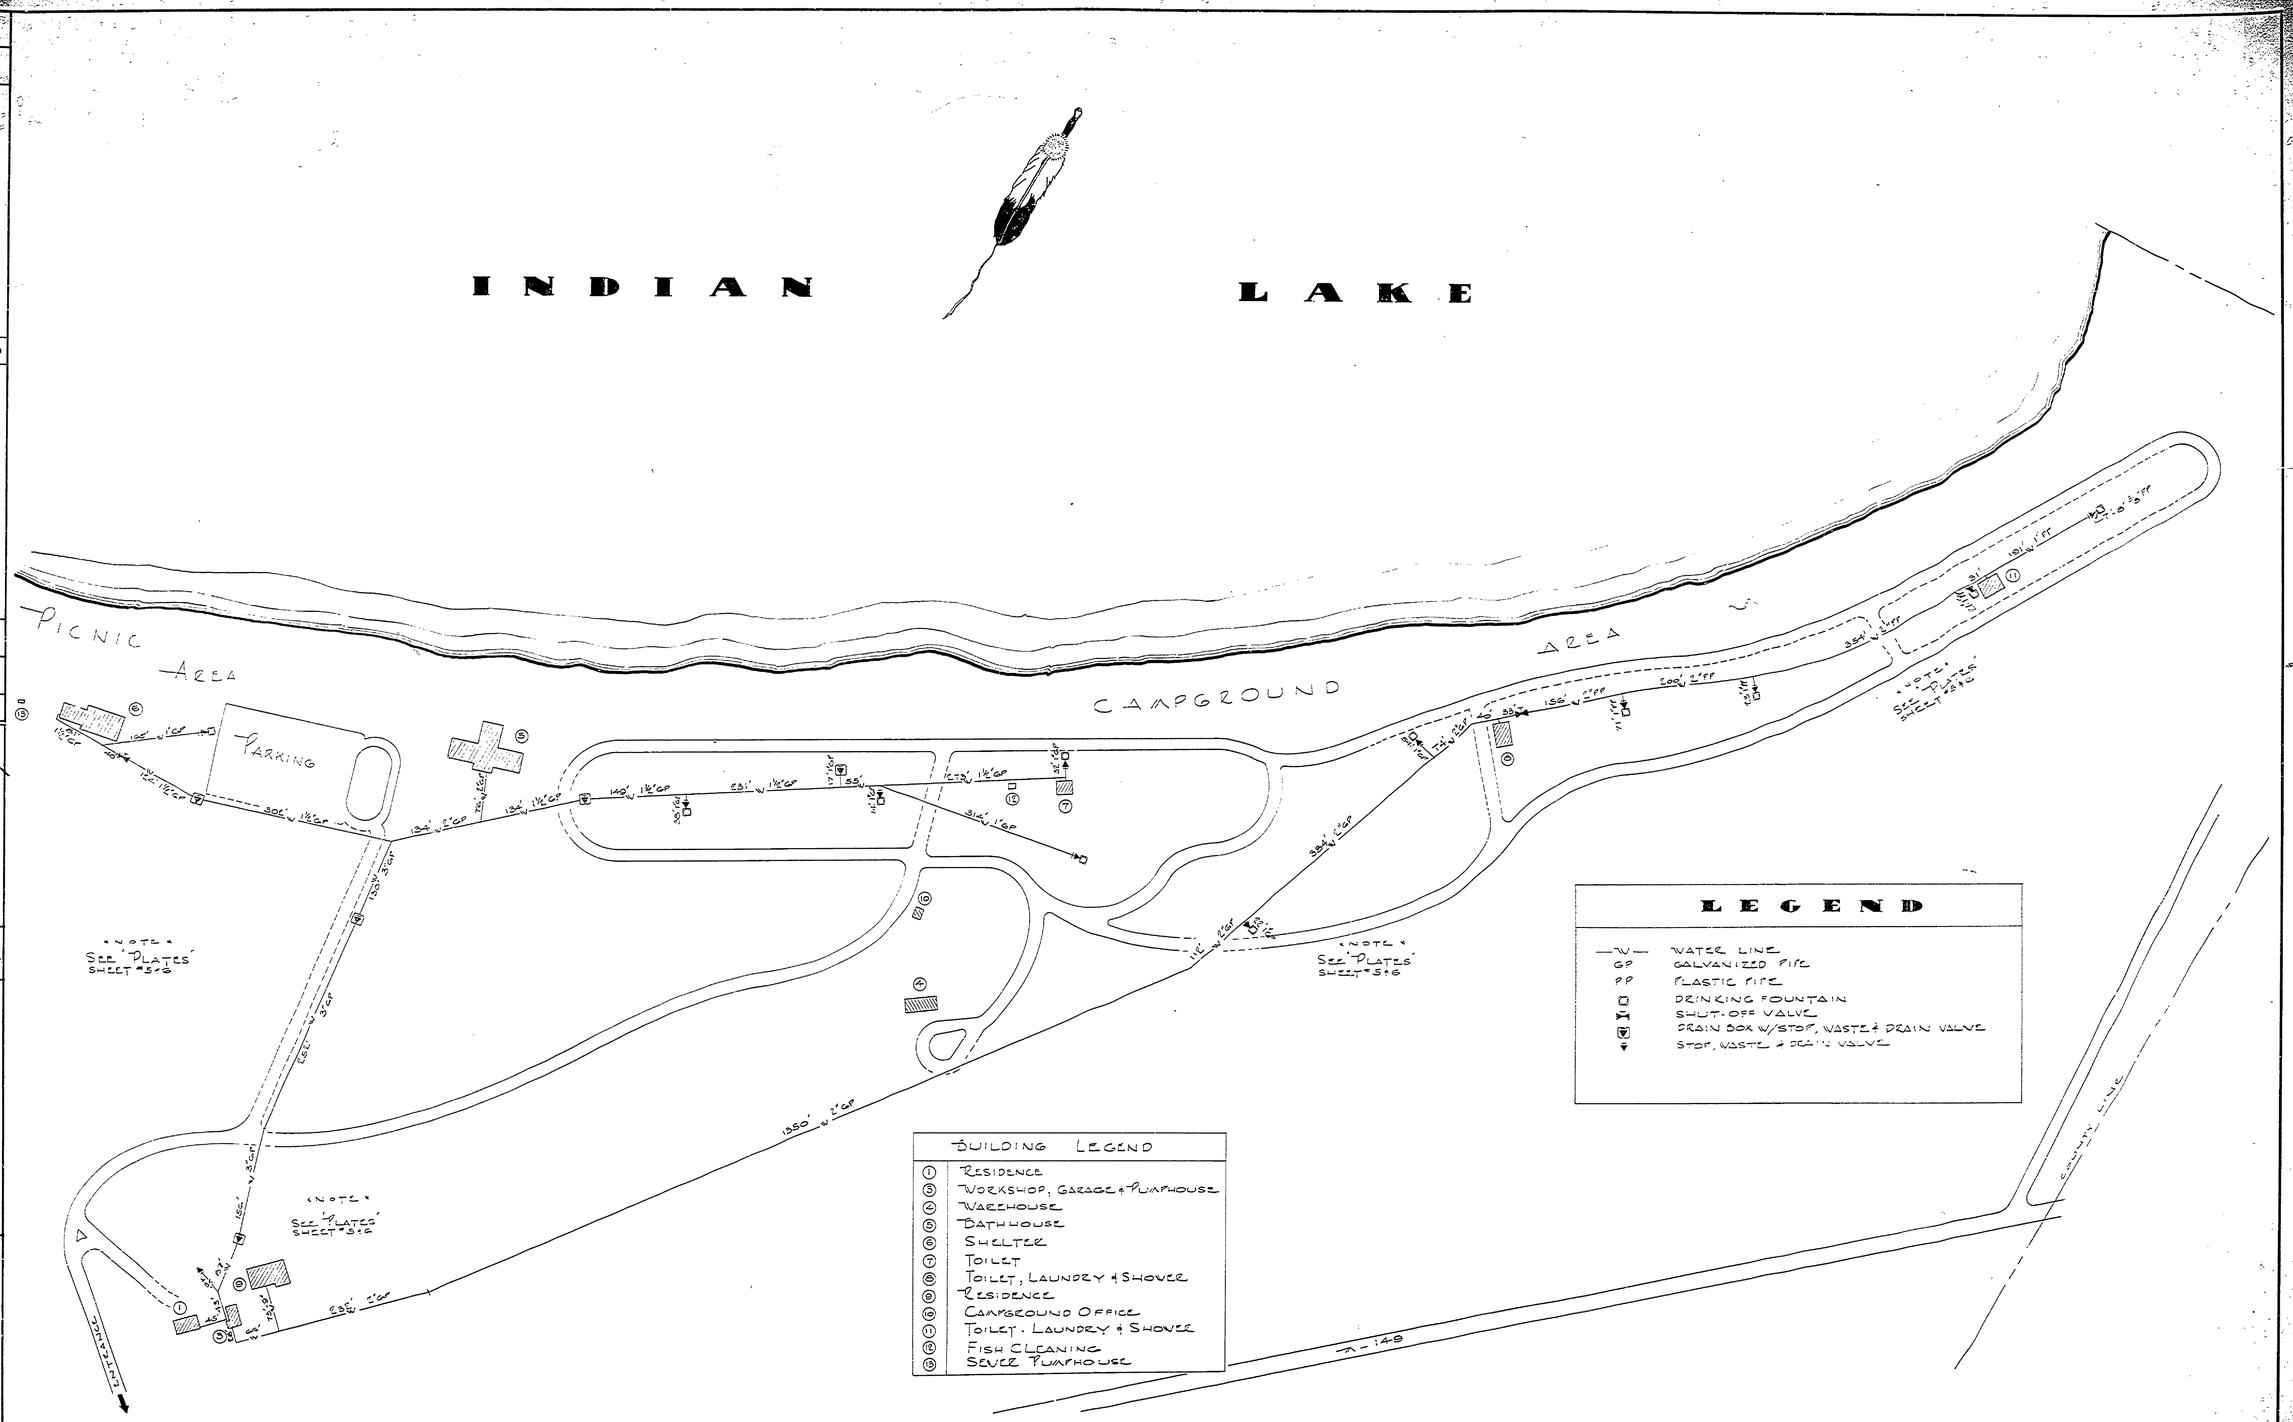


| NO. | DATE | BY | REVISIONS | NO. | DATE | BY |
|---|---|---|---|---|---|---|
| 1 | | | | 4 | | |
| 2 | | | | 5 | | |
| 3 | | | | 6 | | |

APPROVED BY
ASSISTANT CHIEF IN CHARGE OF DESIGN — DATE 23-Sep-60

| REVIEWED BY SECTIONS | | DATE |
|---|---|---|
| ARCHITECTURAL | J.T.R. | 9-14-60 |
| ENGINEERING | J.T.R. | 9-14-60 |
| LANDSCAPE | J.T.R. | 9-14-60 |

| | |
|---|---|
| DRAWN BY | V. CARLISLE |
| TRACED BY | |
| CHECKED BY | |
| DATE | |

INDIAN LAKE STATE PARK

SCALE 1" = 100'-0"

MICHIGAN
DEPARTMENT OF CONSERVATION
PARKS AND RECREATION DIVISION

INDIAN LAKE STATE PARK
UTILITY MAP
WATER SYSTEM

SHEET NO. 4 OF 6

PLAN NO. U-1 R-7