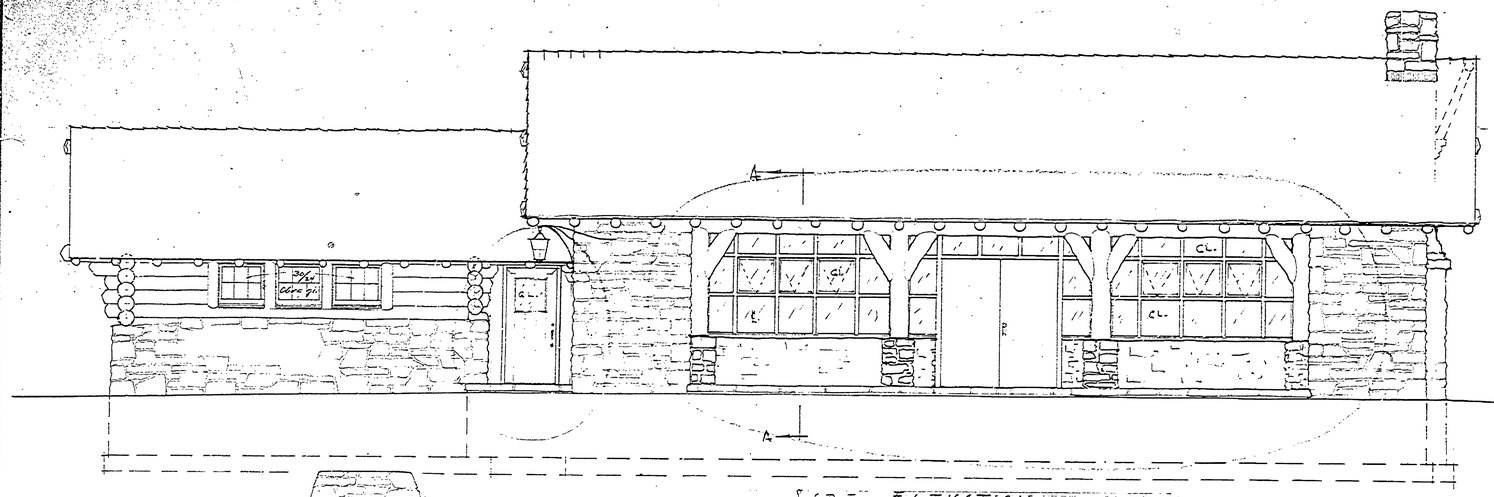

SIDE ELEVATION Other side similar
Scale 1/4" = 1'-0"

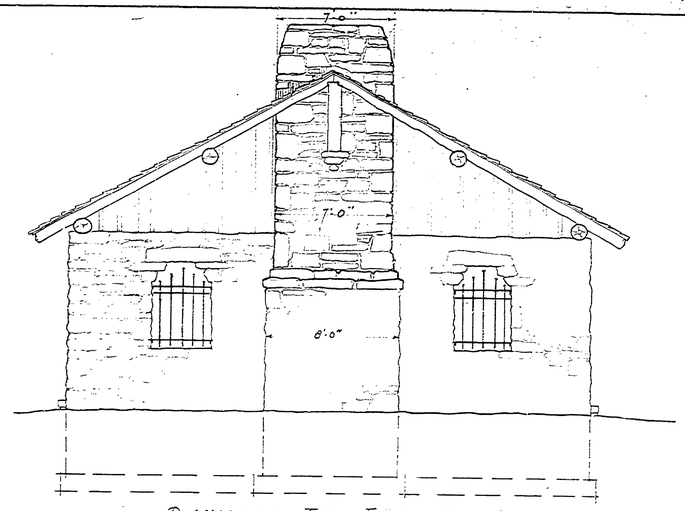

PAVILION END ELEVATION
Scale 1/4" = 1'-0"

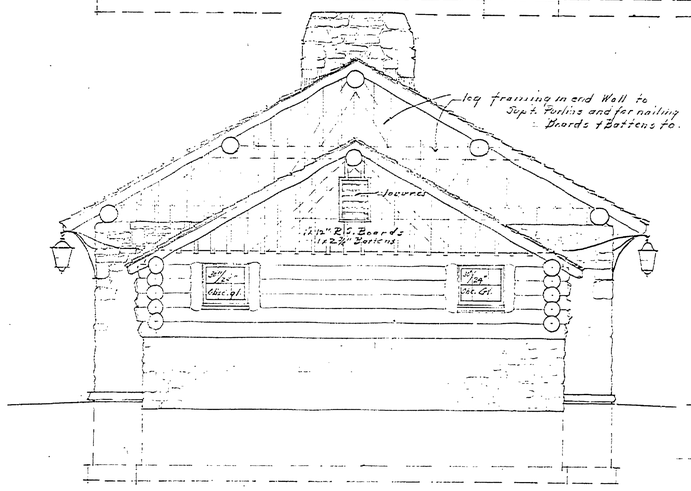

TOILET END ELEVATION
Scale 1/4" = 1'-0"

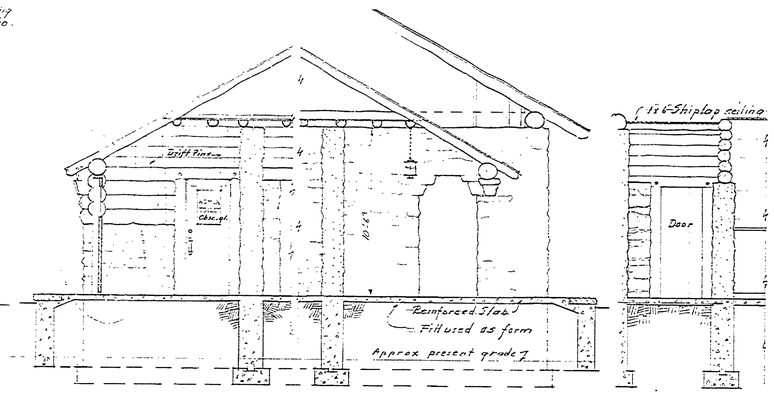

SECTIONS & ELEVATIONS TOILET RM ENTRANCES
Scale 1/4" = 1'-0"

CROSS SECTION

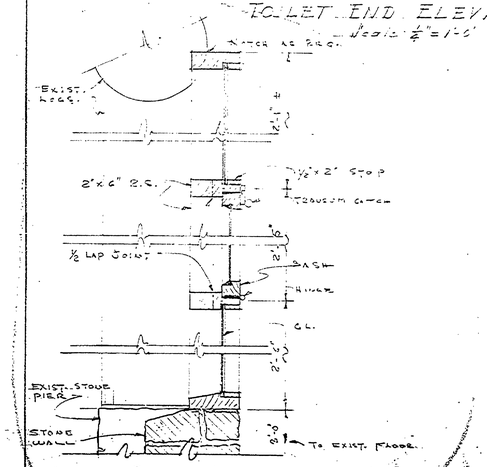

SECT. A-A. TYP.
1½" = 1'-0"

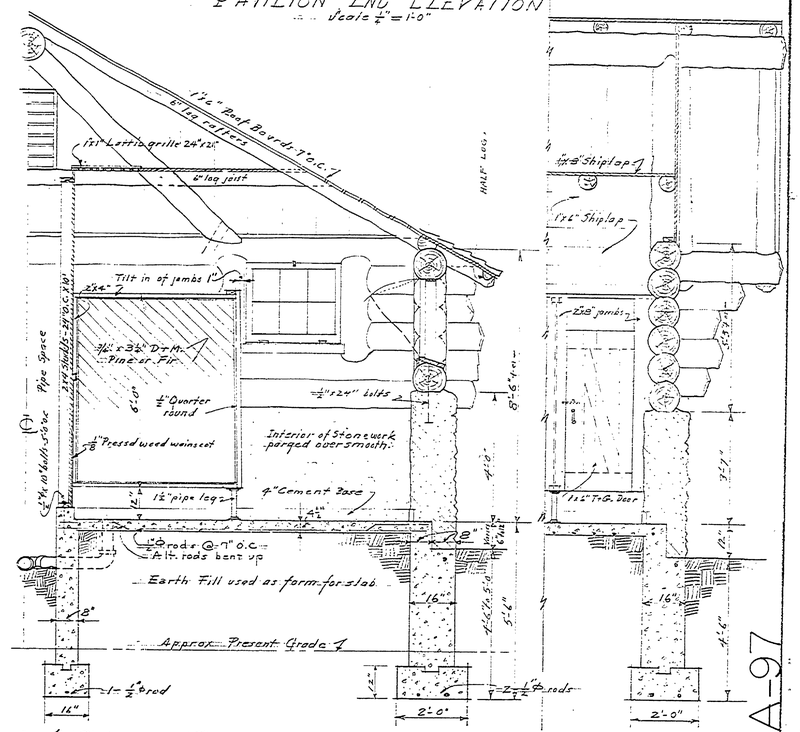

½ CROSS SECTION OF TOILET
Scale 1/4" = 1'-0"

SECTION THRU END TOILET WALL

REVISED 1-16-65 W.H.G.
1. Doors & windows in Shelt.
2. Ext. Doors in Toil. Entrances

REVISED - Sept. 11, 1936. BY THE II REG. OFFICE — OMAHA.
Revision - Redesign of stone chimney.
" - Half log iron window grilles, reduced to flush edge of sheathing.

Insurance No. 6
Master Plan Bldg. No. 4
approved

COMBINATION BLDG. FOR INDIAN LAKE STATE PARK	
SYMBOL	NUMBER 108
Drawn by R.B.H.	2

A-97

SEP 11 1936