




ENTRANCE RACK
 WITH METER SOCKET & CIRCUIT BREAKER PANEL BOARD
 NOTE: GROUND ELECTRICAL SYSTEM AT DISTRIBUTION PANELBOARD TO NEAREST BURIED WATER PIPE.

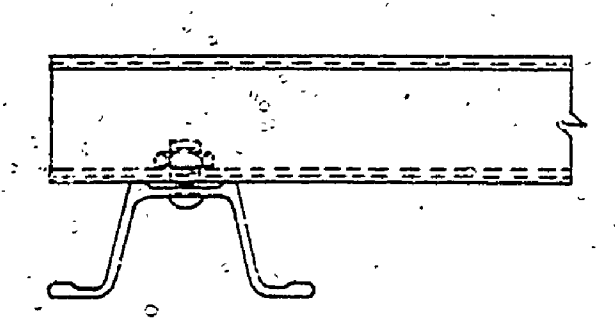


SECTION A-A
 NO SCALE

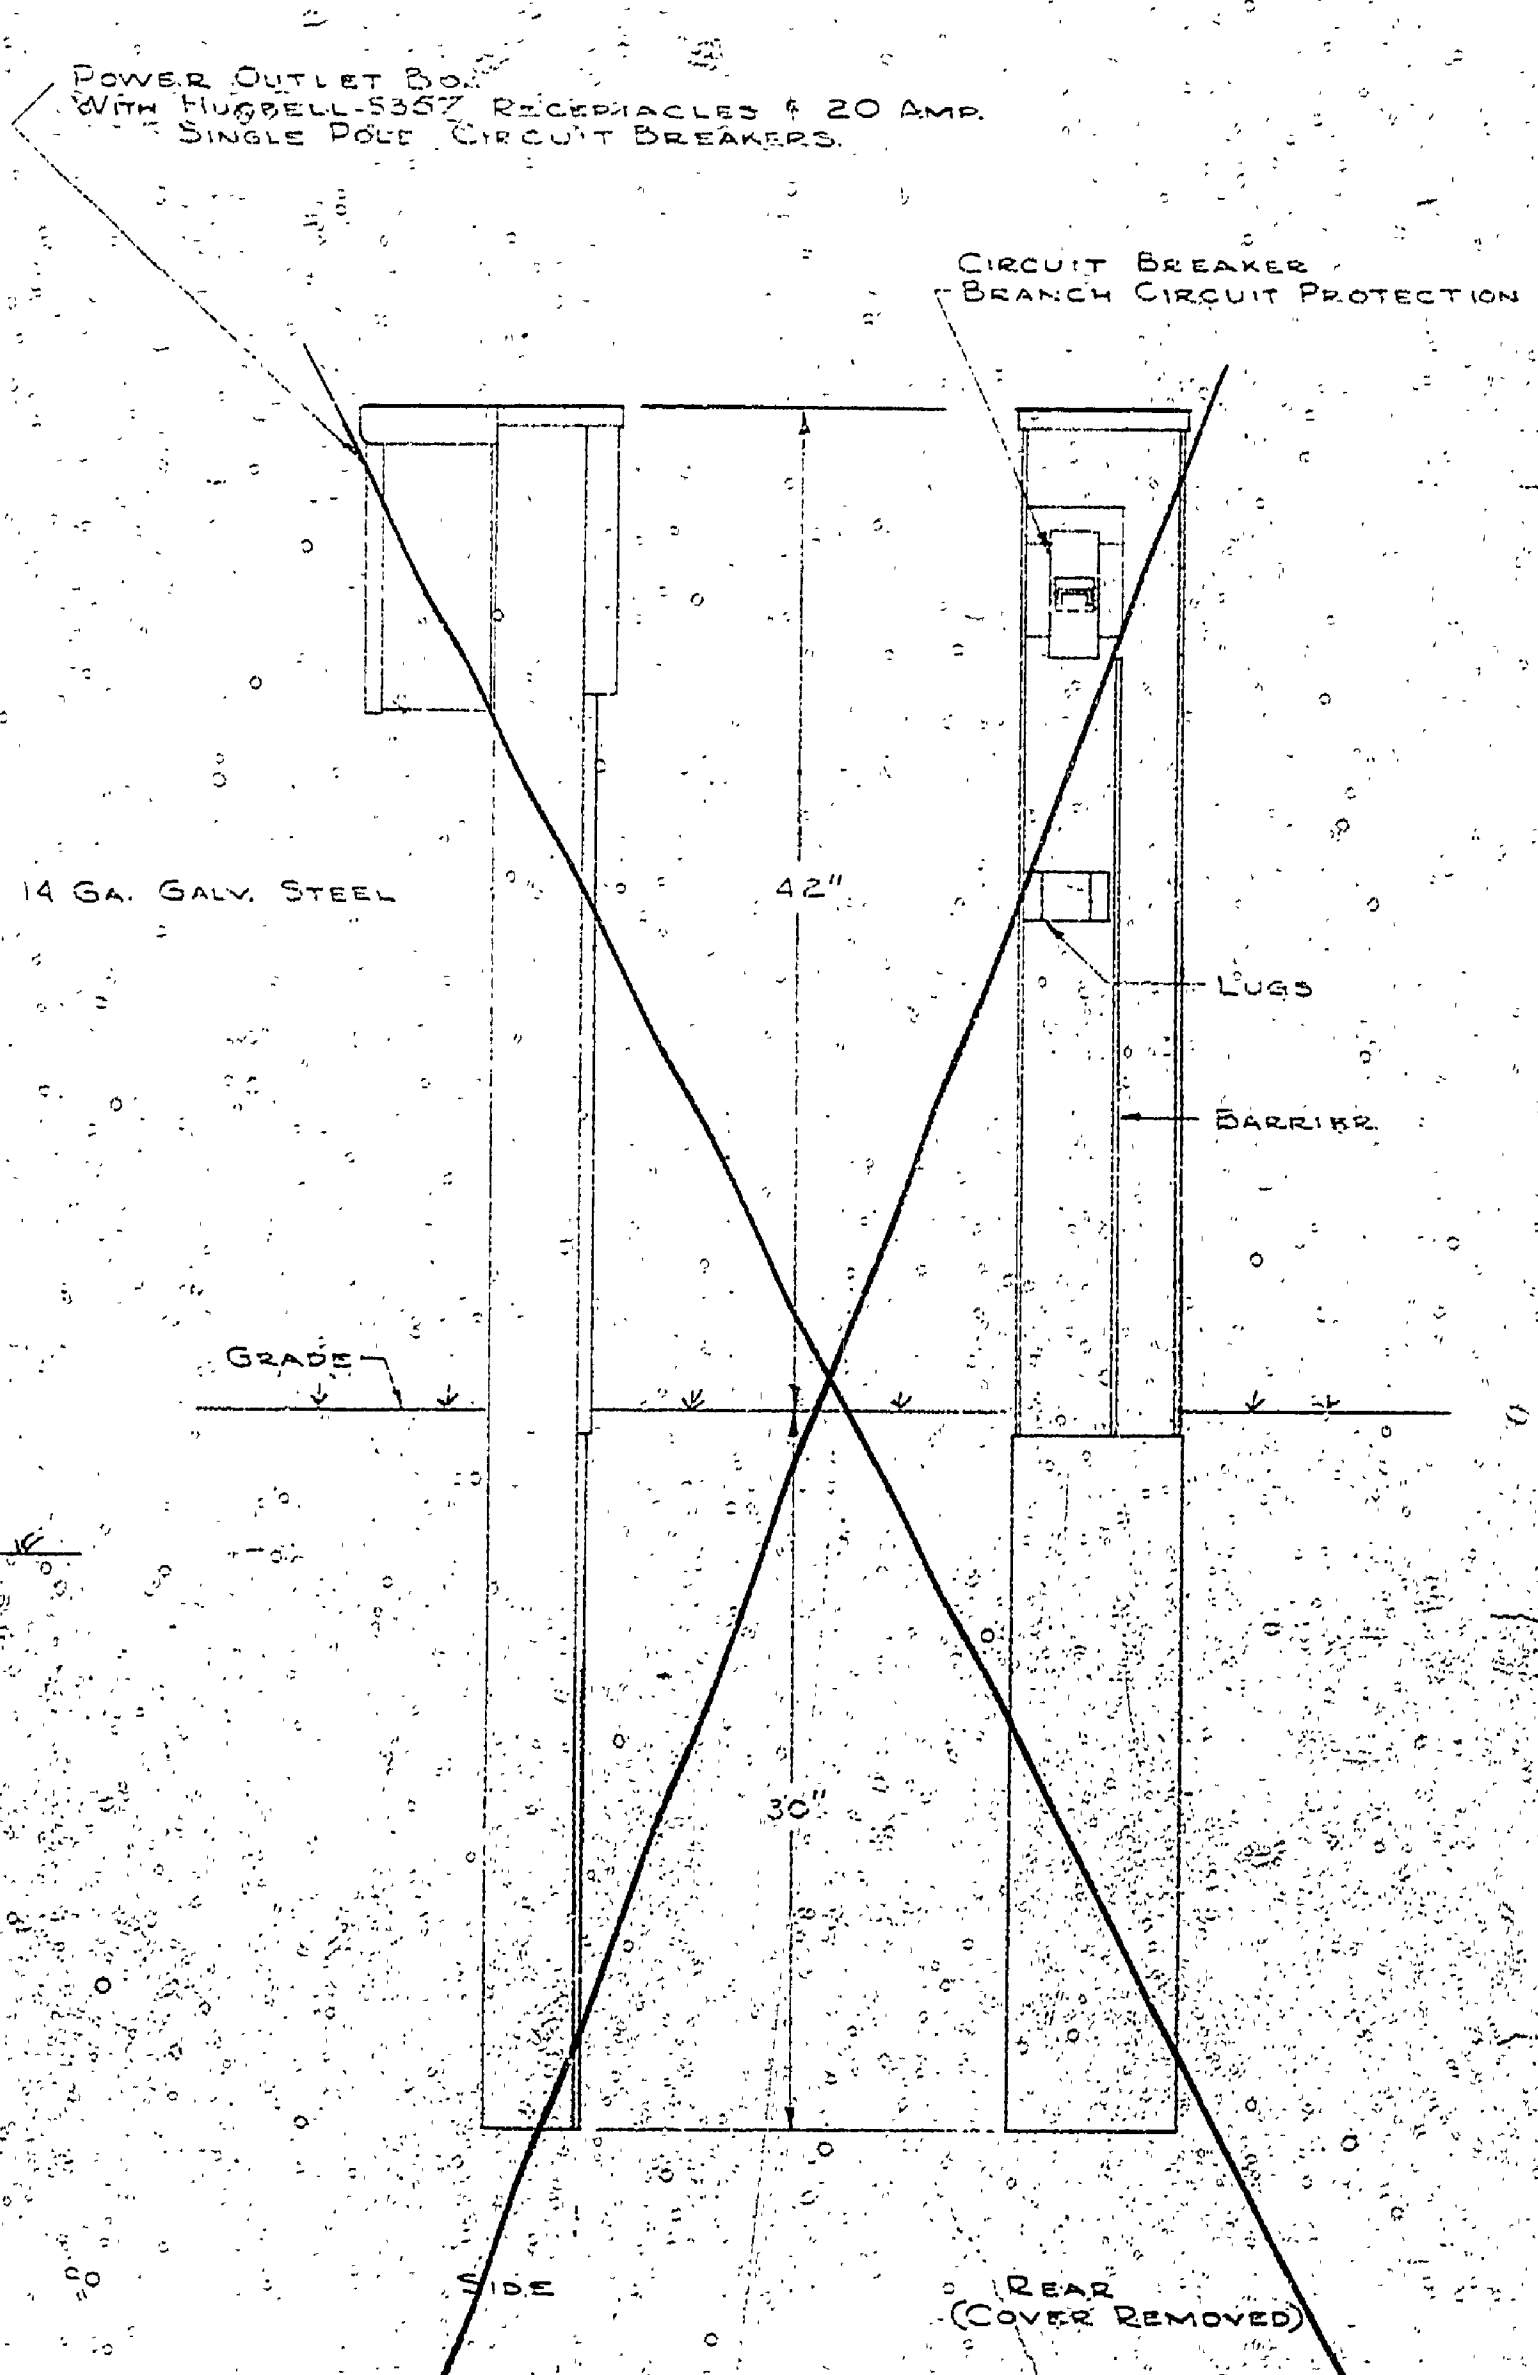


JUNCTION POST
 WITH OUTLET BOX & BRANCH CIRCUIT PROTECTION

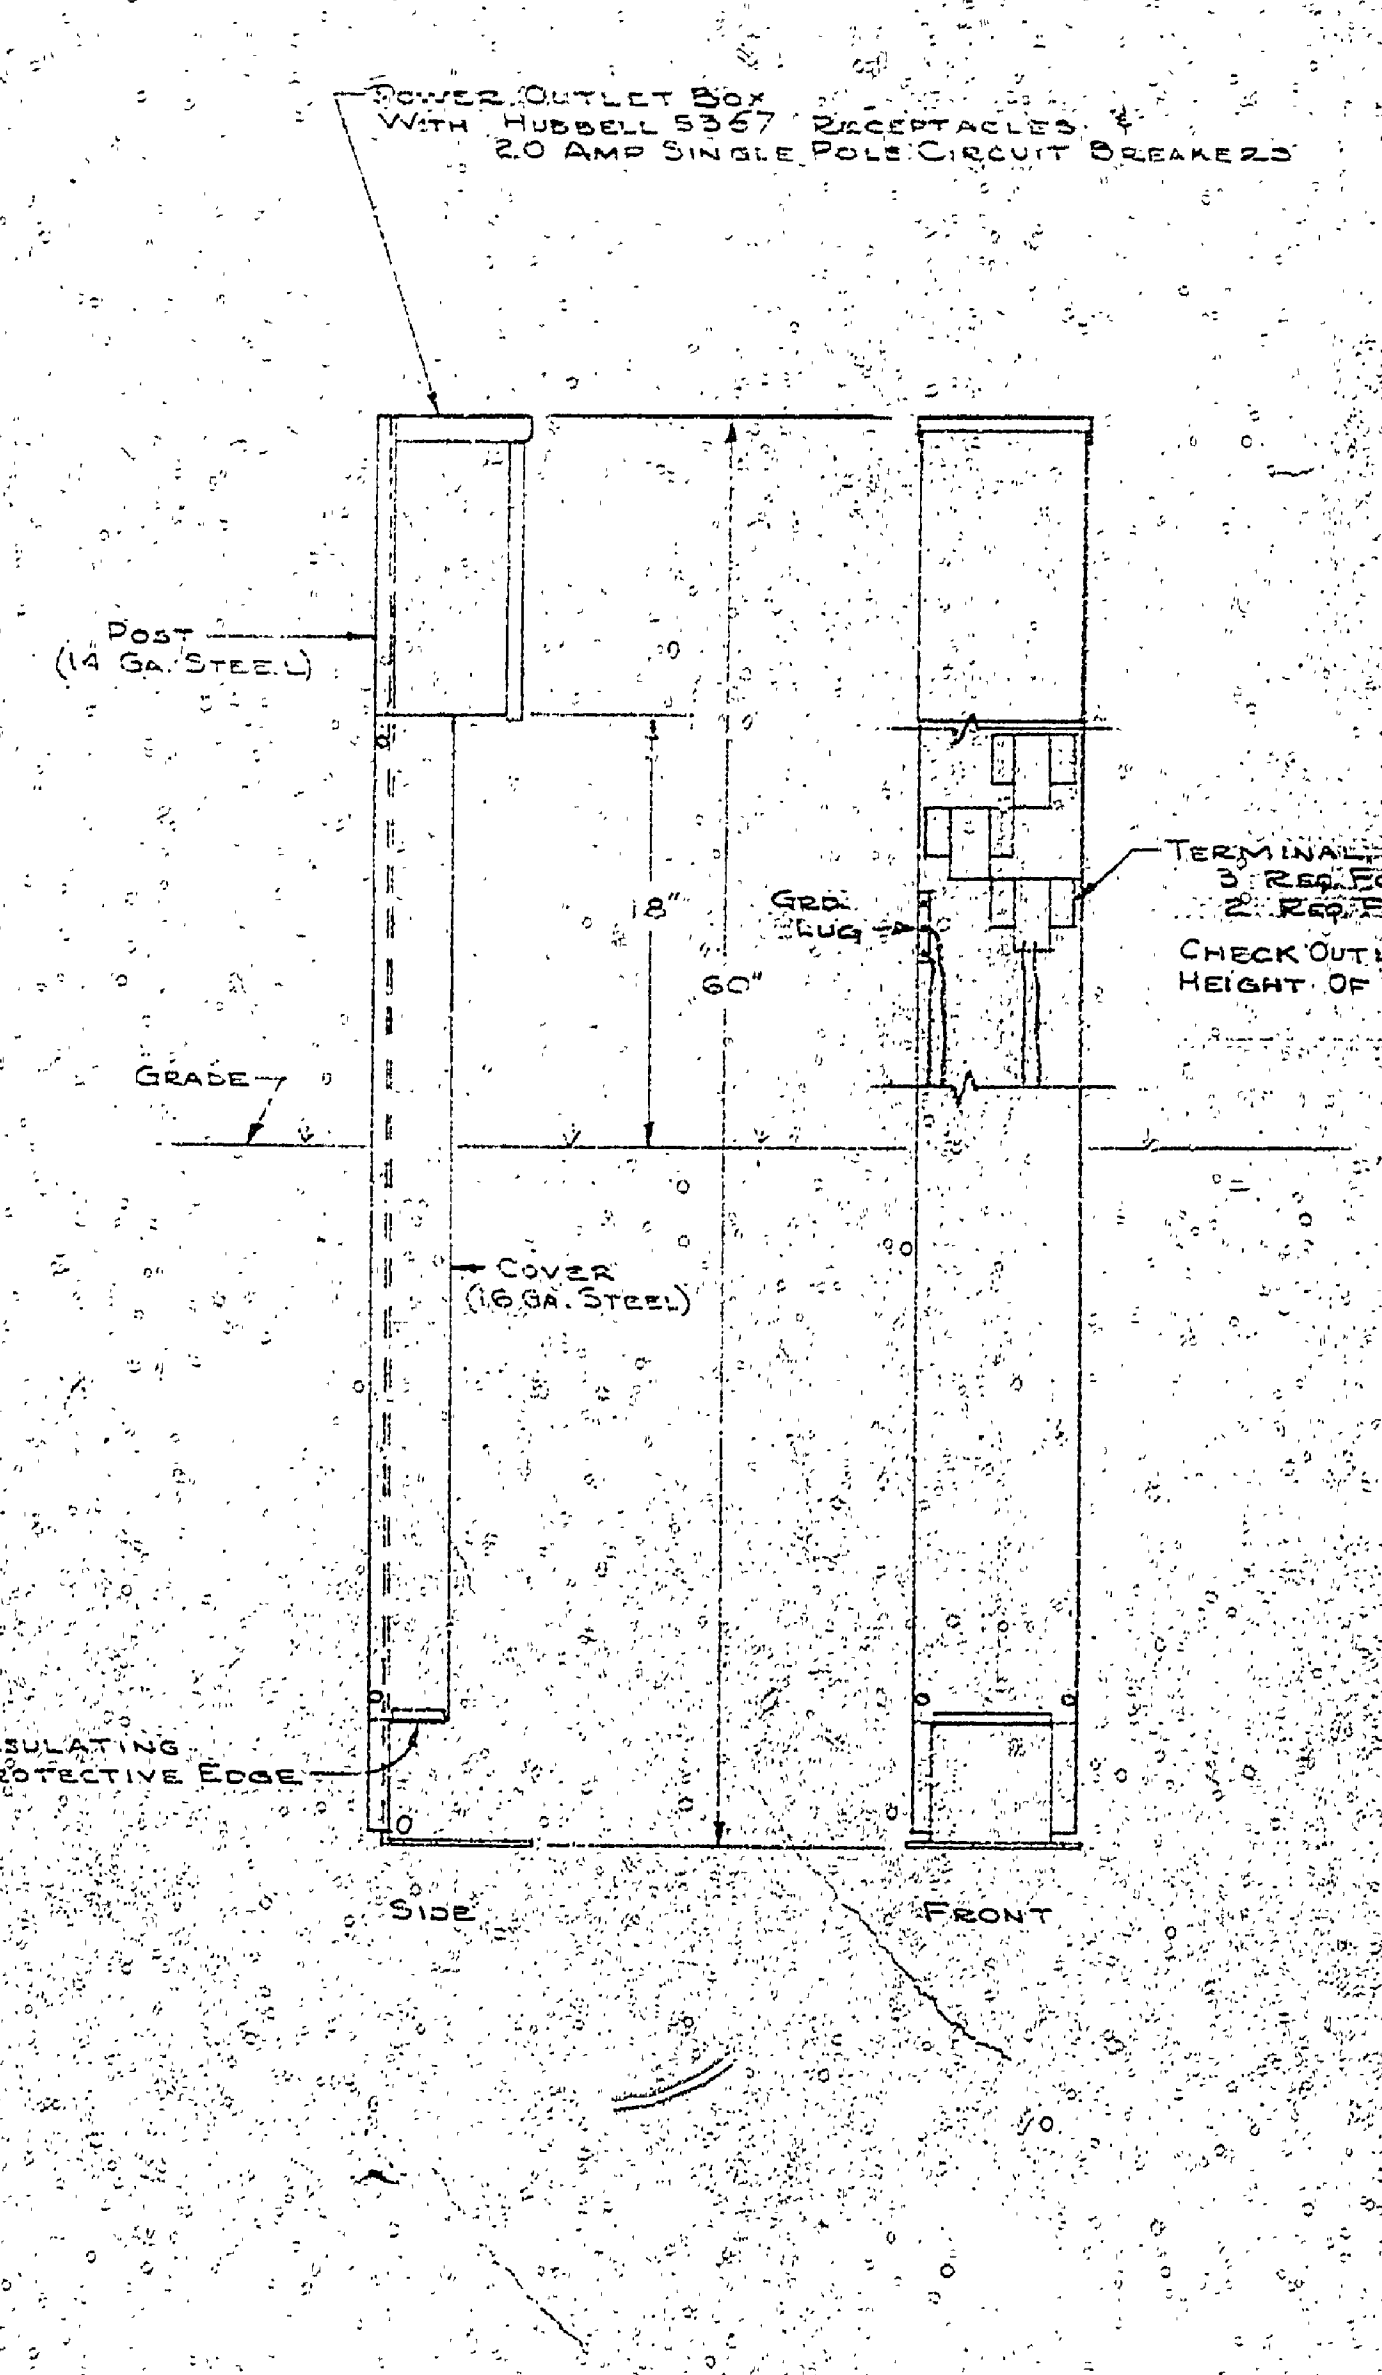

MOUNTING POST
 WITH OUTLET BOX

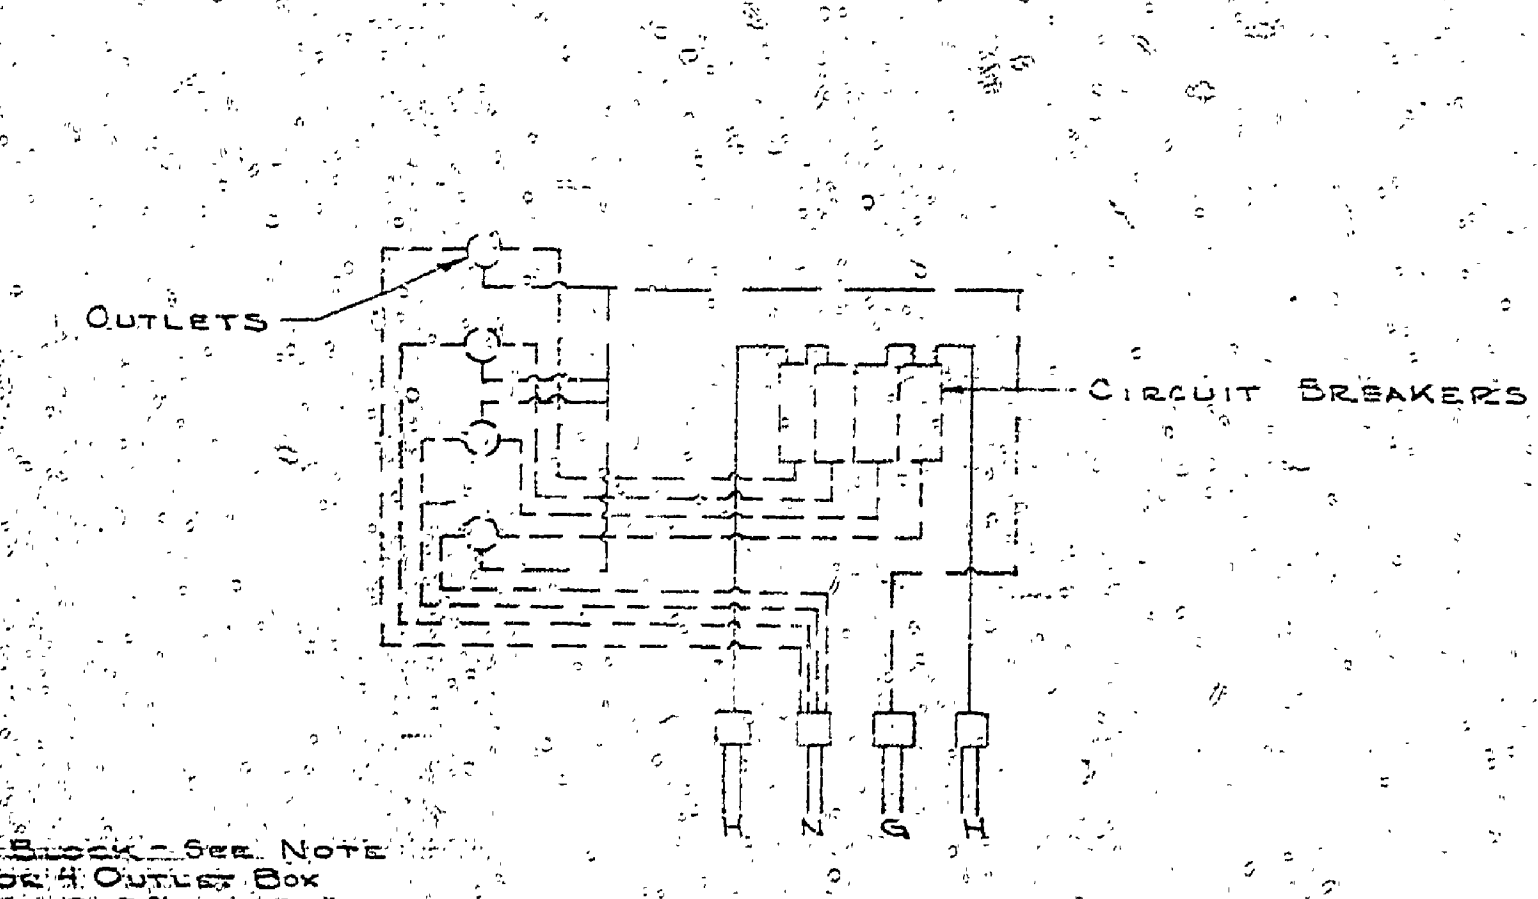

WIRING DIAGRAM FOR 4 OUTLET BOXES

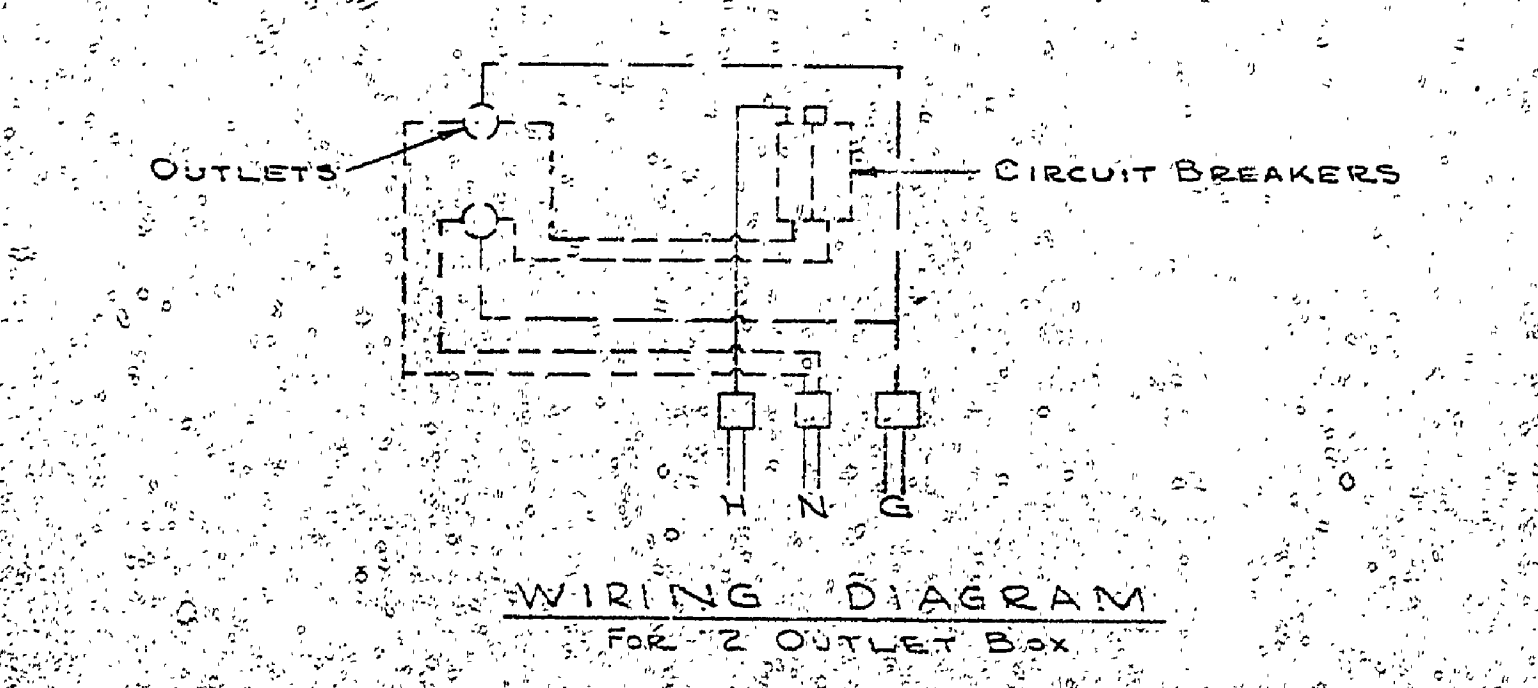

WIRING DIAGRAM FOR 2 OUTLET BOX

NOTE: THESE POSTS ARE DESIGNED TO PERMIT LOOPING OF CABLE FROM ONE UNIT TO THE NEXT. SPlicing TO BE DONE IN POST. LUGS ARE PROVIDED TO RELIEVE UP TO #4/0 WIRE. GROUND TO BARRIERS TO EQUIPMENT GROUND PROVIDED ON POST.

SURVEYED BY	DRAWN BY	NO.	DATE	BY	REVISIONS	NO.	DATE	BY	REVISIONS	MICHIGAN DEPARTMENT OF CONSERVATION	STANDARD PLAN UNDERGROUND SECONDARY FOR CAMPGROUND	SHEET NO. OF	INDIAN LAKE STATE PARK
DESIGNED BY	CHECKED BY	1.	4/15/58	J.Y.	WIRING DIA. REV. TERMINAL BLOCK ADDED	3.						FOR PROJECT NO. 24-1379	
		2.	11/25/59	J.W.	CONDUIT PLUMBING ADDED	4.							SHEET 2 OF 2 PLAN NO. E-116