

REVISIONS	NO.	DATE	BY
	1		
	2		
	3		
	4		
	5		
	6		

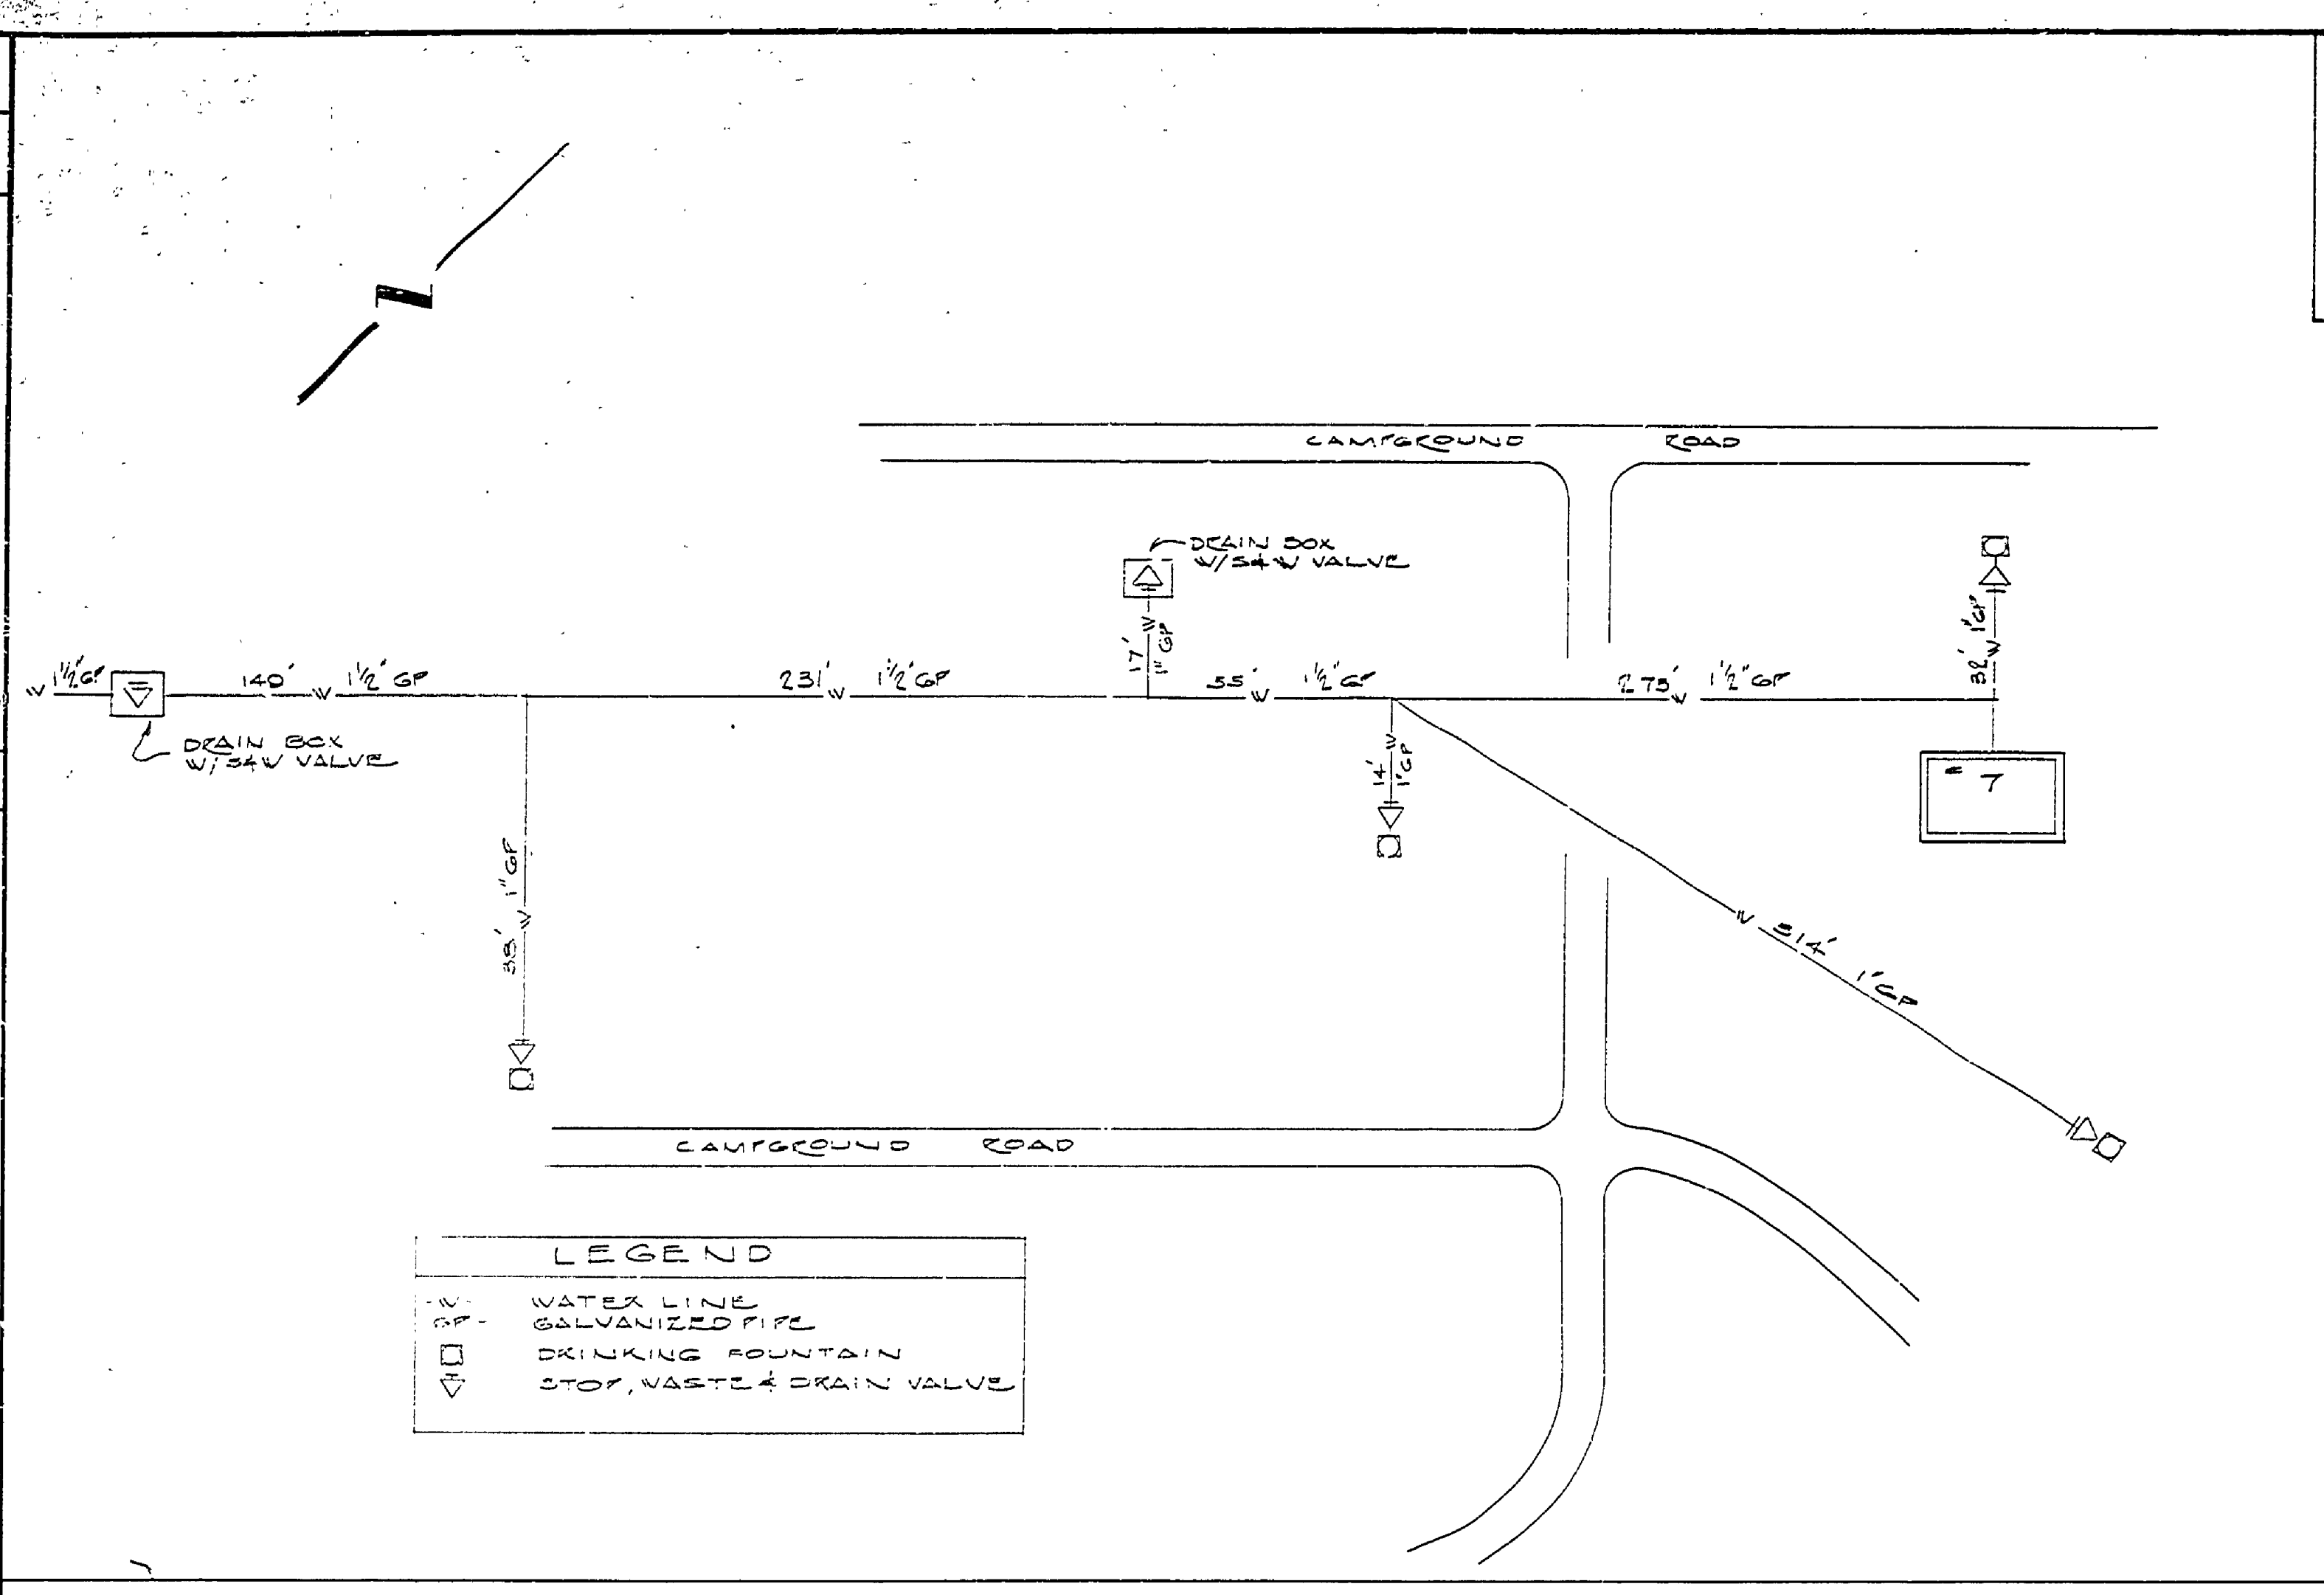


PLATE NO.	9
NO. SCALE	
DRAWN BY U.C.	
MICHIGAN DEPT. OF CONSERVATION	WEST CAMPGROUND D. FOUNTAINS
INDIAN LAKE STATE PARK	WATER SYSTEM

APPROVED BY	DATE	REVIEWED BY SECTIONS
<i>[Signature]</i>	9-14-60	ARCHITECTURAL
ASSISTANT CHIEF IN CHARGE	9-14-60	ENGINEERING
OF DESIGN	9-14-60	LANDSCAPE

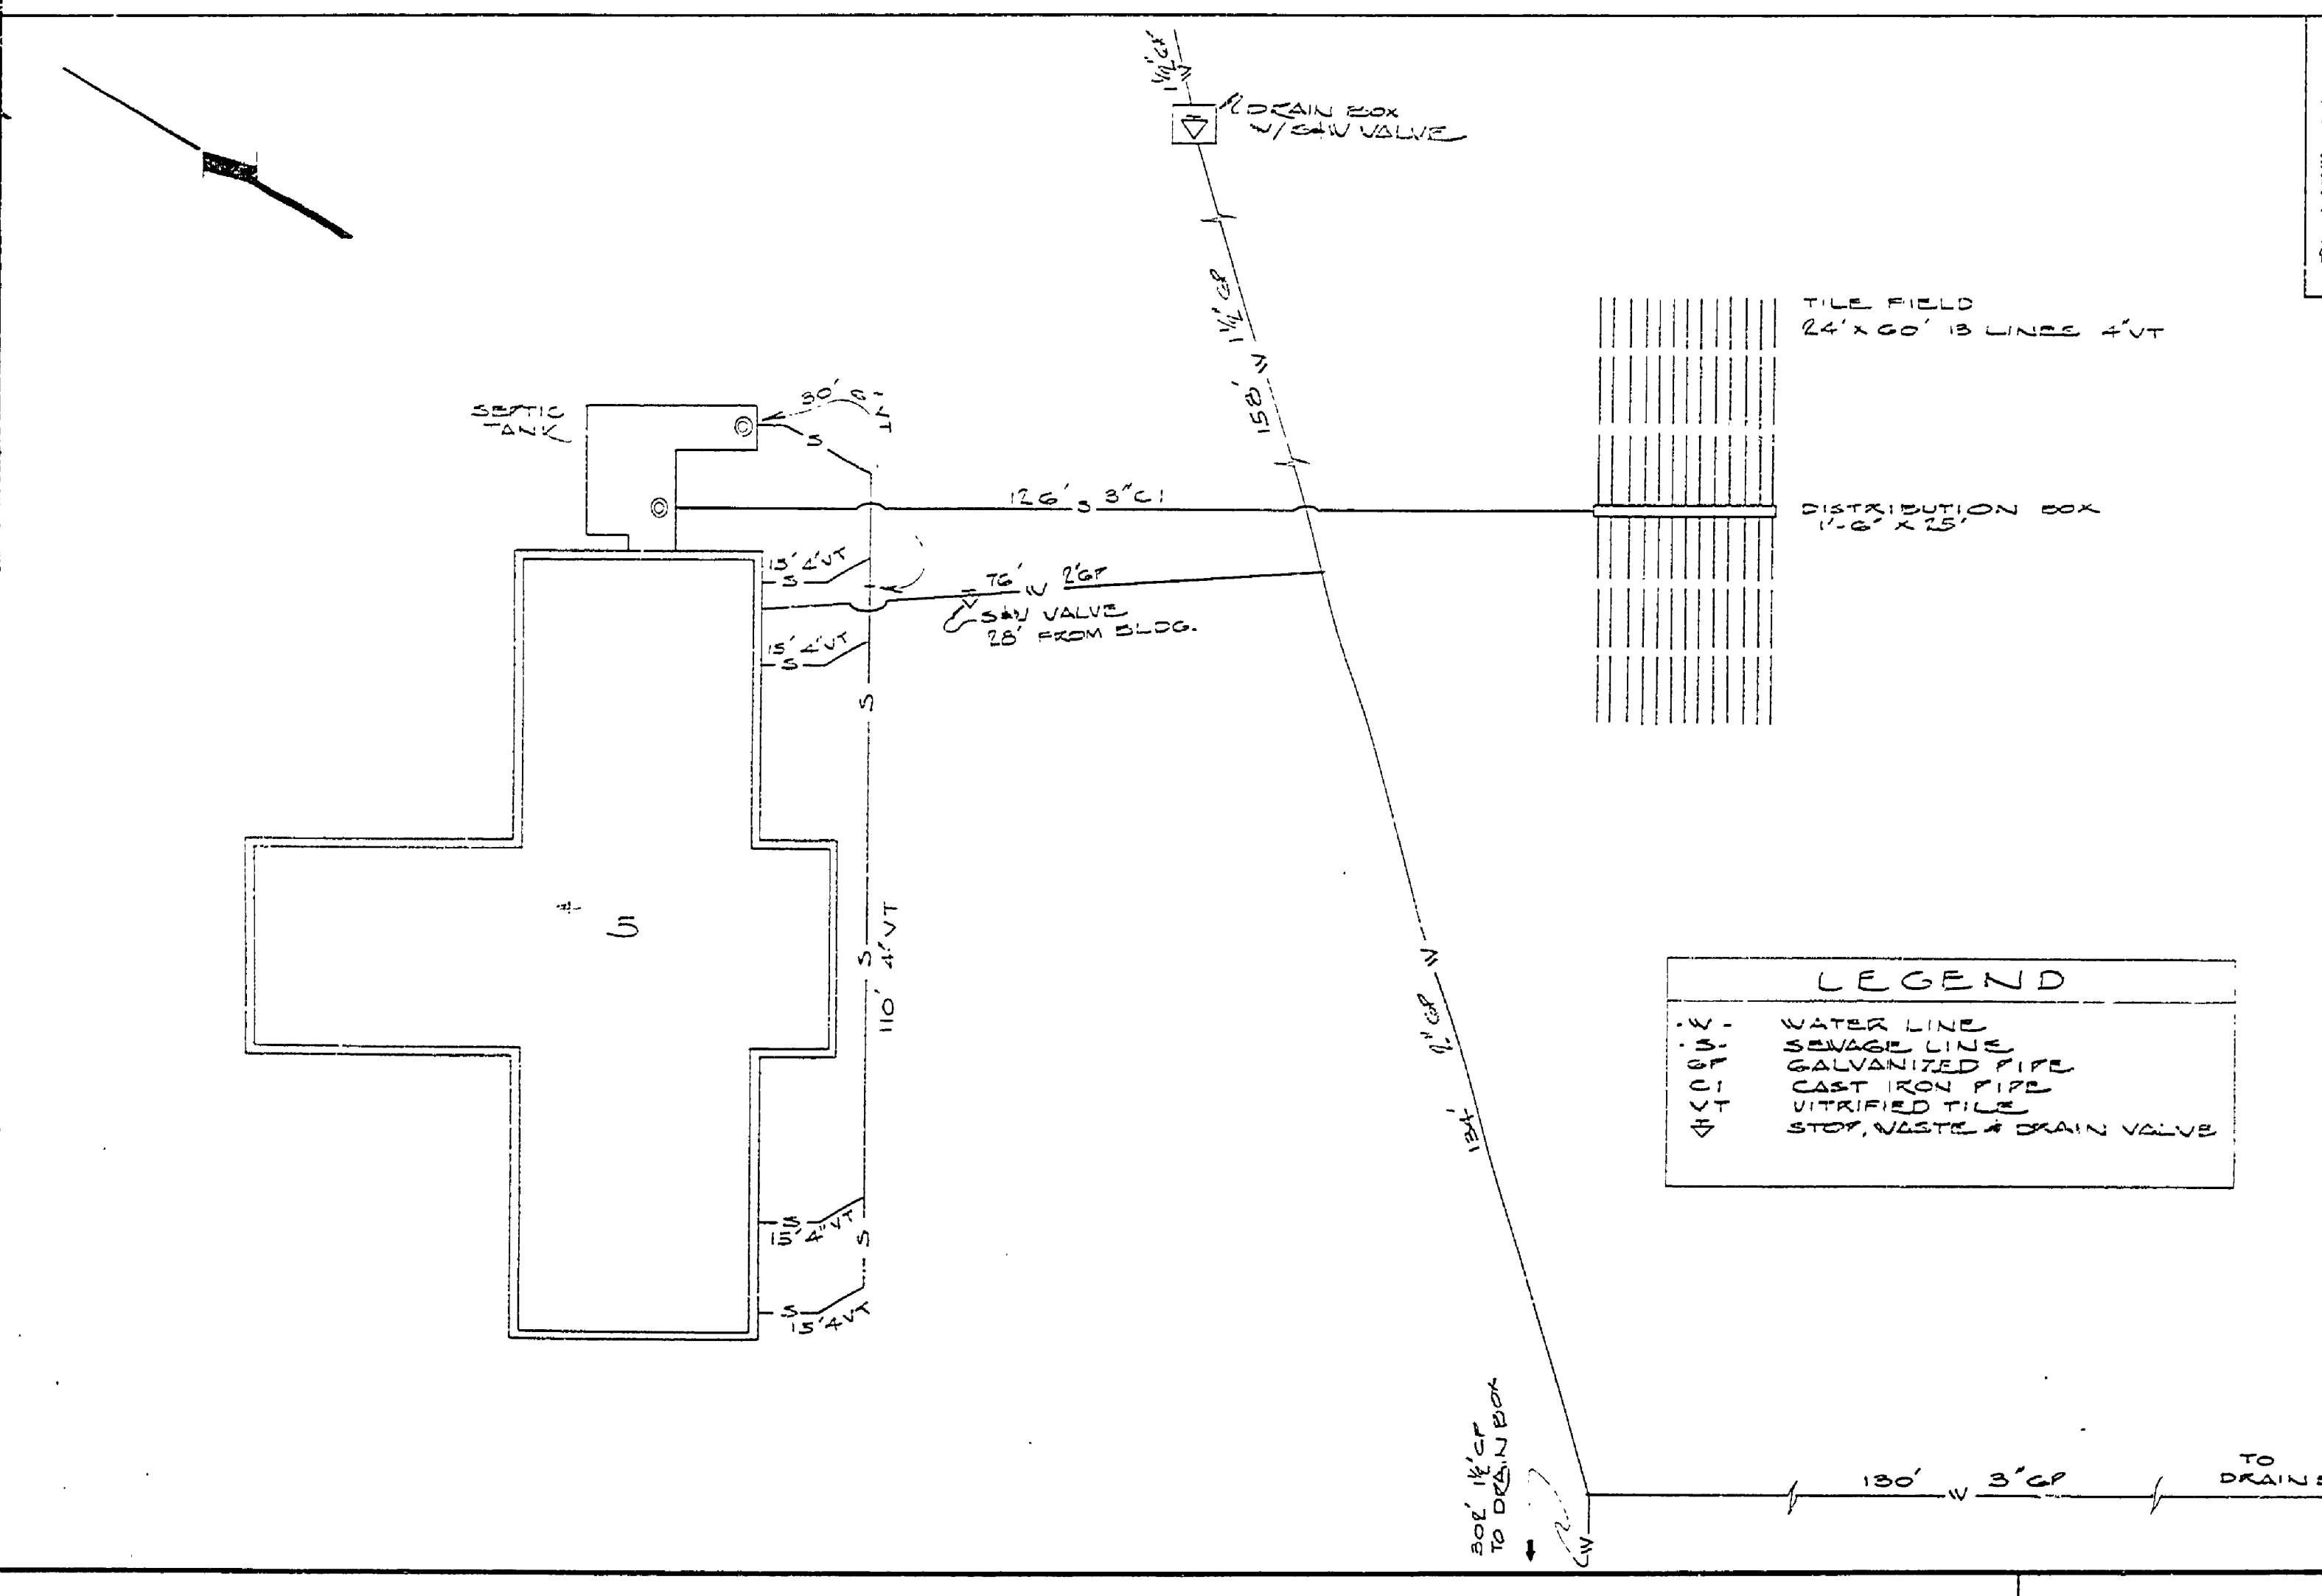


PLATE NO.	7
SCALE	1" = 40' 0"
DRAWN BY U.C.	
MICHIGAN DEPT. OF CONSERVATION	BATHHOUSE #5
INDIAN LAKE STATE PARK	WATER & SEWERAGE SYSTEM

INDIAN LAKE STATE PARK

SCALE - AS SHOWN

 


PLATE NO.	8
NO. SCALE	
DRAWN BY U.C.	
MICHIGAN DEPT. OF CONSERVATION	EAST CAMPGROUND D. FOUNTAINS
INDIAN LAKE STATE PARK	WATER SYSTEM

INDIAN LAKE STATE PARK

MICHIGAN DEPARTMENT OF CONSERVATION
PARKS AND RECREATION DIVISION

INDIAN LAKE STATE PARK
UTILITY MAP
WATER & SEWERAGE SYSTEM

SHEET NO. 016 OF 016

PLAN NO. U-1