R-1638 COMMERCIAL BLUEPRINT SERVICE 12-70 43046

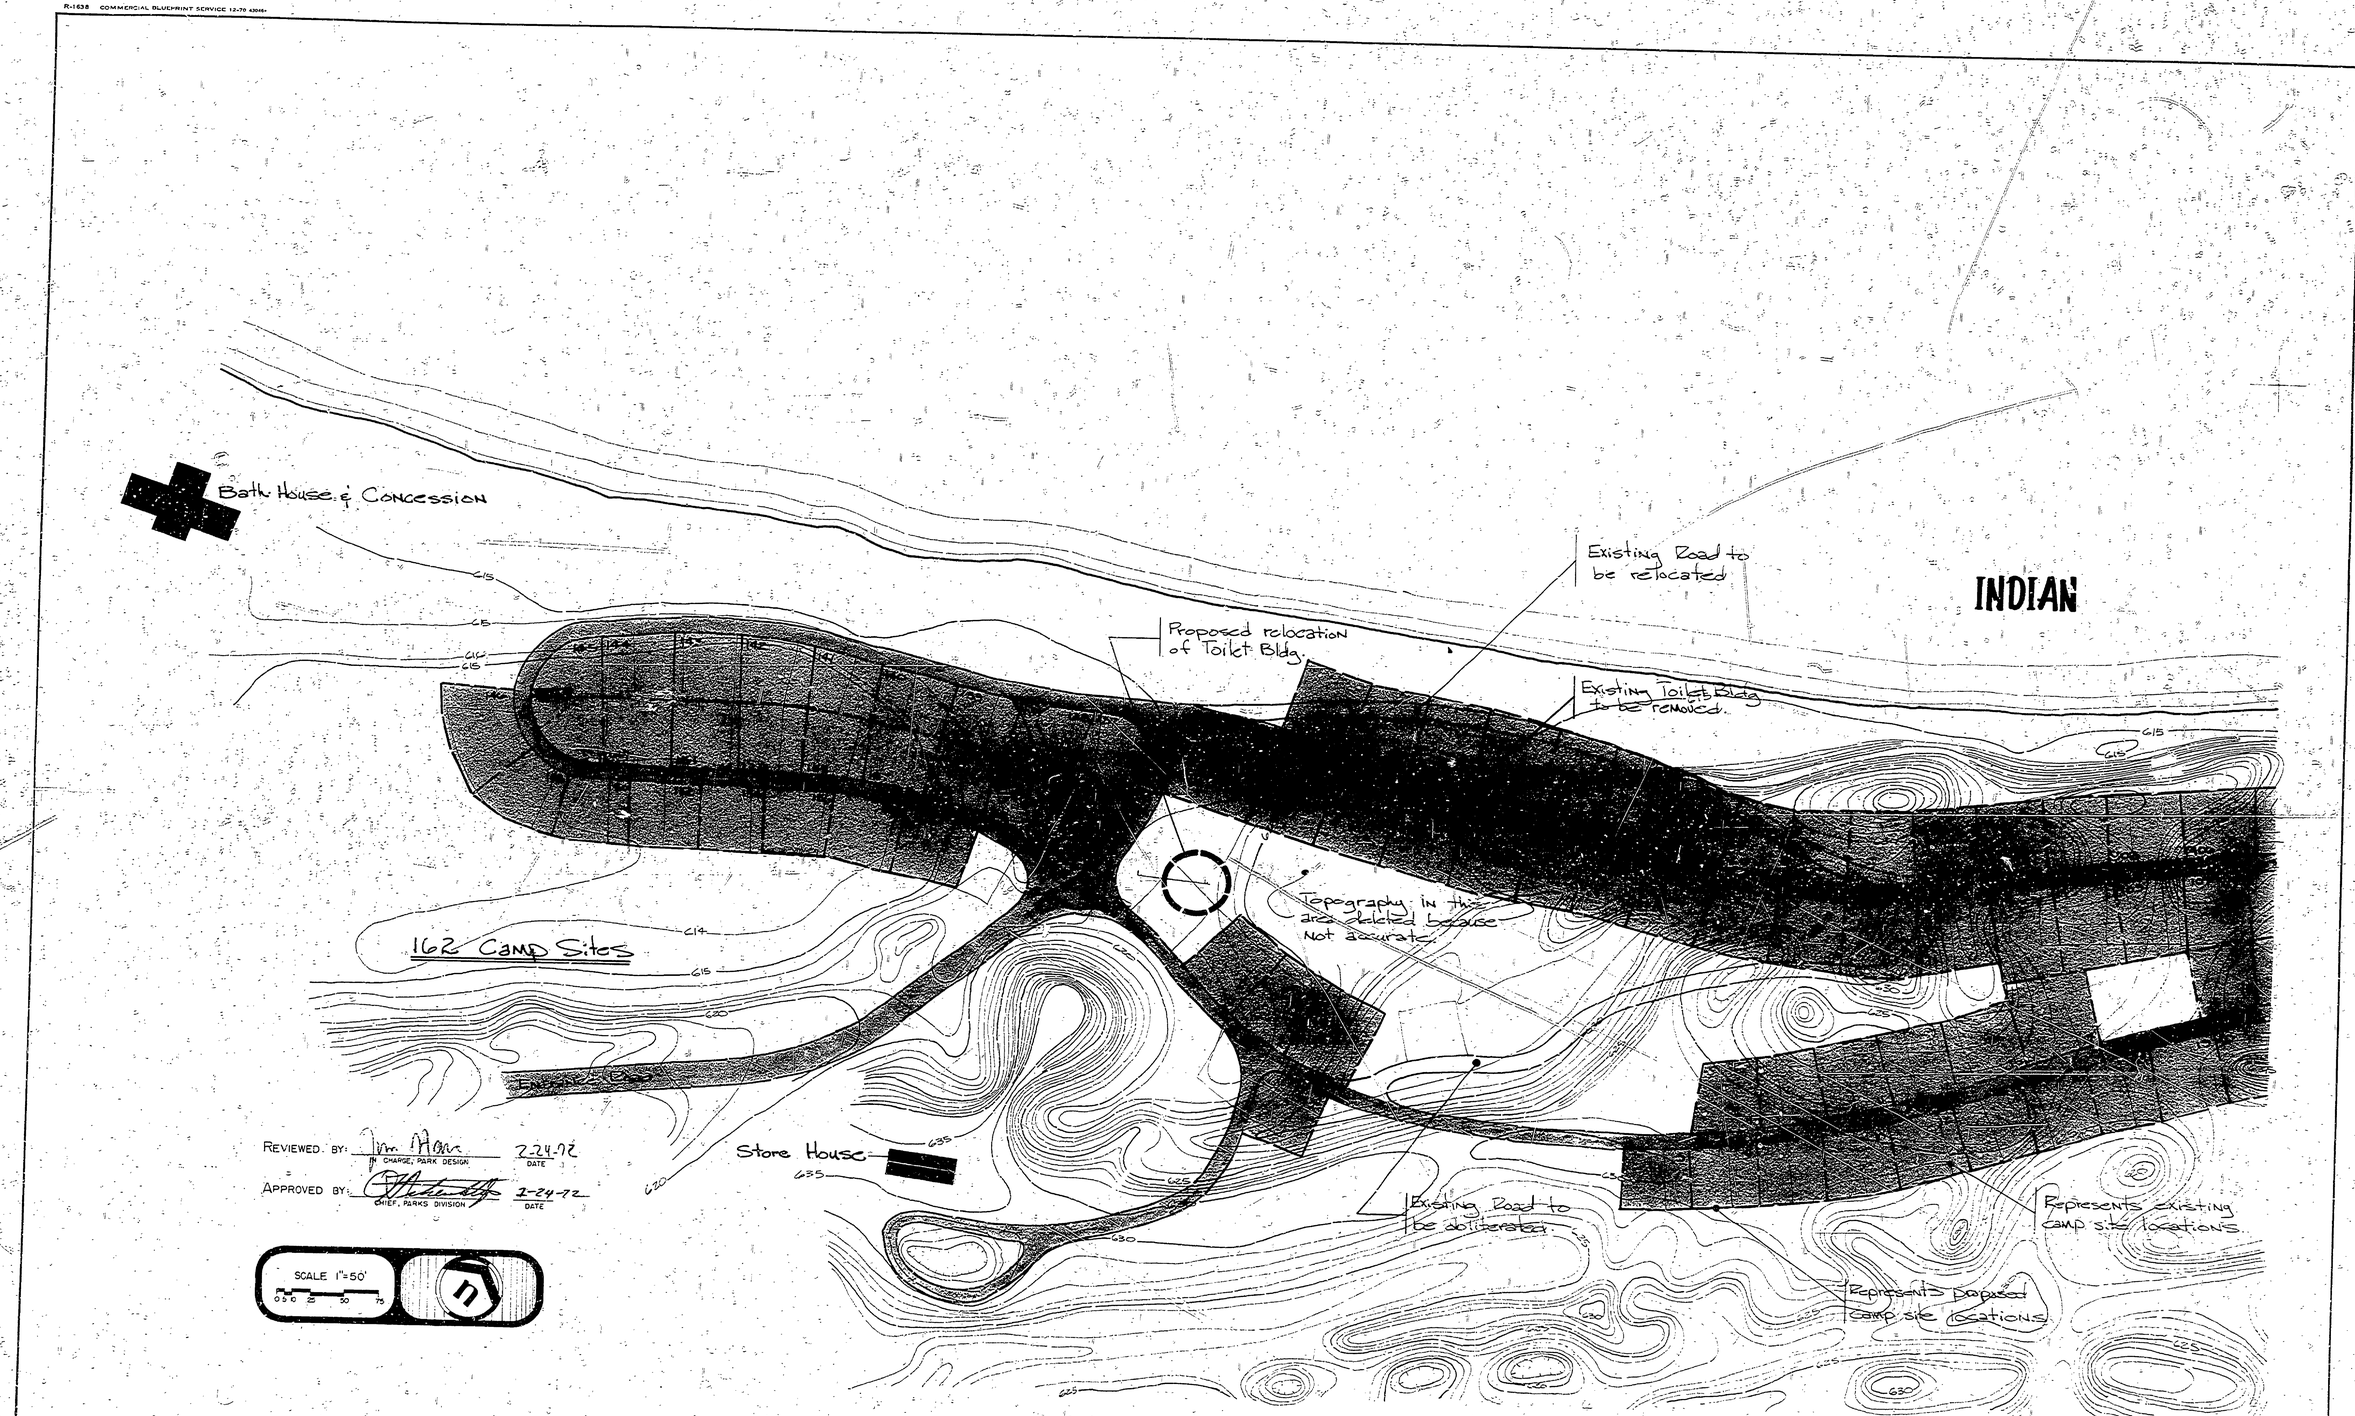

REVIEWED BY: Jm. Hom — IN CHARGE, PARK DESIGN — 2-24-72 DATE

APPROVED BY: [signature] — CHIEF, PARKS DIVISION — 2-24-72 DATE

SURVEYED BY		DRAWN BY R. WHITENER	2-3-72
DESIGNED BY		CHECKED BY	
	DATE		DATE

NO.	DATE	BY	REVISIONS	NO.	DATE	BY	REVISIONS
1.	RCW.	2-3-72	REVISED & REDRAWN	3.			
2.				4.			

MICHIGAN
DEPARTMENT OF NATURAL RESOURCES

INDIAN LAKE

AREA OR PARK: INDIAN LAKE STATE PARK

PROJECT: CAMPGROUND DEV.

PROJECT NO.

SHEET 1 OF 2

PLAN NO. L-102