



NORTHWEST ELEVATION

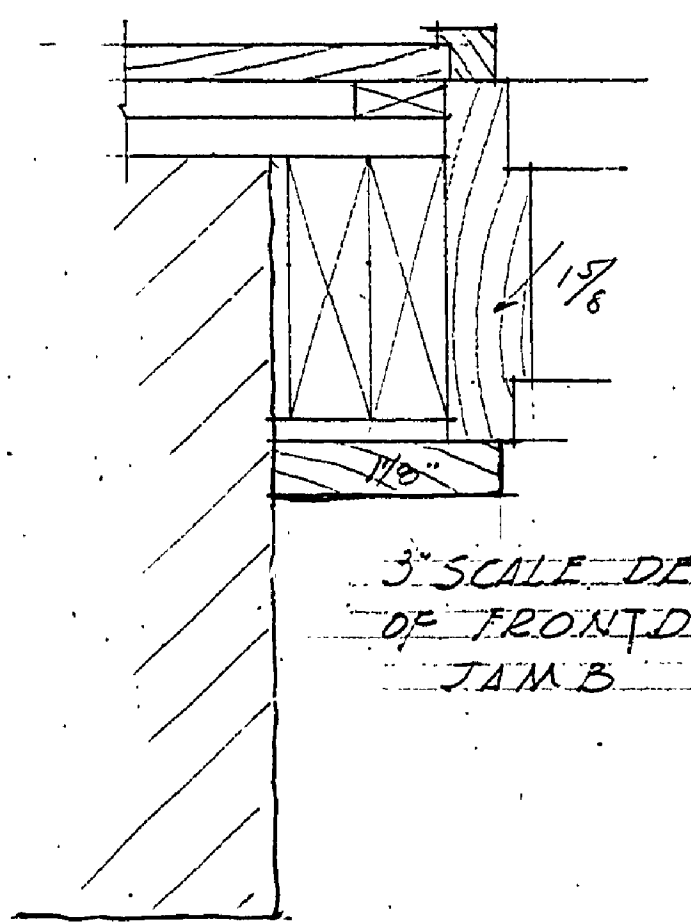


3" SCALE DETAIL OF FRONT DOOR JAMB

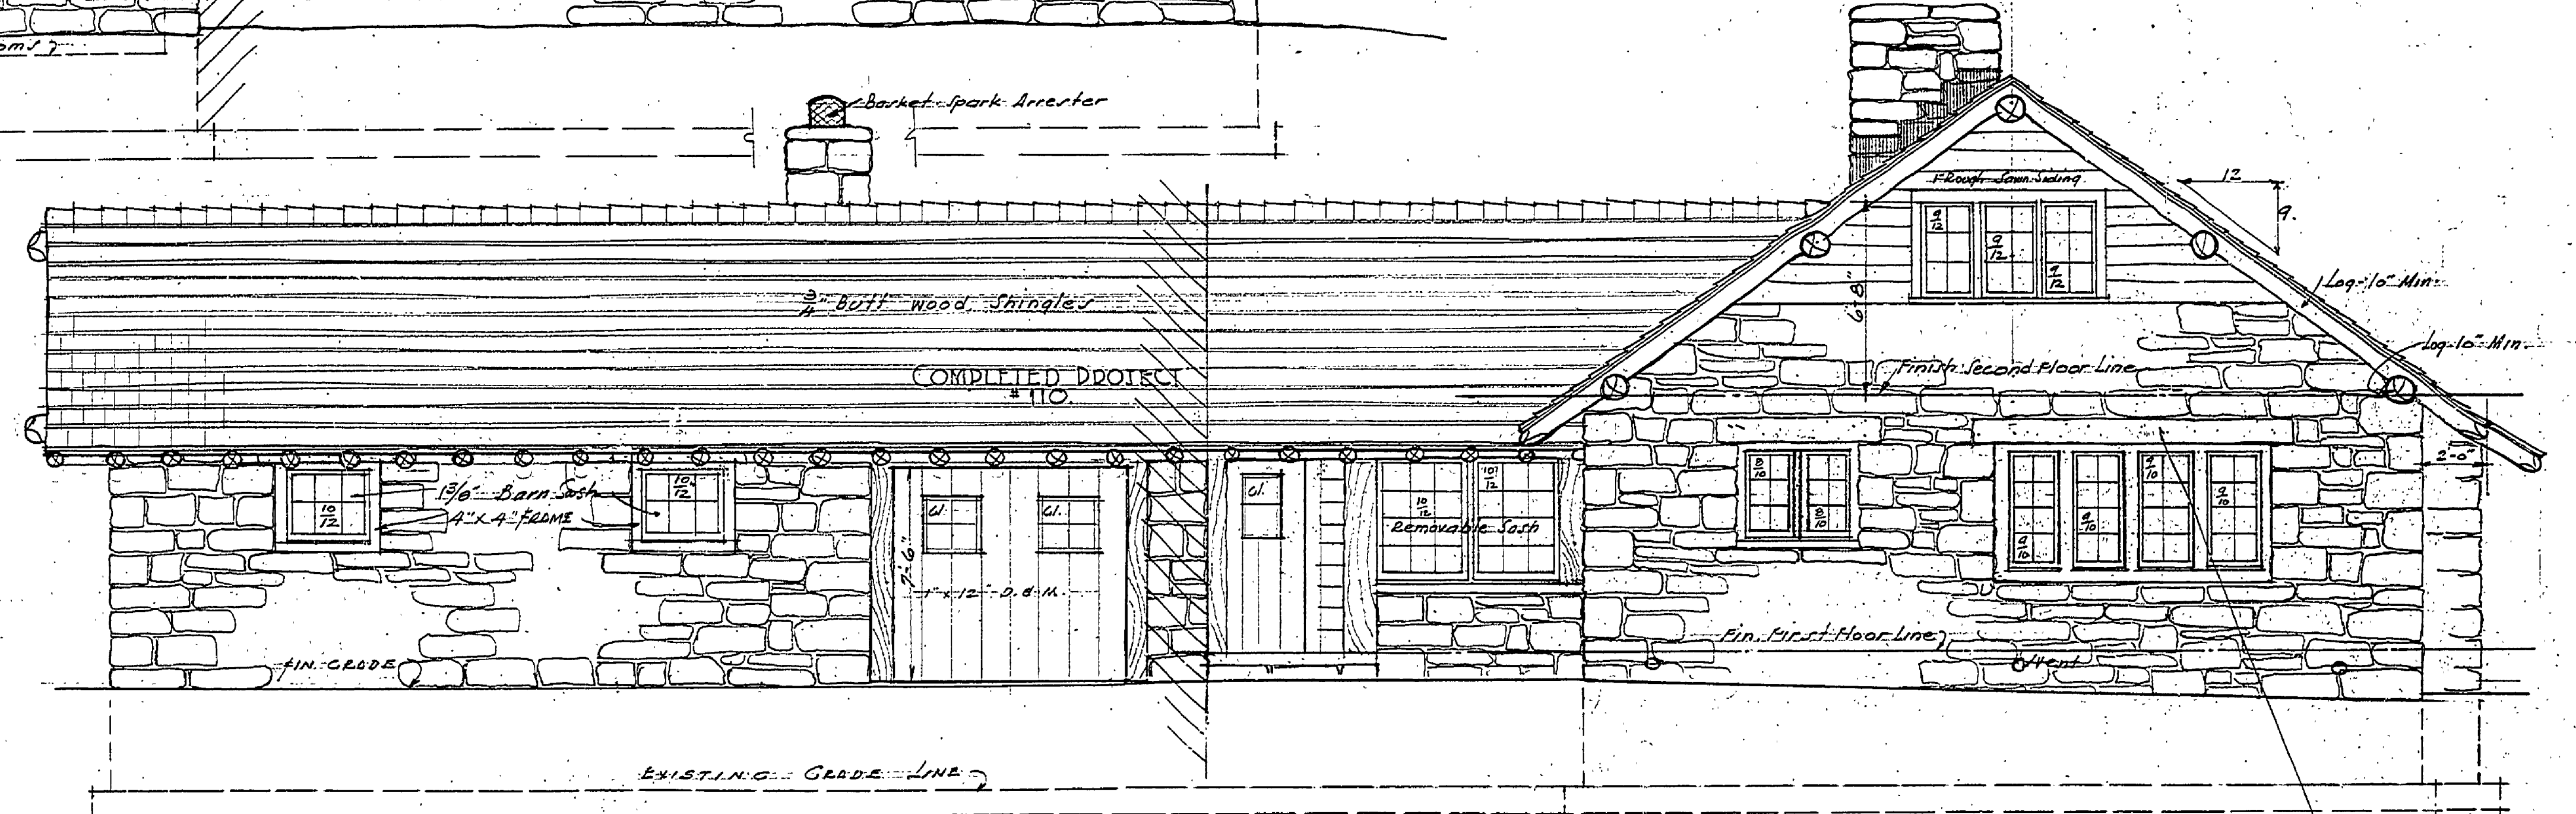


SOUTHEAST ELEVATION

Note: All concrete lintels to be formed of plywood, grain left showing and stain to indicate wood.

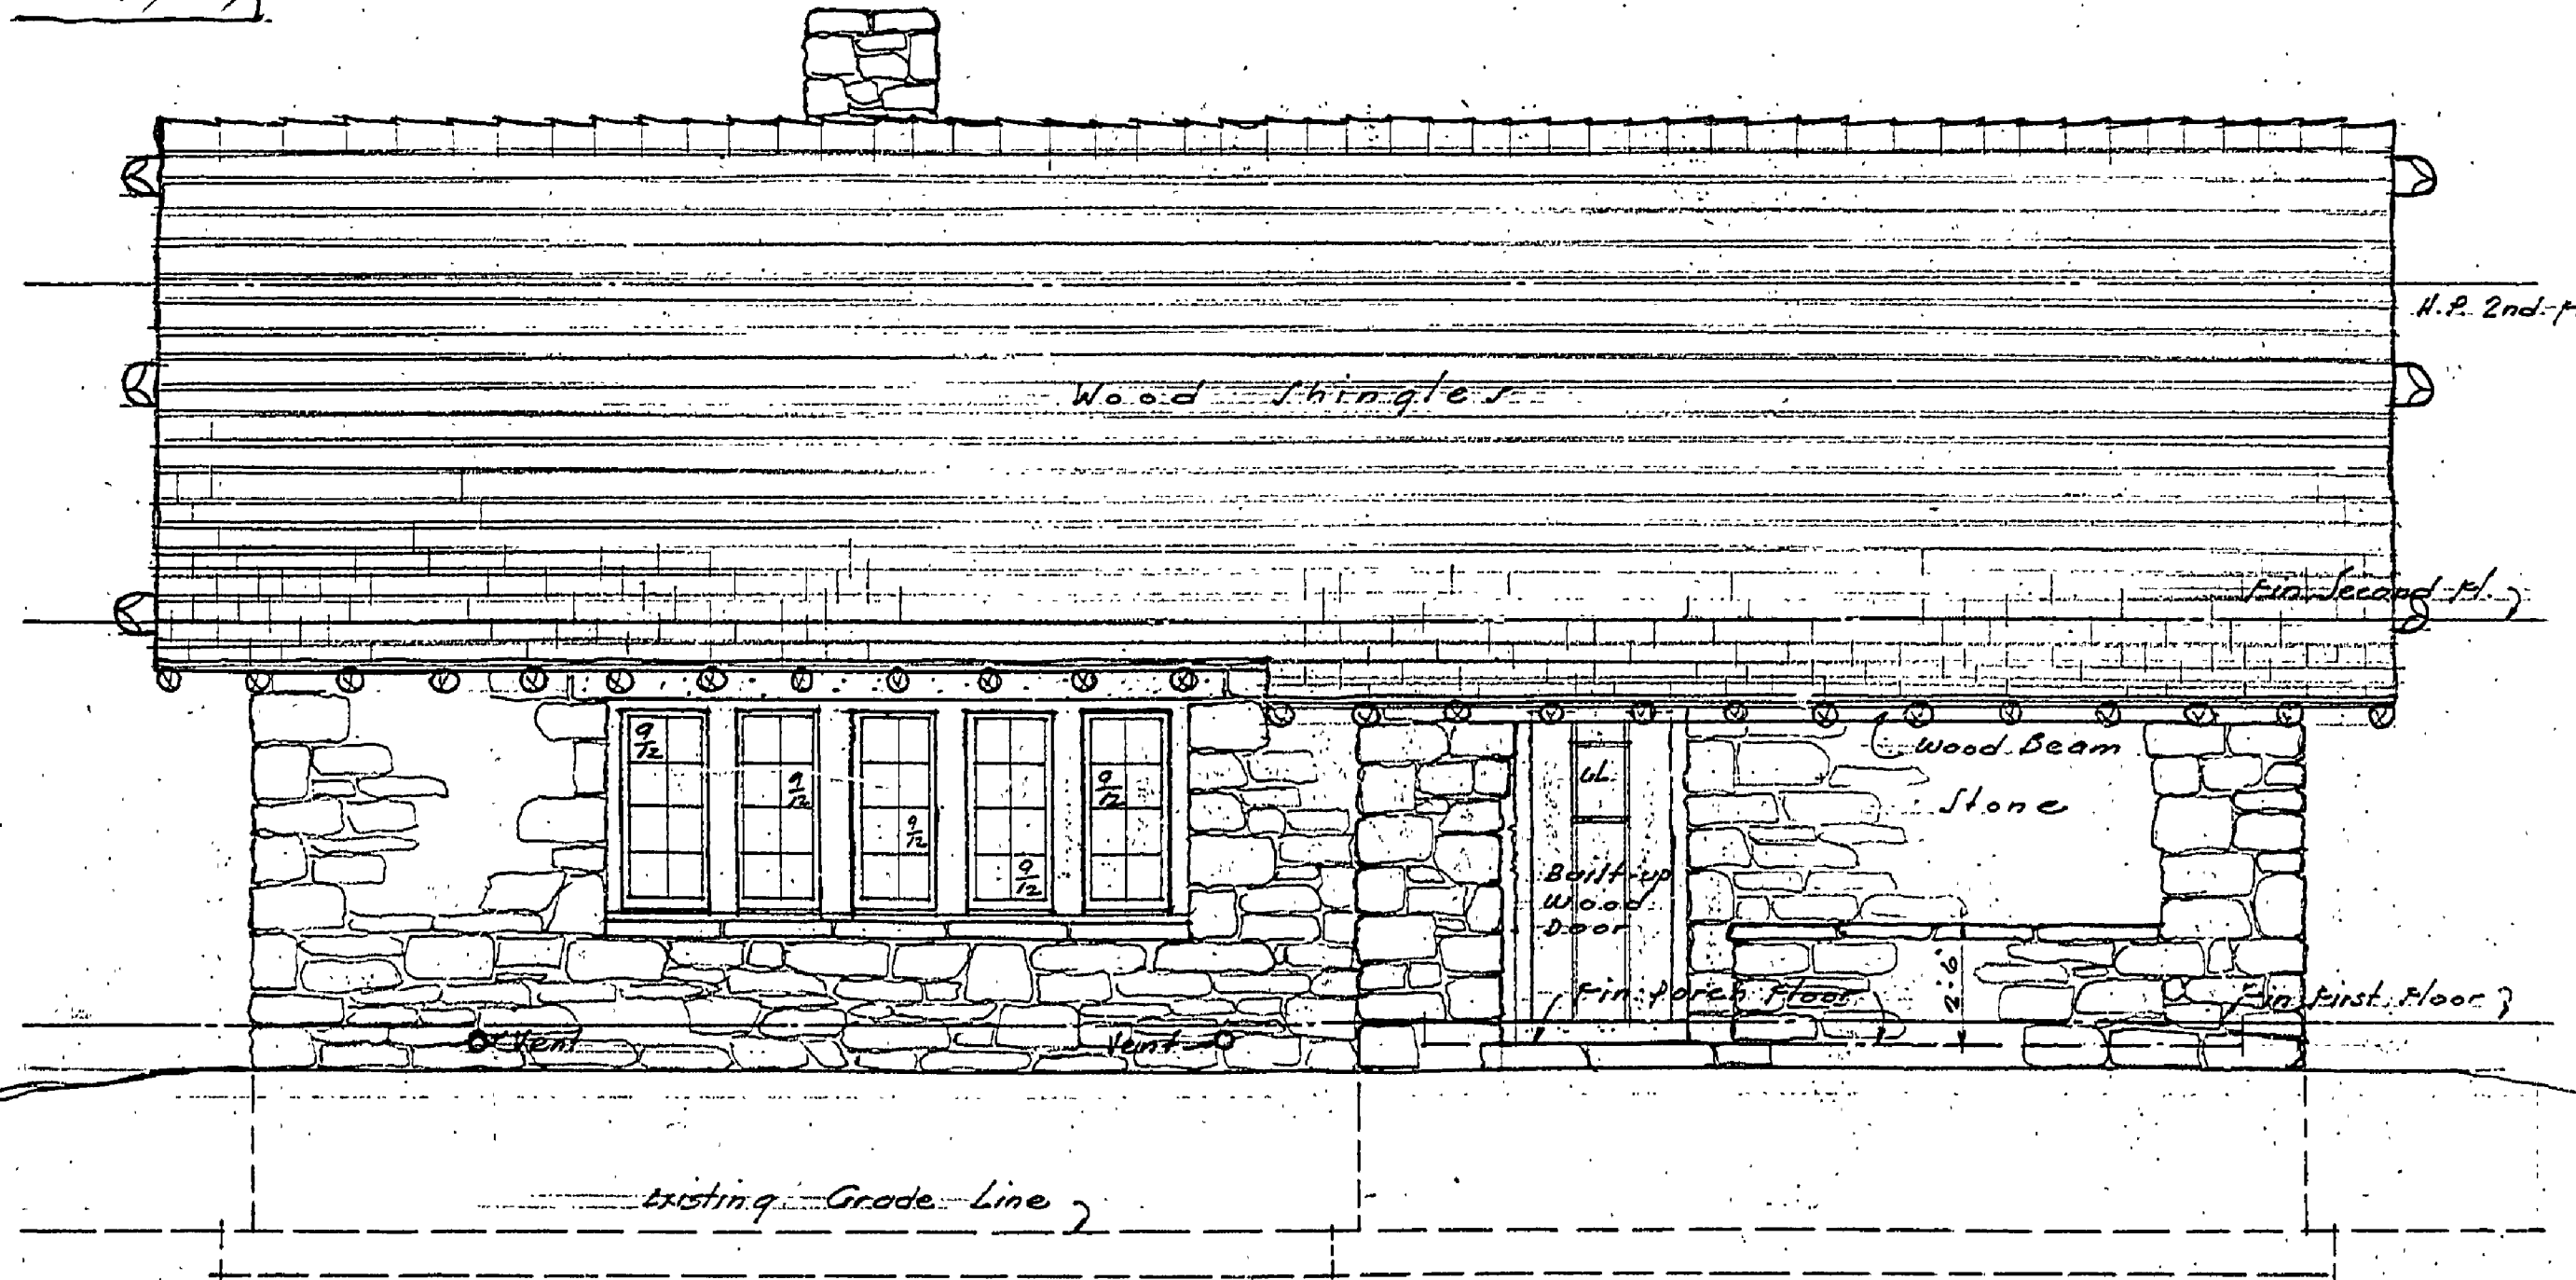

NORTHEAST (FRONT) ELEVATION

SCALE 1/8" = 1'-0"

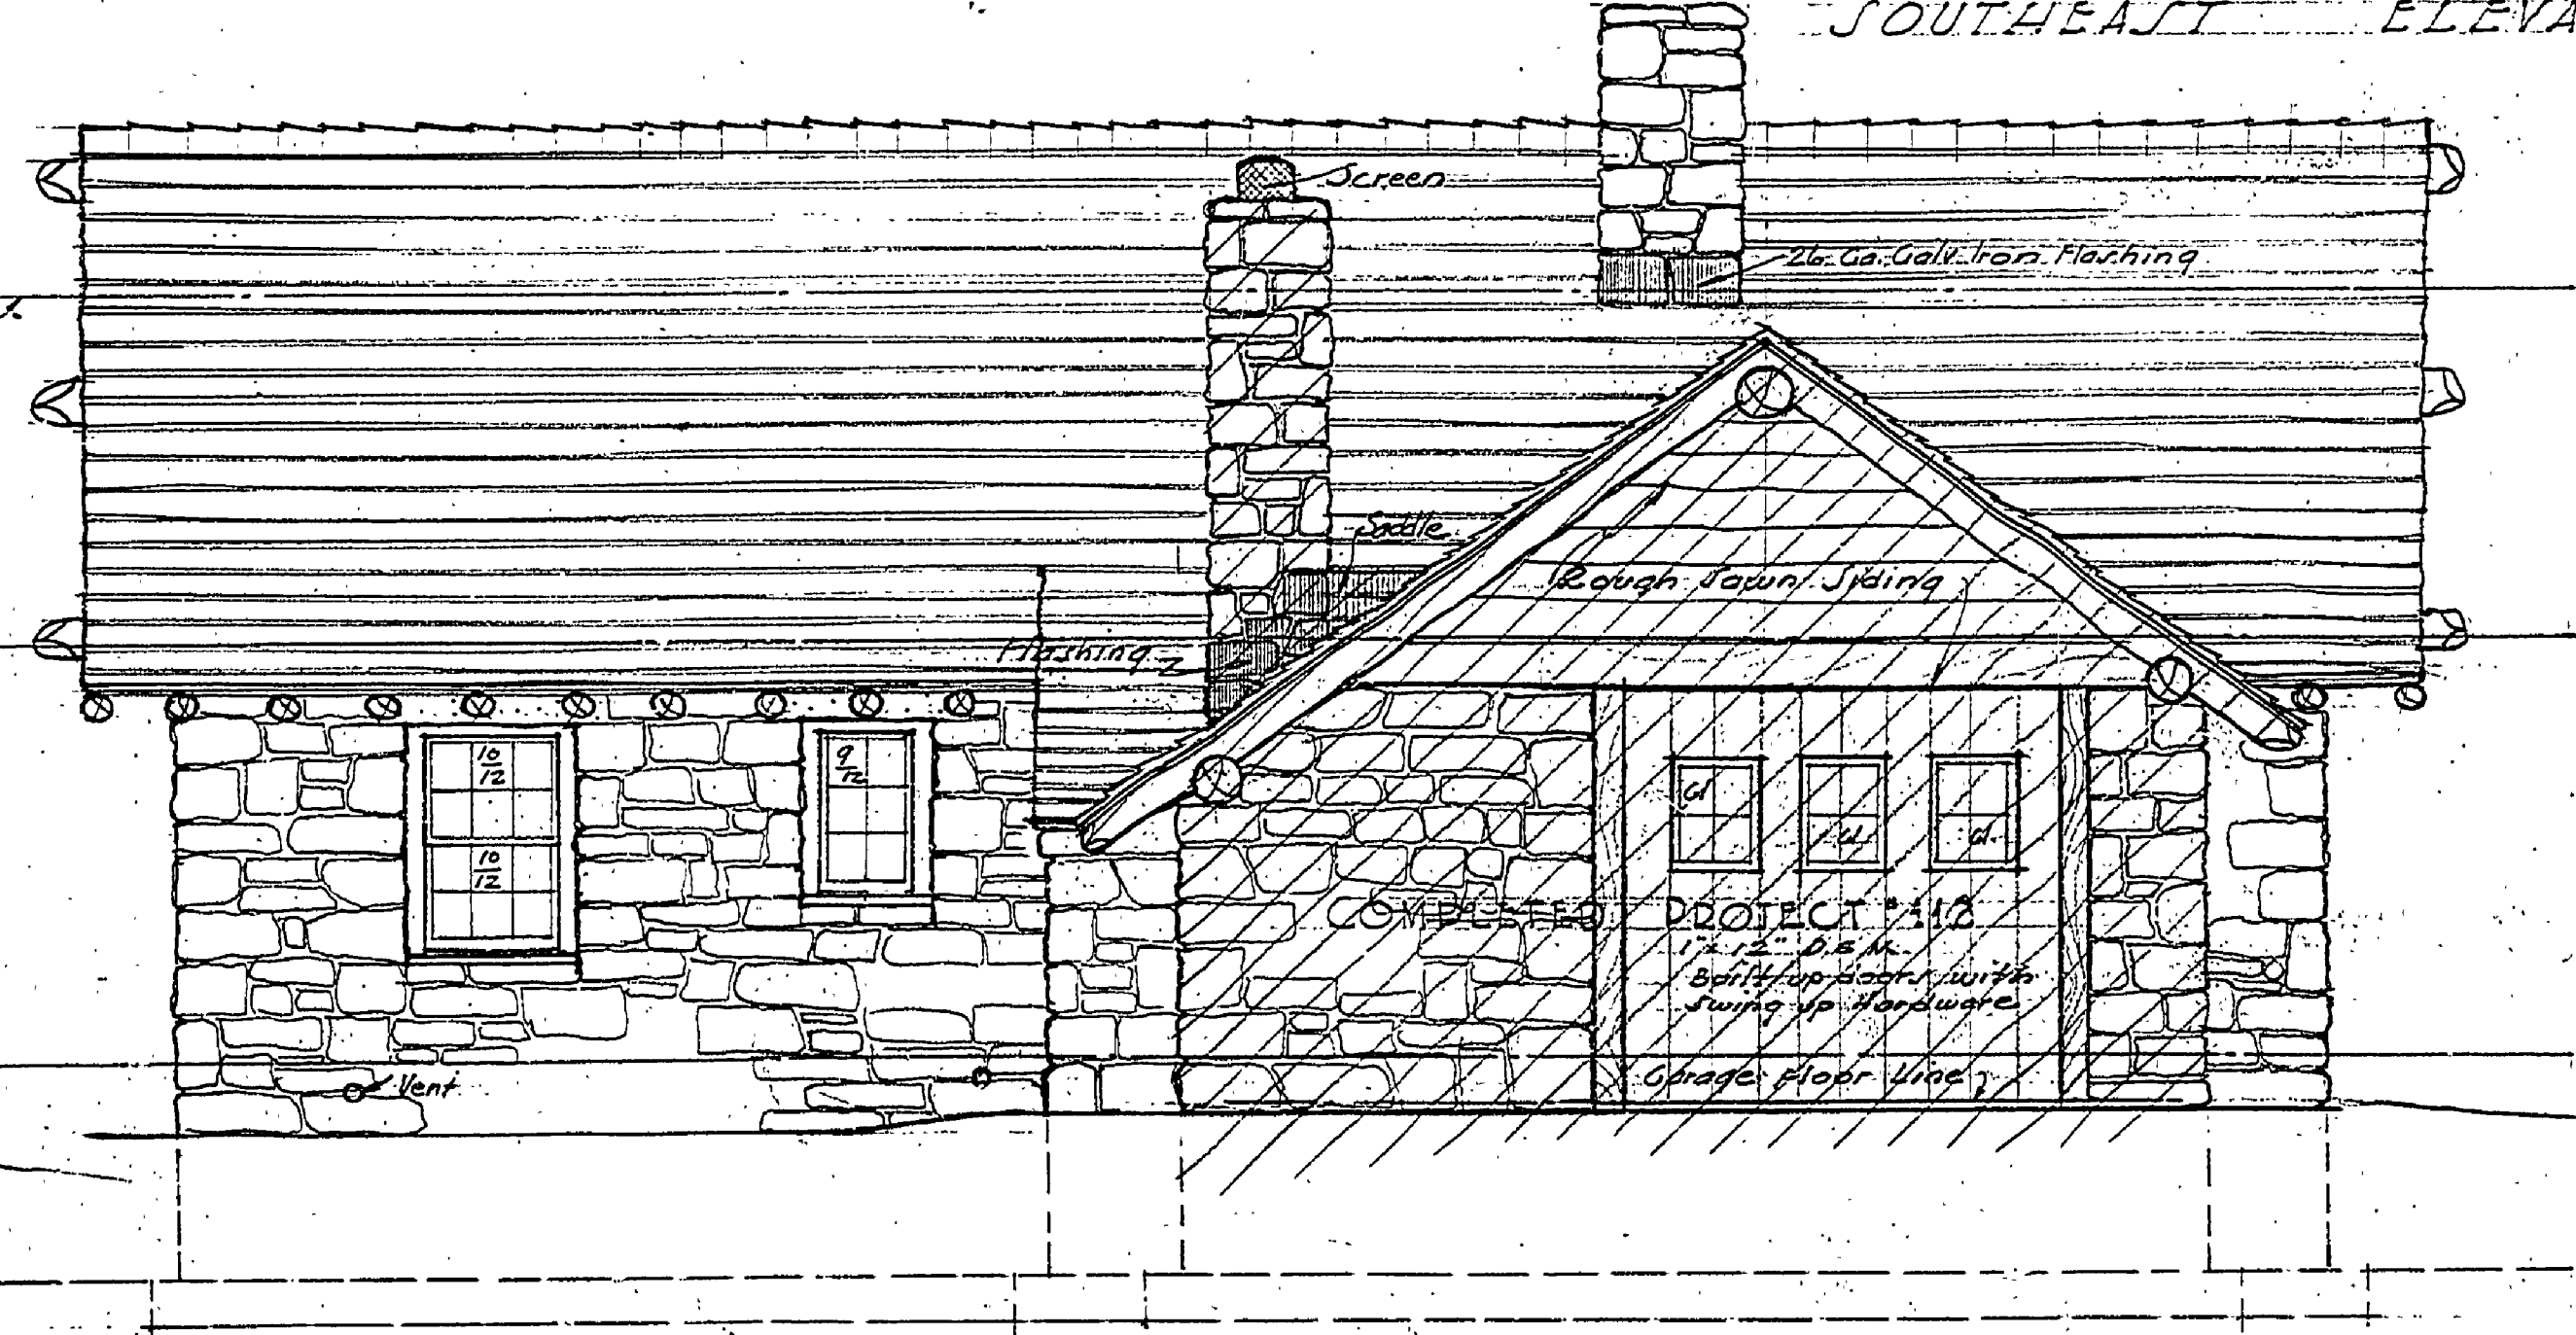

SOUTHWEST ELEVATION

A-96

SYMBOL	SHEET NO. 3 OF 5
NUMBER 9065-3-3	FILE NO. 9065-3-3
DRAWN BY G.E.P.	

INSURANCE No. 1

PLANS REVISED 2/27/37 G.E.P.