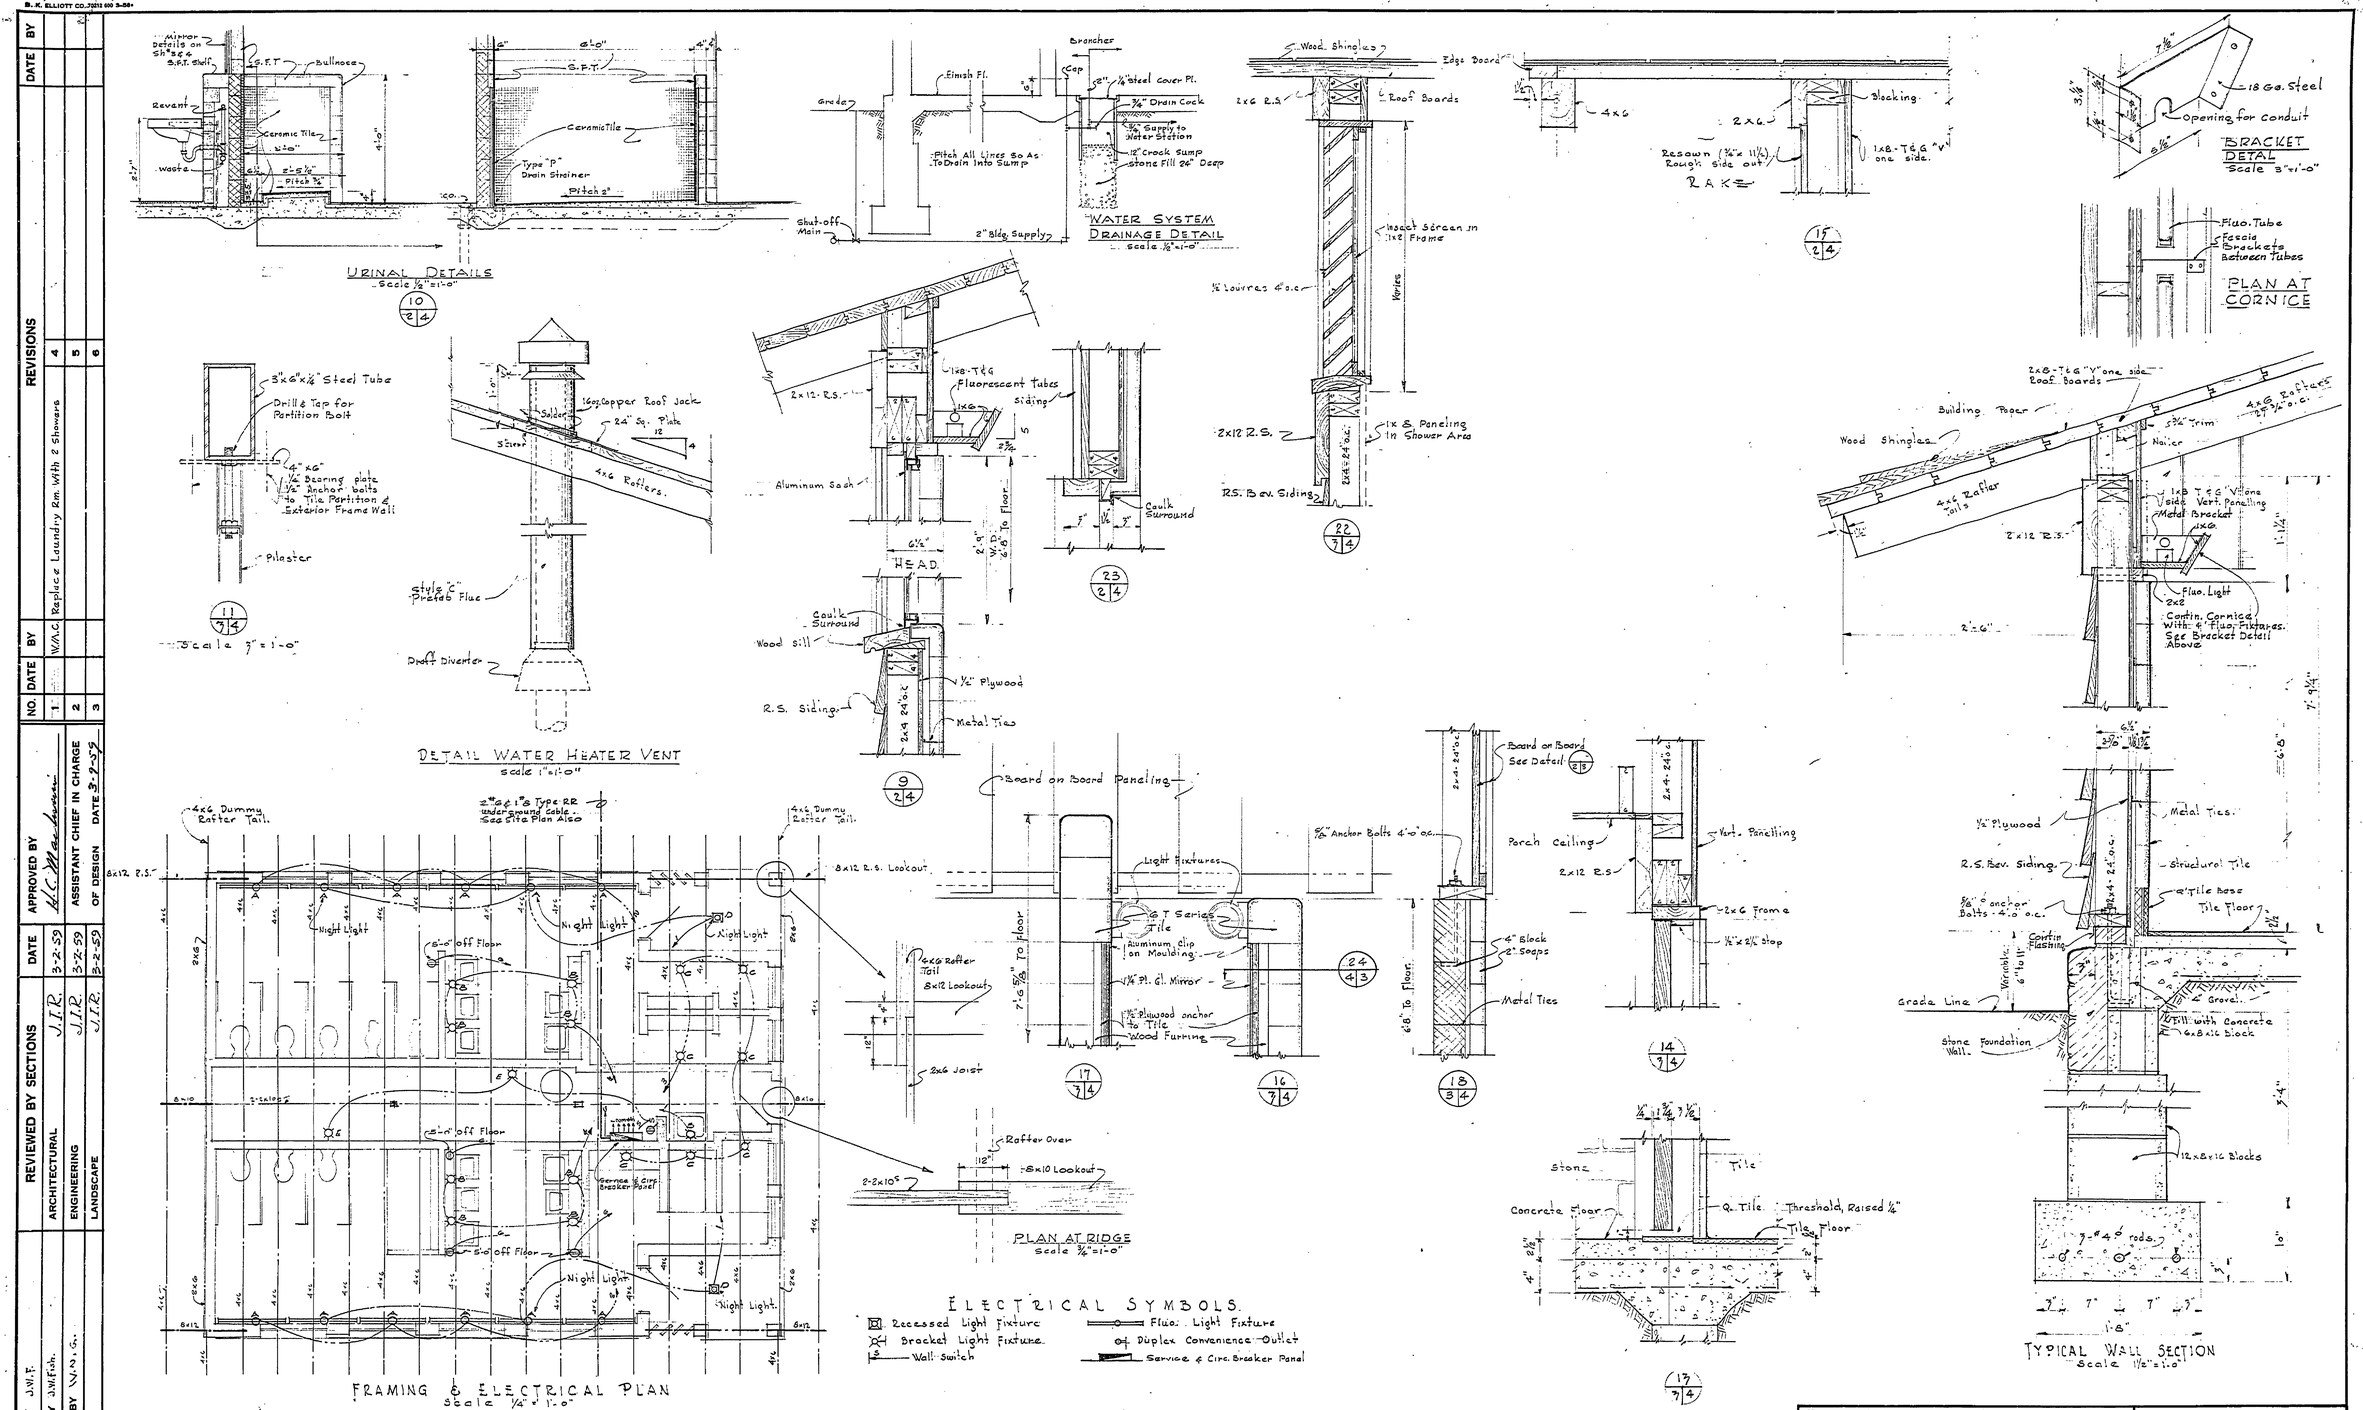

NO.	DATE	BY	REVISIONS
1		W.A.C.	Replace Laundry Rm. With 2 Showers
2			
3			
4			
5			
6			

		DATE
APPROVED BY	H.C. Mackenzie	
ASSISTANT CHIEF IN CHARGE OF DESIGN		DATE 3-2-59

REVIEWED BY SECTIONS		DATE
ARCHITECTURAL	J.I.R.	3-2-59
ENGINEERING	J.I.R.	3-2-59
LANDSCAPE	J.I.R.	3-2-59

DRAWN BY	J.W.F.
TRACED BY	J.W.Fish.
CHECKED BY	W.A.S.
DATE	

MICHIGAN
DEPARTMENT OF CONSERVATION
PARKS AND RECREATION DIVISION

FRAMING & ELECTRICAL PLANS & DETAILS

J. W. WELLS STATE PARK
NEW TOILET BUILDING

SHEET NO. 4 OF 5

PLAN NO. A-107