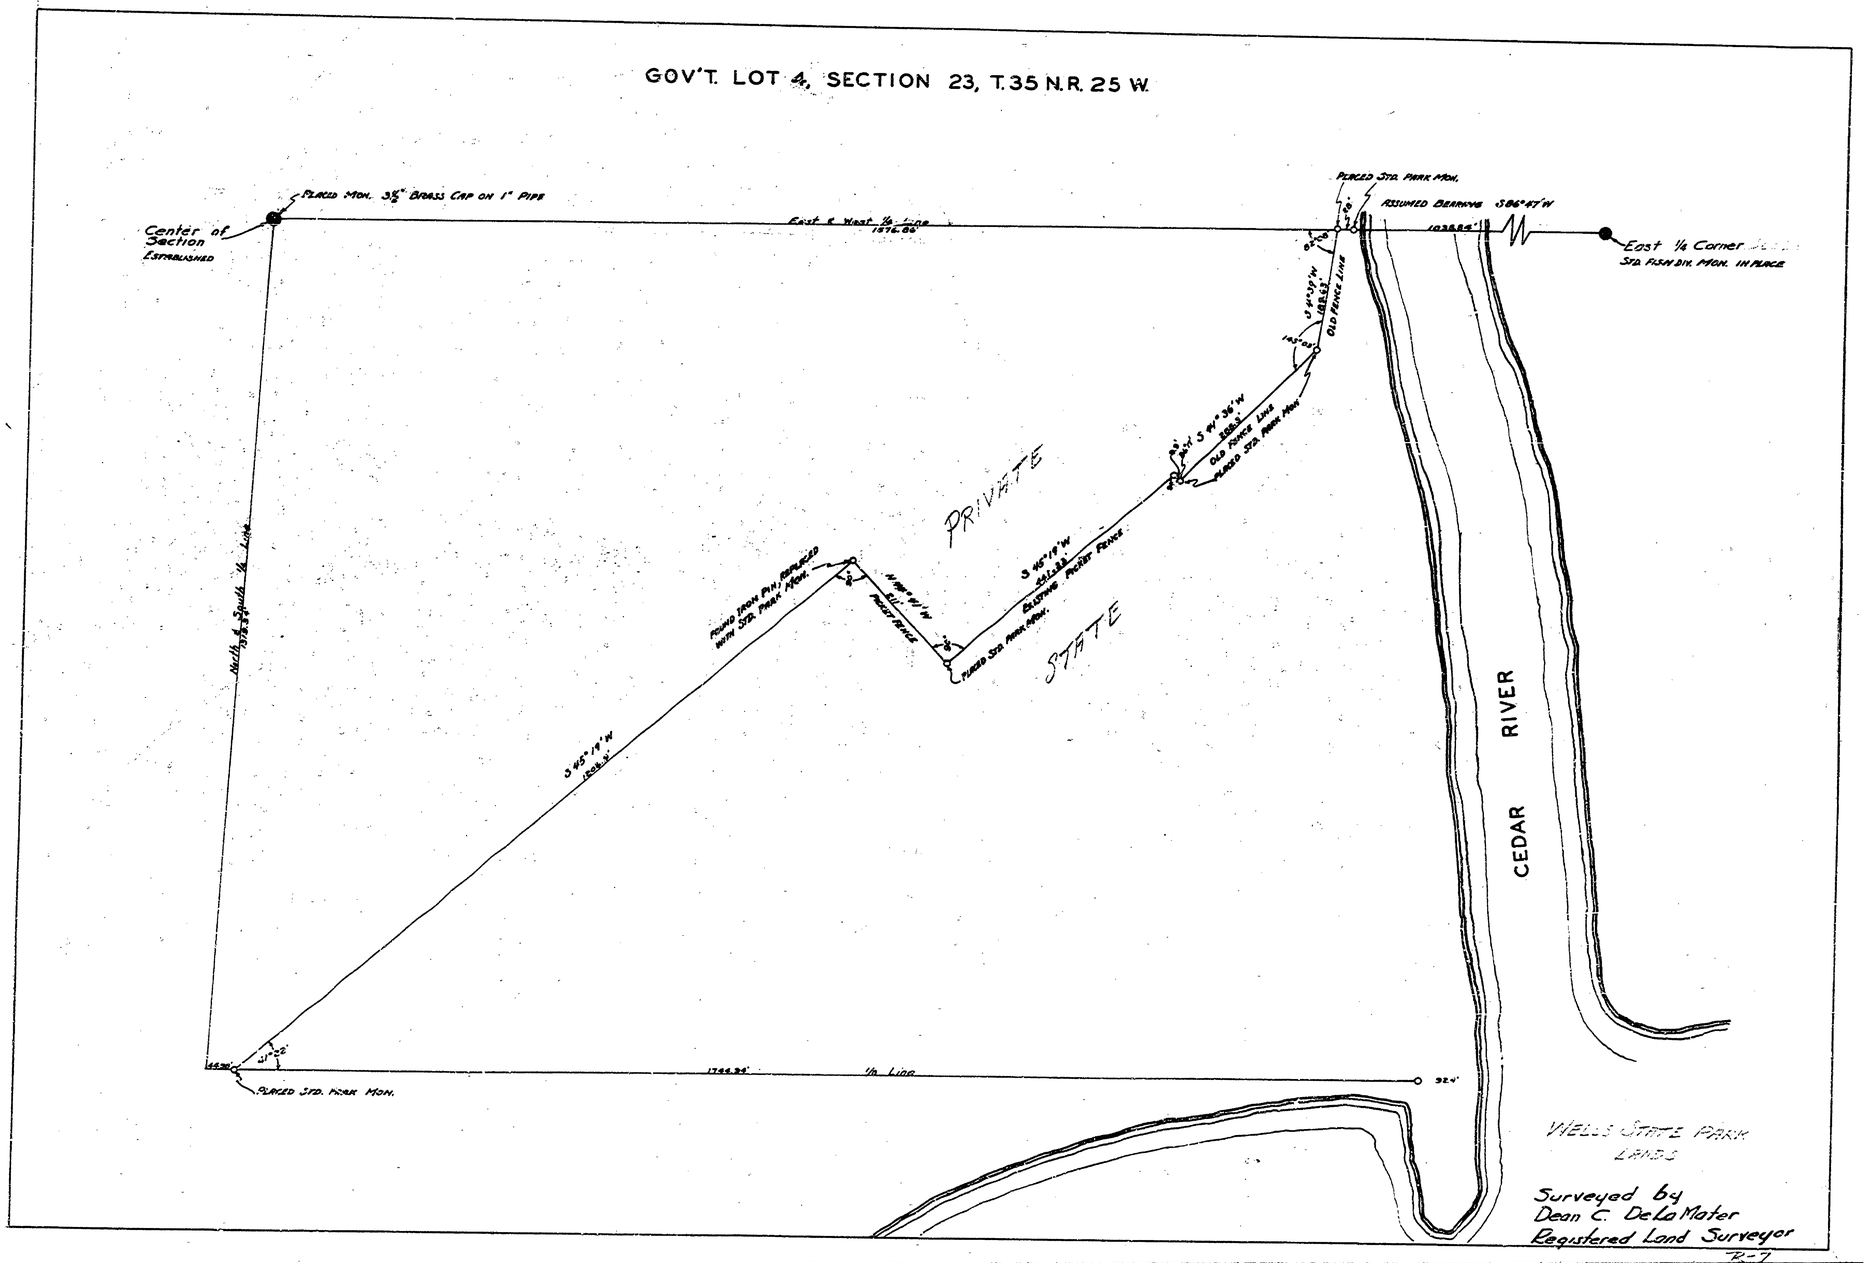GOV'T. LOT 4, SECTION 23, T.35 N.R. 25 W.