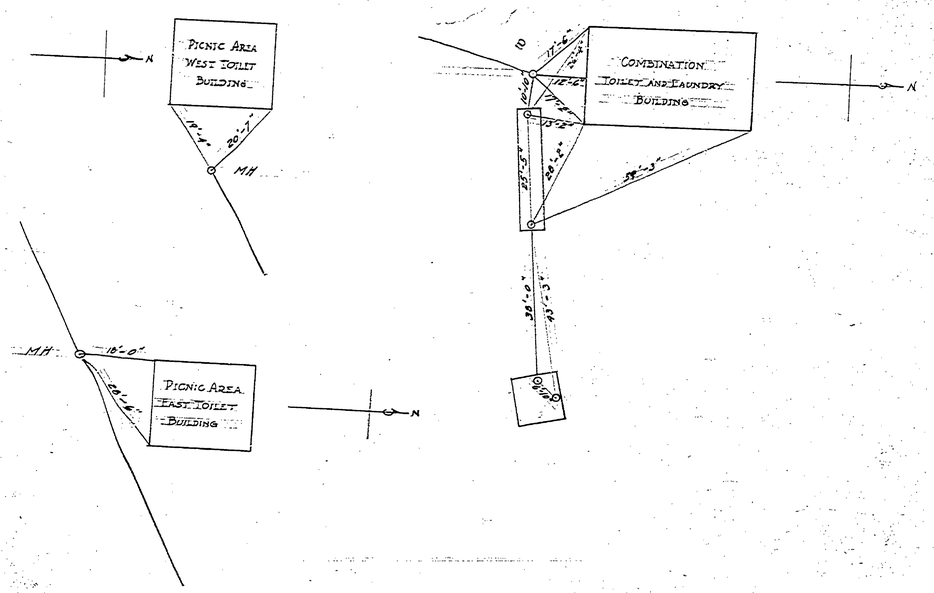

HARRISVILLE STATE PARK
RECORD OF UNDERGROUND STRUCTURES
DEC. 1941

E-96
P4 R W E