




NO.	DATE	BY	REVISIONS
1	1/25/51	E.J.P.	Relocation of Tile Field & Pump Installation
2			
3			
4			
5			
6			

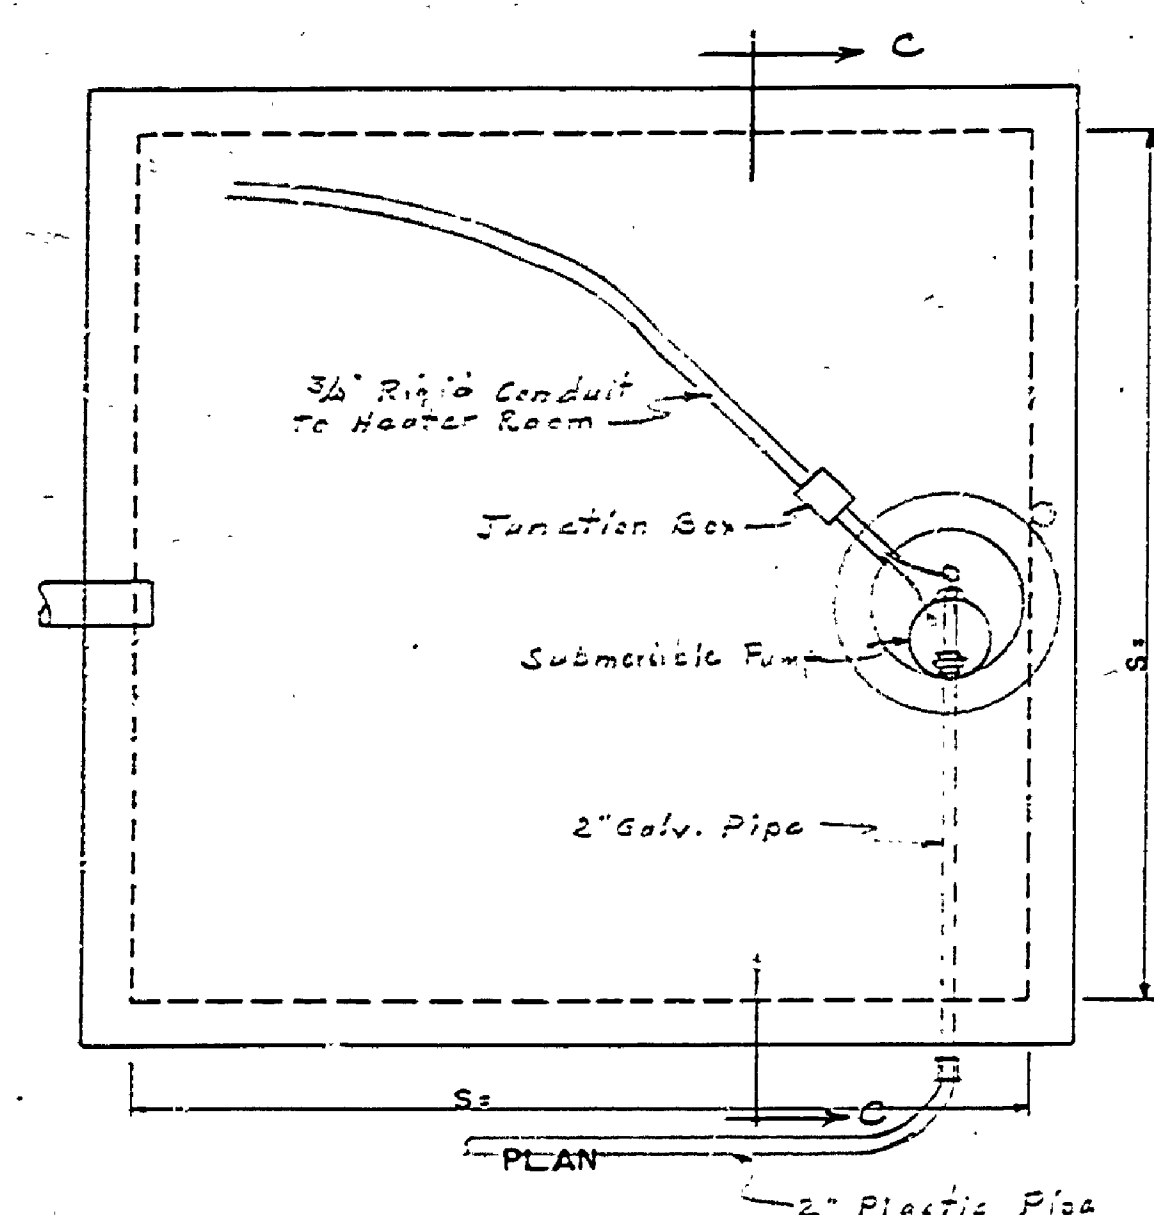


NOTES FOR DOSING CHAMBER
 SEE PLAN NO. SE-119 FOR STEEL REINFORCING DETAILS AND DETAIL DIMENSIONS OF DOSING CHAMBER BEAM.
 USE SIPHON WITH DRAWDOWN.
 USE S = , H = , K = , N =

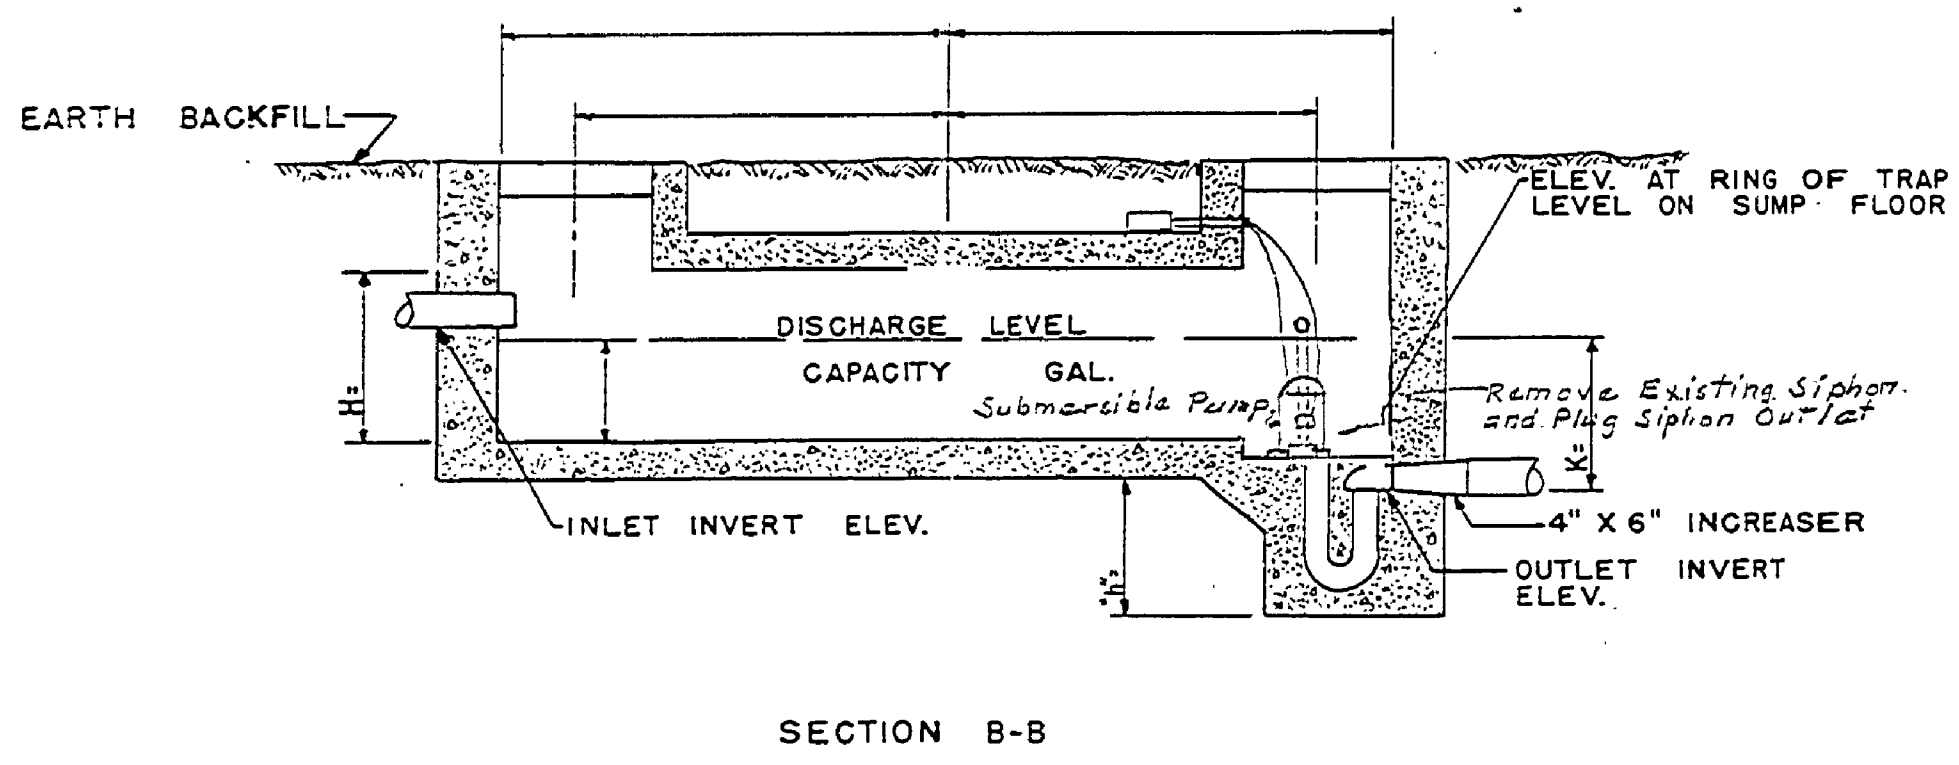


DOSING CHAMBER
 NOT TO SCALE

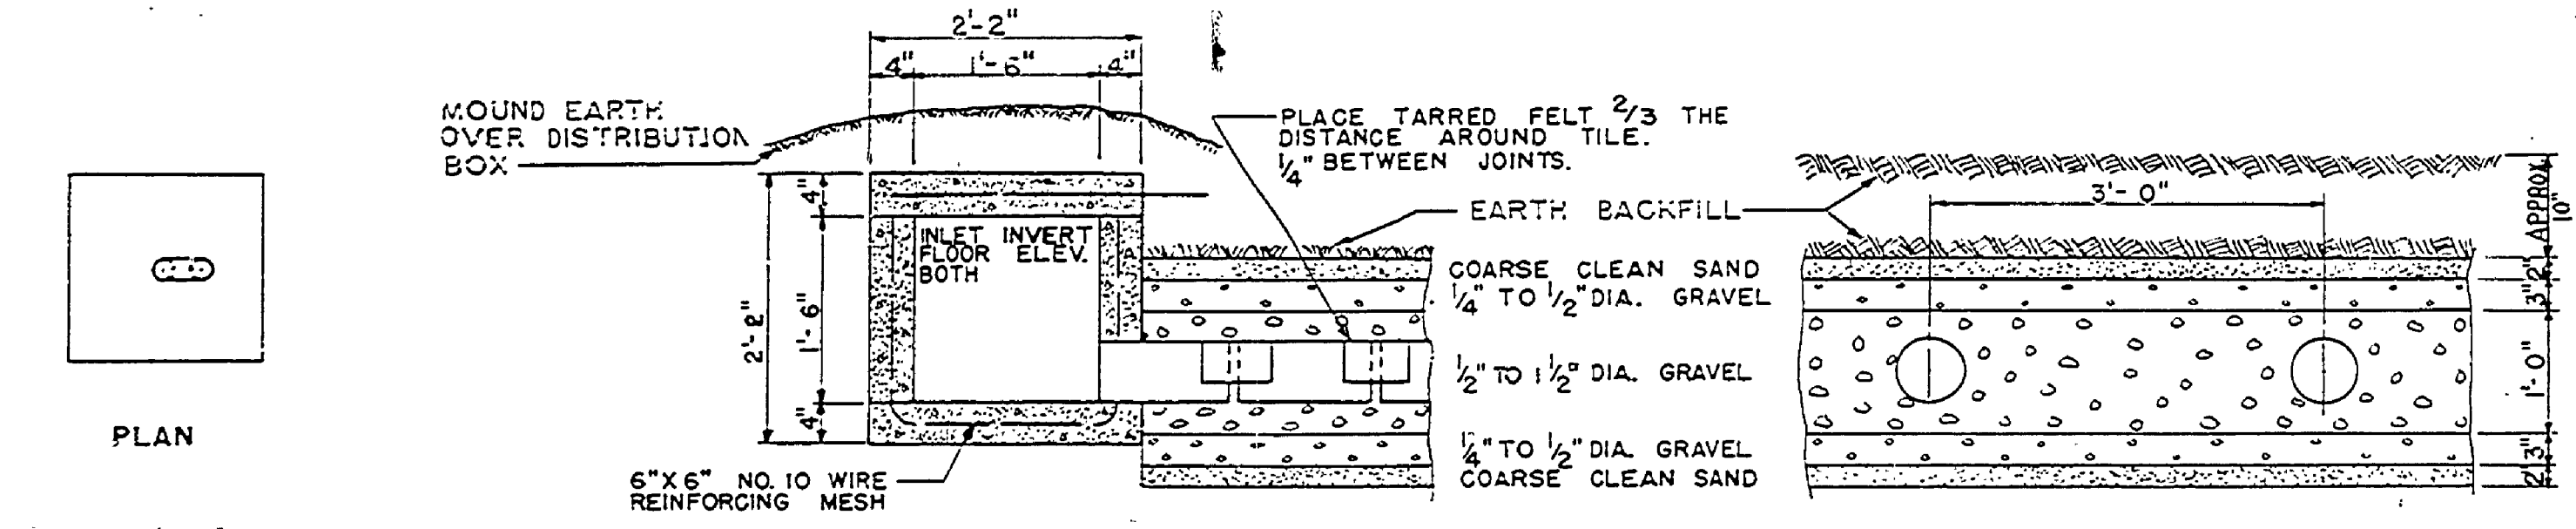


ELEVATION OF DISPOSAL FIELD
 NOT TO SCALE

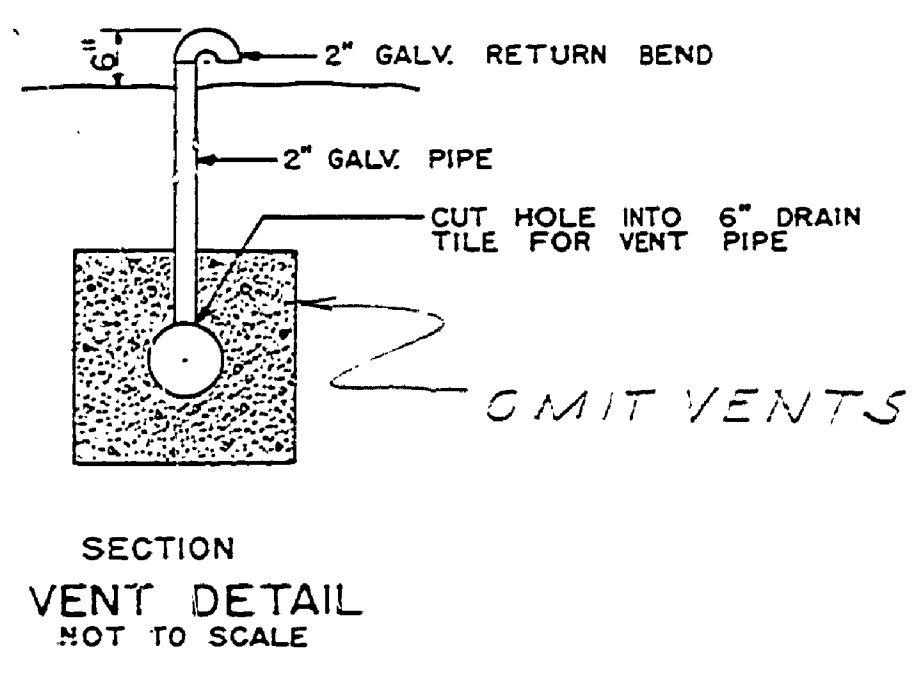


SECTION VENT DETAIL
 NOT TO SCALE

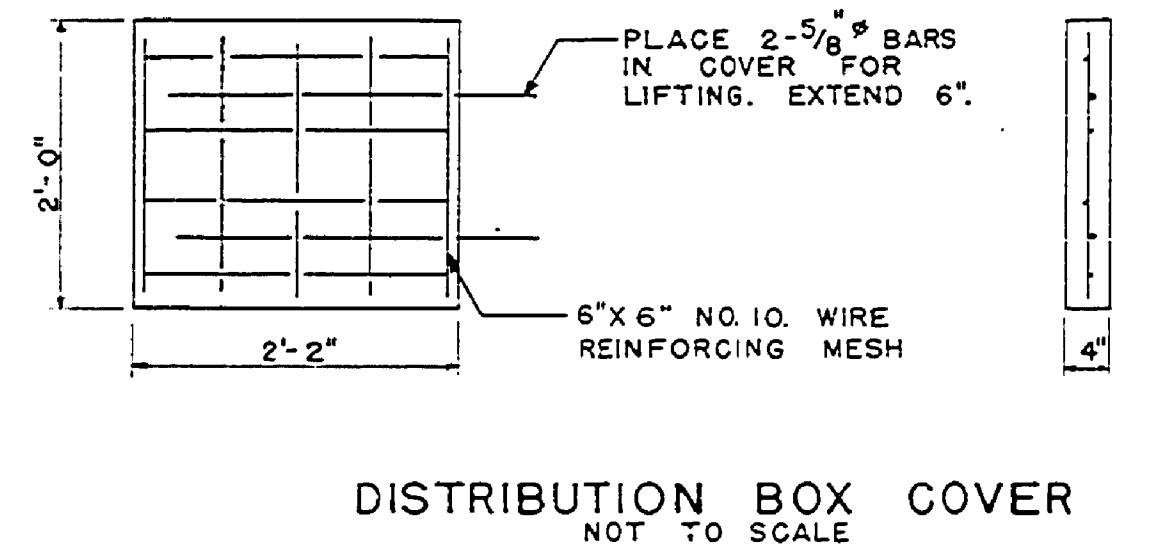


DISTRIBUTION BOX COVER
 NOT TO SCALE

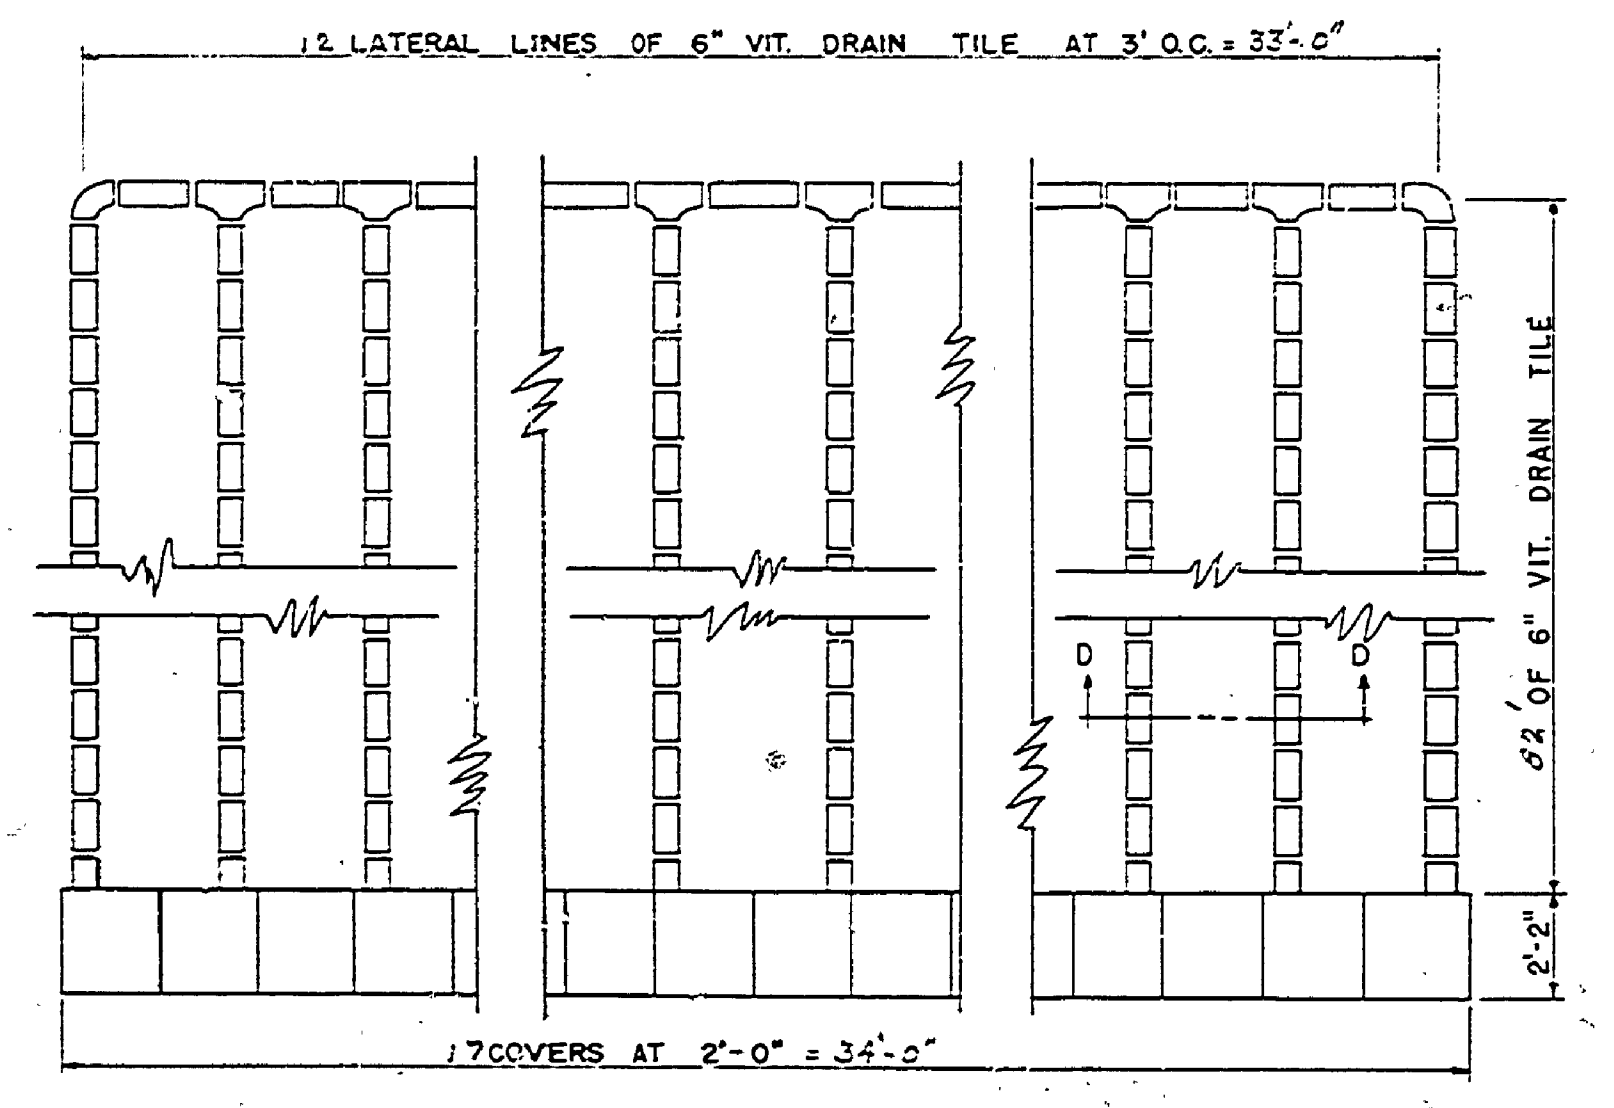


PLAN DISPOSAL FIELD
 NOT TO SCALE

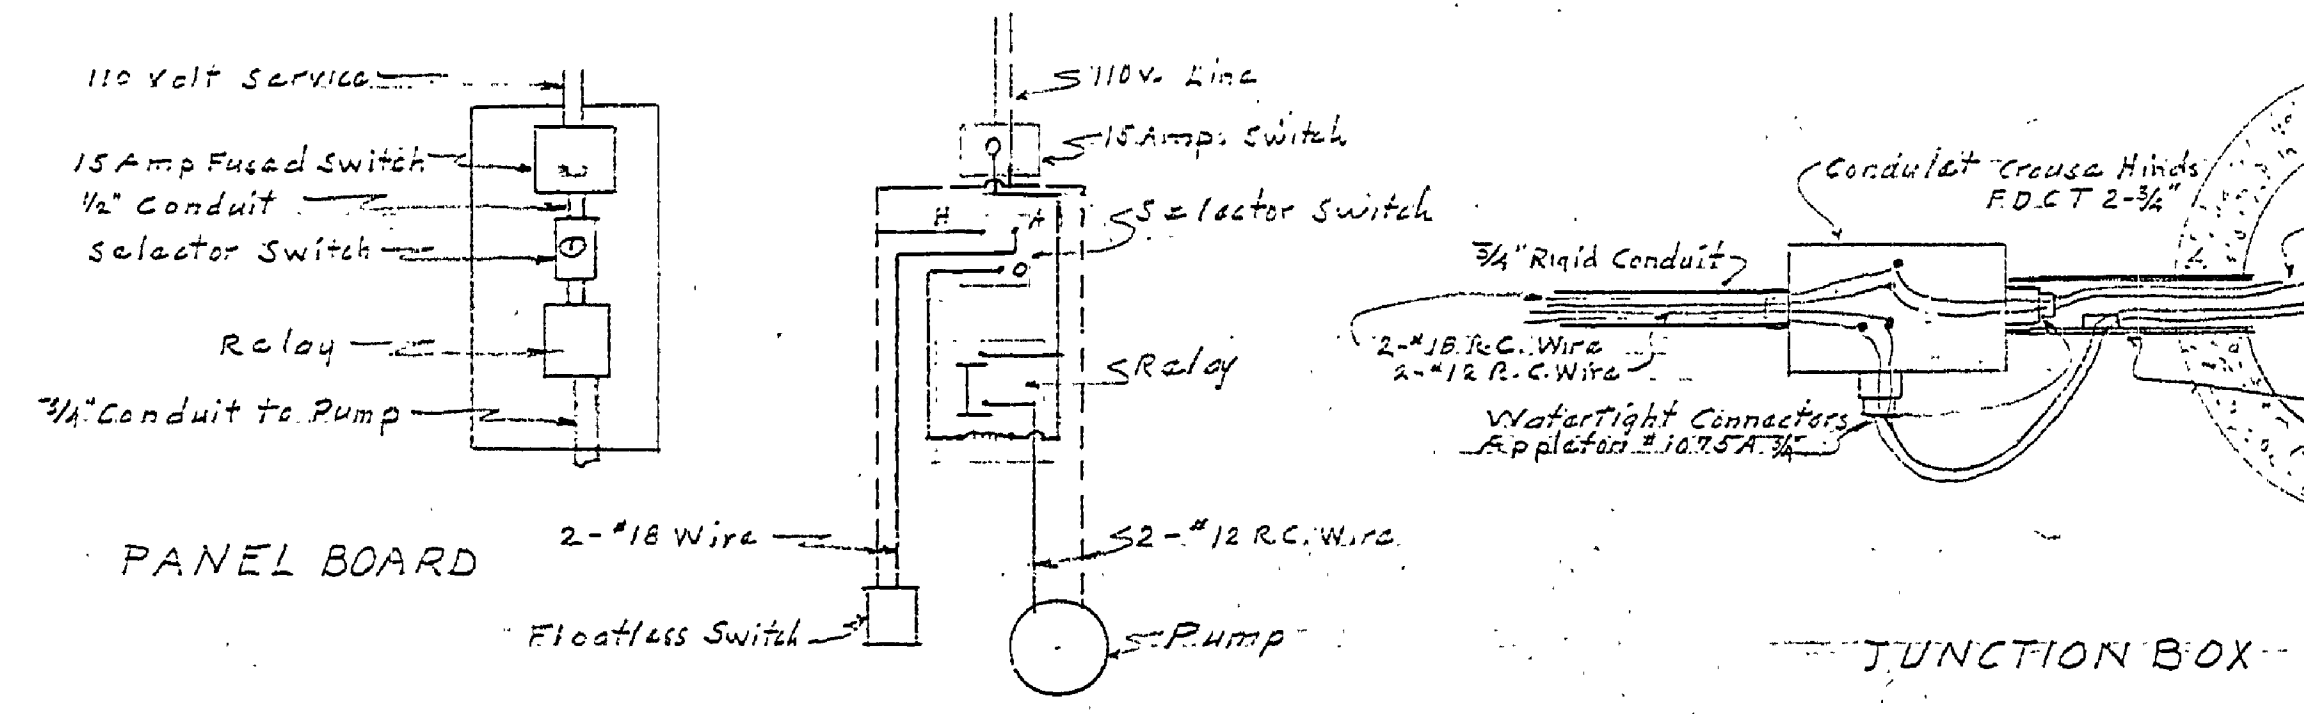

WIRING DIAGRAM
 ELECTRICAL DETAILS
 NOT TO SCALE

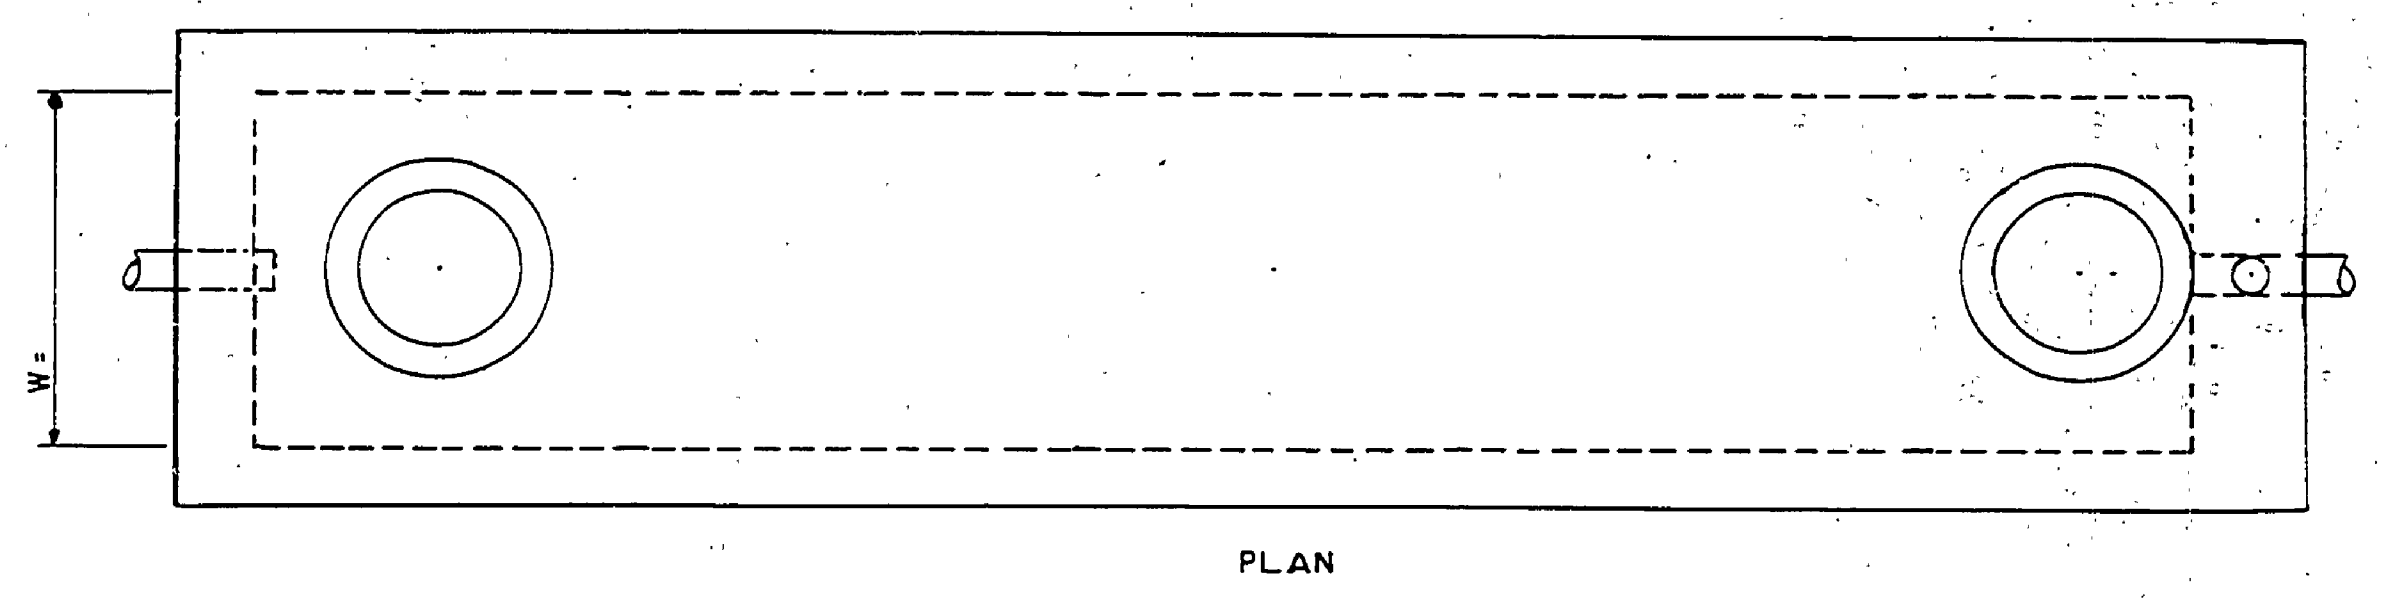


NOTES FOR SEPTIC TANK
 SEE PLAN NO. SE-121 FOR STEEL REINFORCING DETAILS AND DETAIL DIMENSIONS.
 USE L = , W = , H =

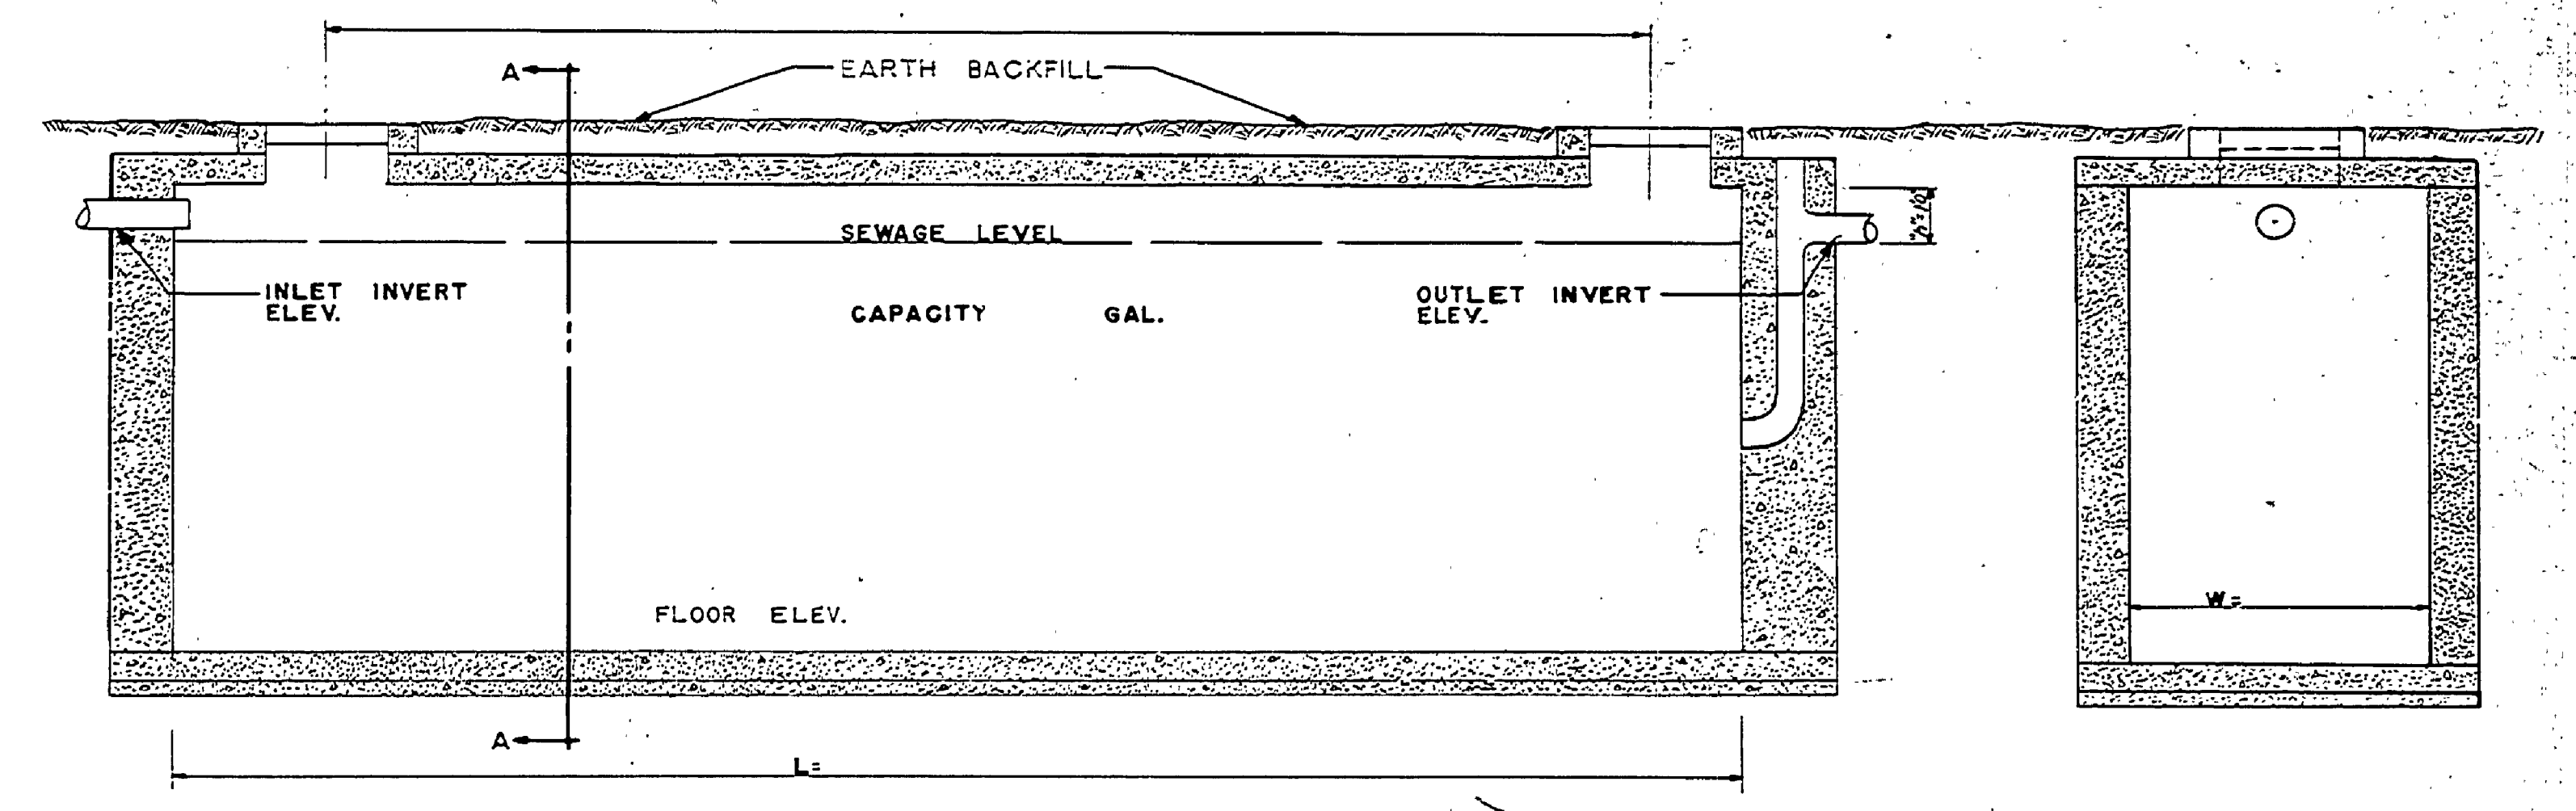


LONGITUDINAL SECTION
 SEPTIC TANK
 NOT TO SCALE

SECTION A-A


NOTE:
 Tile field to be laid with invert of tile 10" below existing ground surface. Strip of existing top soil to a depth of 1-8" level area before constructing tile field. Replace cut material over tile as shown in Elev. of Disposal Field. Tile lines to be laid level.

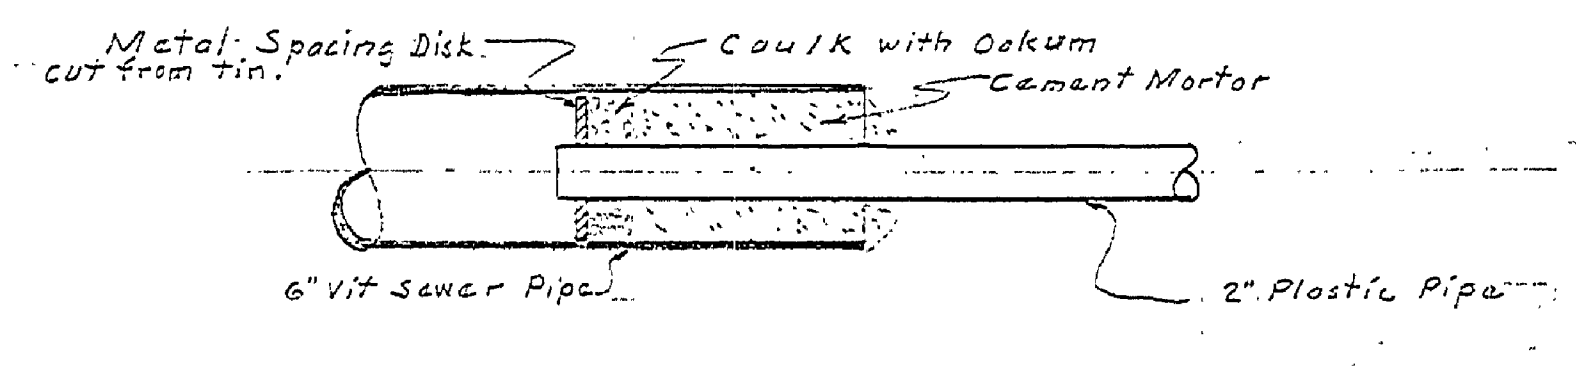

JOINT DETAIL
 SCALE 1/2" = 1'-0"

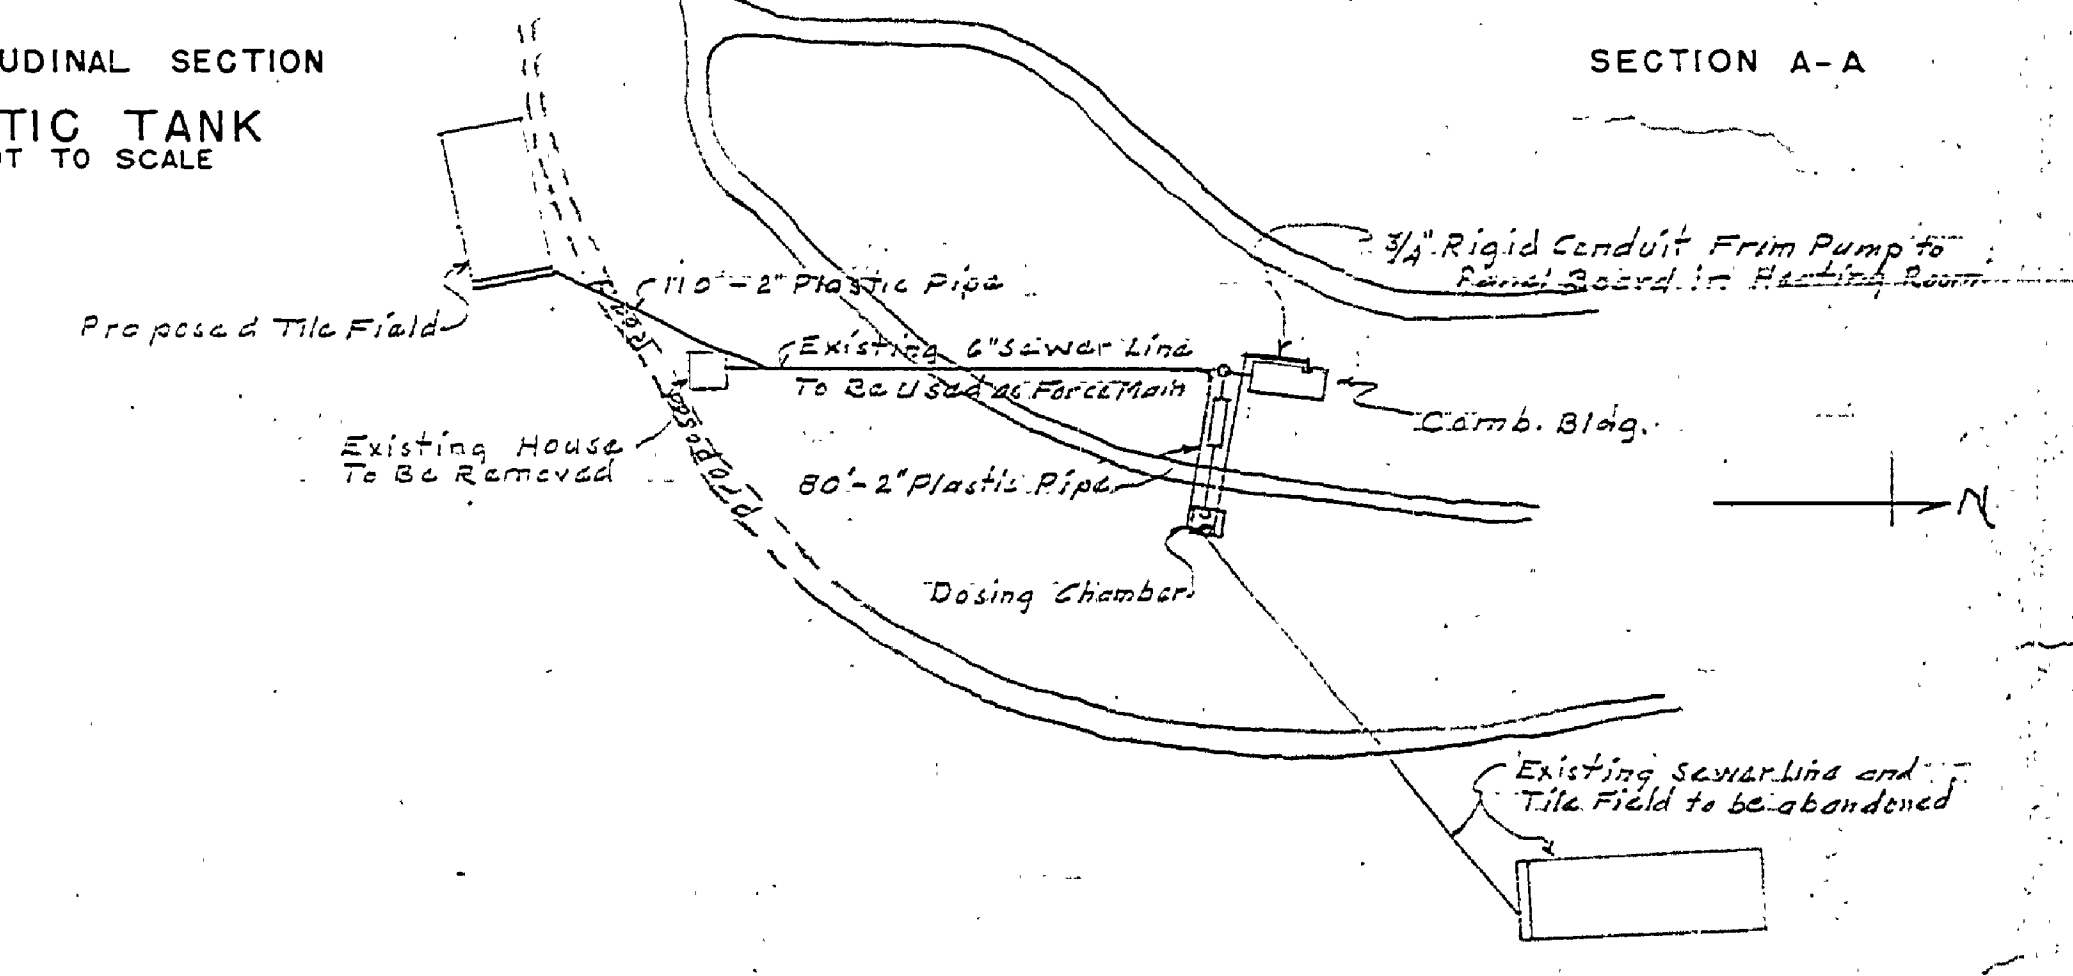

PLOT PLAN
 SCALE 1" = 100'

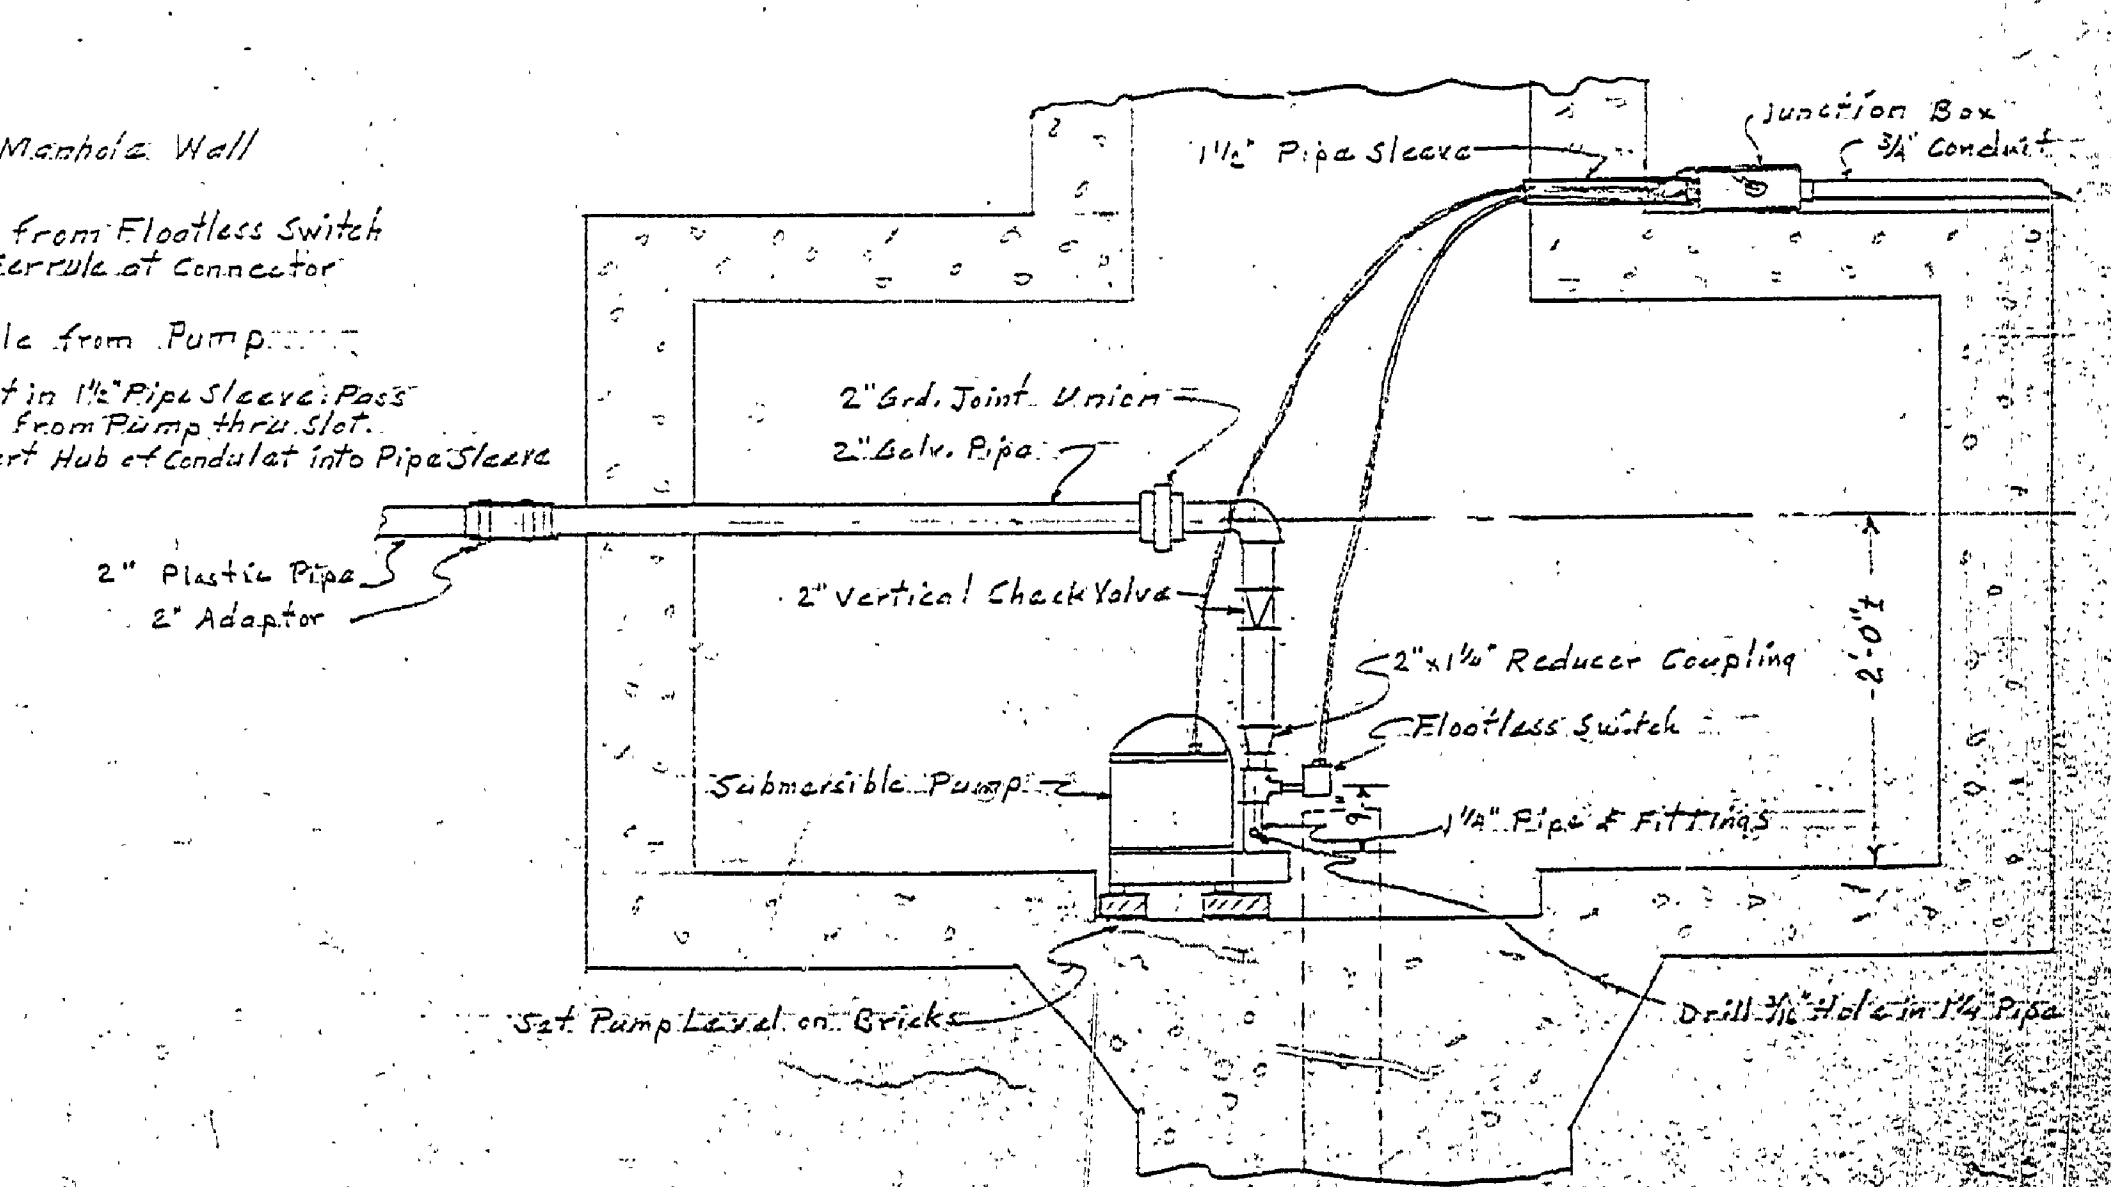

SECTION C-C DOSING CHAMBER
 SCALE 1/2" = 1'-0"

MICHIGAN
 DEPARTMENT OF CONSERVATION
 PARKS AND RECREATION DIVISION

HARRISVILLE STATE PARK
 COMB. BLDG. SEWAGE DISPOSAL SYSTEM
 SCALE AS SHOWN

SHEET NO. 1 OF 3
 PLAN NO. E-97