


NO.	DATE	BY	REVISIONS
1	10-27-53	EJP	Rebuild Tile Field and S.T. Disposal Chamber
2			
3			

DATE	BY


APPROVED BY	DATE
ASSISTANT CHIEF IN CHARGE OF DESIGN	

REVIEWED BY SECTIONS	DATE
ARCHITECTURAL	
ENGINEERING	
LANDSCAPE	


DRAWN BY	DATE
E. J. P.	
CHECKED BY	DATE

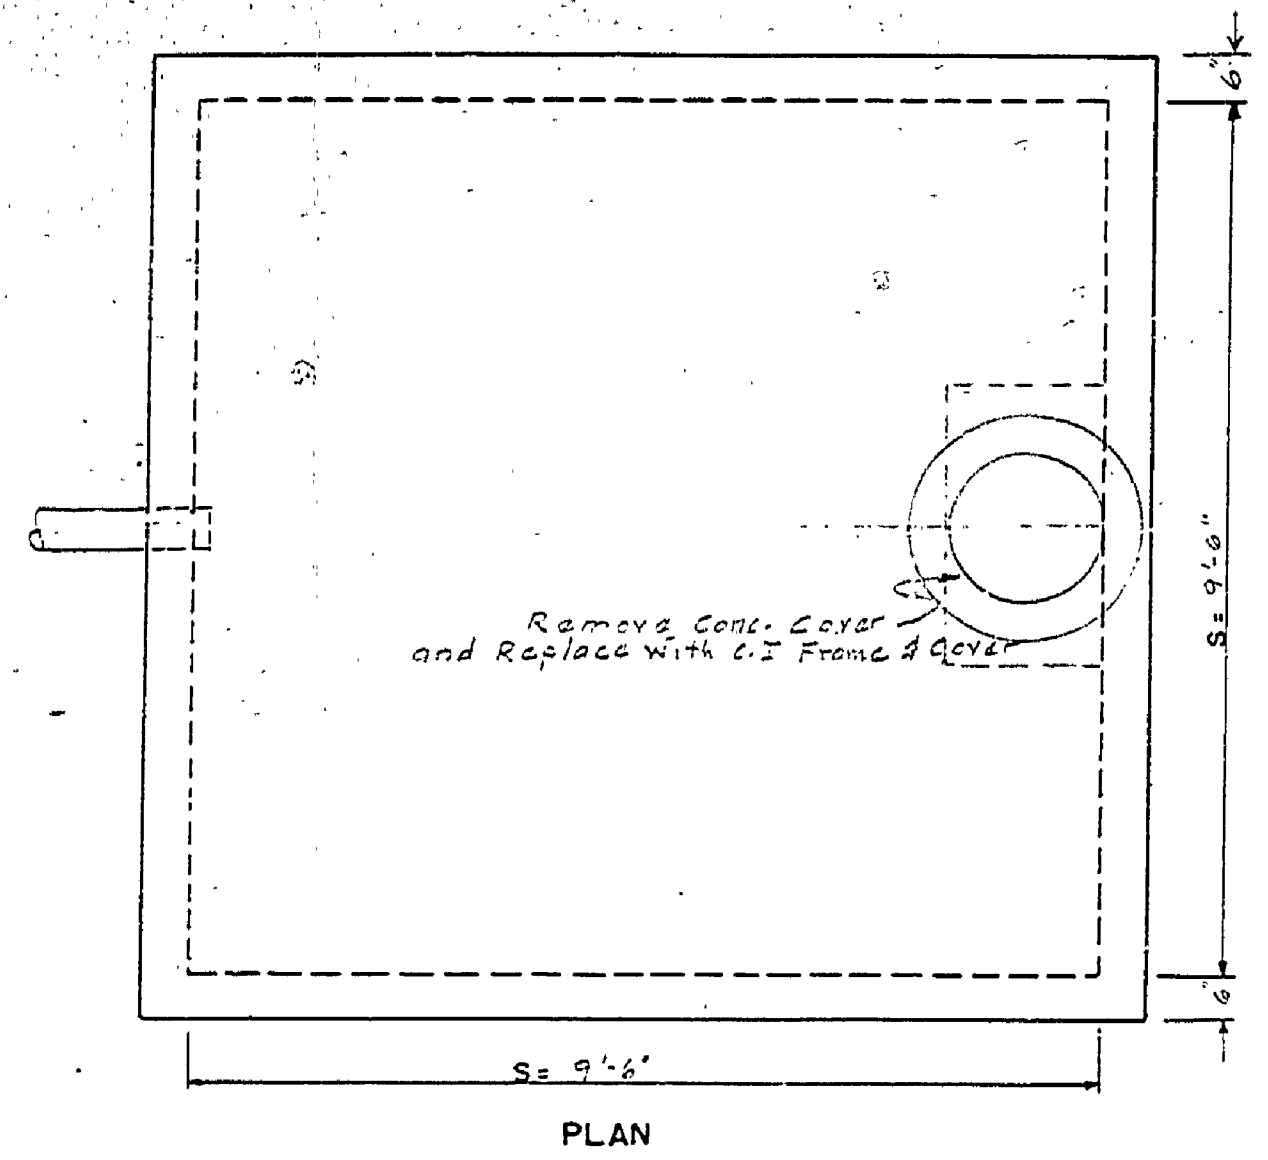


NOTES FOR DOSING CHAMBER
 SEE PLAN NO. SE-119 FOR STEEL REINFORCING DETAILS AND DETAIL DIMENSIONS OF DOSING CHAMBER BEAM.
 USE SIPHON WITH DRAWDOWN.
 USE S = H = K = N =

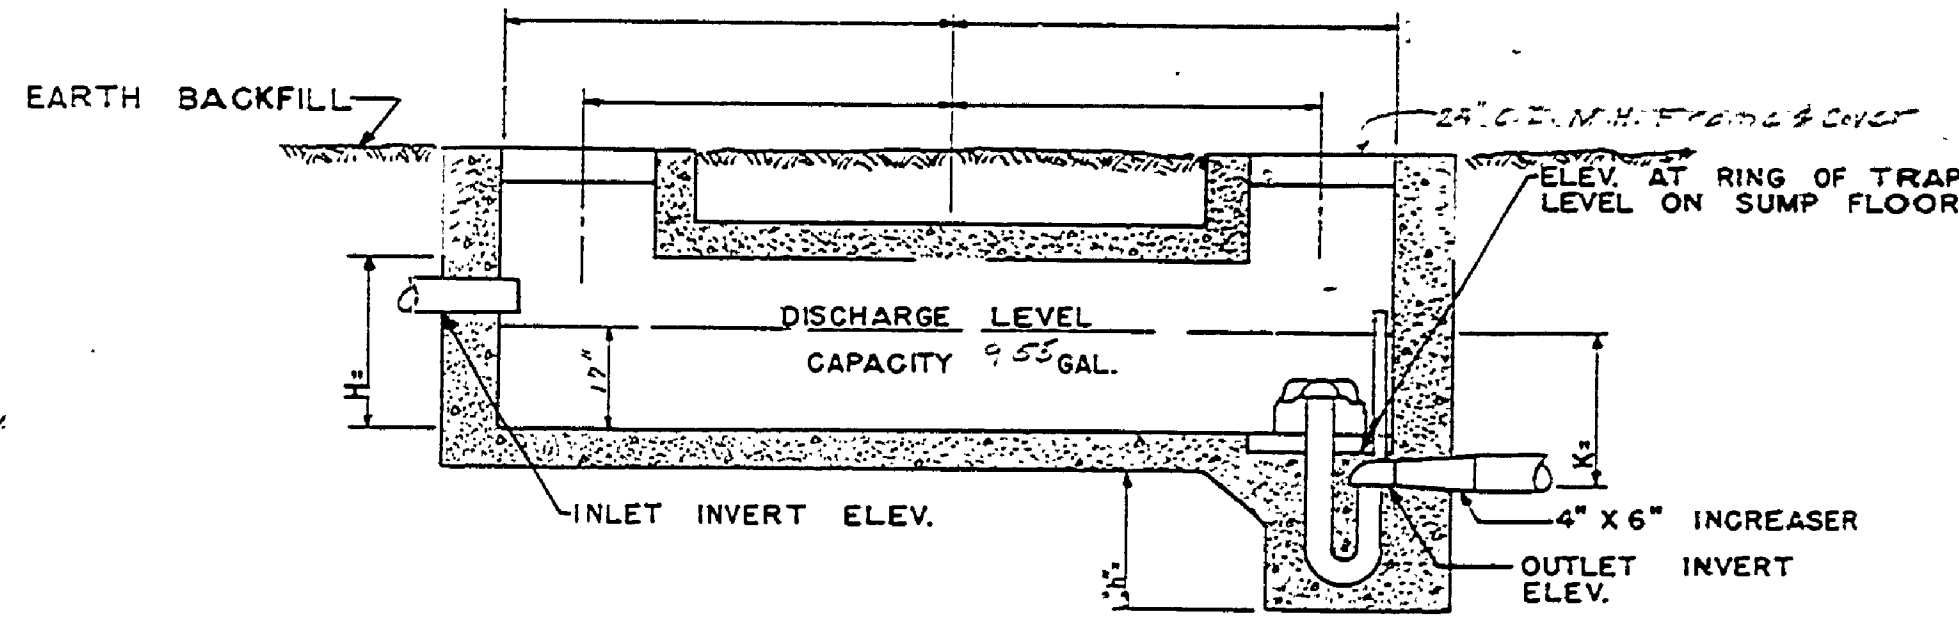


DOSING CHAMBER
 NOT TO SCALE

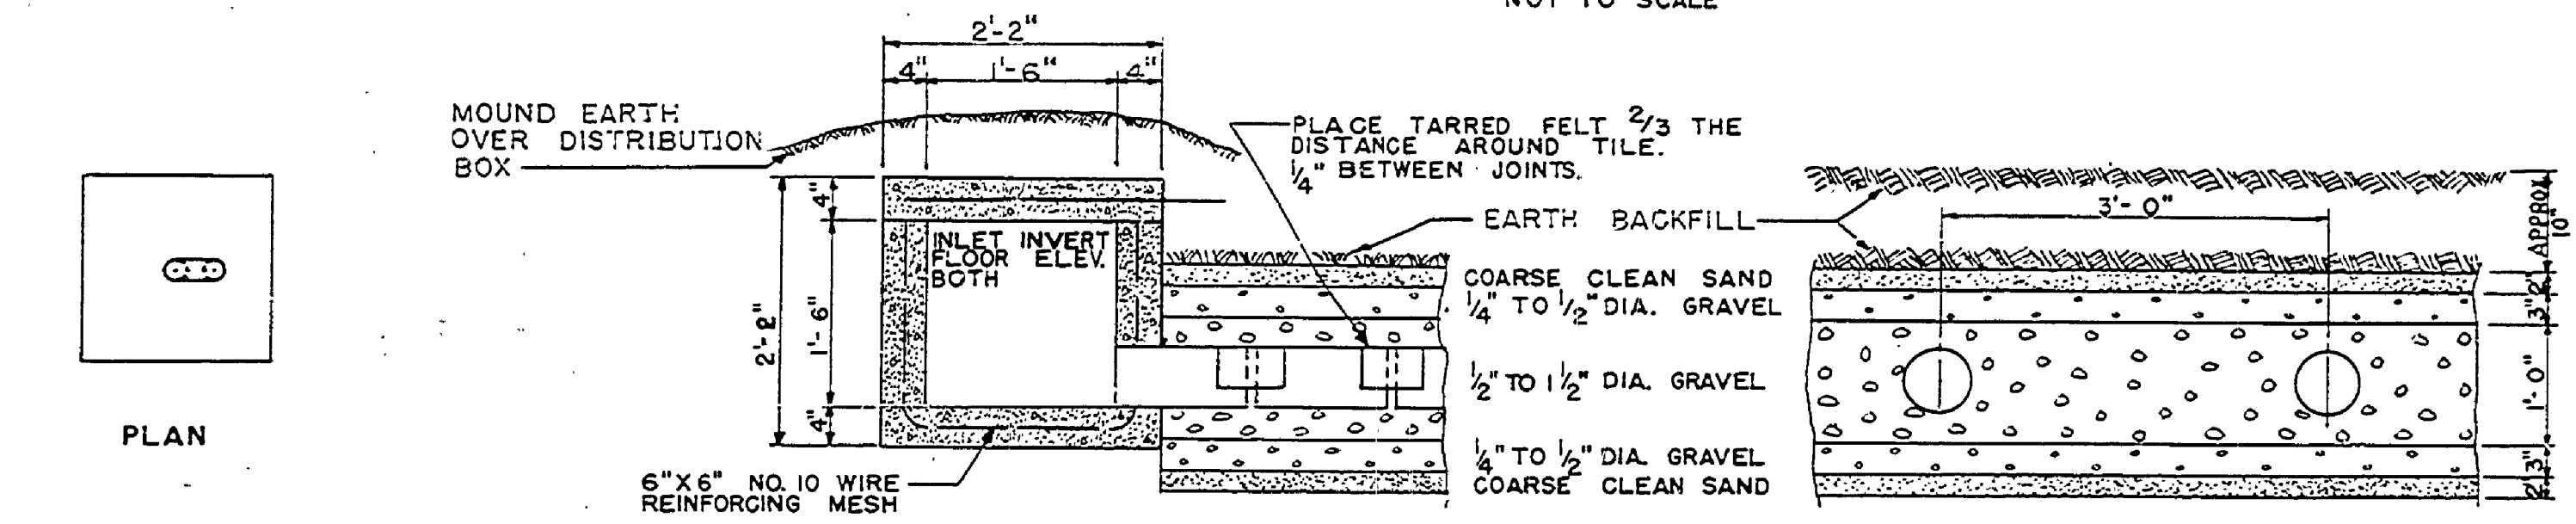


ELEVATION OF DISPOSAL FIELD
 NOT TO SCALE

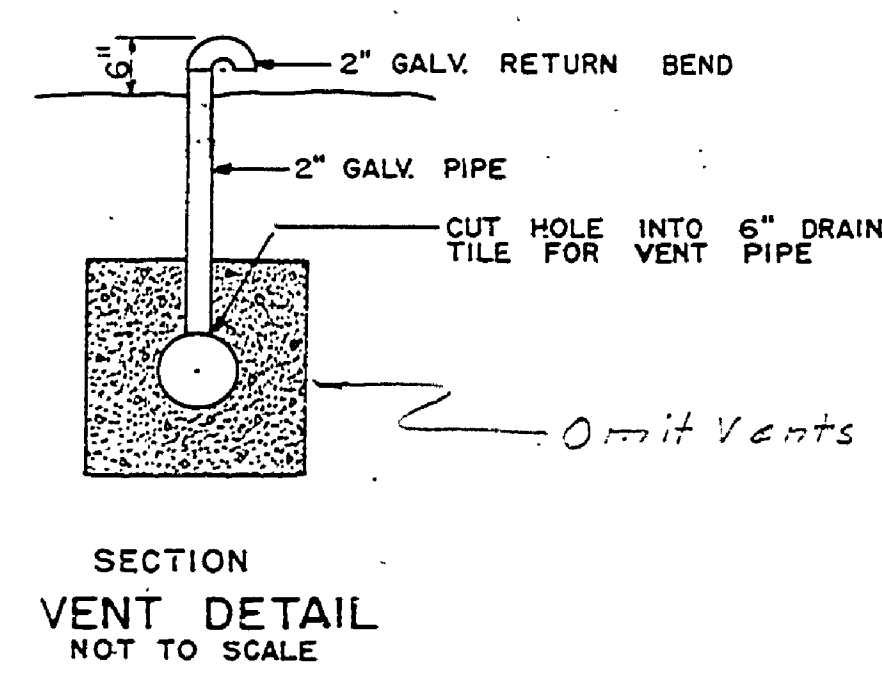


SECTION VENT DETAIL
 NOT TO SCALE

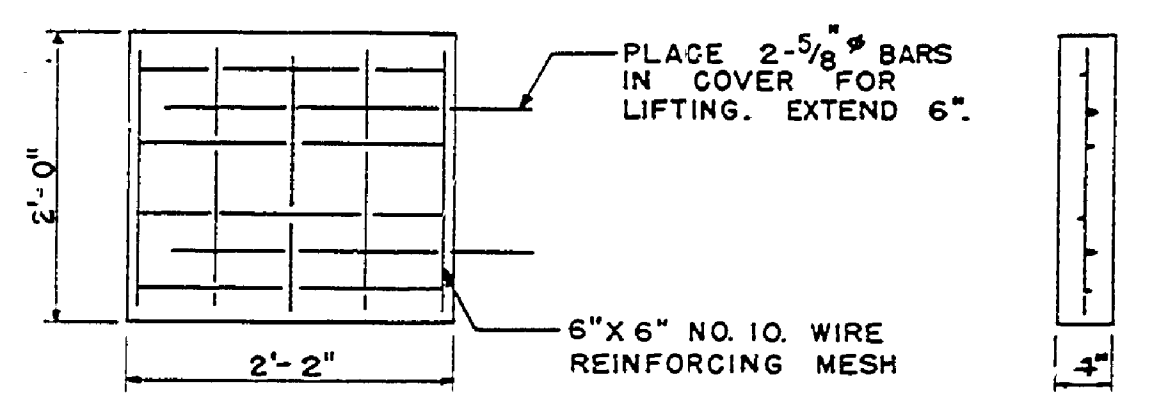


DISTRIBUTION BOX COVER
 NOT TO SCALE

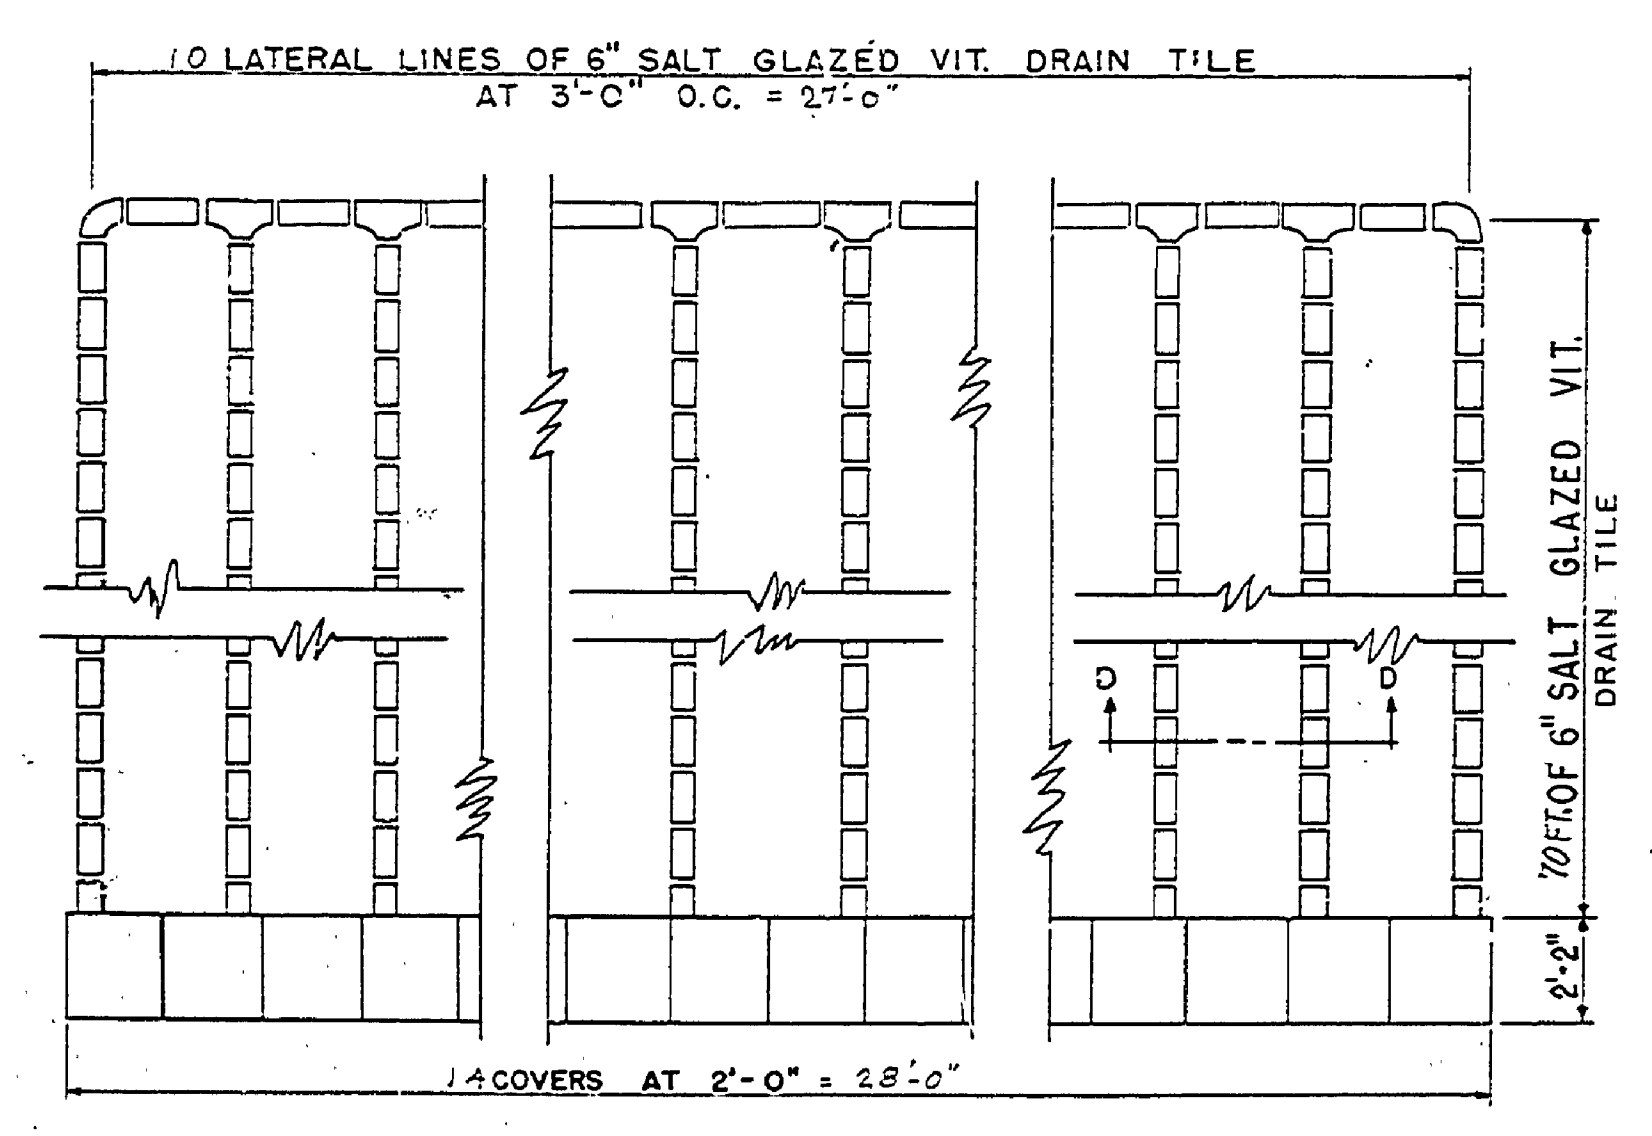


PLAN DISPOSAL FIELD
 NOT TO SCALE

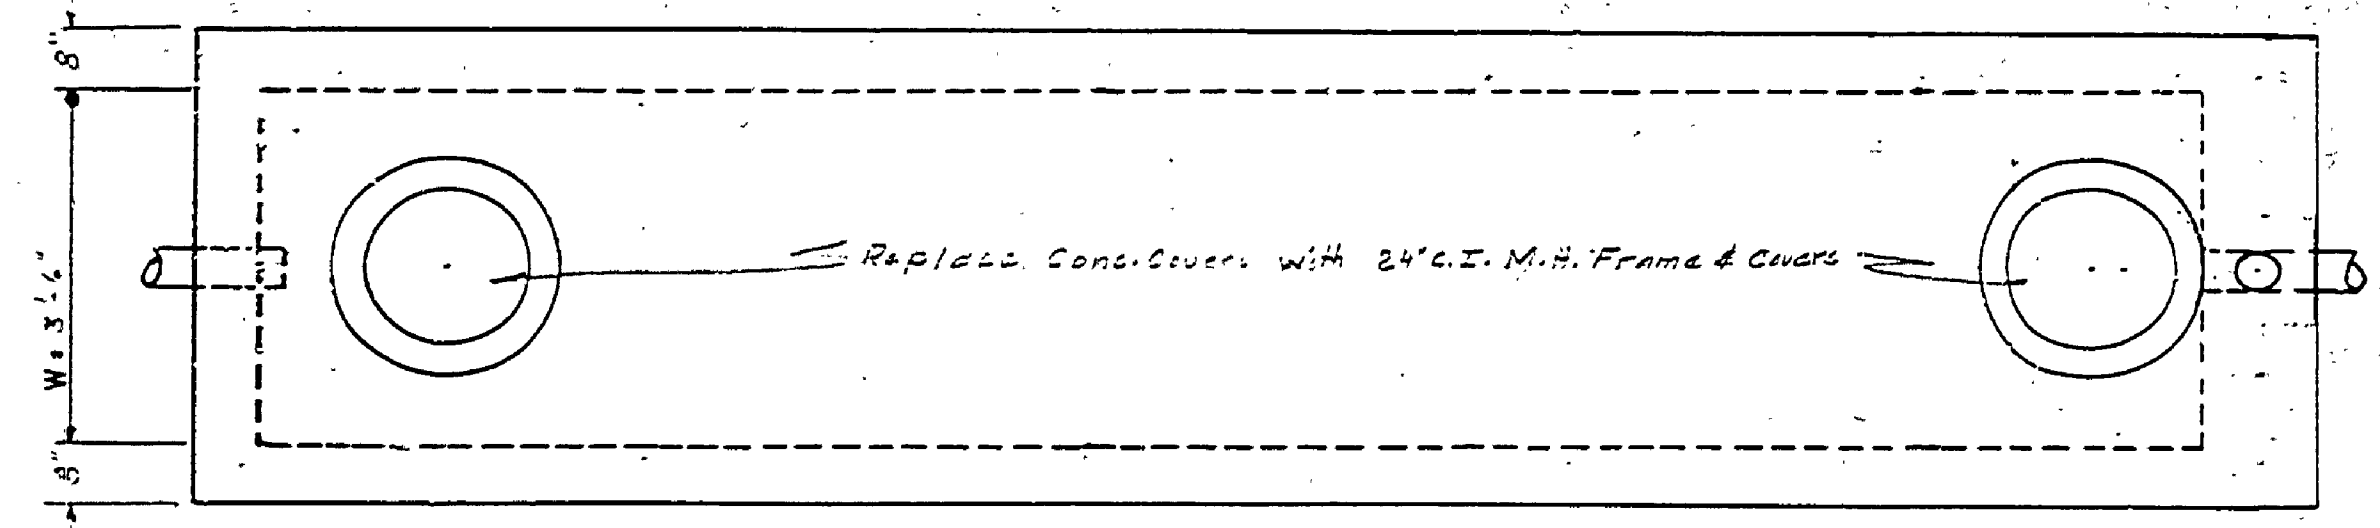


NOTES FOR SEPTIC TANK
 SEE PLAN NO. SE-121 FOR STEEL REINFORCING DETAILS AND DETAIL DIMENSIONS.
 USE L = W =

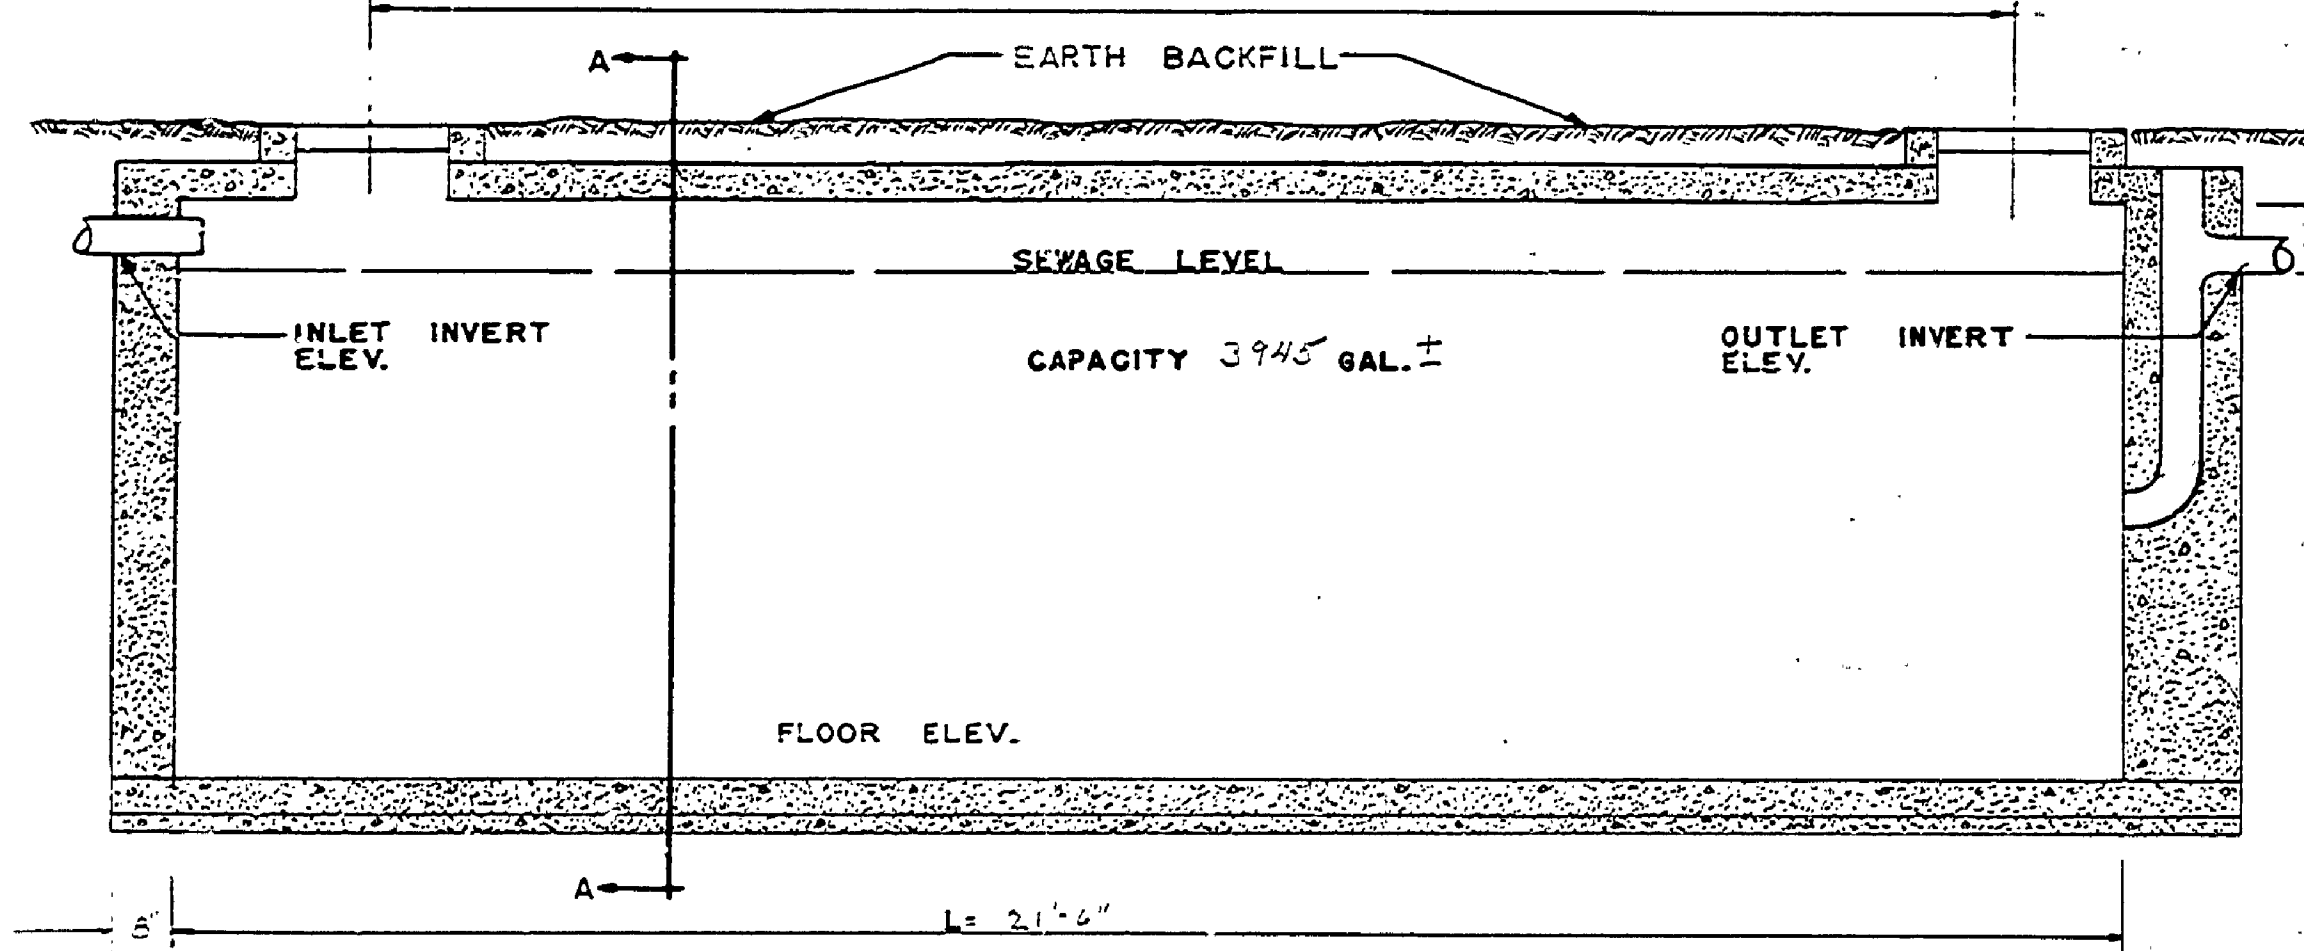

LONGITUDINAL SECTION
 SEPTIC TANK
 NOT TO SCALE

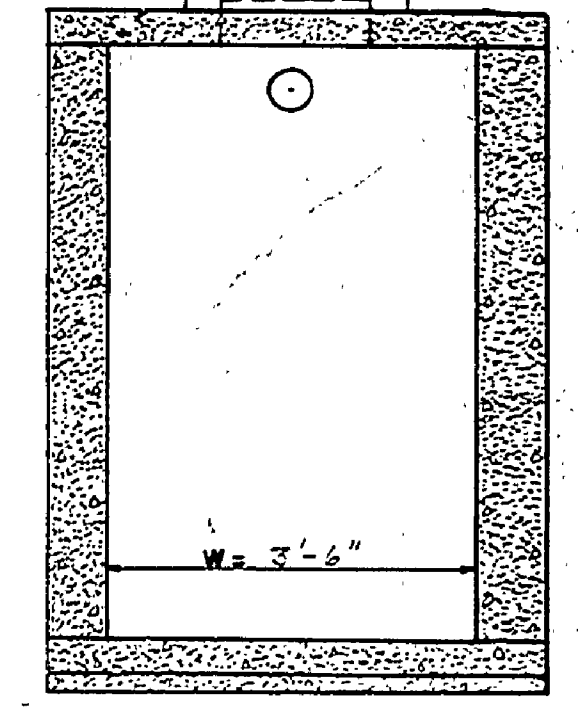

SECTION A-A

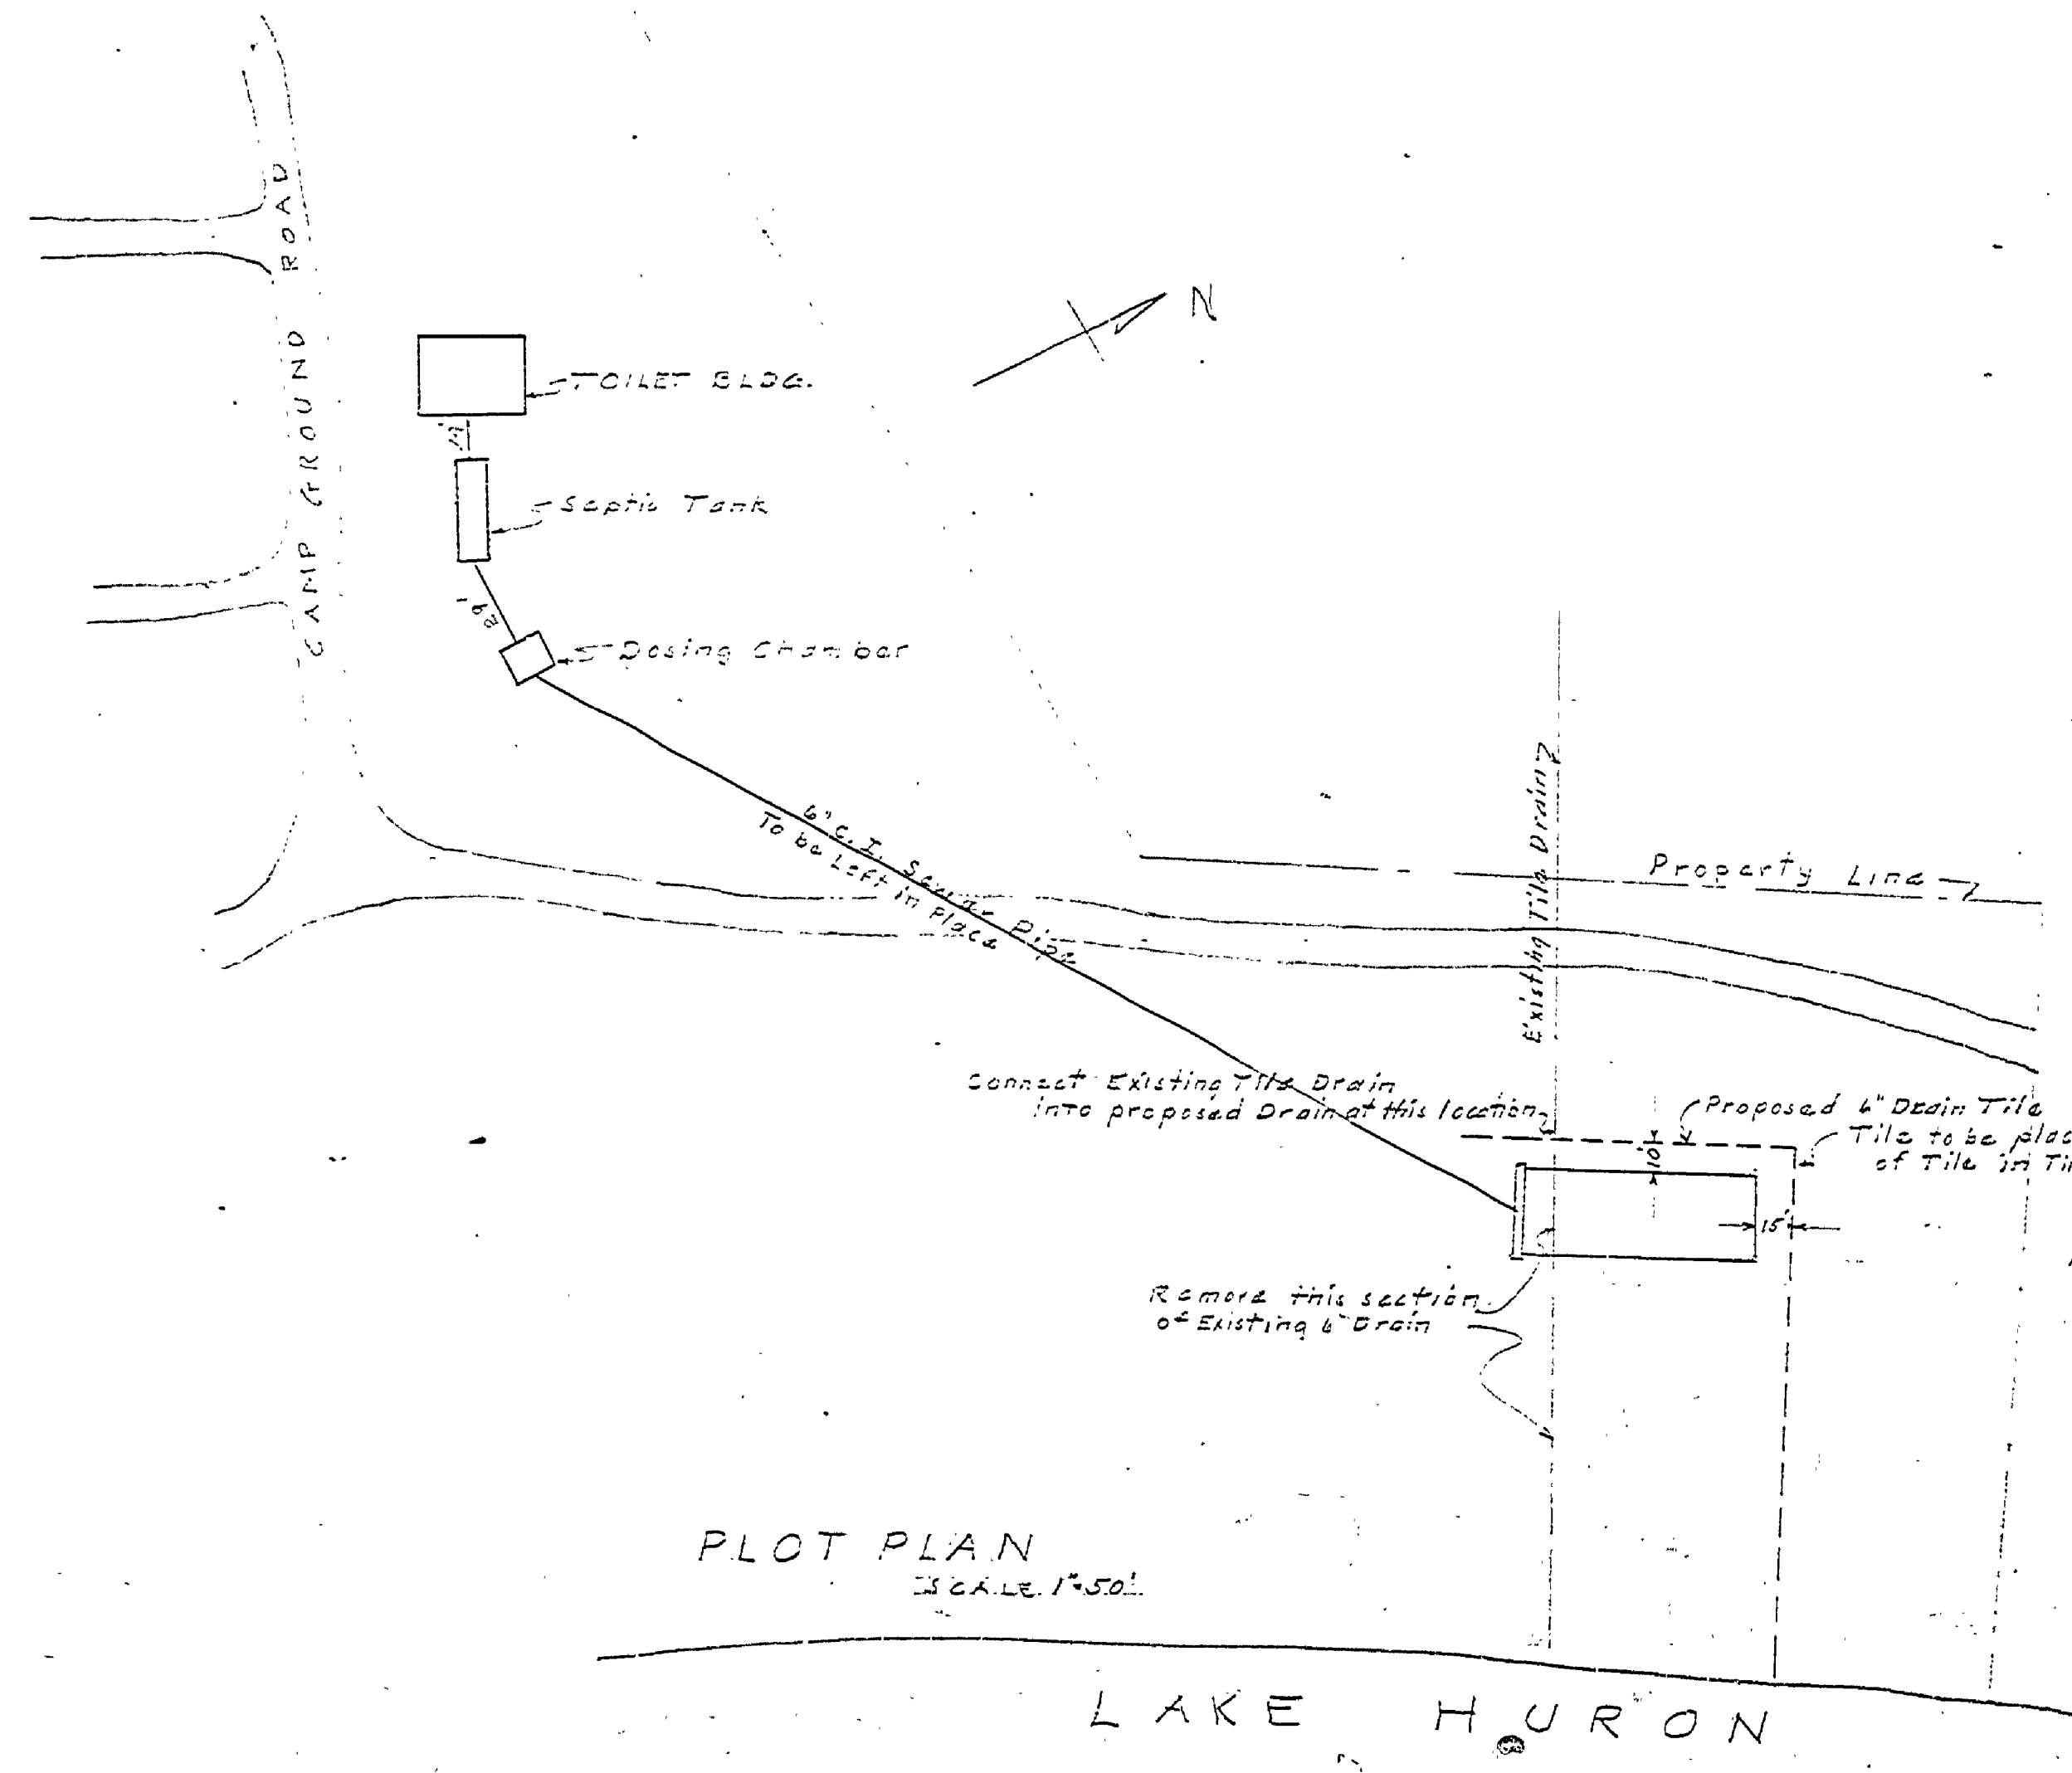

PLOT PLAN
 SCALE 1"=50'

Note:
 Remove, clean and relay existing tile field. Repair Dist. Box and use in rebuilt system. Install ground water drain before starting work on tile field. Purchase and place the necessary gravel to construct the tile field in accordance with details of this plan.

MICHIGAN DEPARTMENT OF CONSERVATION
 PARKS AND RECREATION DIVISION

HARRISVILLE STATE PARK
 NORTH C.G. TOILET BLDG. DISPOSAL
 SCALE 1"=50'

SHEET NO. 1
 OF 1

PLAN NO. E-110

STANDARD DISPOSAL SYSTEM