FORM 1955M 2-58

NO.	DATE	BY	REVISIONS
1	3-18-43	DMC	REVISED ROADS AS CONSTRUCTED ADDED NEW OUTLET BOXES IN FORMER MALL
2			
3			
4			
5			
6			

DRAWN BY
TRACED BY KEB
CHECKED BY RMK
DATE 11 Jan. 1957

REVIEWED BY SECTIONS

		DATE
ARCHITECTURAL	J.T.P.	4-9-57
ENGINEERING	J.T.P.	4-9-57
LANDSCAPE	J.T.P.	4-9-57

APPROVED BY
ASSISTANT CHIEF IN CHARGE OF DESIGN
DATE 4 April 57

KEY

- Proposed outlet box on new pole
- Proposed secondary line
- New pole on existing secondary line
- Proposed guy
- Existing outlet box
- Existing secondary line
- Existing secondary line, to be replaced

NOTE

Use galv. sec. heavy duty wire racks w/8" spacing for #2 and heavier wire & 6" spacing for #4 and lighter.

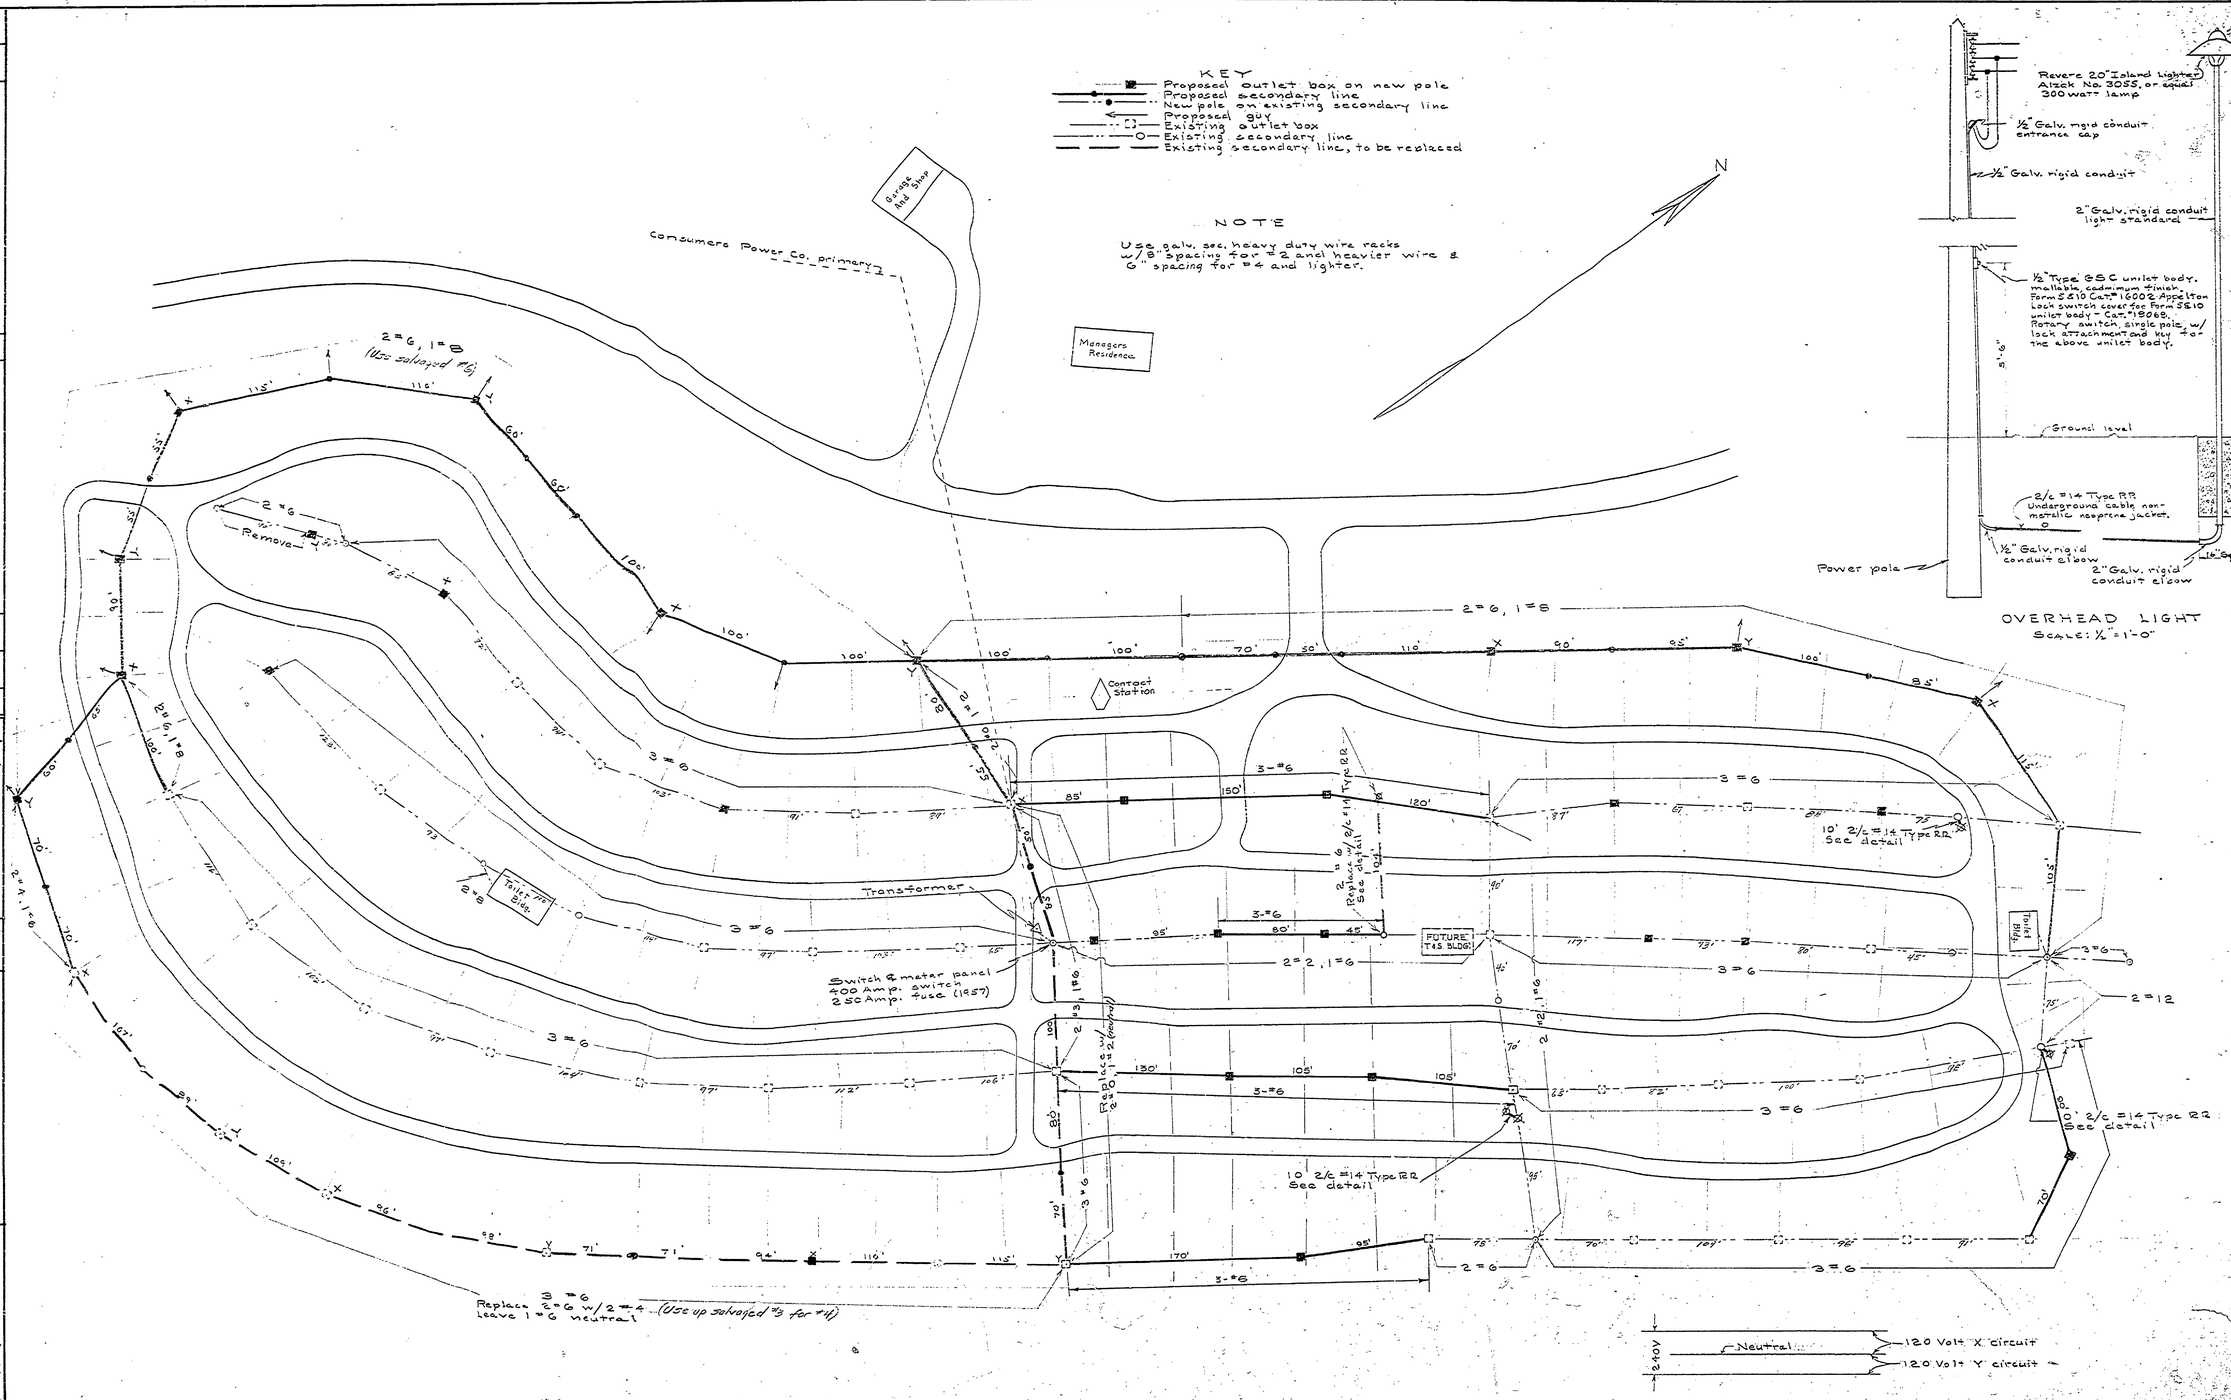

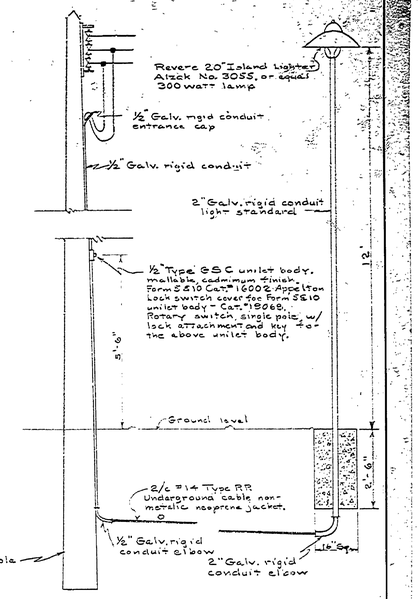

OVERHEAD LIGHT
SCALE: ½"=1'-0"

MICHIGAN
DEPARTMENT OF CONSERVATION
PARKS AND RECREATION DIVISION

HARRISVILLE STATE PARK
ELECTRICAL DISTRIBUTION SYSTEM
Scale 1"=50'

SHEET NO. 1 OF 3

PLAN NO. E-111