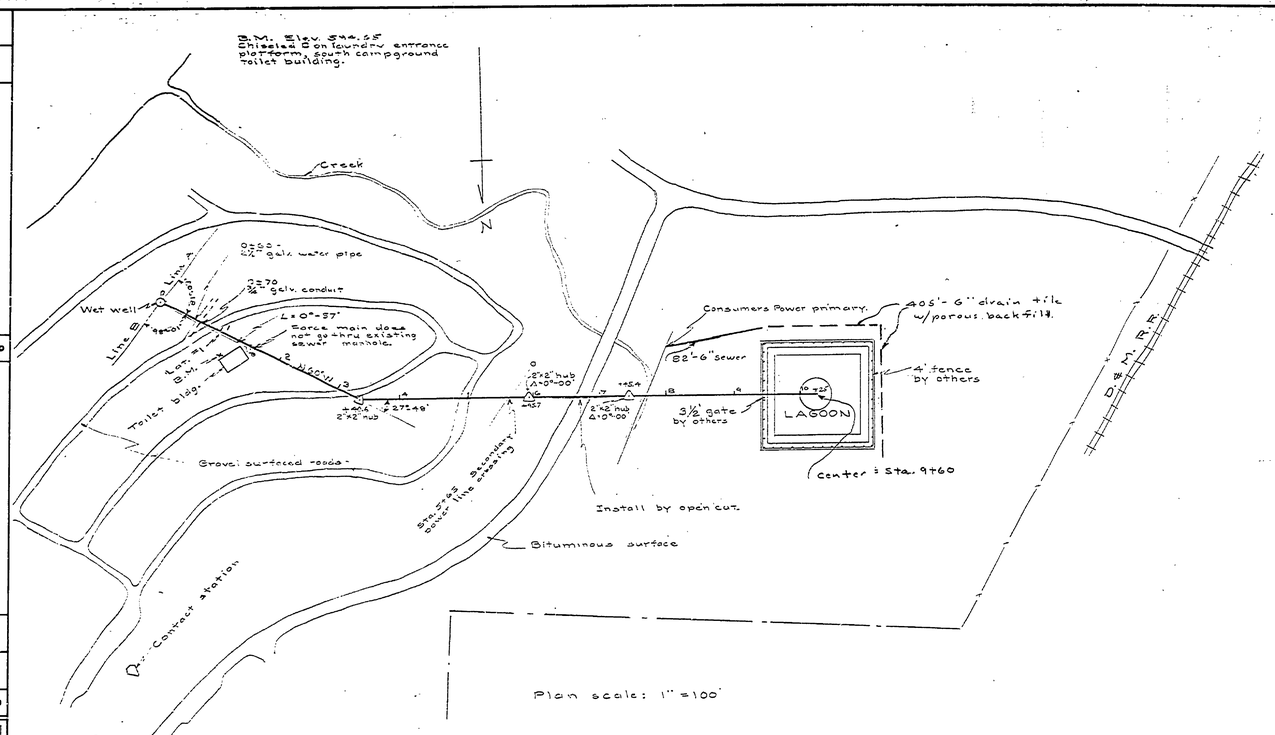

Plan scale: 1" = 100'

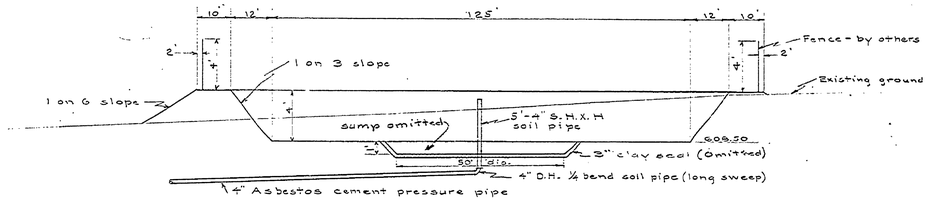

SECTION THRU LAGOON

Scales: Hor. 1" = 20'
Vert. 1" = 5'

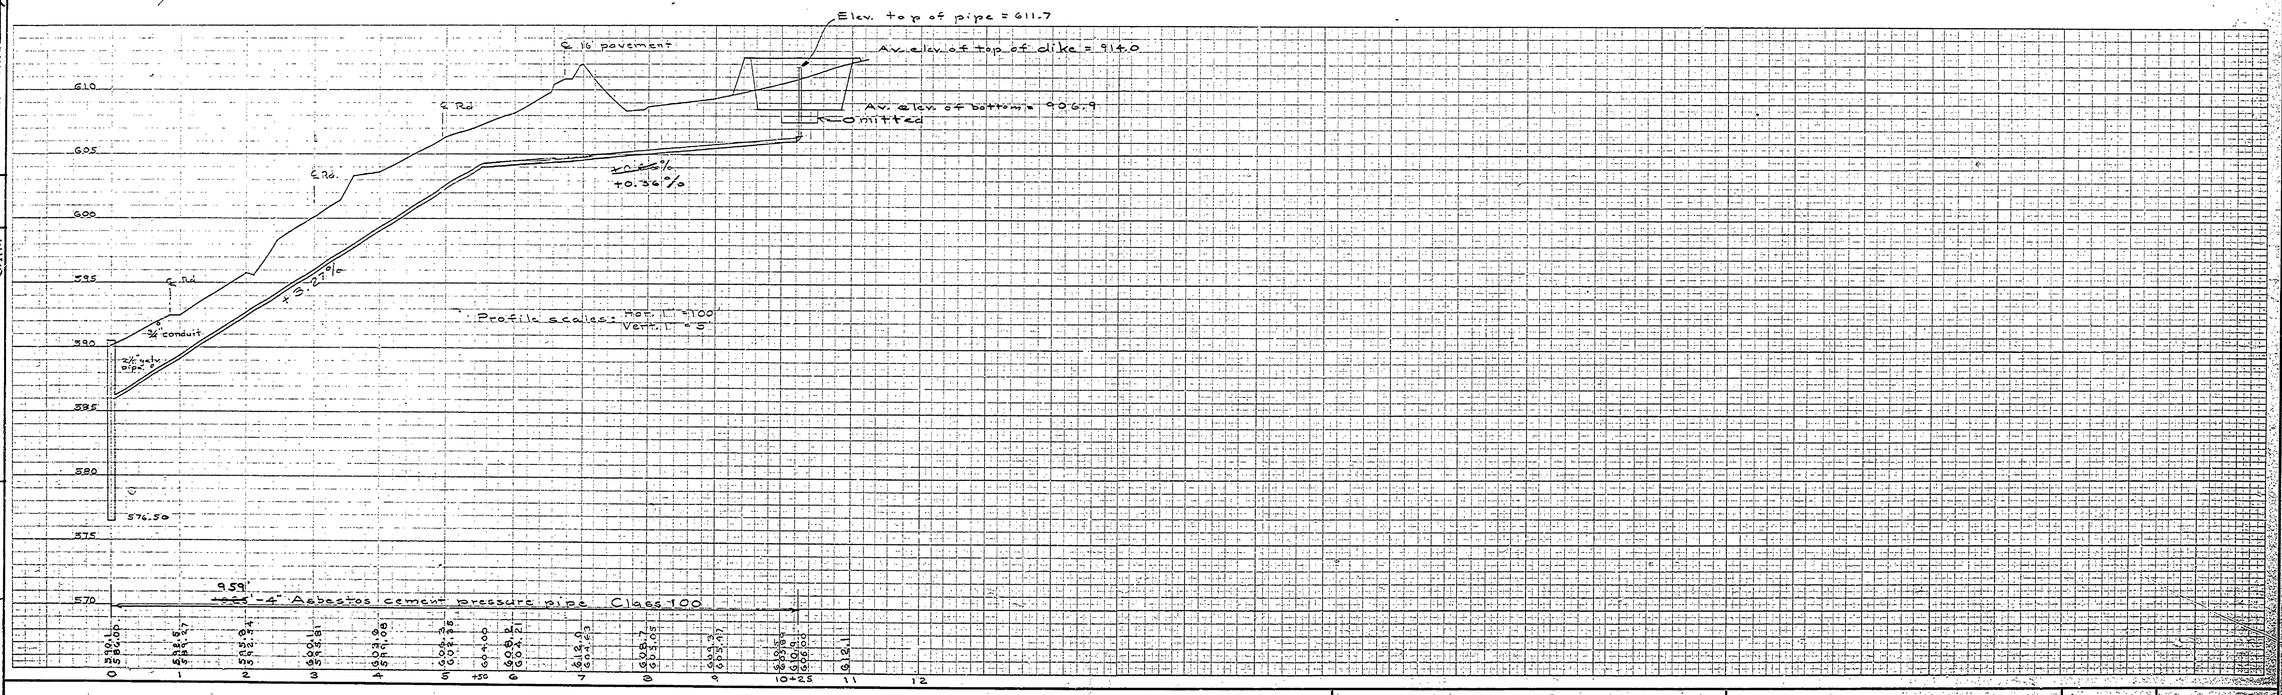

Profile scales: Hor. 1" = 100'
Vert. 1" = 5'

FORCE MAIN & LAGOON

DRAWN BY K.E.B.	REVIEWED BY SECTIONS	DATE	APPROVED BY
TRACED BY	ARCHITECTURAL J.I.R.	8-25-60	
CHECKED BY E.J.P.	ENGINEERING J.I.R.	8-25-60	ASSISTANT CHIEF IN CHARGE
DATE 13 July 1960	LANDSCAPE J.I.R.	8-25-60	OF DESIGN DATE

REVISIONS

NO.	DATE	BY					
1			4				
2			5				
3			6				

MICHIGAN
DEPARTMENT OF CONSERVATION
PARKS AND RECREATION DIVISION

HARRISVILLE STATE PARK
CENTRAL SEWAGE DISPOSAL SYSTEM
SCALE: AS SHOWN

SHEET NO. 3 OF 6

PLAN NO. E-112