

DESIGNED BY W. C. CALANCA	REVIEWED BY SECTIONS	DATE	APPROVED BY	NO. DATE BY	REVISIONS	DATE	BY
TRACED BY J.I.R.	ARCHITECTURAL	3-24-60	<i>J.I.R.</i>	1			
CHECKED BY J.I.R.	ENGINEERING	3-24-60	<i>J.I.R.</i>	2			
DATE	LANDSCAPE	3-27-60	<i>J.I.R.</i>	3			
				4			
				5			
				6			

HARRISVILLE STATE PARK


SCALE AS SHOWN

MICHIGAN DEPARTMENT OF CONSERVATION
PARKS AND RECREATION DIVISION

HARRISVILLE STATE PARK
UTILITY MAP
WATER & SEWAGE SYSTEM



SHEET NO. 4 OF 4

PLAN NO. U-1

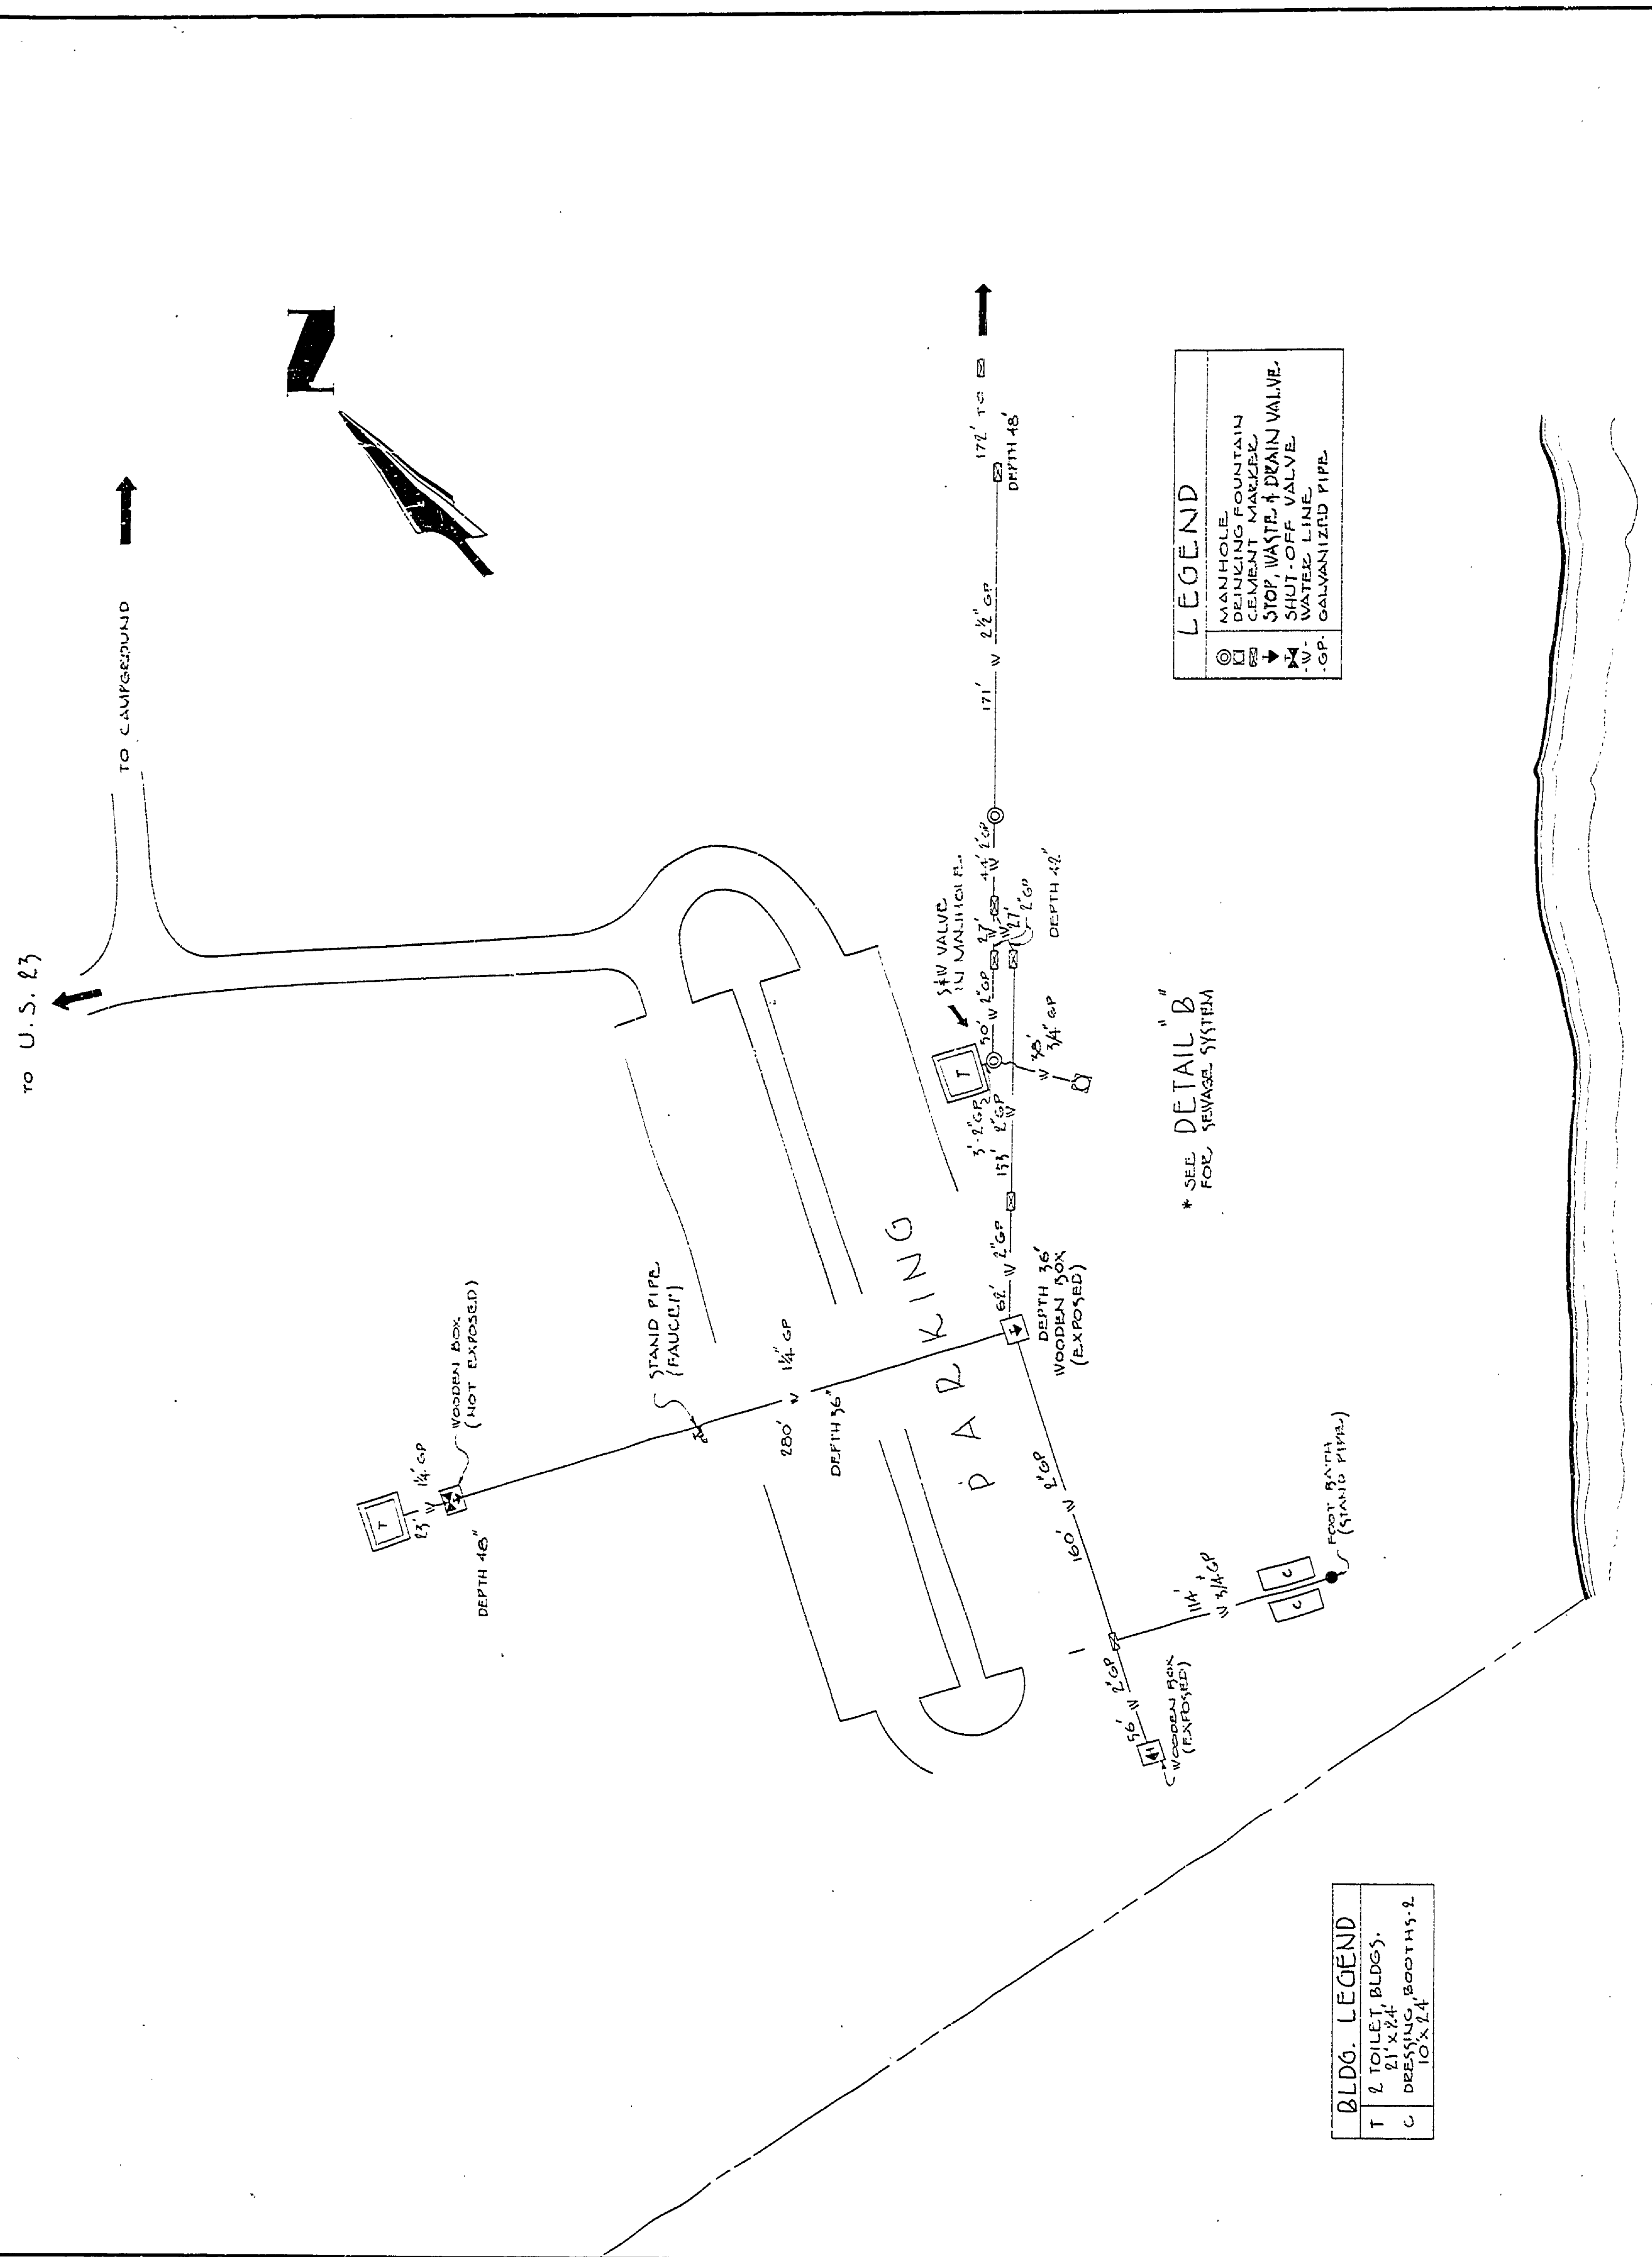

MICHIGAN DEPARTMENT OF CONSERVATION
HARRISVILLE STATE PARK
PICNIC AREA
WATER SYSTEM

MICHIGAN DEPARTMENT OF CONSERVATION
HARRISVILLE STATE PARK
TOILET BLDGS.
SEWAGE SYSTEM

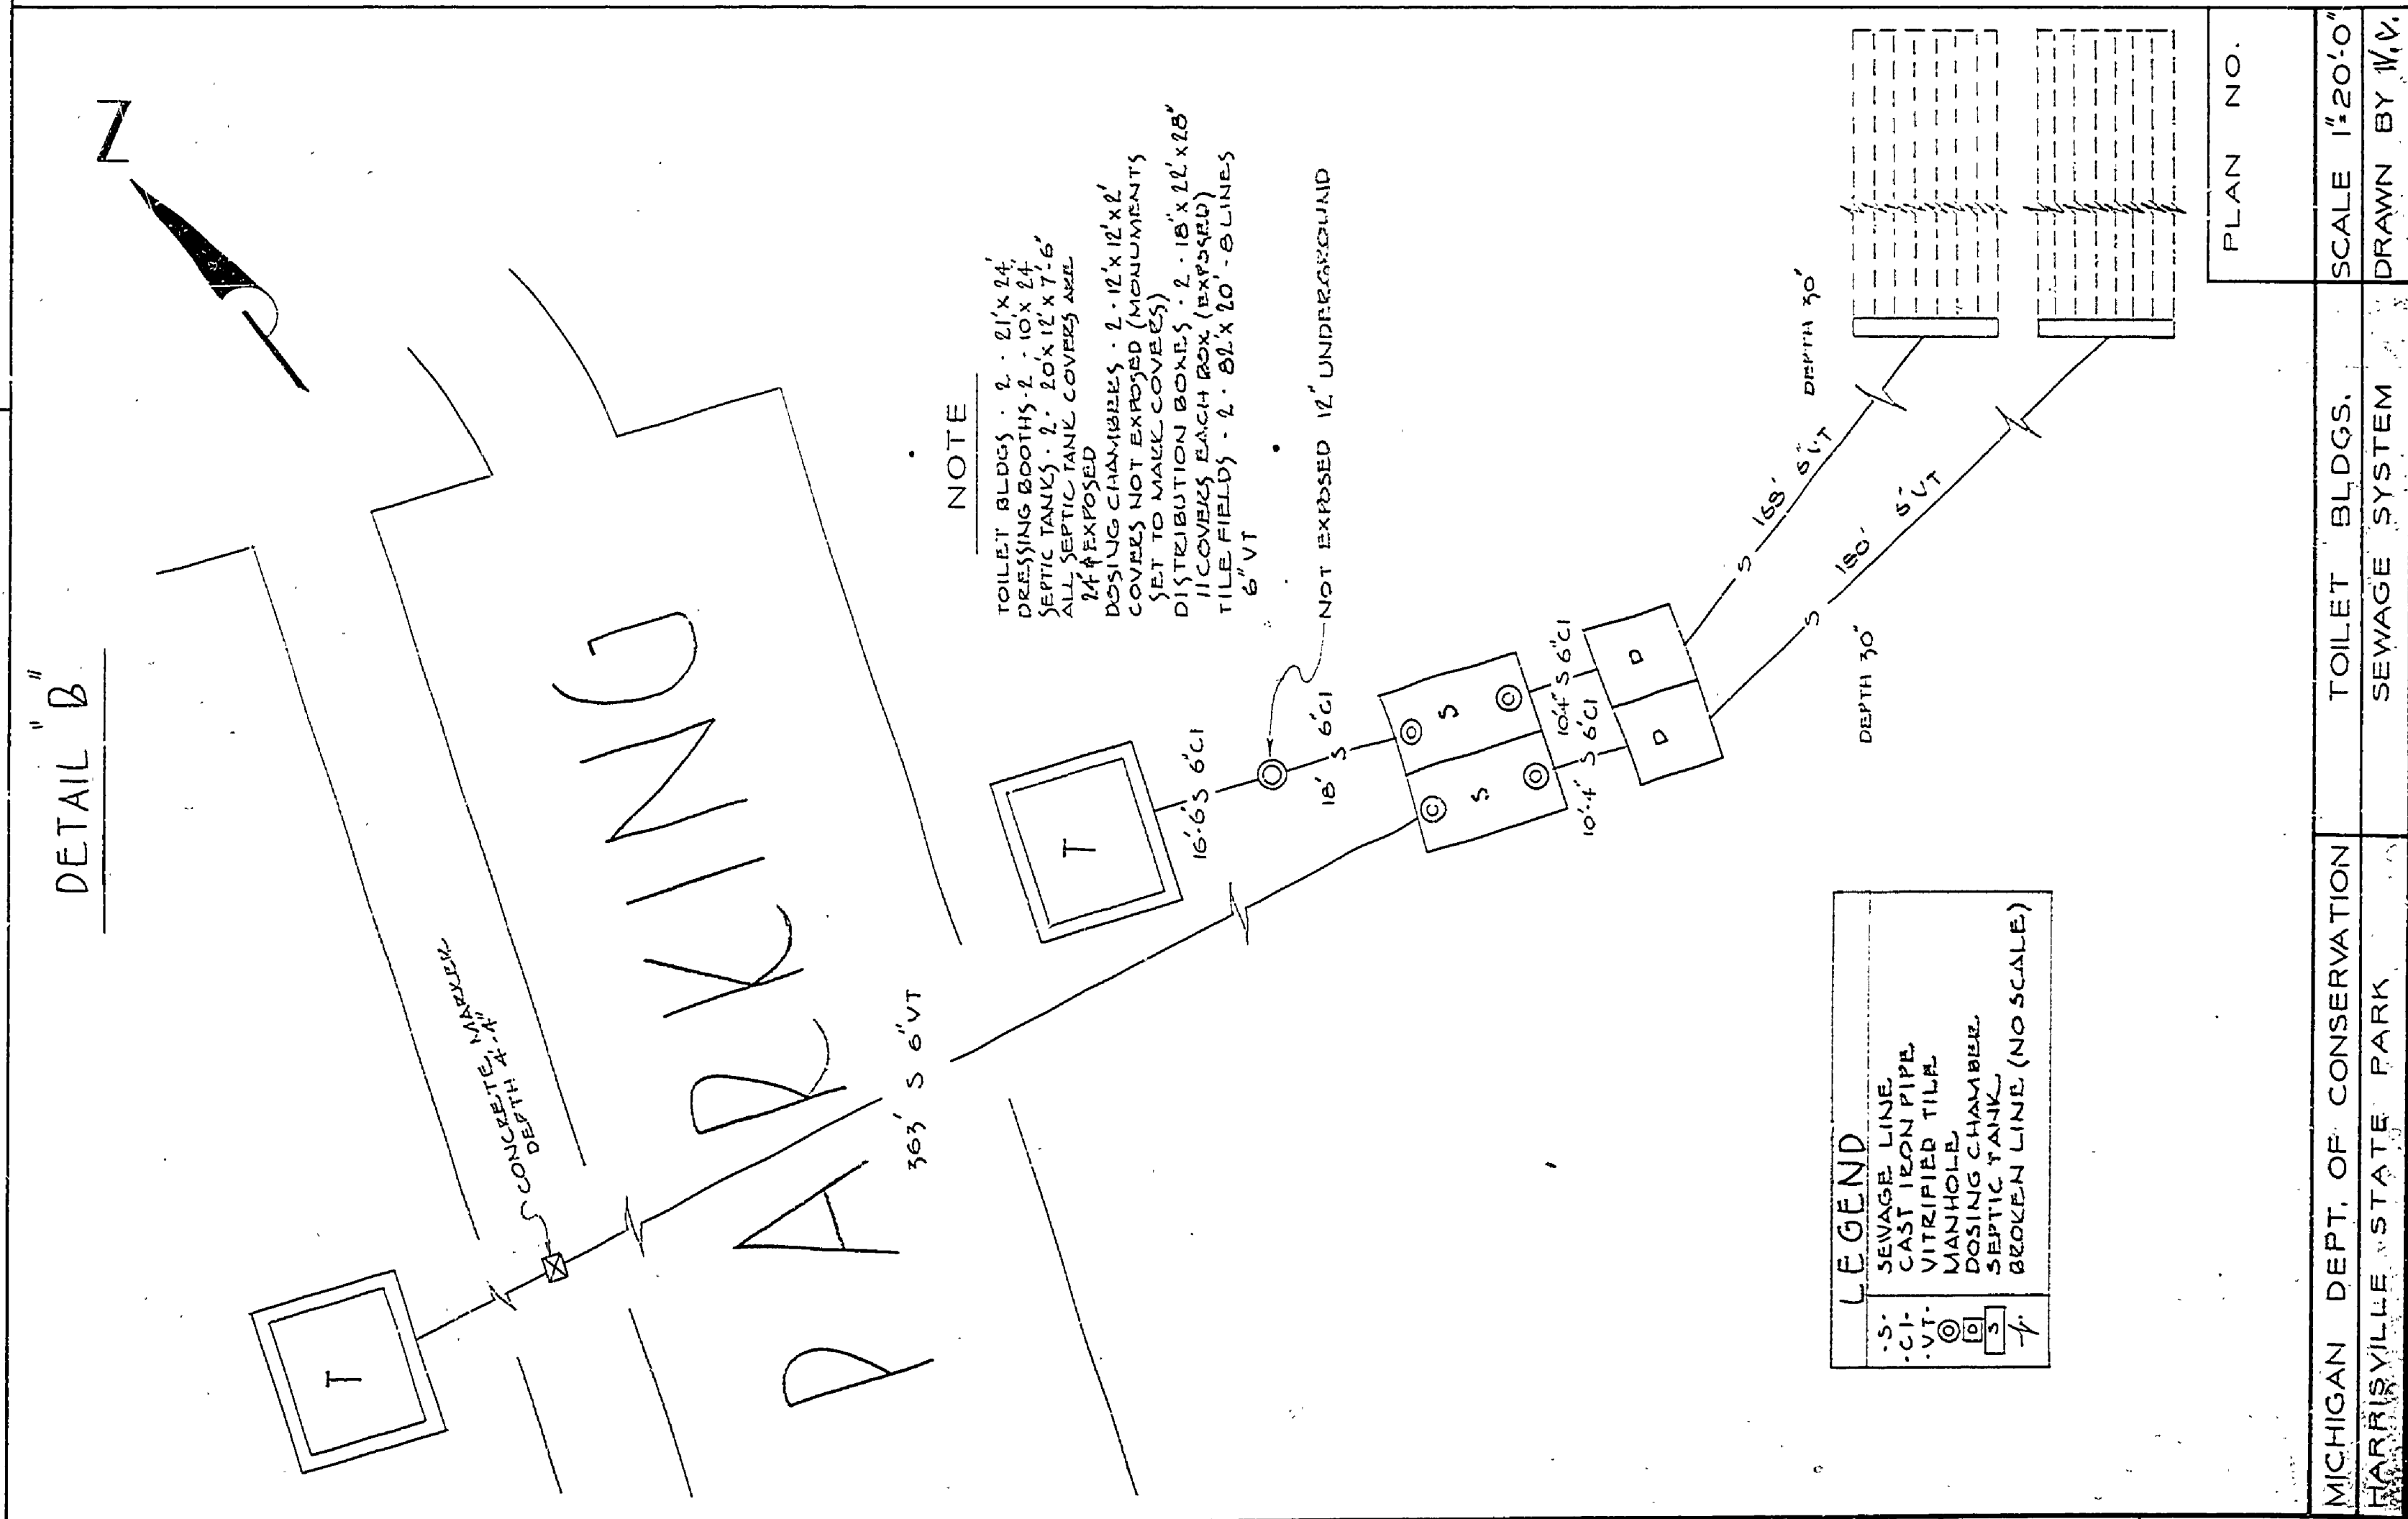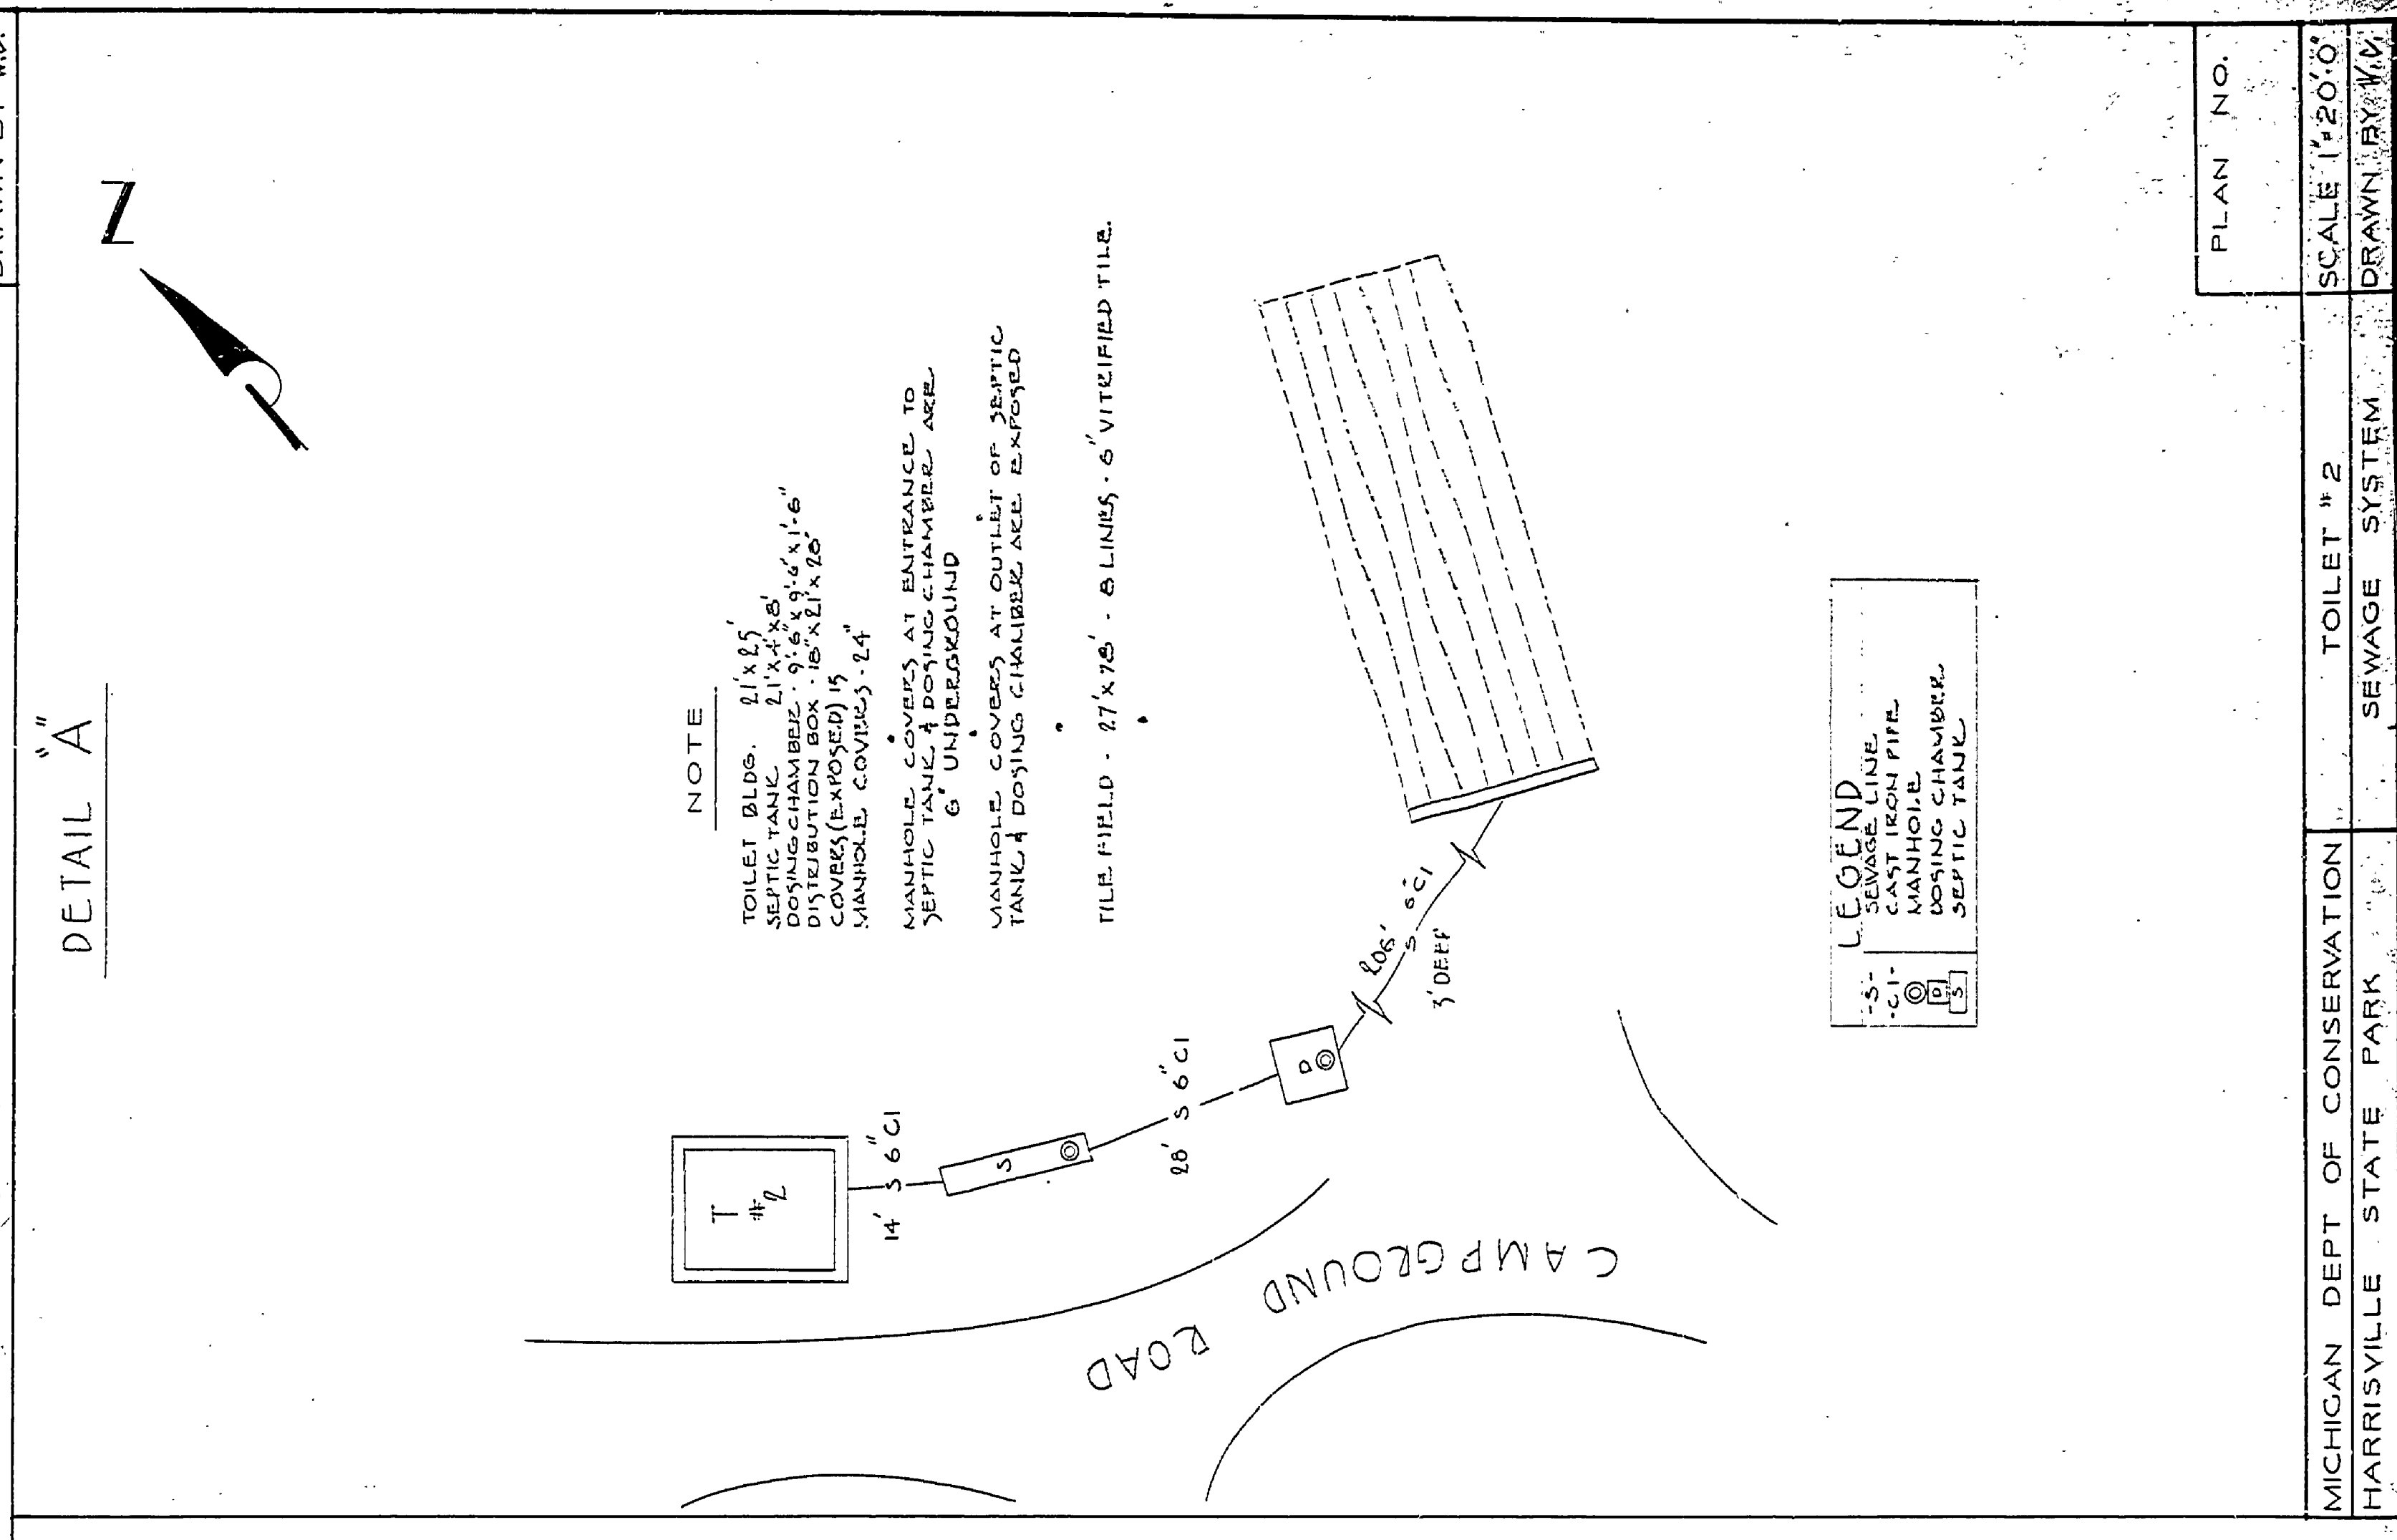

MICHIGAN DEPT. OF CONSERVATION
HARRISVILLE STATE PARK
TOILET # 2
SEWAGE SYSTEM

MICHIGAN DEPT. OF CONSERVATION
HARRISVILLE STATE PARK
TOILET BLDGS.
SEWAGE SYSTEM