

DATE	BY	REVISIONS	NO.	DATE	BY
			1		
			2		
			3		

DRAWN BY
 TRACED BY
 CHECKED BY
 DATE


REVIEWED BY SECTIONS
 ARCHITECTURAL
 ENGINEERING
 LANDSCAPE

APPROVED BY
 ASSISTANT CHIEF IN CHARGE
 OF DESIGN

DATE 3-7-57
 DATE 3-7-57
 DATE 3-7-57

AREAS TO BE GRAVELED

Areas to receive 5" of compacted gravel as determined from cross sections.
 5 to 10 foot strip to receive any gravel remaining in the contract quantity (780 ton) after the shaded areas have been surfaced.

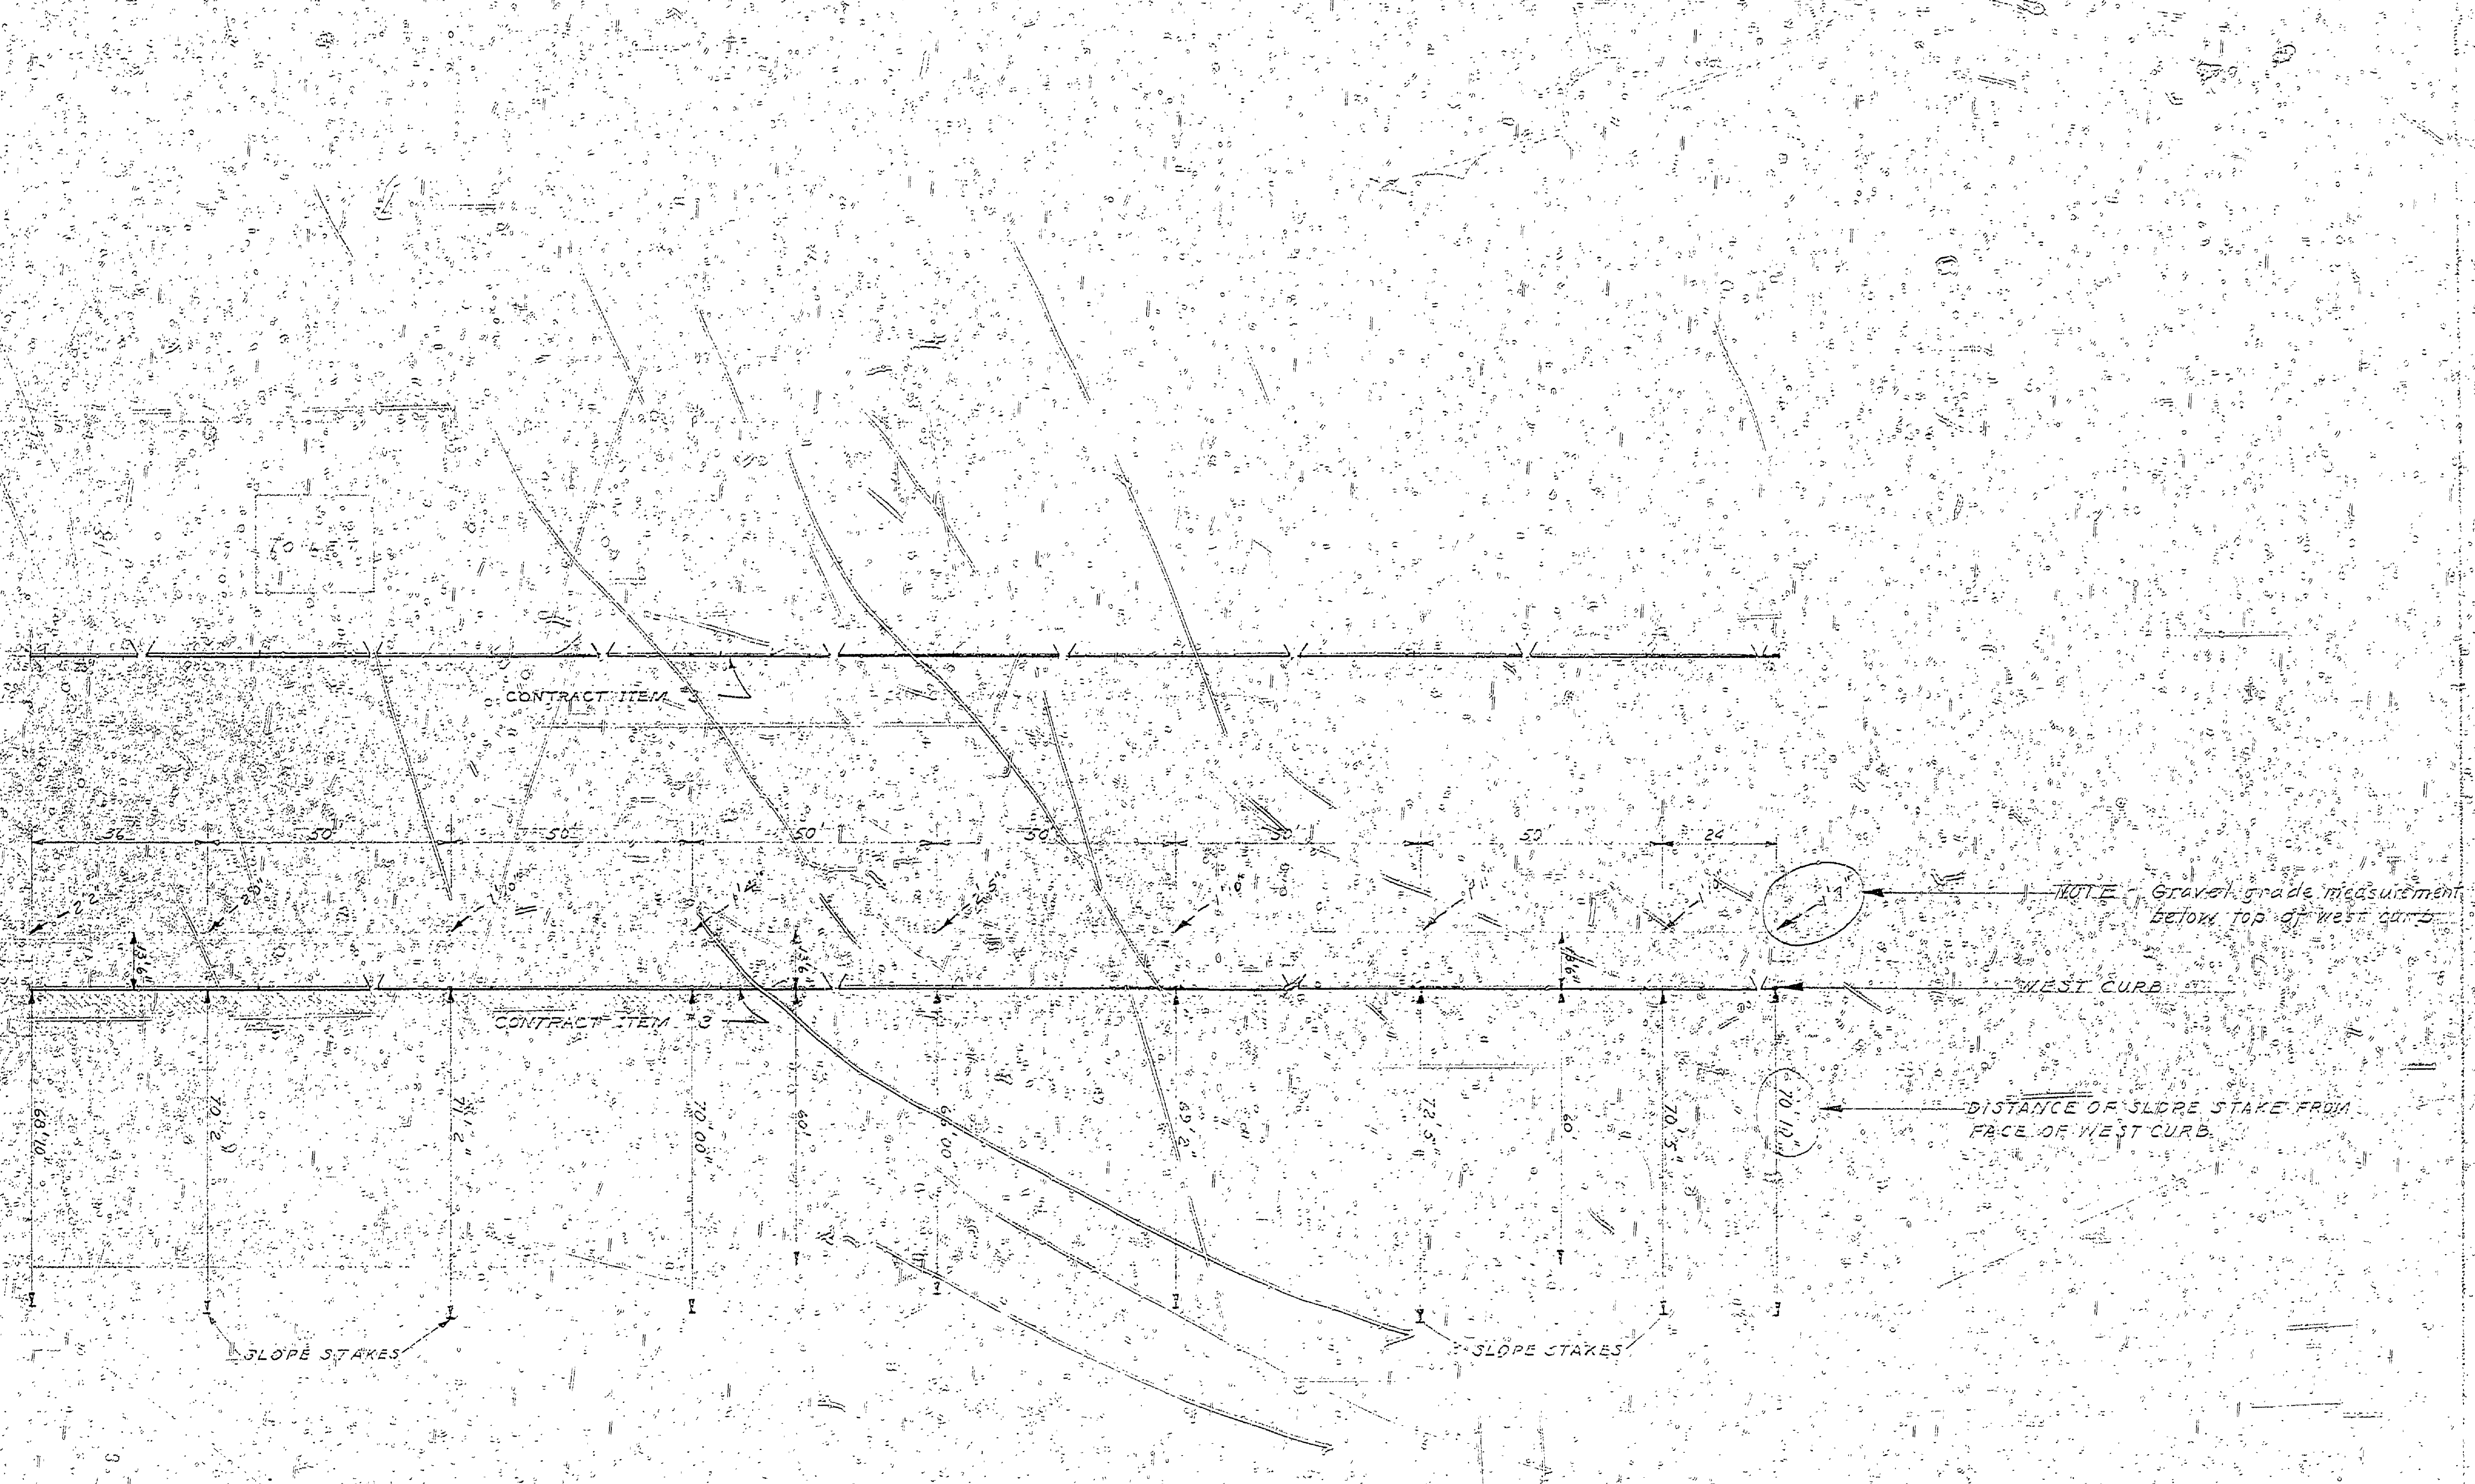

NOTE: Cuts on Slope Stakes are cuts to sub-grade.
 Station 1+14 - 1.3 = 1'4"
 1+50 - 1.4 = 1'5"
 2+00 - 1.6 = 1'7"
 2+50 - 1.9 = 1'11"
 3+00 - 1.5 = 1'6"
 3+50 - 2.3 = 2'4"
 4+00 - 3.1 = 3'1"
 4+50 - 2.6 = 2'7"
 4+74 - 2.0 = 2'0"

SCALE - 1" = 20'

MICHIGAN
 DEPARTMENT OF CONSERVATION
 PARKS AND RECREATION DIVISION

HARRISVILLE STATE PARK
 PICNIC AREA PARKING
 REVISED PLAN

SHEET NO. 2
 OF 4
 PLAN NO. L-106