# Lake Gogebic State Park

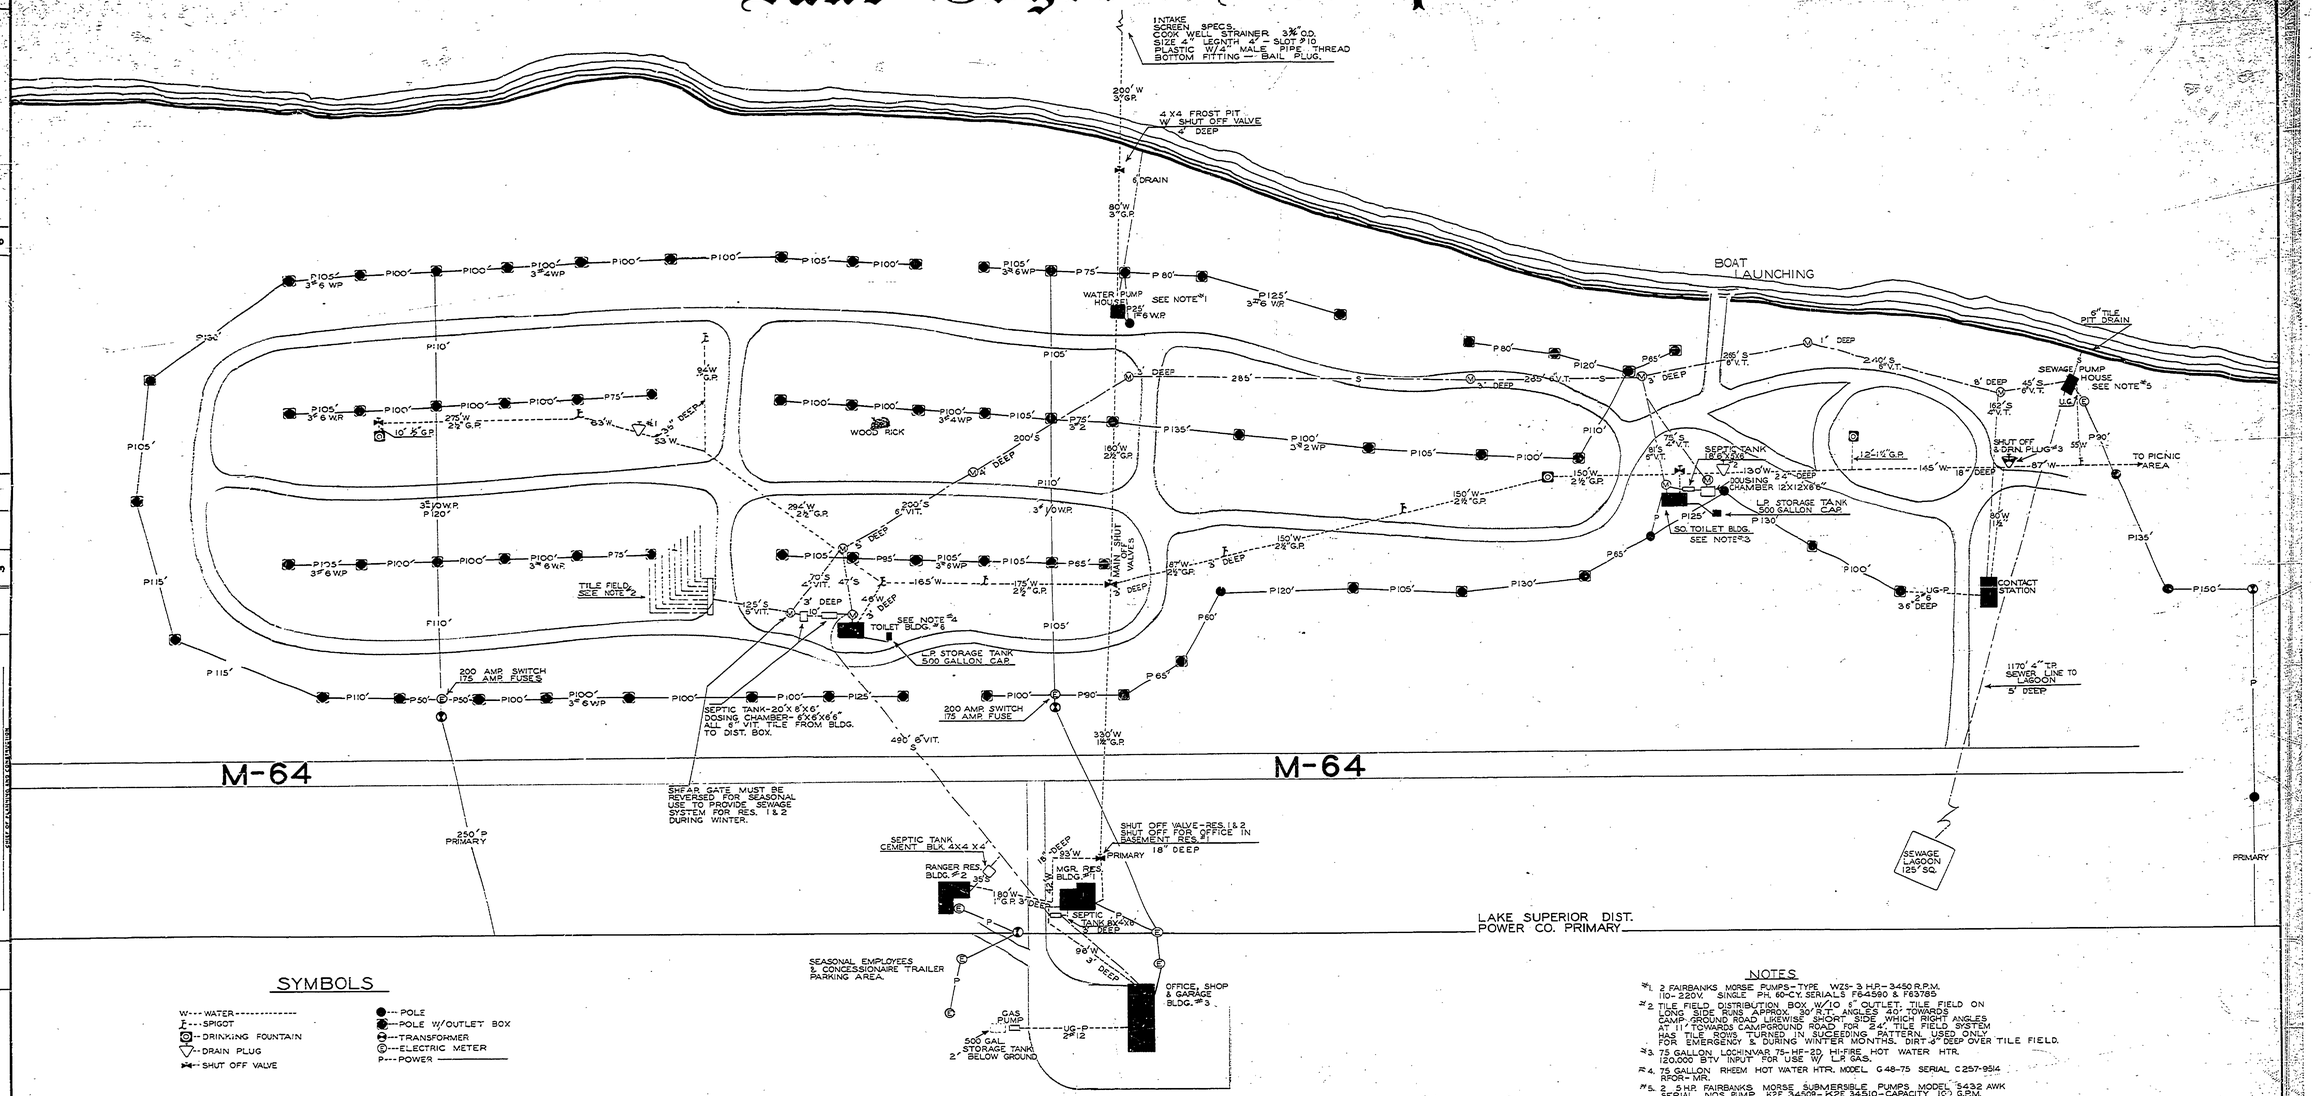


## SYMBOLS

- W--- WATER
- SPIGOT
- DRINKING FOUNTAIN
- DRAIN PLUG
- SHUT OFF VALVE
- POLE
- POLE W/OUTLET BOX
- TRANSFORMER
- ELECTRIC METER
- P--- POWER
- S--- SEWAGE
- MANHOLE

DRAIN PLUG 1&2 MUST BE OPENED WHEN WINTERIZING.

## NOTES

#1. 2 FAIRBANKS MORSE PUMPS-TYPE WZS-3 H.P.-3450 R.P.M. 110-220V. SINGLE PH. 60-CY. SERIALS F64590 & F63785

#2 TILE FIELD DISTRIBUTION BOX W/10 5" OUTLET. TILE FIELD ON LONG SIDE RUNS APPROX. 30' R.T. ANGLES 40' TOWARDS CAMP-GROUND ROAD LIKEWISE SHORT SIDE WHICH RIGHT ANGLES AT 117 TOWARDS CAMPGROUND ROAD FOR 24' TILE FIELD SYSTEM HAS TILE EDGE TURNED IN SUCEEDING PATTERN. USED ONLY FOR EMERGENCY & DURING WINTER MONTHS. DIRT 3' DEEP OVER TILE FIELD.

#3. 75 GALLON LOCHINVAR 75-HF-20 HI-FIRE HOT WATER HTR. 120,000 BTV INPUT FOR USE W/ LP GAS.

#4. 75 GALLON RHEEM HOT WATER HTR. MODEL G48-75 SERIAL C257-9514 RFOR-MR.

#5. 2 5 HP FAIRBANKS MORSE SUBMERSIBLE PUMPS MODEL 5432 AWK SERIAL NOS PUMP K2E 34509-K2E 34510-CAPACITY 100 G.P.M. 5 HP- SINGLE PHASE-60-CYCLE 230 VOLT - 1750 R.P.M.

| DATE | NO. | DATE | BY | REVISION | DATE | BY |
|---|---|---|---|---|---|---|
| | 1 | | | 4 | | |
| | 2 | | | 5 | | |
| | 3 | | | 6 | | |

APPROVED — CHIEF OF DIVISION — CHIEF, CHIEF OF DIVISION — STATE OF MICHIGAN DEPT. OF CONSERVATION

| | DATE | REVIEWED | DATE |
|---|---|---|---|
| DESIGNED BY | | ARCHITECTURAL | |
| DRAWN BY | 9/1/61 | ENGINEERING | |
| CHECKED BY G. H. CRAY | 5-18-63 | LANDSCAPE | |

MICHIGAN
DEPARTMENT OF CONSERVATION
PARKS AND RECREATION DIVISION

UTILITY
ELECTRIC-WATER-SEWAGE

SHEET NO. 1 OF 1

PLAN NO. U-1