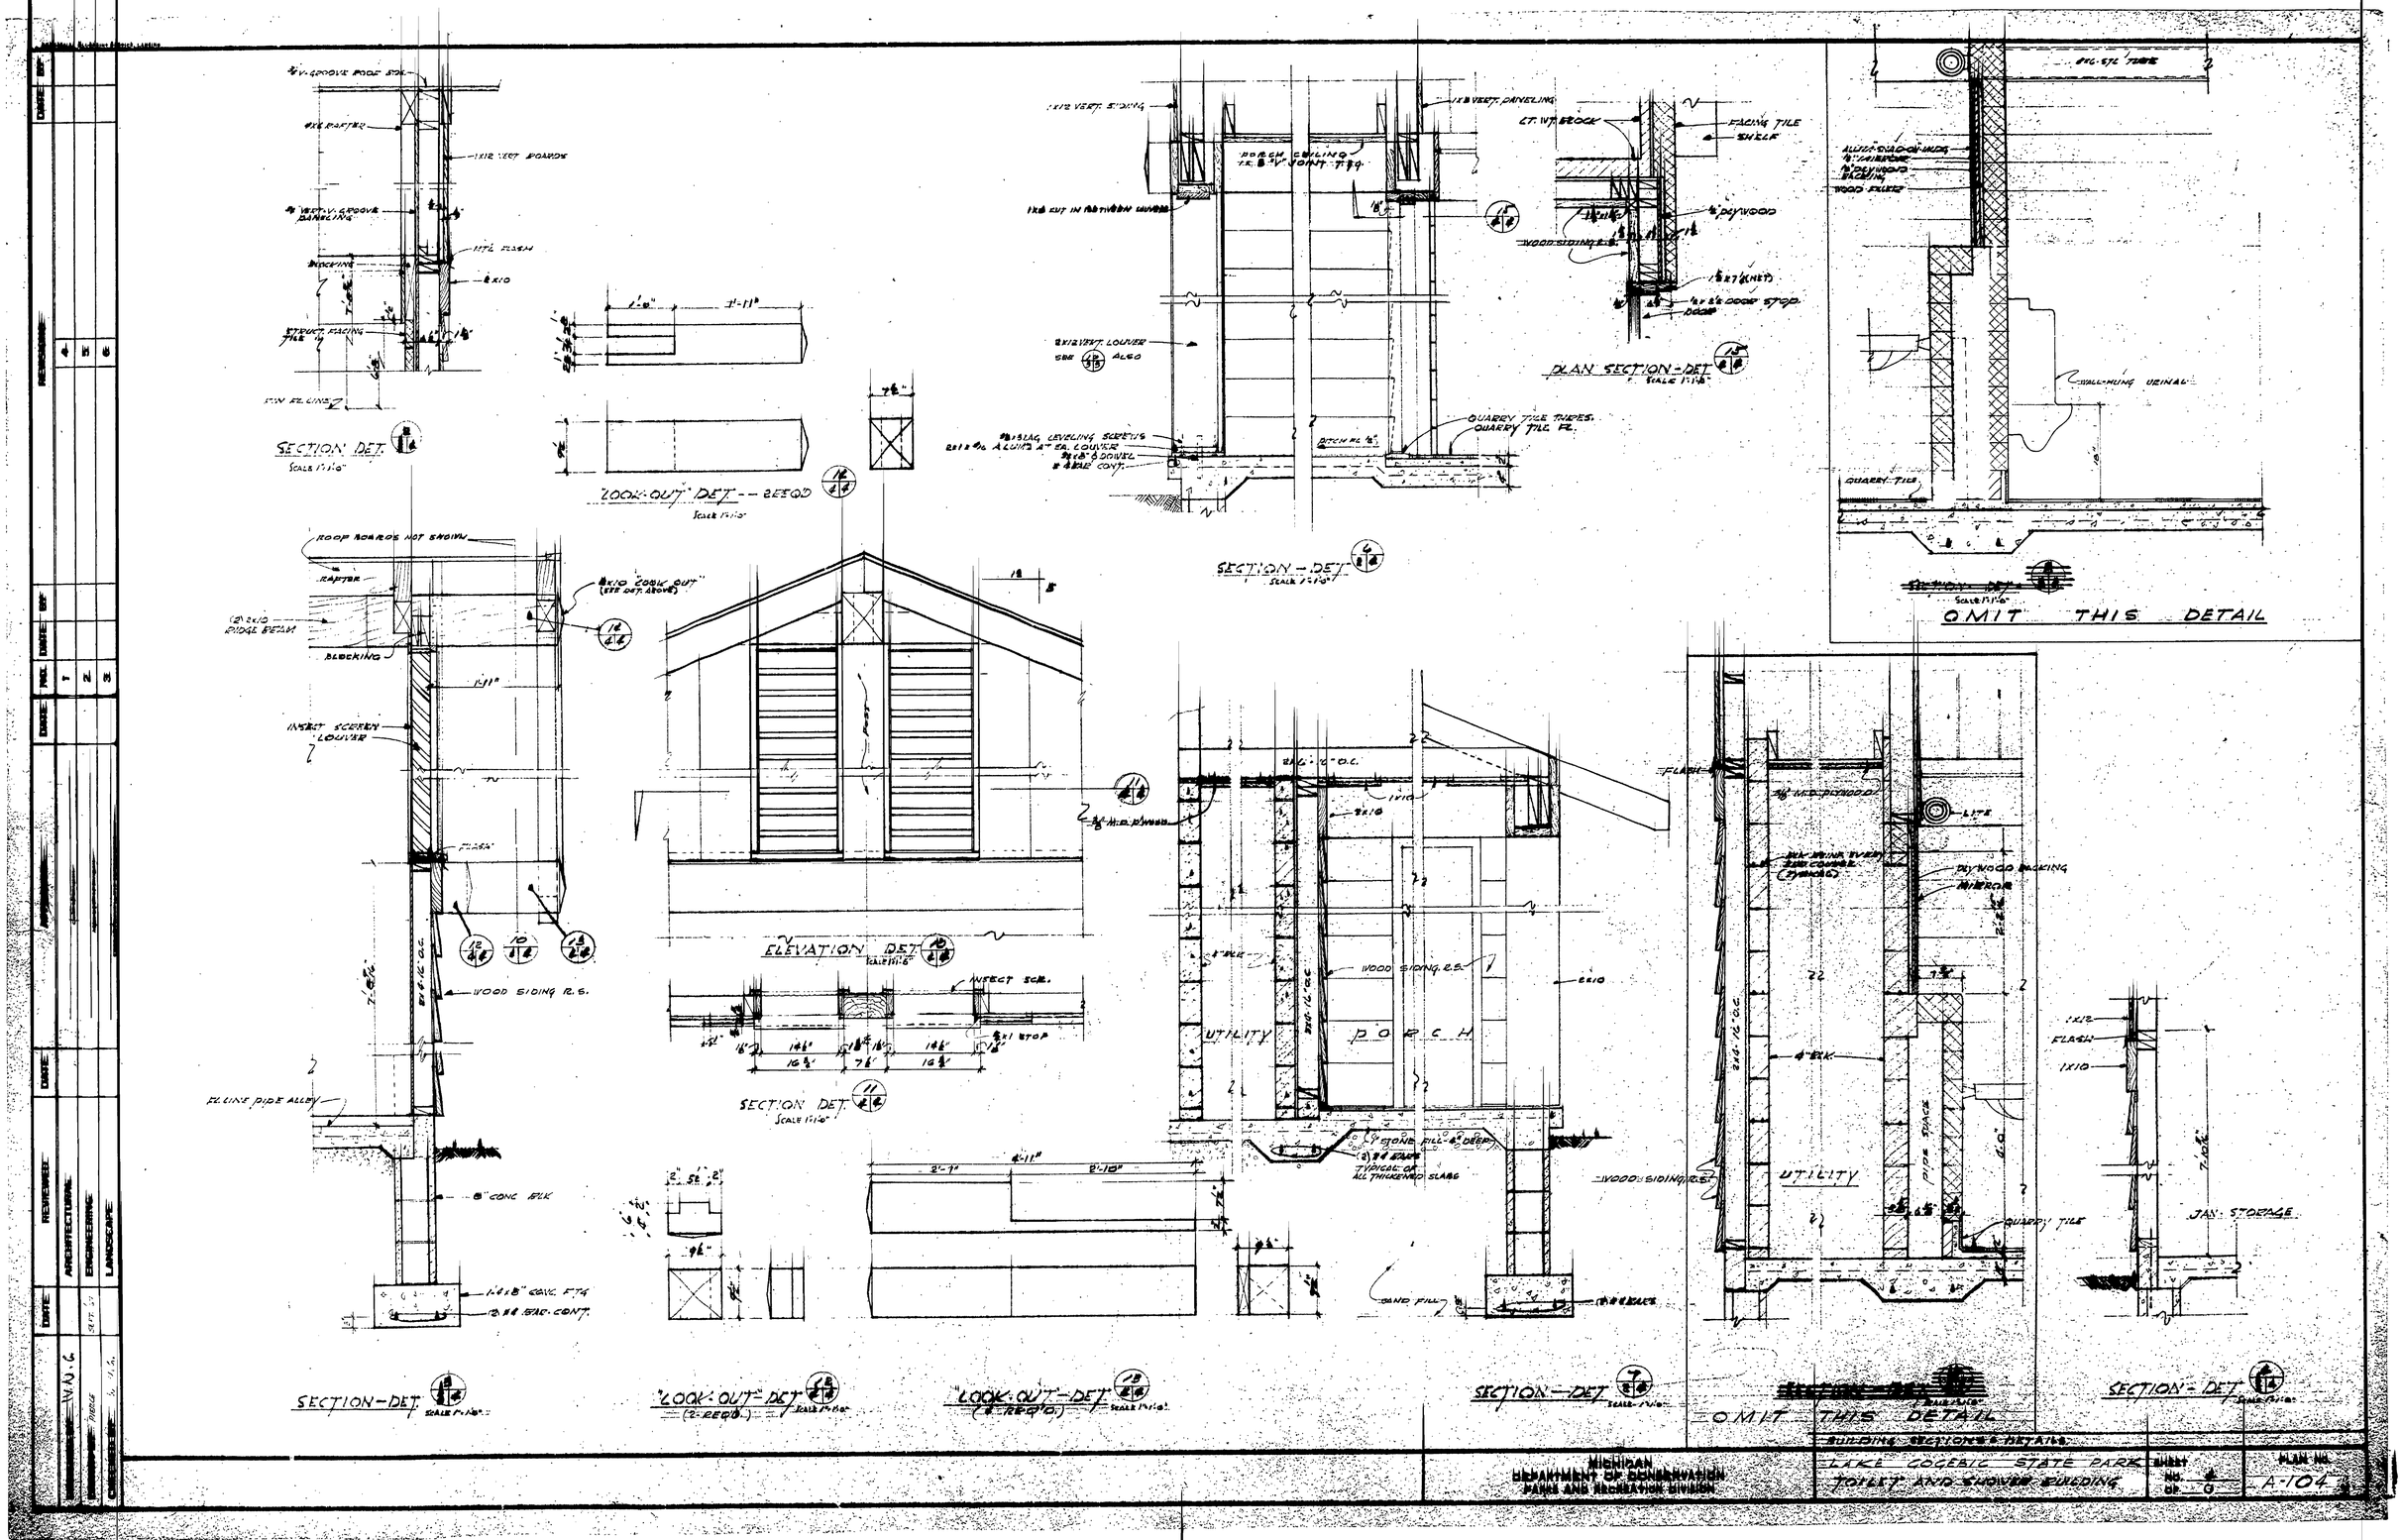
SECTION DET.
SCALE 1"=1'-0"
"LOOK-OUT" DET. -- 2 REQ'D
SCALE 1"=1'-0"
SECTION - DET.
SCALE 1"=1'-0"
PLAN SECTION - DET.
SCALE 1"=1'-0"
OMIT THIS DETAIL
ELEVATION DET.
SCALE 1"=1'-0"
SECTION DET.
SCALE 1"=1'-0"
UTILITY
PORCH
UTILITY
SECTION - DET.
SCALE 1"=1'-0"
"LOOK-OUT" DET.
(2 REQ'D.)
SCALE 1"=1'-0"
"LOOK-OUT" DET.
(8 REQ'D.)
SCALE 1"=1'-0"
SECTION - DET.
SCALE 1"=1'-0"
OMIT THIS DETAIL
SECTION - DET.
SCALE 1"=1'-0"
MICHIGAN
DEPARTMENT OF CONSERVATION
PARKS AND RECREATION DIVISION
BUILDING SECTIONS & DETAILS
LAKE GOGEBIC STATE PARK
TOILET AND SHOWER BUILDING
SHEET NO. 4 OF 9
PLAN NO. A-104