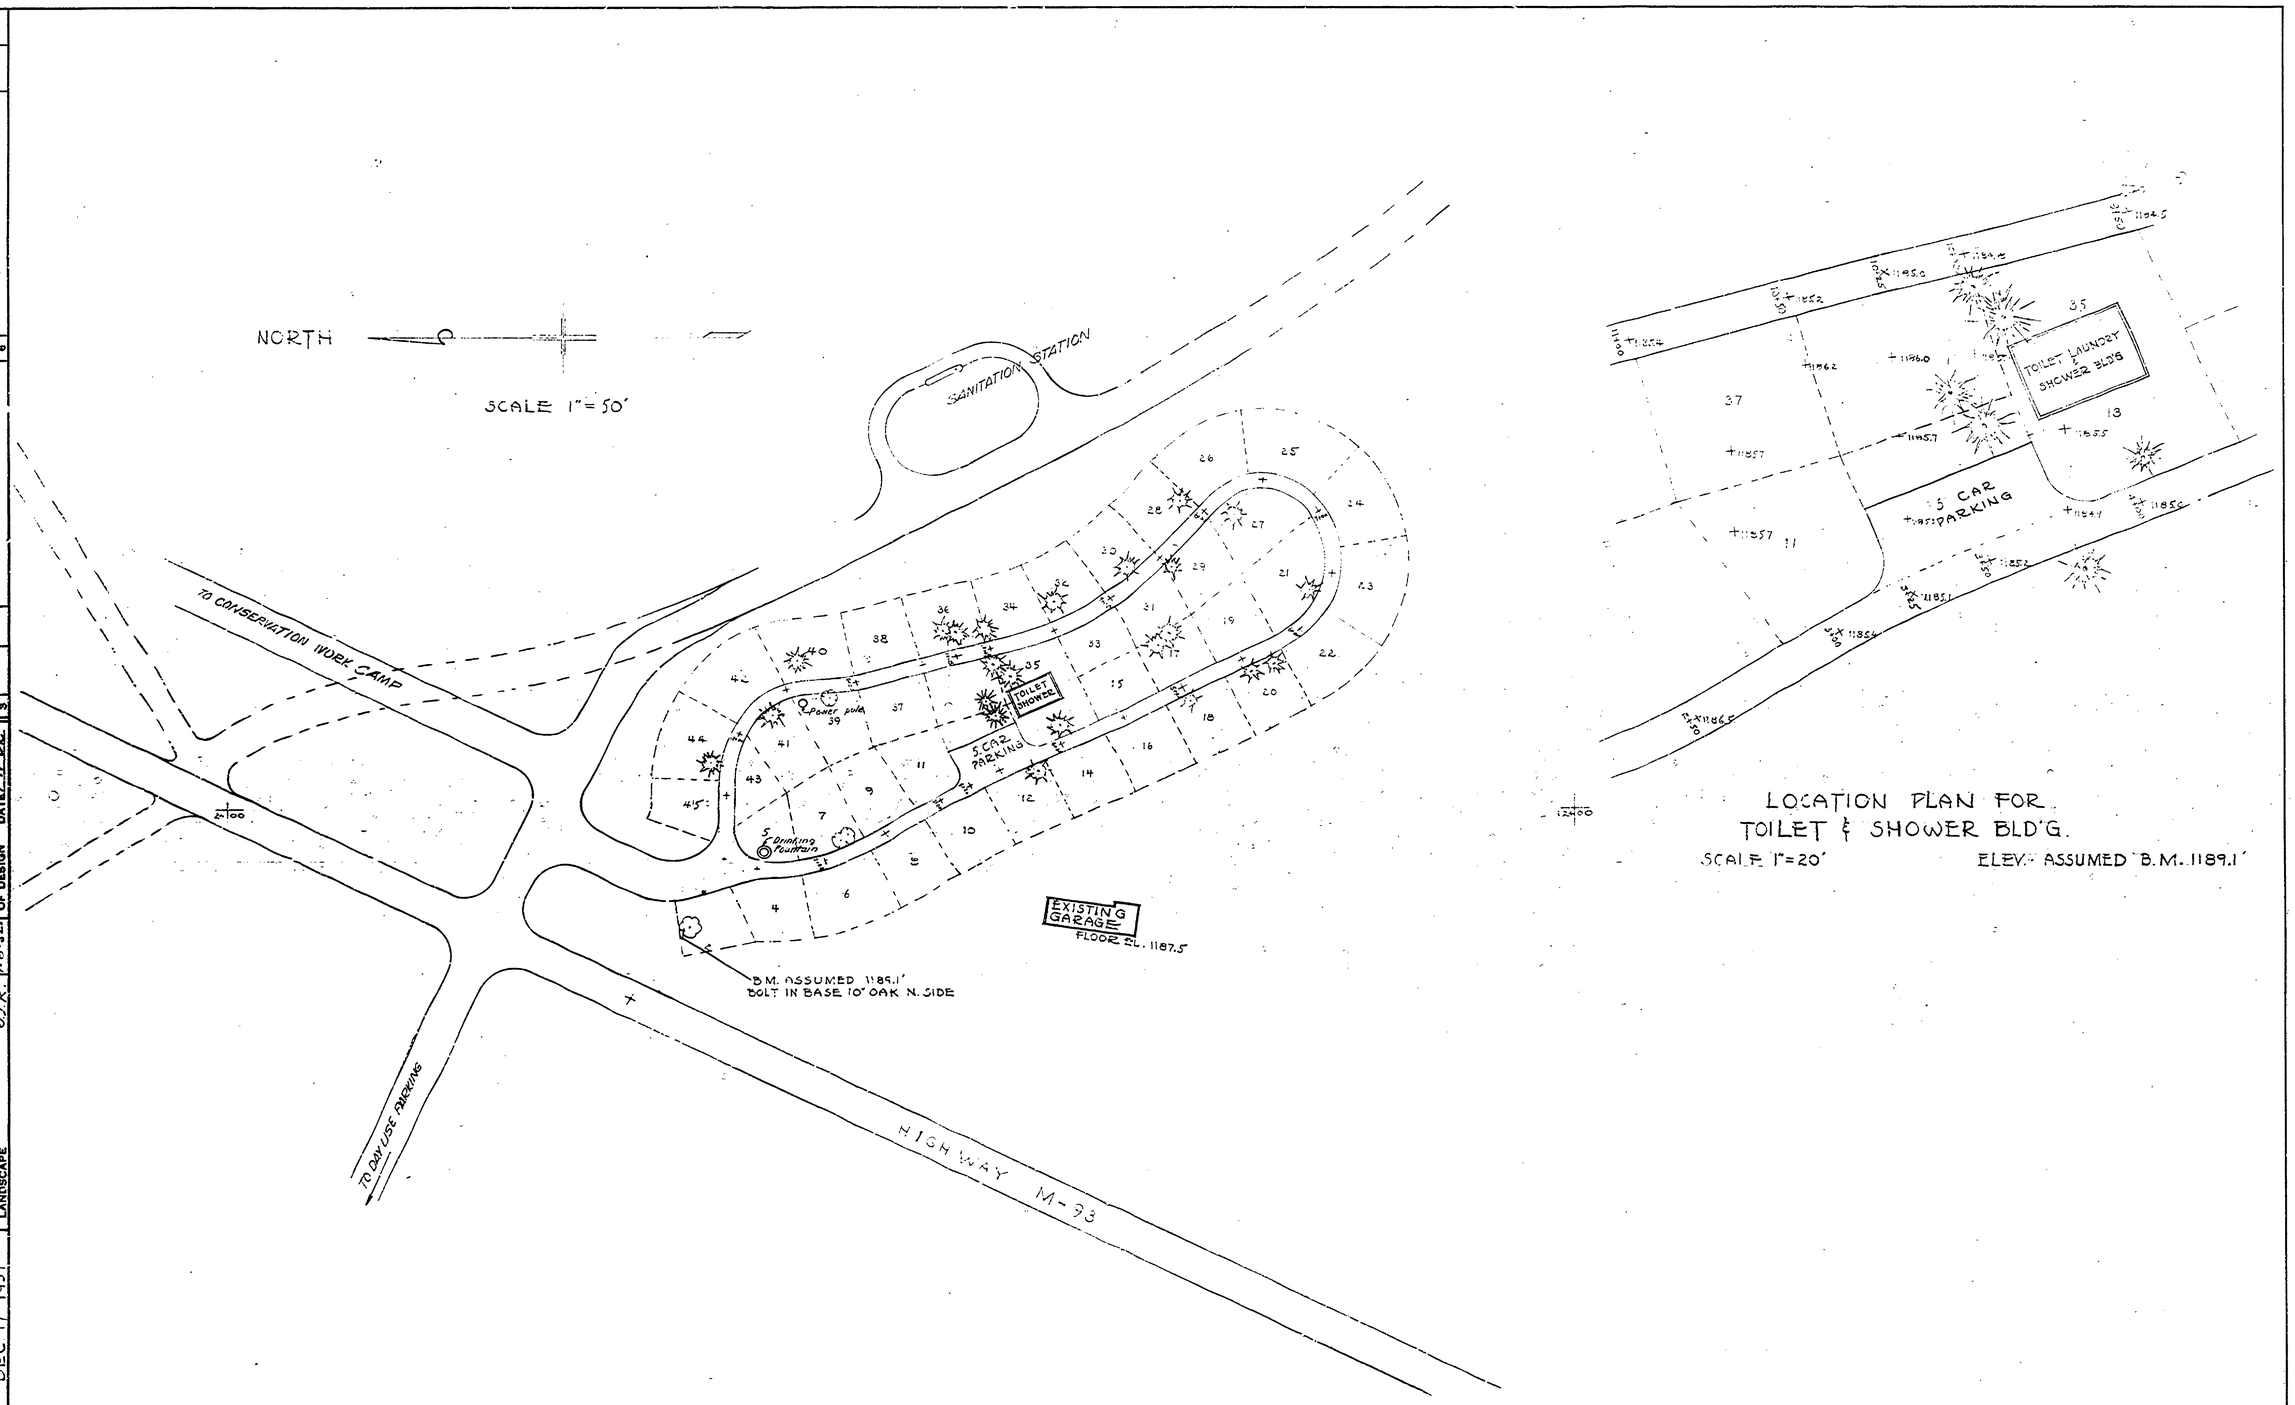

NO.	DATE	BY	REVISIONS	DATE	BY
1	4/15/52	J.L.R.	Ent. Rd. & Bathhouse location altered		
2	8/7/56	G.R.H.	ADD NEW ROAD ALIGNMENT. SAW. 5274		
3					
4					
5					
6					

APPROVED BY: [signature]
ASSISTANT CHIEF IN CHARGE OF DESIGN — DATE 1-17-52

REVIEWED BY SECTIONS		DATE
ARCHITECTURAL	J.I.R.	1-8-52
ENGINEERING	H.C.M.	10 Jan 52
LANDSCAPE	J.I.R.	1-8-52

DRAWN BY	L.E.L.
TRACED BY	
CHECKED BY	
DATE	DEC. 17 1951

MICHIGAN
DEPARTMENT OF CONSERVATION
PARKS AND RECREATION DIVISION

HARTWICK PINES STATE PARK
CAMP GROUND
SCALE: AS NOTED DEC. 1951

SHEET NO. 1 OF 1

PLAN NO. L-105