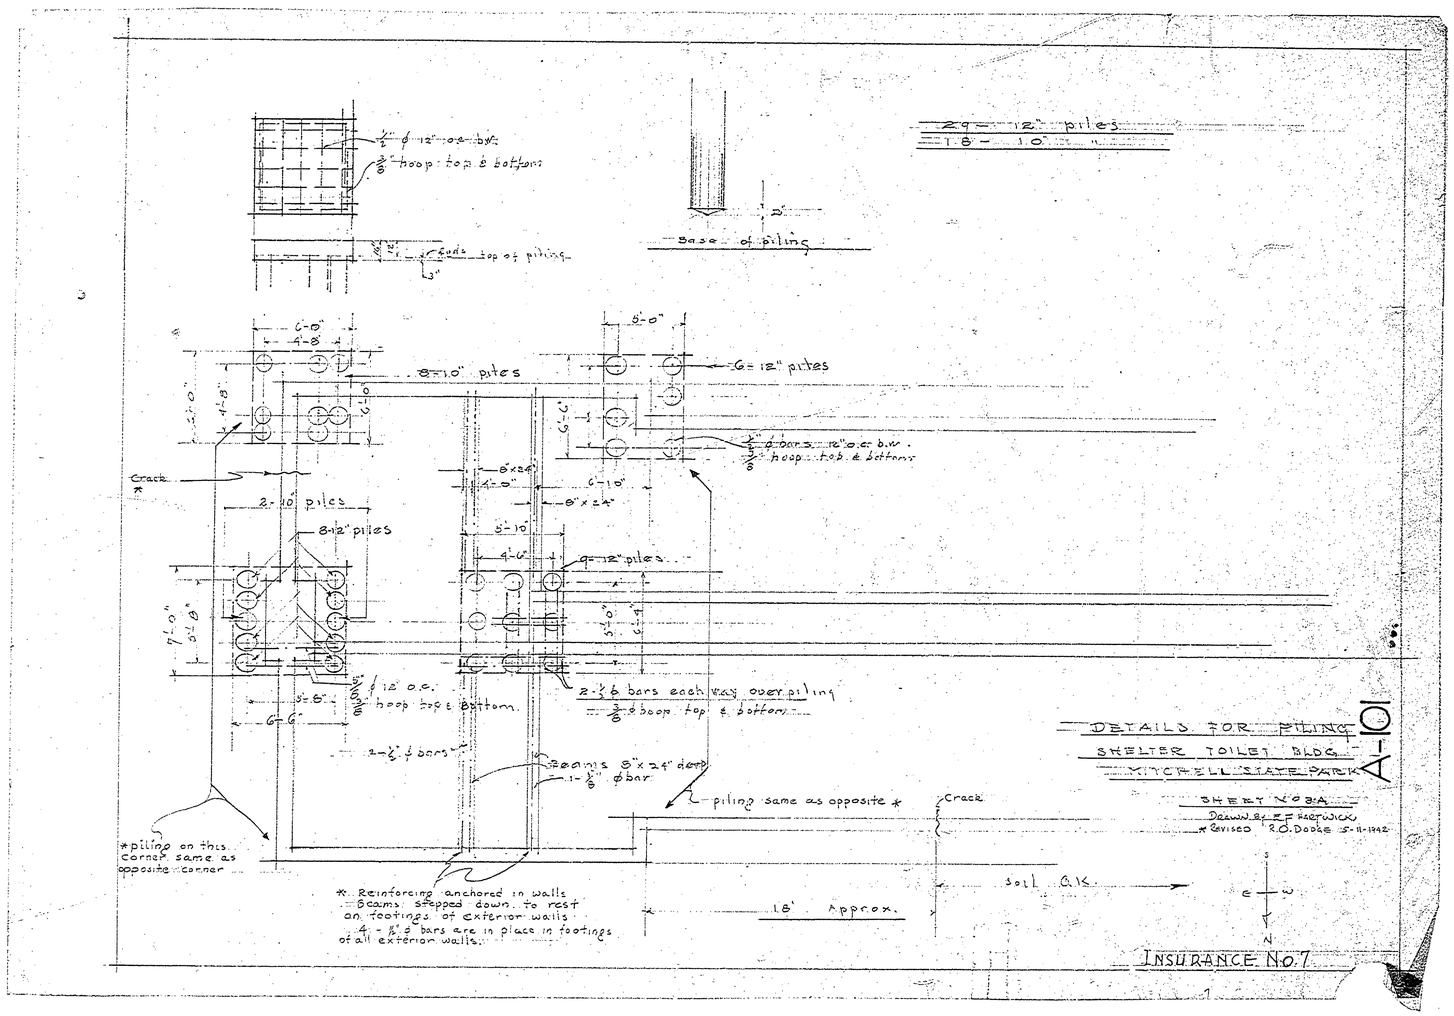
1/2" ϕ 12" o.c. b.w.
3/8" hoop: top & bottom
Cuts top of piling
3"
2"
Base of piling
29 - 12" piles
18 - 10" "
6'-0"
4'-8"
8'-0"
8-10" piles
6-12" piles
1/2" ϕ bars 12" o.c. b.w.
3/8" hoop: top & bottom
Crack
2-10" piles
8-12" piles
8"x24"
4'-0"
6'-10"
8"x24"
5'-10"
4'-6"
9-12" piles
2-1/2" ϕ bars each way over piling
3/8" ϕ hoop top & bottom
3/8" ϕ 12" o.c.
hoop top & bottom
2-1/2" ϕ bars
2 beams 8"x24" deep
1-1/2" ϕ bar
piling same as opposite *
Crack
*piling on this corner same as opposite corner
*. Reinforcing anchored in walls
Beams stepped down to rest
on footings of exterior walls
4 - 1/2" ϕ bars are in place in footings
of all exterior walls.
18' Approx.
Soil OK
E
W
N
DETAILS FOR PILING
SHELTER TOILET BLDG.
MITCHELL STATE PARK
A-101
SHEET No 3-A
DRAWN BY E.F. HARTWICK
* REVISED R.O. DOOLE 5-11-1942
INSURANCE No. 7