


DRAWN BY	K.M.B.	REVIEWED BY SECTIONS	DATE	APPROVED BY	NO. DATE BY	REVISIONS
TRACED BY	K.M.B.	ARCHITECTURAL	J.P.R.	3-21-57	1	4
CHECKED BY	K.M.B.	ENGINEERING	J.P.R.	3-21-57	2	5
DATE	MARCH 1957	LANDSCAPE	J.P.R.	3-21-57	3	6

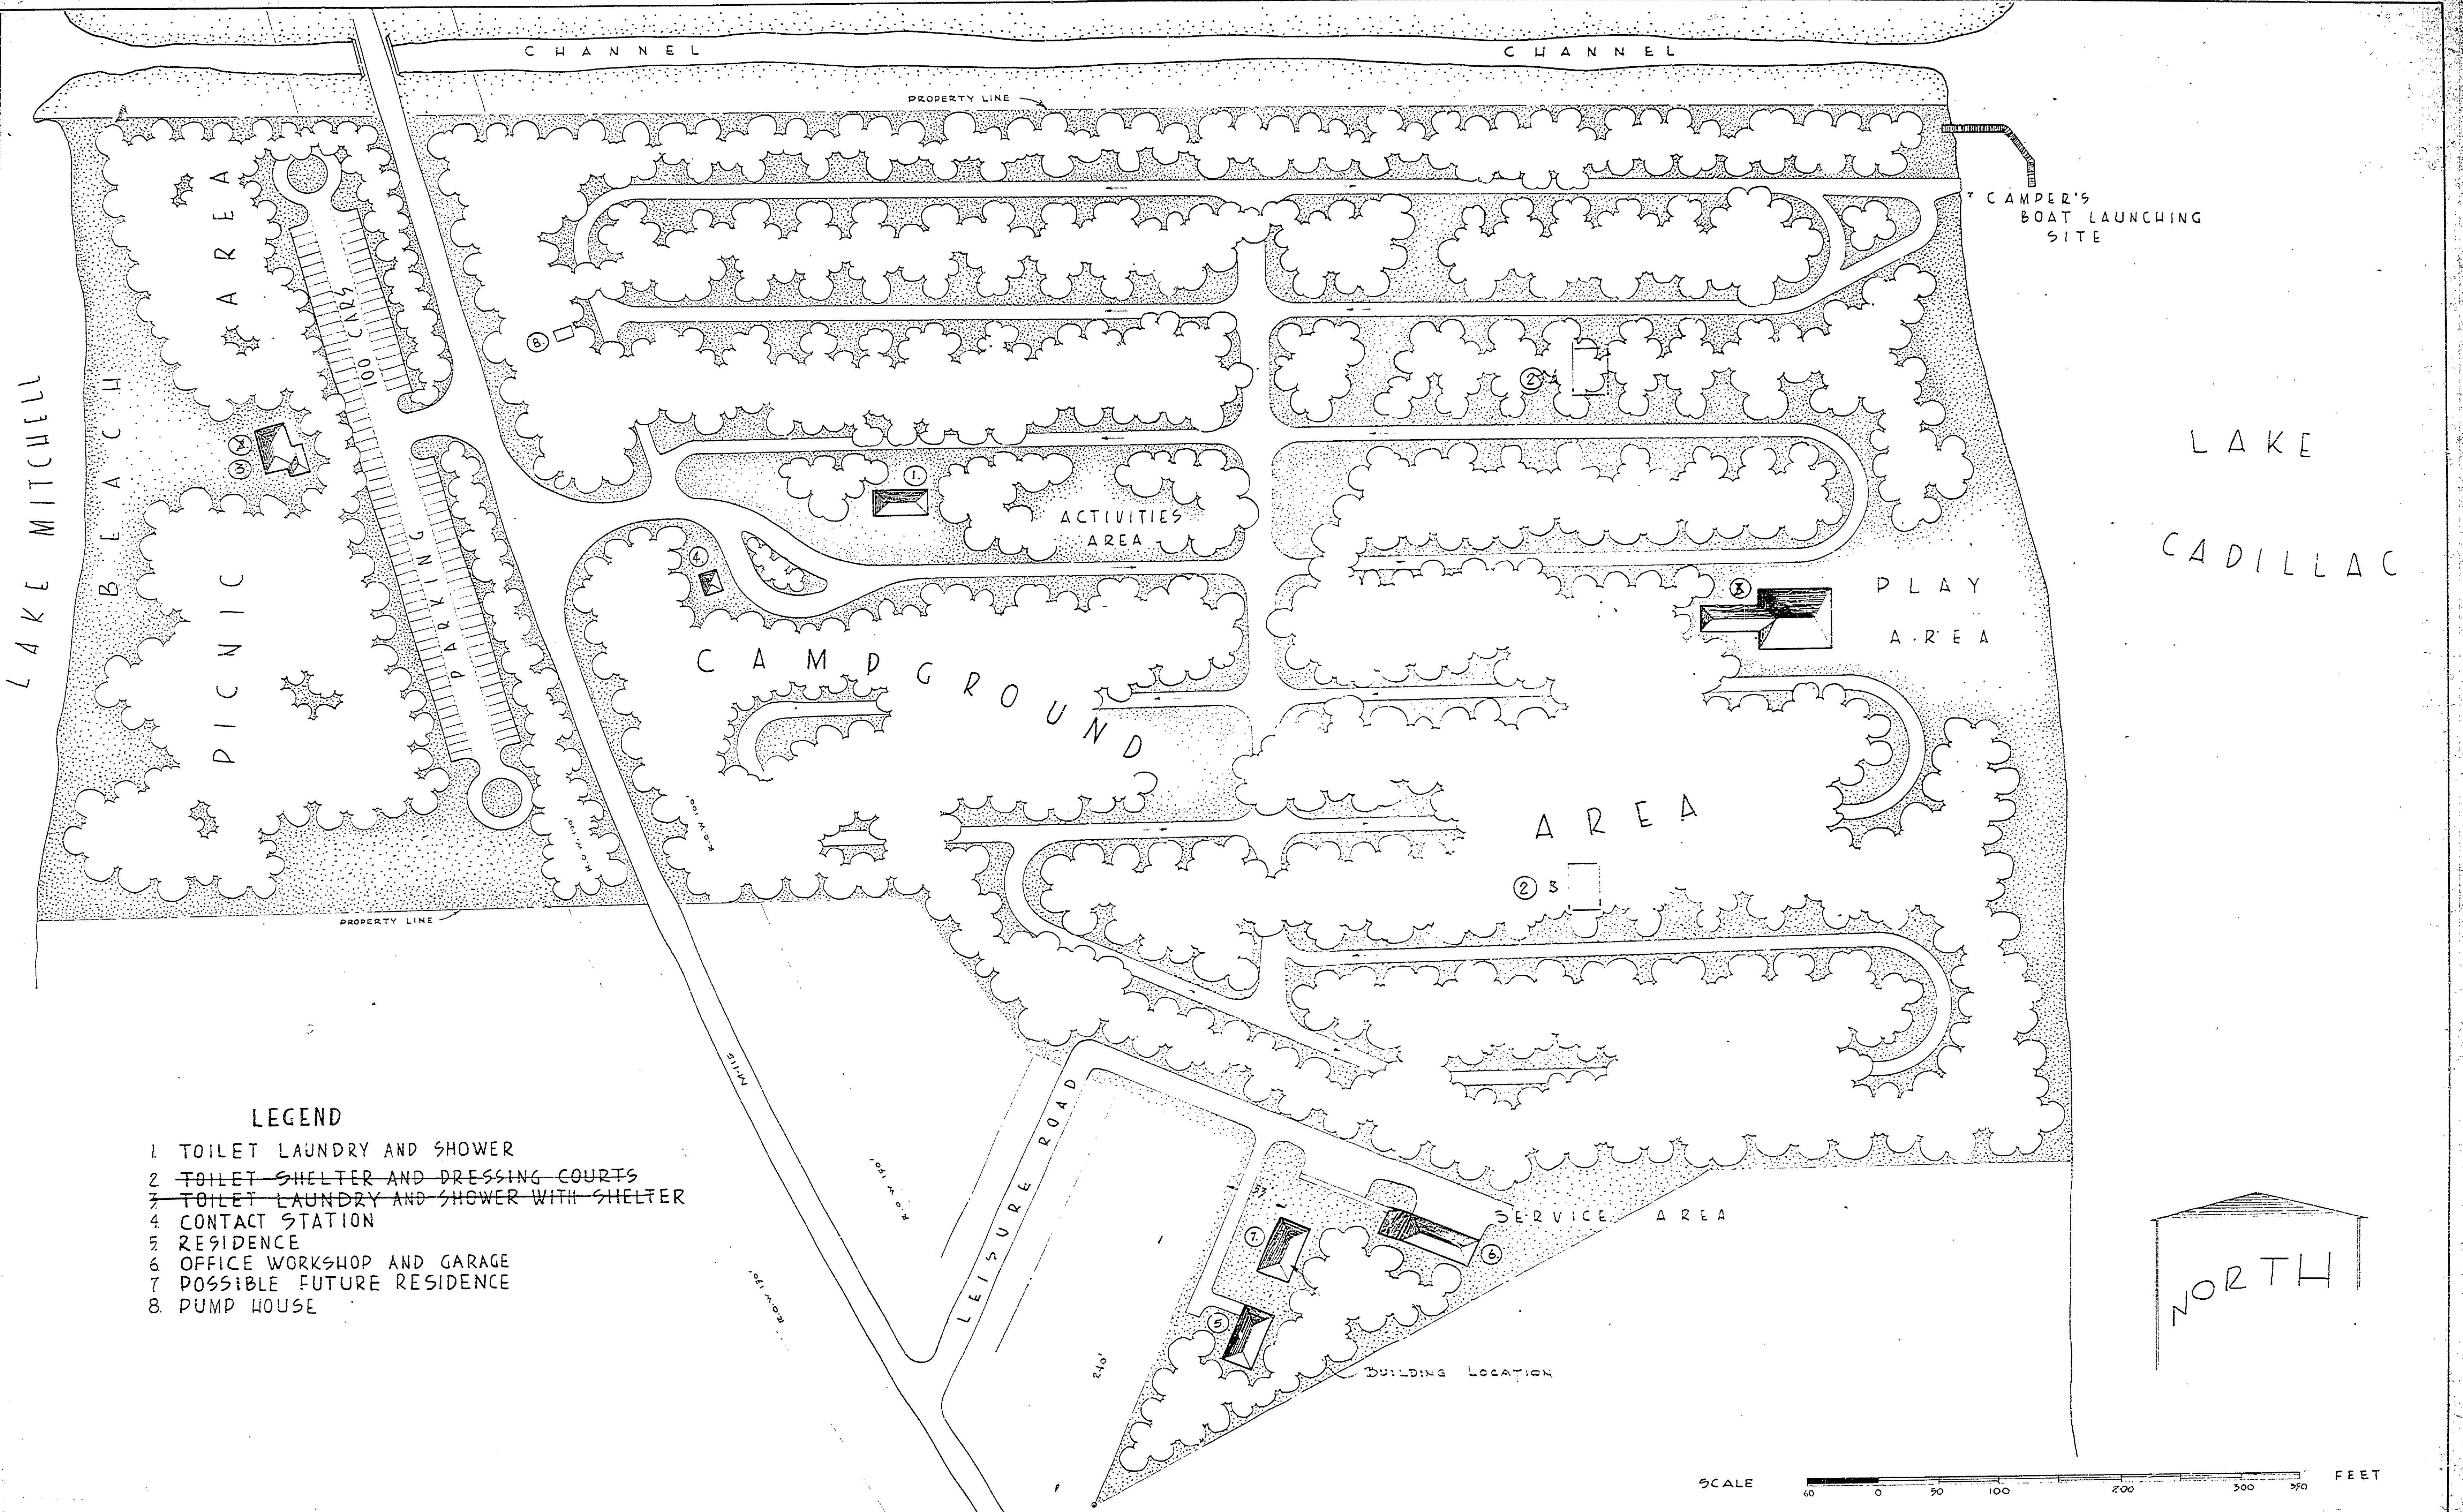

- LEGEND**
- 1 TOILET LAUNDRY AND SHOWER
 - 2 TOILET SHELTER AND DRESSING COURTS
 - 3 TOILET LAUNDRY AND SHOWER WITH SHELTER
 - 4 CONTACT STATION
 - 5 RESIDENCE
 - 6 OFFICE WORKSHOP AND GARAGE
 - 7 POSSIBLE FUTURE RESIDENCE
 - 8 PUMP HOUSE