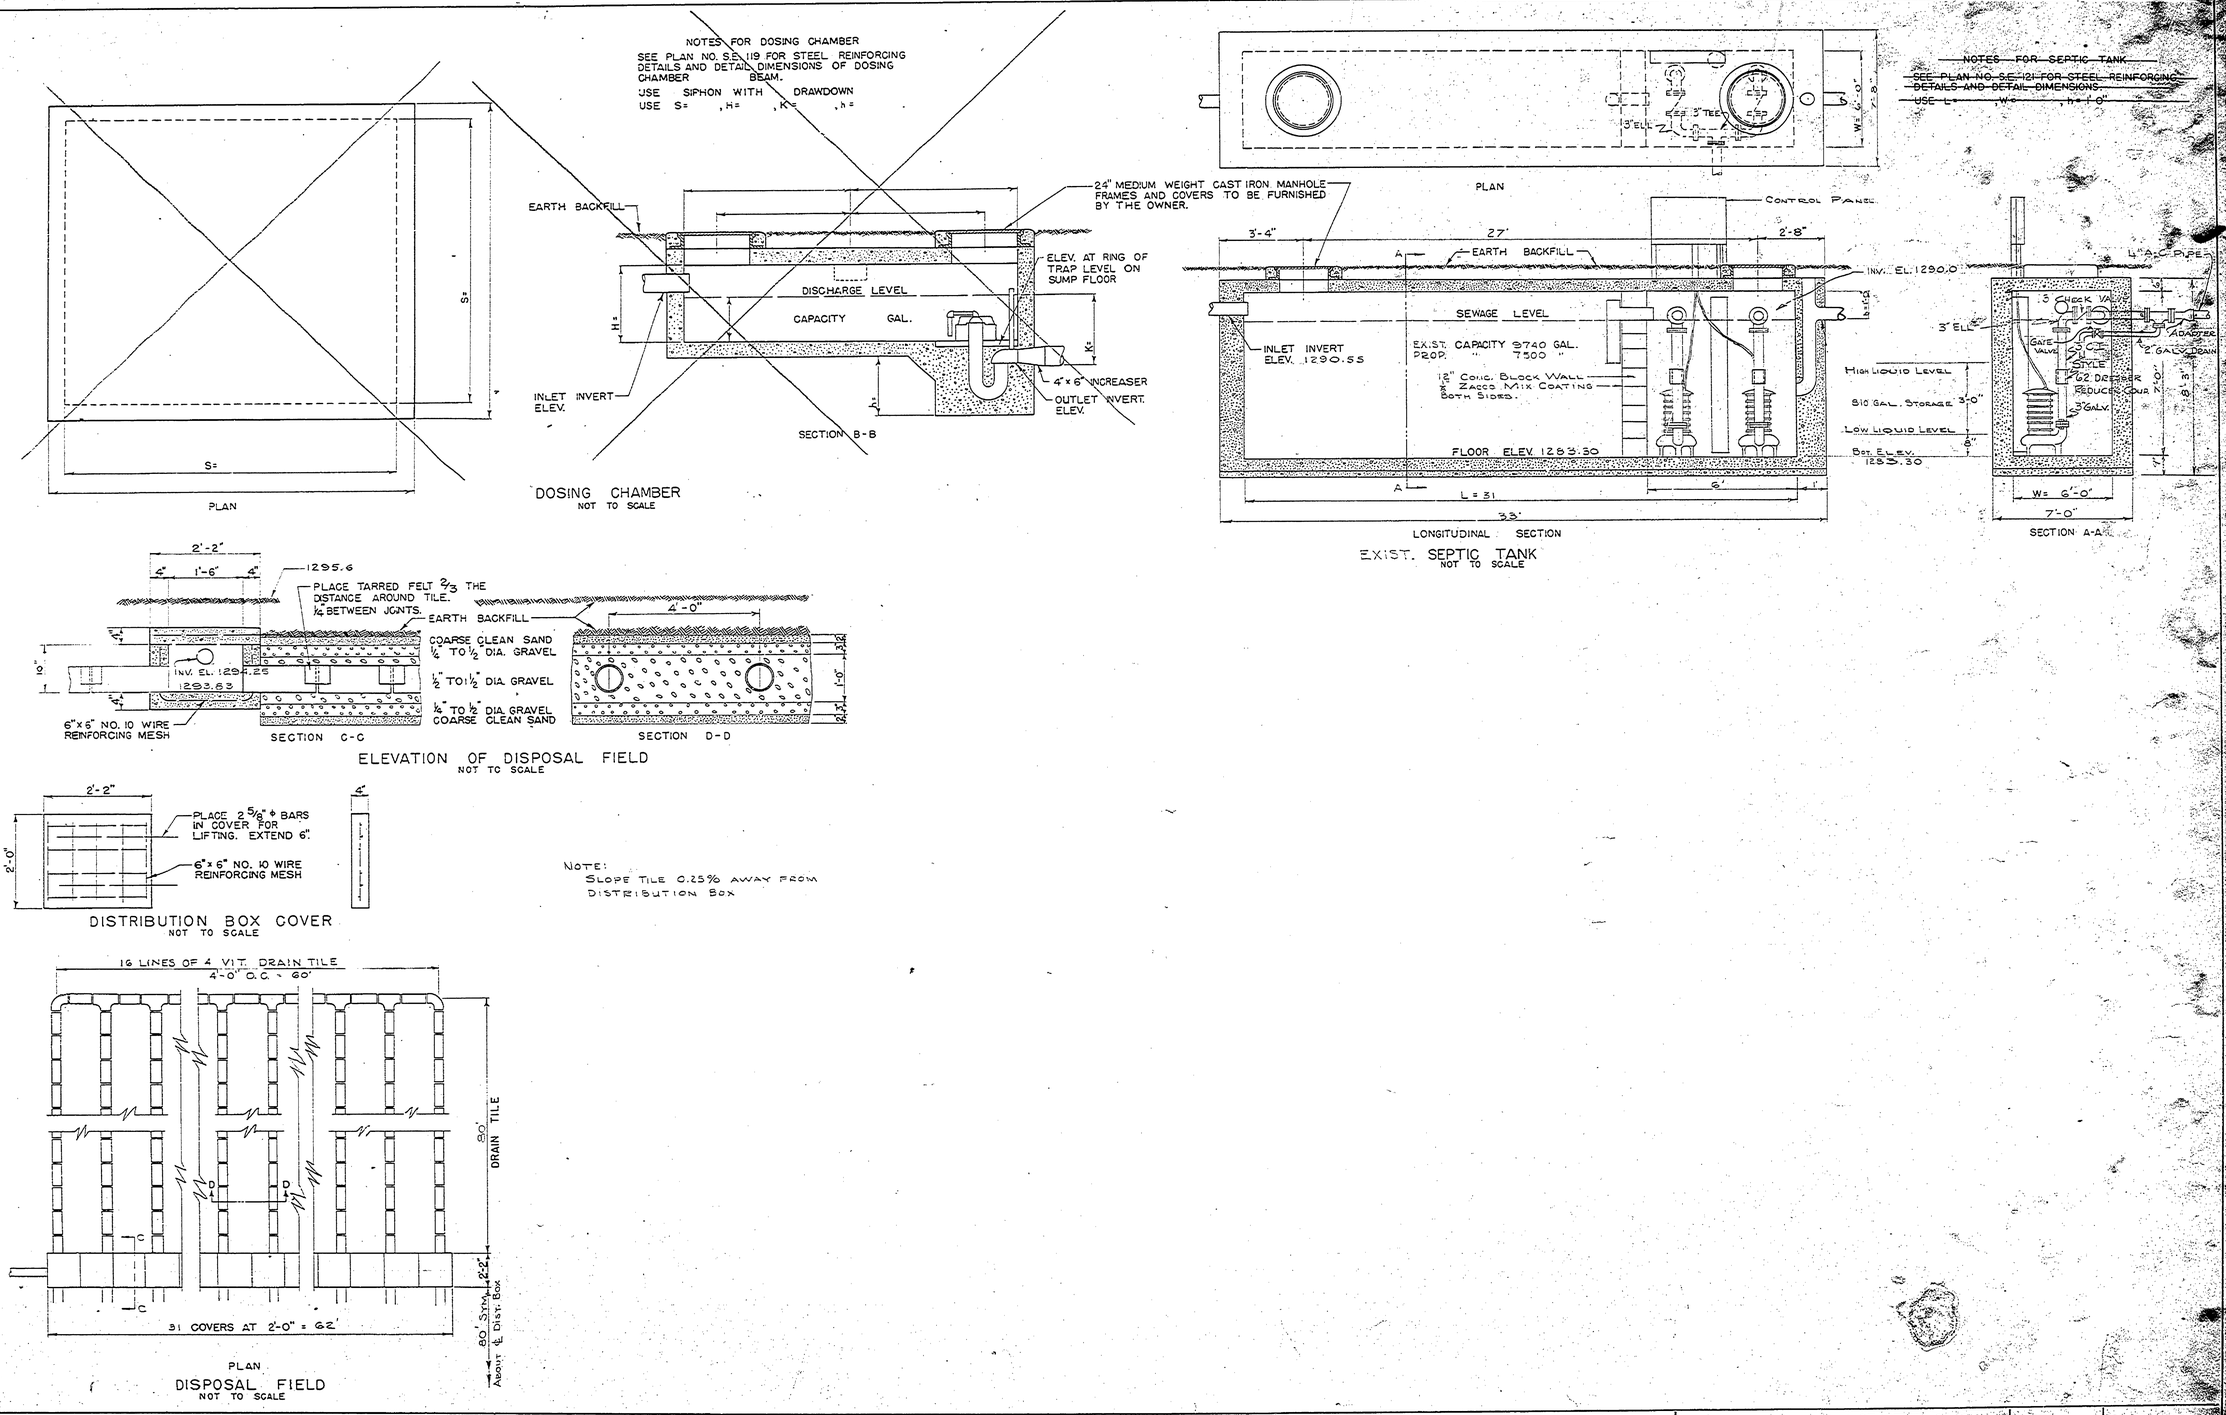

NO.	DATE	BY	REVISIONS	DATE	BY
1			4		
2			5		
3			6		

DRAWN BY J.Y. 9-65	REVIEWED BY SECTIONS	DATE	APPROVED BY
TRACED BY	ARCHITECTURAL		ASSISTANT CHIEF IN CHARGE OF DESIGN DATE
CHECKED BY Reckell 9-65	ENGINEERING		
DATE	LANDSCAPE		

APPROVED — CHIEF OF DIVISION — DATE — APPROVED — CHIEF OF PLANNING AND CONSTRUCTION — DATE

MICHIGAN
DEPARTMENT OF CONSERVATION
PARKS AND RECREATION DIVISION

MITCHELL STATE PARK
LIFT STATION AND TILE FIELD
FOR BUILDINGS 2A AND 2B

SHEET NO. 3 OF 4

PLAN NO. E-107