


McLAIN STATE PARK - Contact Station Circulation Plan

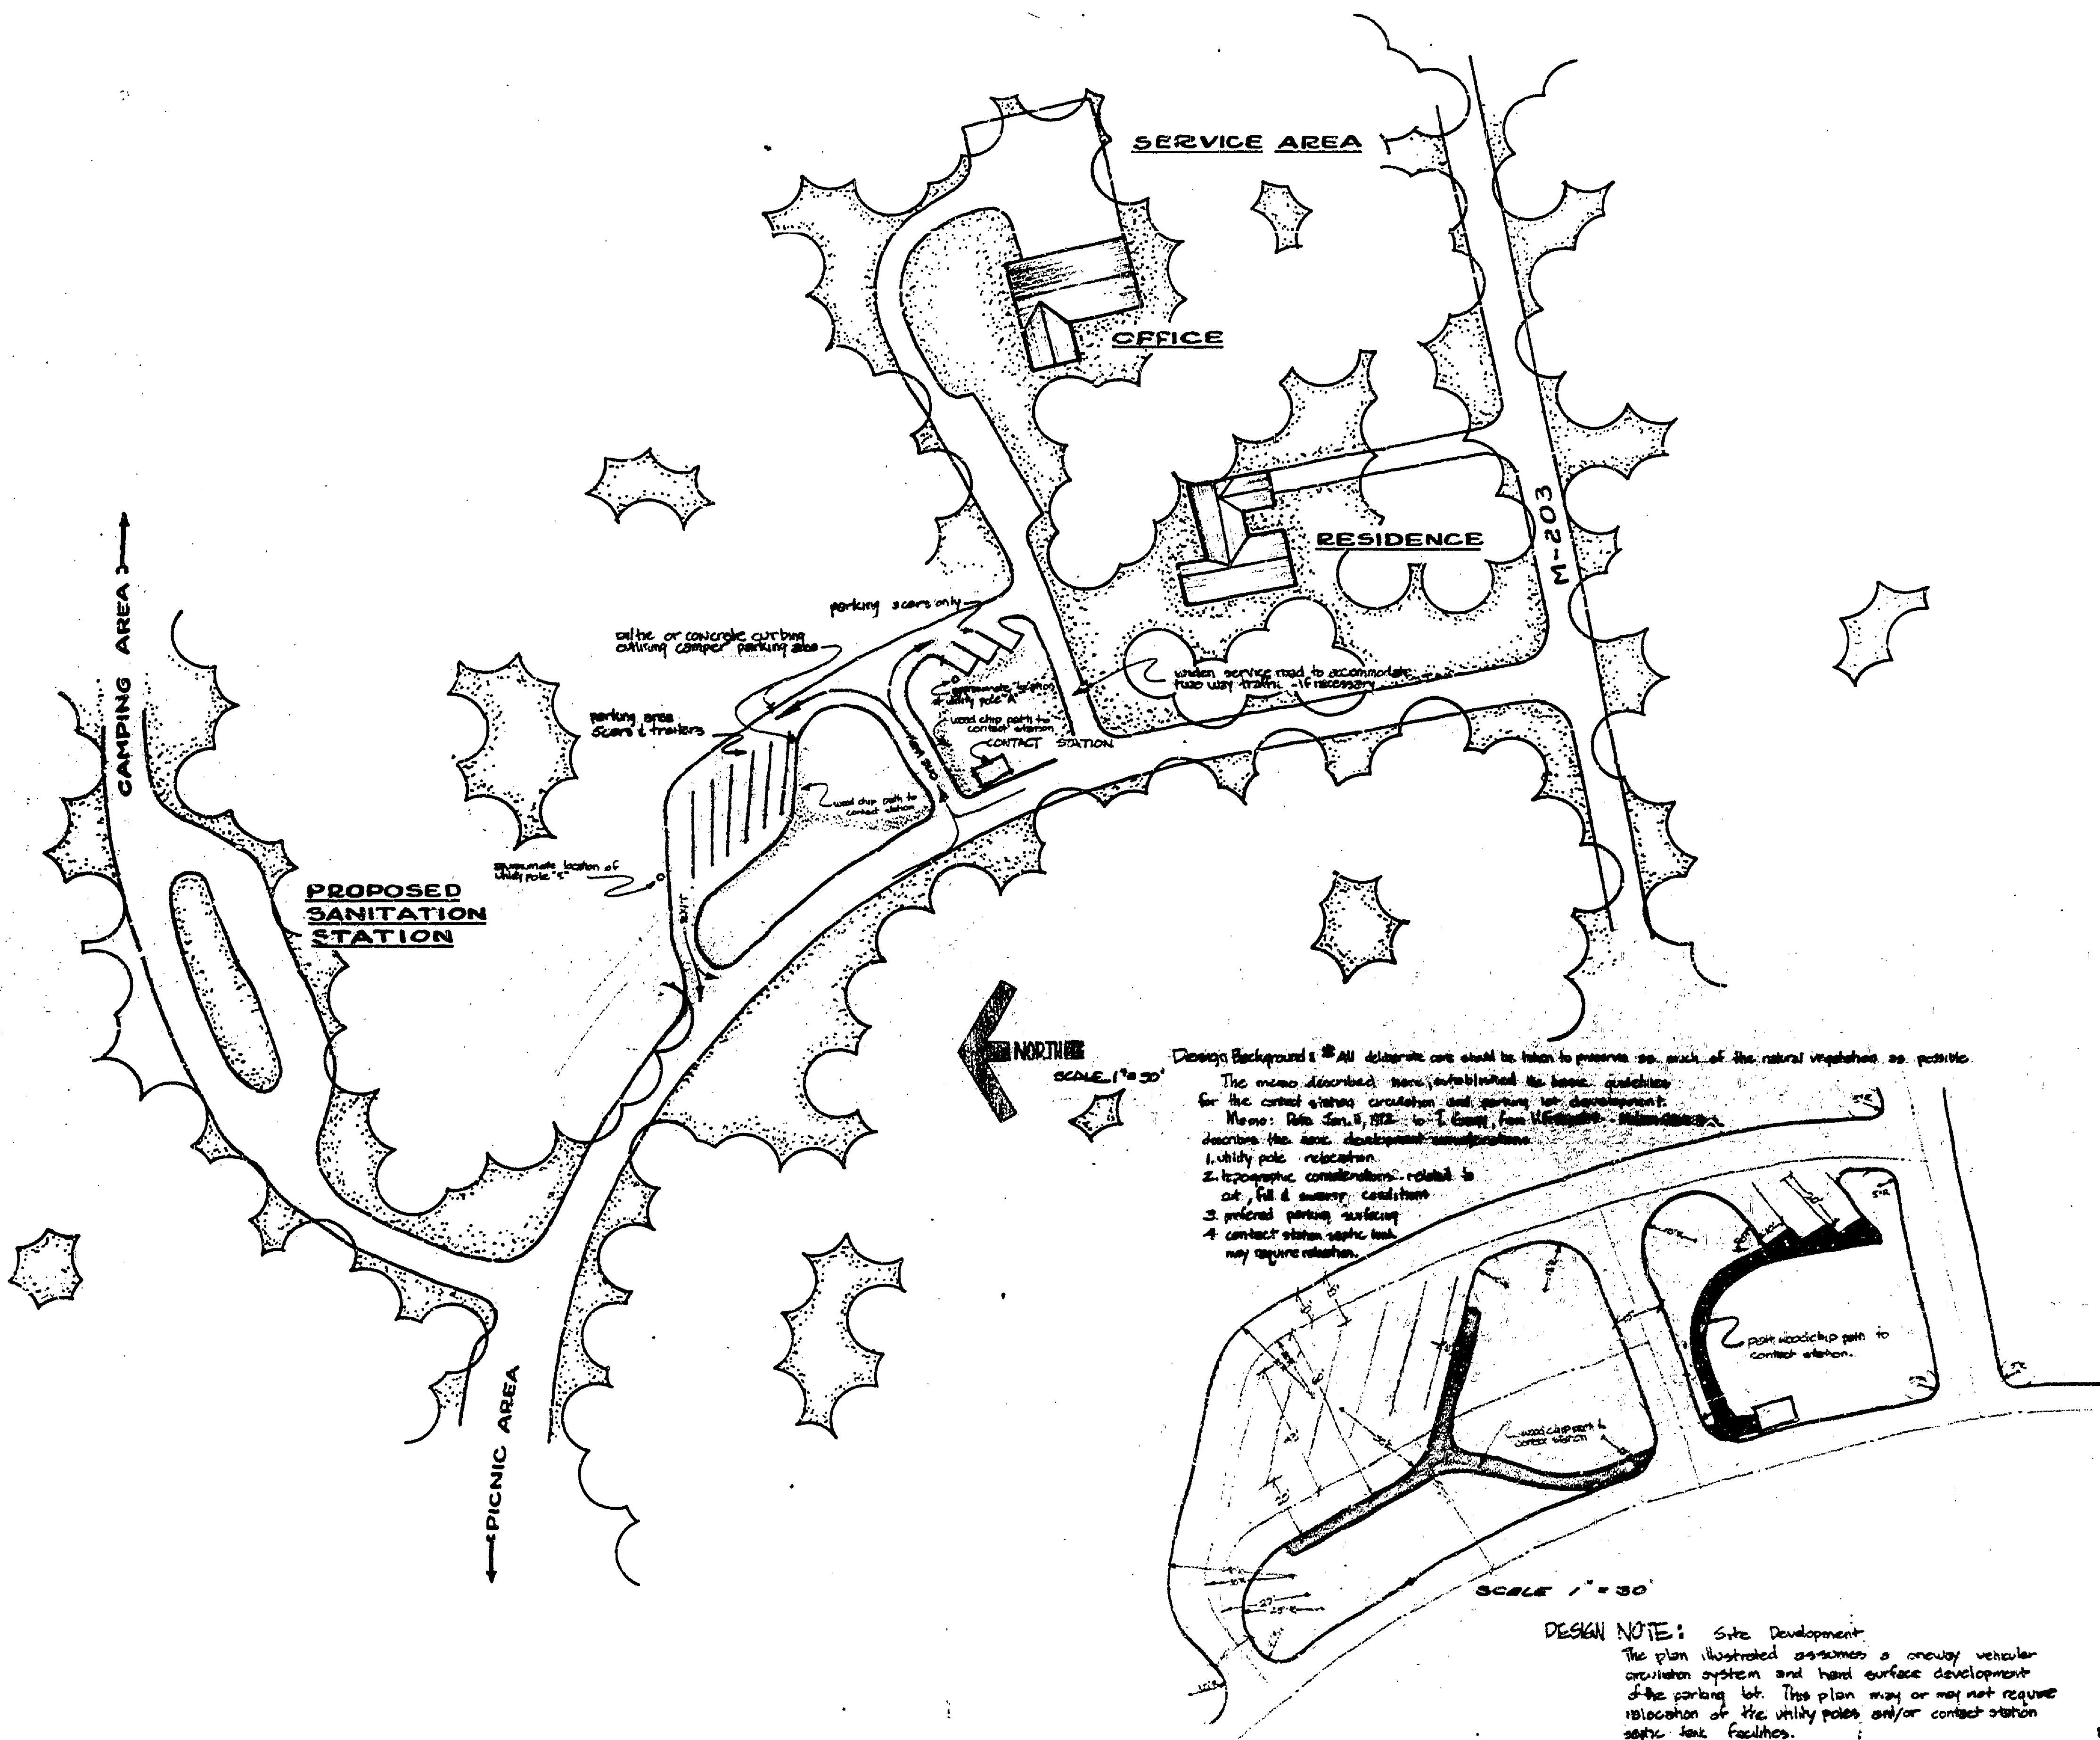

Design Background: All designs are to be taken to preserve as much of the natural vegetation as possible. The areas described here, established as basic guidelines for the contact station circulation and parking lot development. Memo: Date Jan. 11, 1972 to J. Gray from W. H. ...

Describe the site development:

1. utility pole relocation
2. topographic considerations related to site, fill & survey conditions
3. proposed parking surface
4. contact station septic tank may require relocation

NORTH
SCALE 1" = 30'

SCALE 1" = 30'

DESIGN NOTE: Site Development
The plan illustrated assumes a one-way vehicular circulation system and hard surface development of the parking lot. This plan may or may not require relocation of the utility poles and/or contact station septic tank facilities.
The parking lot centerline parallels the park entrance road alignment. The dimensions shown are approximate & should be adjusted to better match the site conditions.

REVISED PLAN - APPROVED:

James H. Hame 5-18-72
PARKS AND RECREATION SECTION

[Signature] 5-19-72
PARKS AND RECREATION SECTION

APPROVED BY:
PARKS AND RECREATION SECTION

[Signature] *[Signature]*
CHIEF DATE

DESIGNED BY	CHECKED BY	DATE	NO.	DATE	BY	REVISIONS	NO.	DATE	BY	REVISIONS
	L. M. C.	7/65	1.	6-30-64	L.C.M.	CHANGE SANITATION STATION	3.			
			2.	5-27-72	J.H.	CONTACT STATION WORKING PLAN	4.			

MICHIGAN
DEPARTMENT OF CONSERVATION

**PROPOSED ENTRANCE
& SANITATION STATIONS**

SHEET NO. _____ OF _____
FOR PROJECT NO. _____

McLAIN STATE PARK
SHEET 1 OF 1 PLAN NO. L-103