


CANAL AND BEAR LAKE DISTRICT
 T56N OF R34W
 SHOWING STATE PARK

BOARD OF COUNTY ROAD COMMISSIONERS
 HOUGHTON COUNTY — T A COON-ENG'G

SCALE — 1 500

NOV 1930

LEGEND
 Proposed Main Canal
 Proposed Branch
 Proposed Side Canal
 Park Boundary

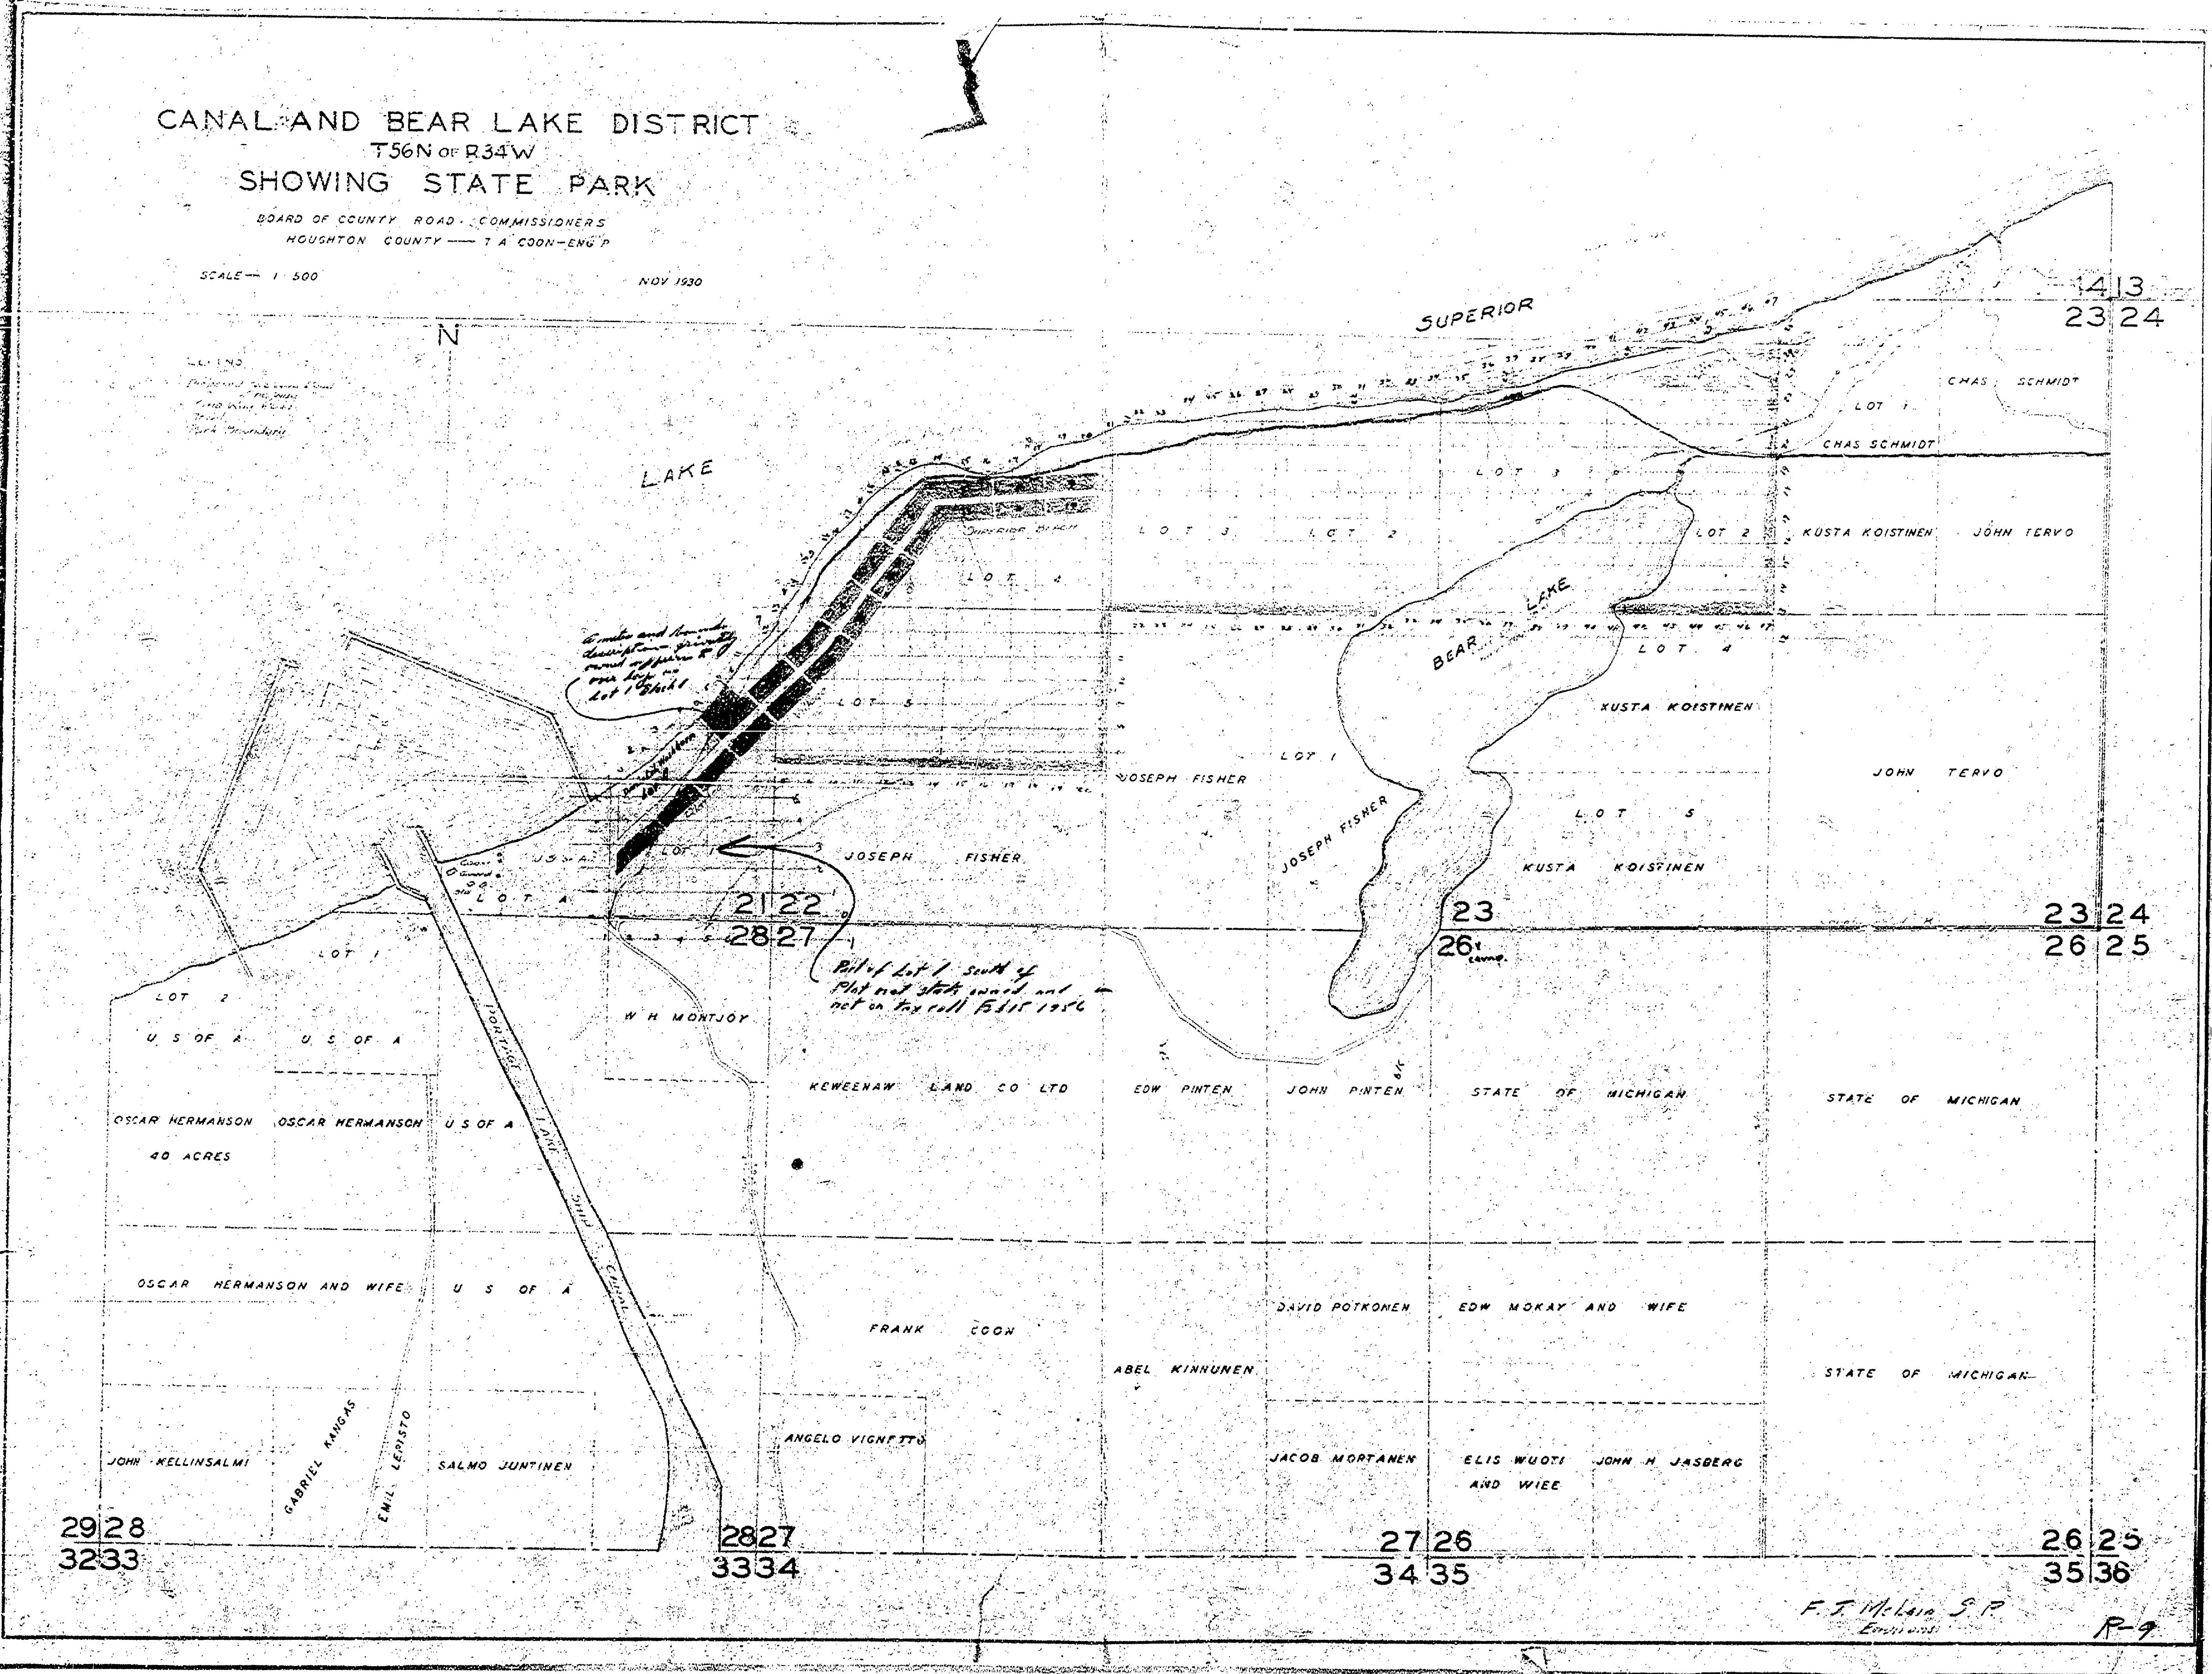

F. J. McLean S.P.
 Engineer
 R-9