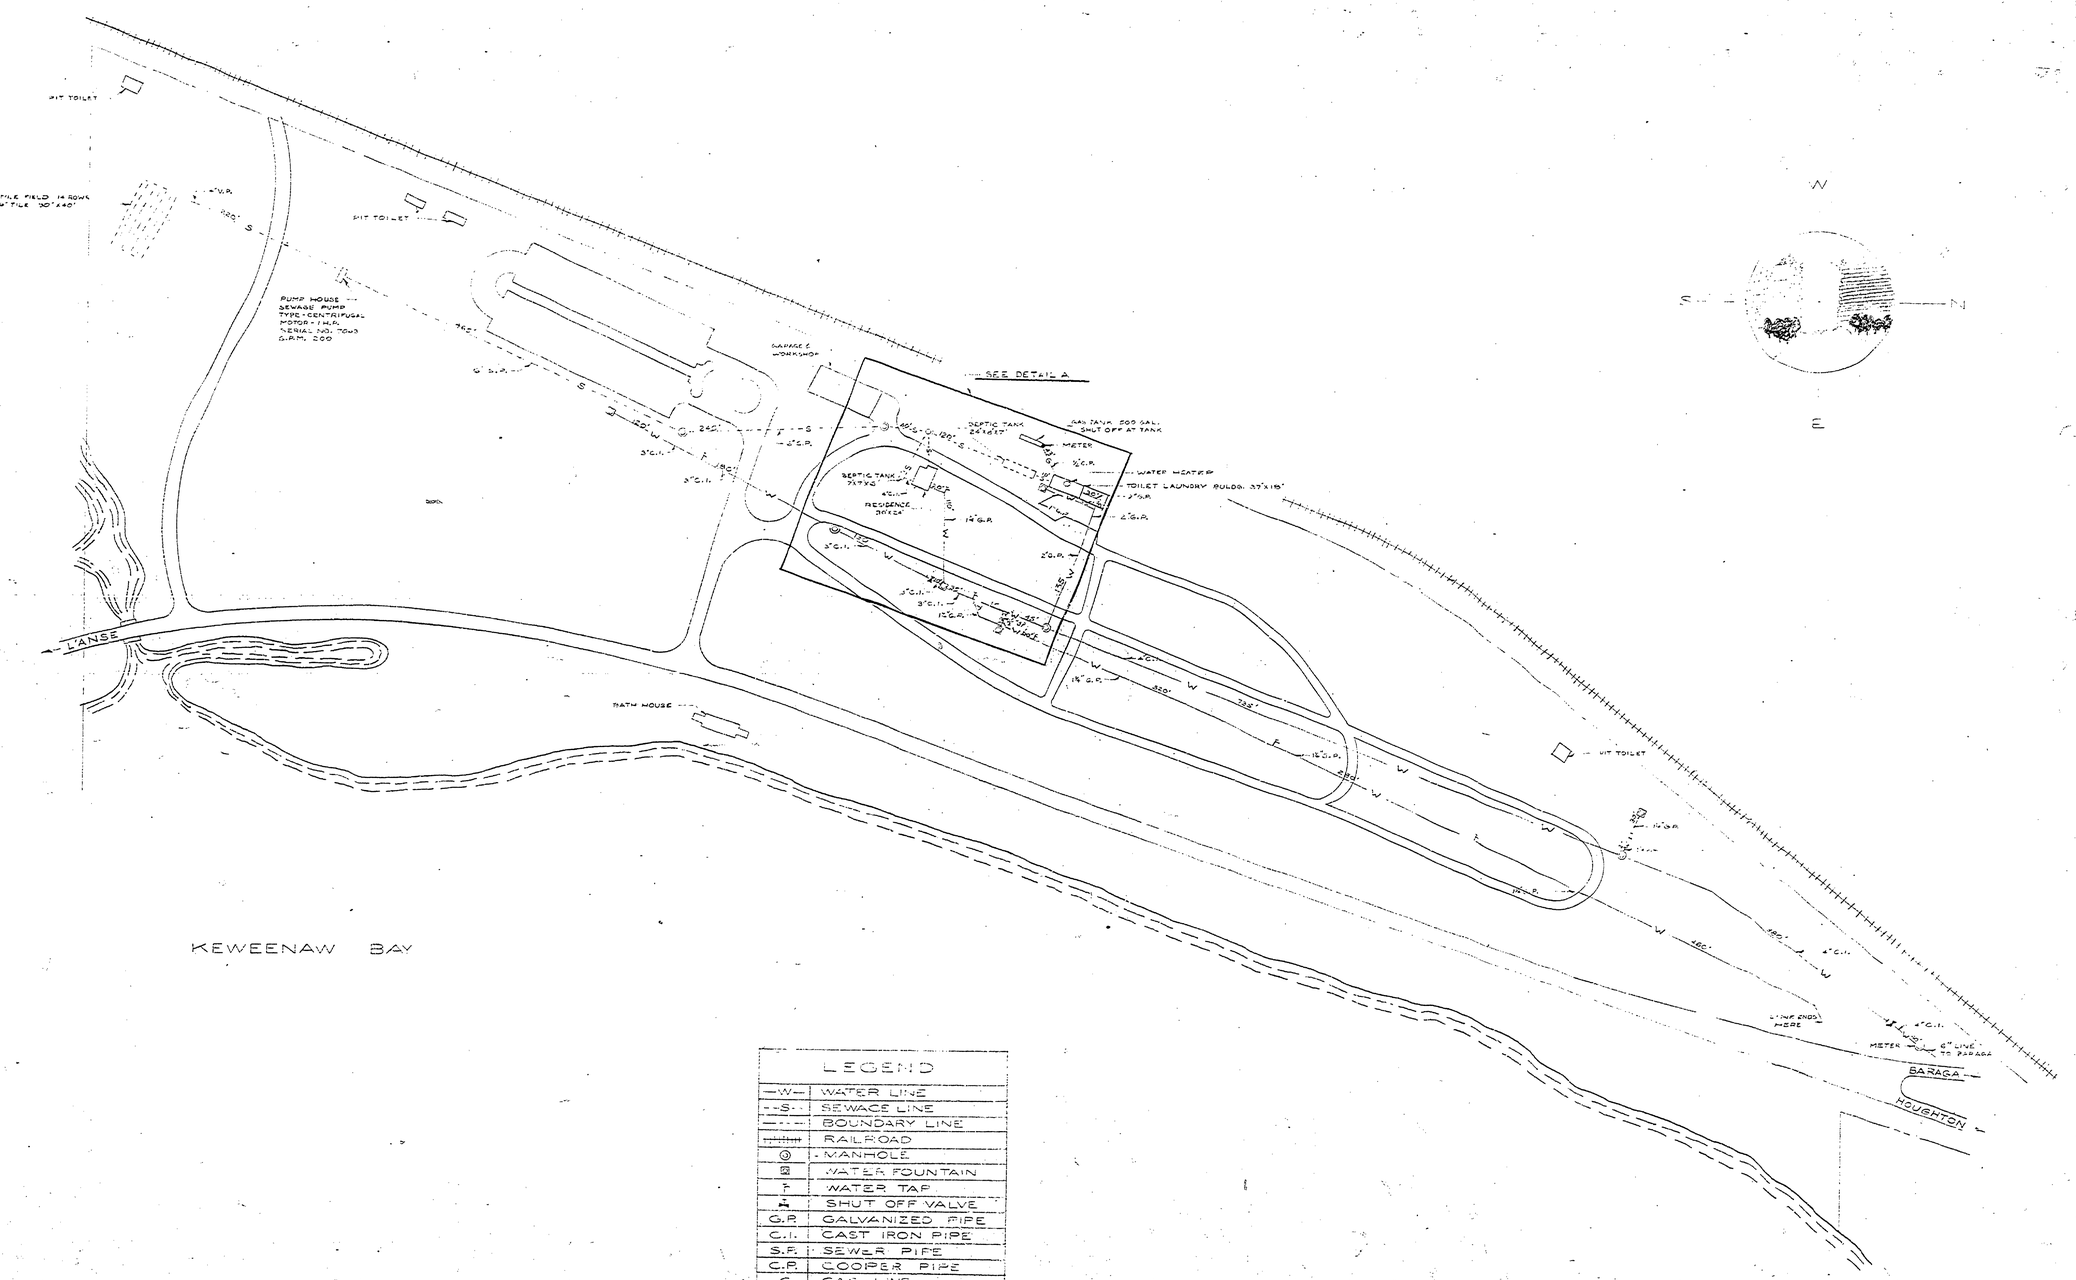

LEGEND	
—W—	WATER LINE
--S--	SEWAGE LINE
—·—·—	BOUNDARY LINE
	RAILROAD
◎	MANHOLE
	WATER FOUNTAIN
T	WATER TAP
	SHUT OFF VALVE
G.P.	GALVANIZED PIPE
C.I.	CAST IRON PIPE
S.P.	SEWER PIPE
C.P.	COOPER PIPE
G	GAS LINE

REVISIONS			
4			
5			
6			

NO.	DATE	BY
1		
2		
3		

REVIEWED BY SECTIONS		DATE
ARCHITECTURAL	J.T.R.	3-24-60
ENGINEERING	J.T.R.	3-24-60
LANDSCAPE	J.T.R.	3-24-60

APPROVED BY
ASSISTANT CHIEF IN CHARGE OF DESIGN DATE 3 APR 1960

DRAWN BY R.W. Beck
TRACED BY
CHECKED BY
DATE 12-30-59

BARAGA STATE PARK

SCALE 1" = 80'

MICHIGAN
DEPARTMENT OF CONSERVATION
PARKS AND RECREATION DIVISION

BARAGA STATE PARK
UTILITY MAP
WATER & SEWAGE

SHEET NO. 2 OF 3

PLAN NO. U-1