


DRAWN BY	R.W. Beck	REVIEWED BY SECTIONS	APPROVED BY	DATE	NO.	DATE	BY
TRACED BY		ARCHITECTURAL	J.I.P.	3-24-66	1		
CHECKED BY		ENGINEERING	J.I.P.	3-24-66	2		
DATE	12-30-59	LANDSCAPE	J.I.P.	3-24-66	3		
					4		
					5		
					6		

# DETAIL A

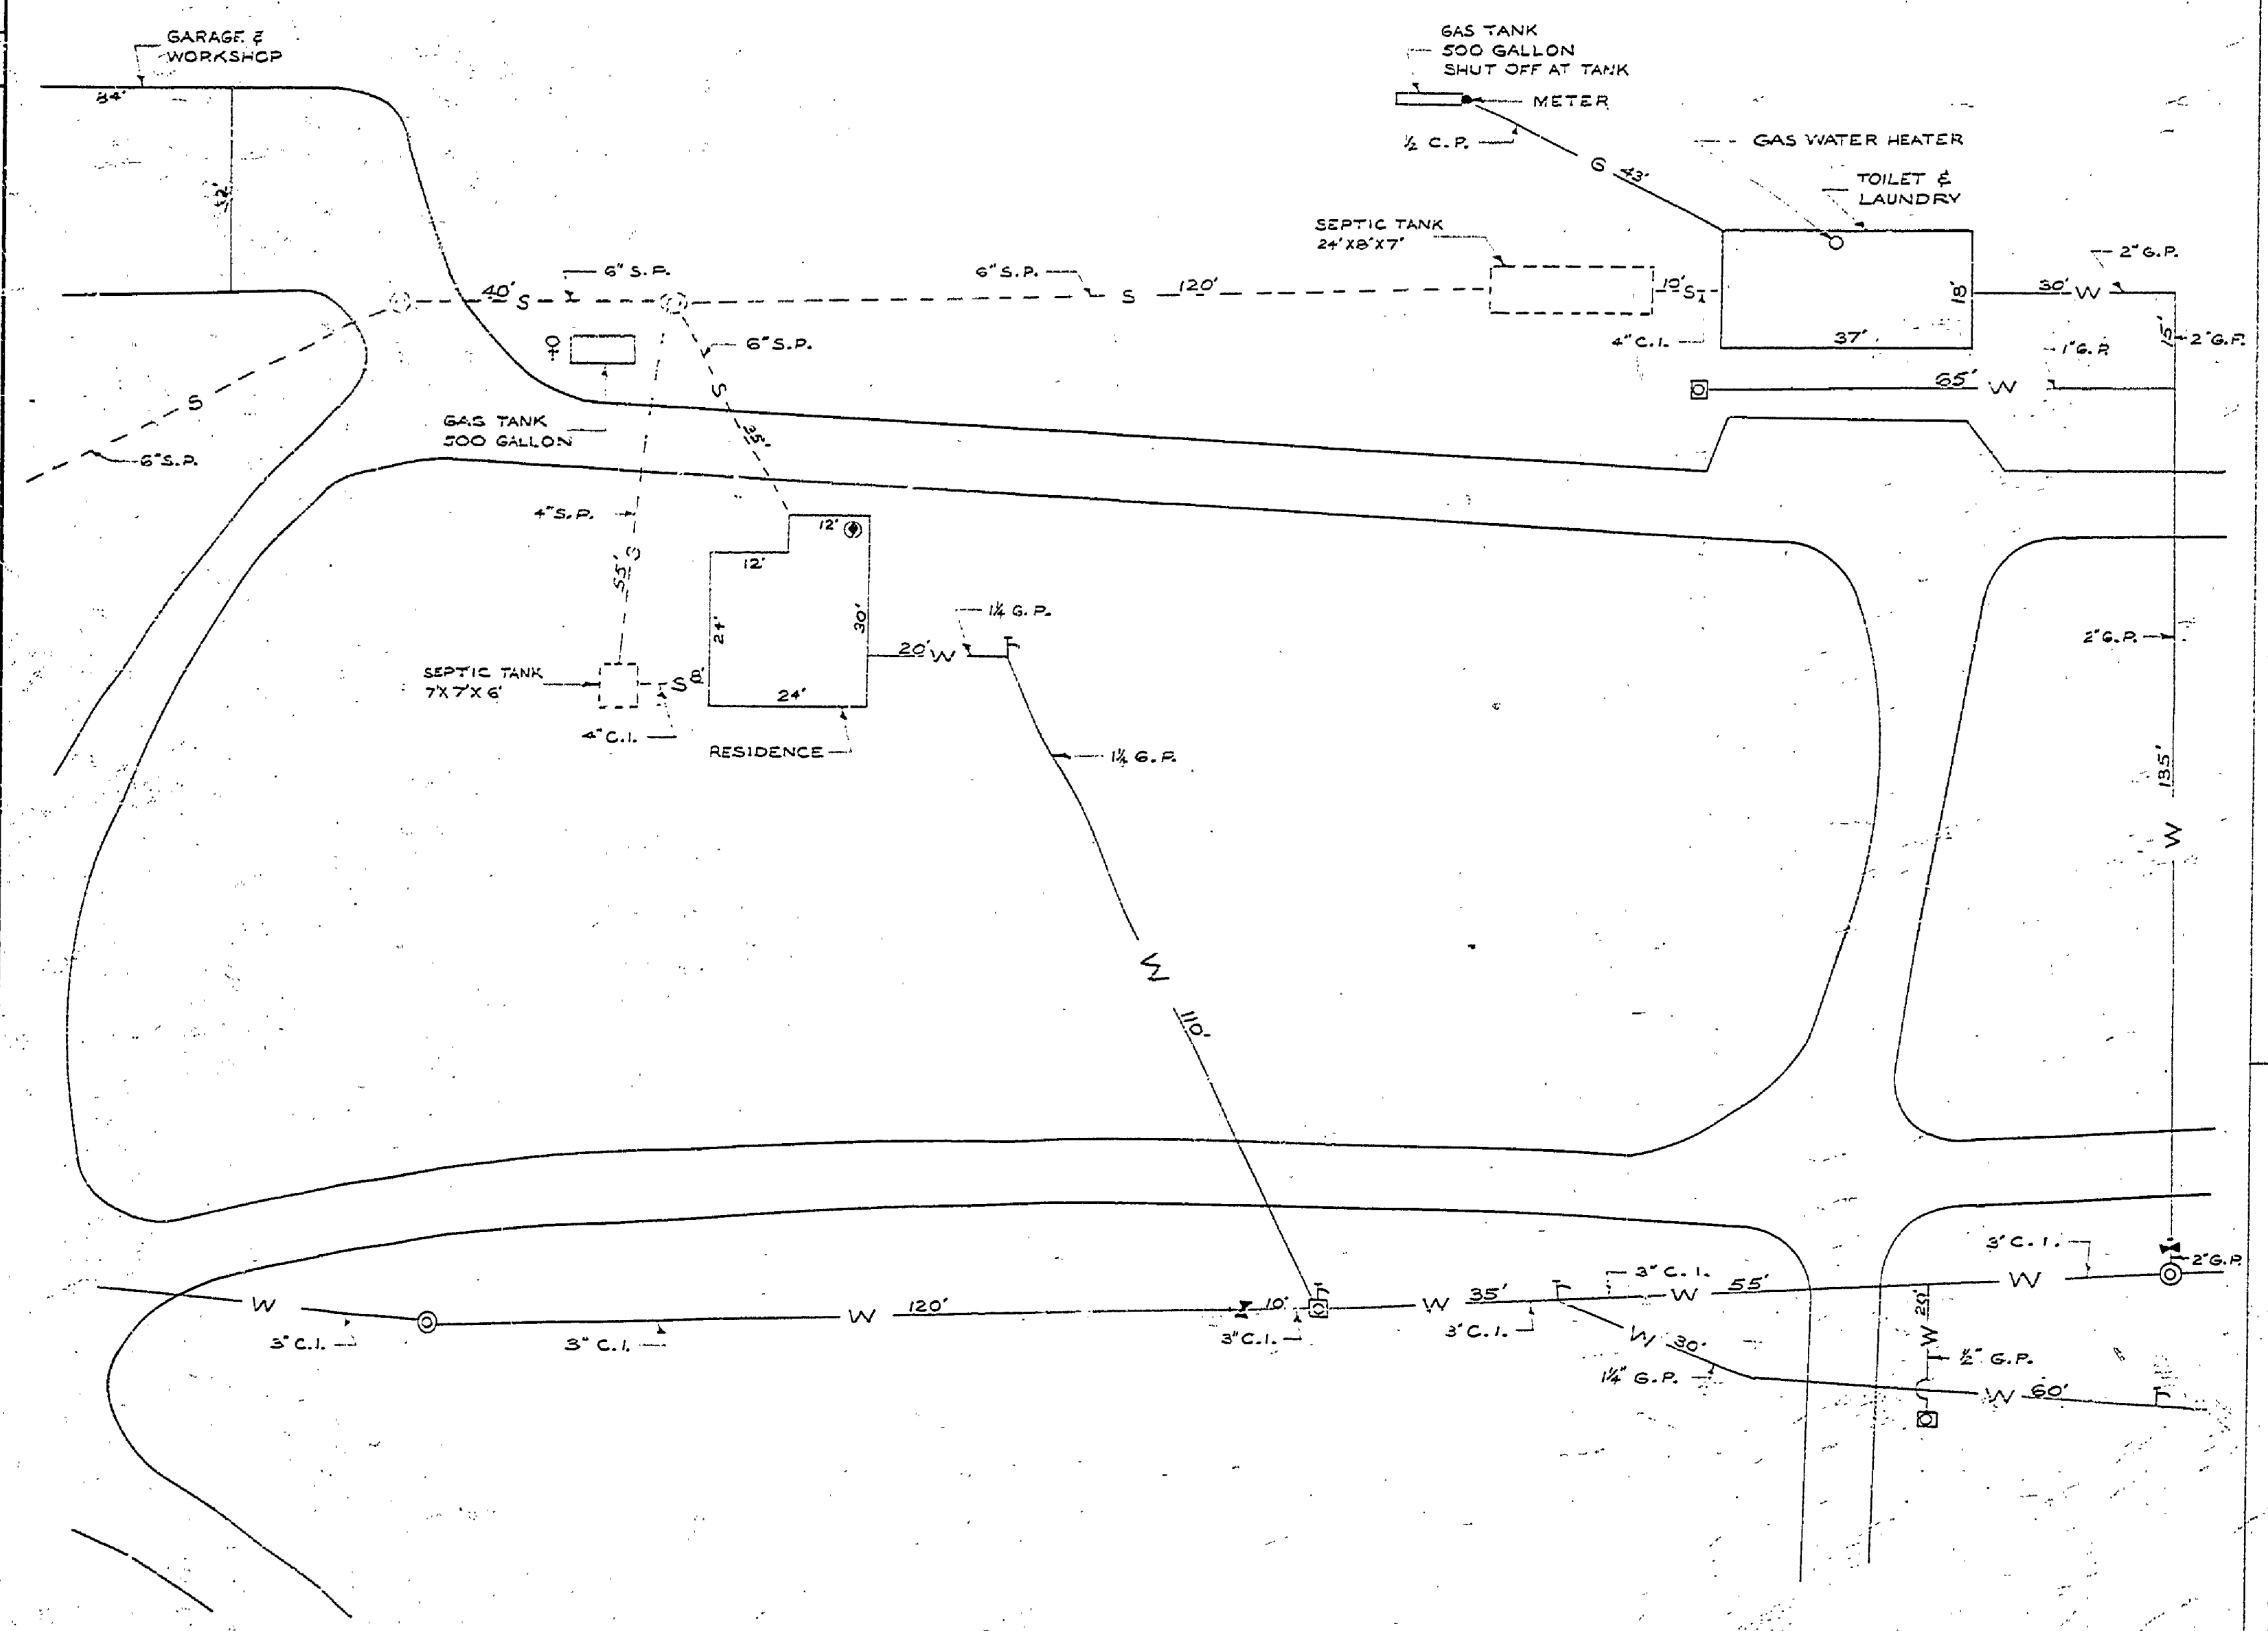

—W—	WATER LINE
- - -S- - -	SEWAGE LINE
- - -G- - -	GAS LINE
⊙	MANHOLE
⊠	WATER FOUNTAIN
T	WATER TAP
⊥	SHUT OFF VALVE
G.P.	GALVANIZED PIPE
S.P.	SEWER PIPE
C.I.	CAST IRON PIPE
C.P.	COPPER PIPE
⊕	ELECTRIC WATER HEATER

DEPARTMENT OF CONSERVATION  
 BARAGA STATE PARK  
 DETAIL A  
 UTILITY MAP  
 SCALE 1" = 20'  
 DRAWN BY R.W. Beck

## BARAGA STATE PARK

MICHIGAN  
 DEPARTMENT OF CONSERVATION  
 PARKS AND RECREATION DIVISION

BARAGA STATE PARK  
 UTILITY MAP  
 DETAIL SHEET

SHEET  
 NO. 3  
 OF 3

PLAN NO.  
 U-227