


INDIAN

LAKE


INDIAN LAKE

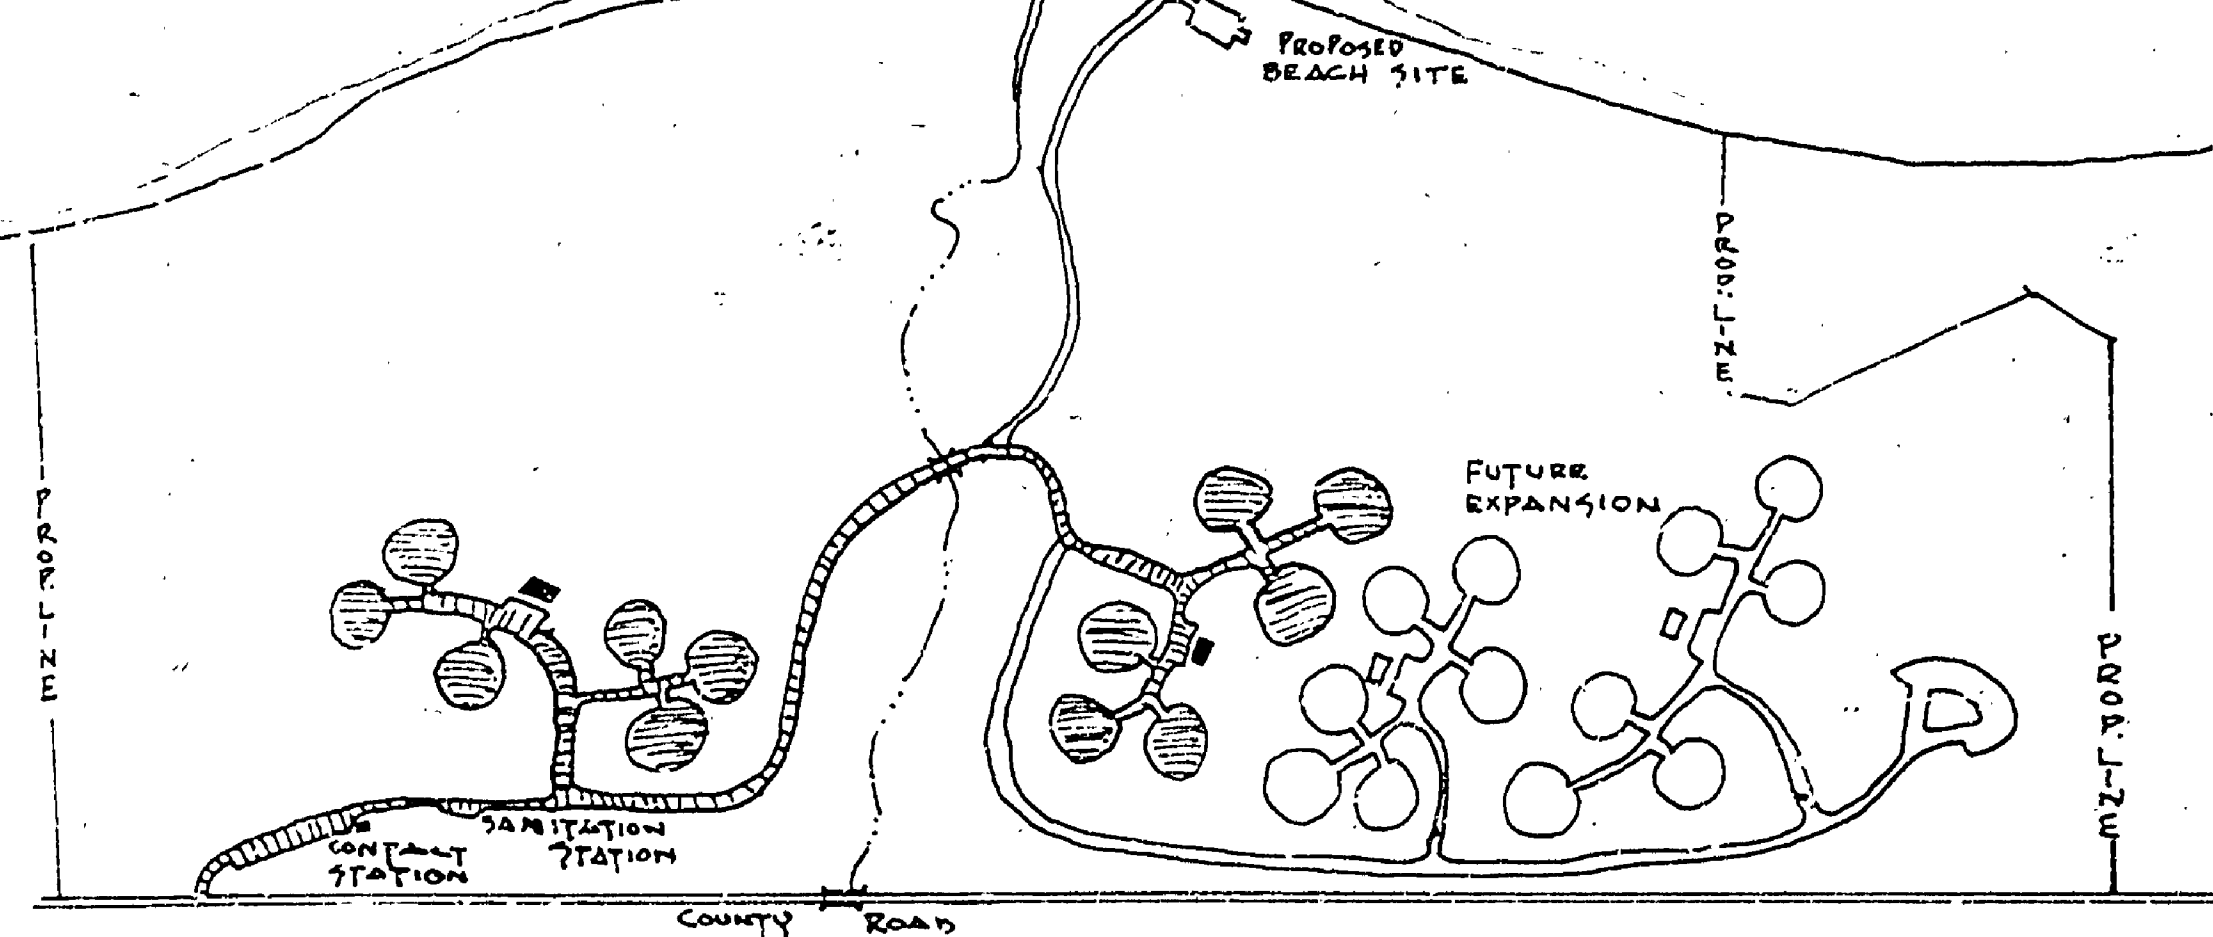

NORTH  
SCALE: 1" = 500'

CEDAR THICKET

SWIMMERS PICNIC AREA  
STUMPS TO BE REMOVED AND AREA  
TO BE FILLED WHERE NECESSARY

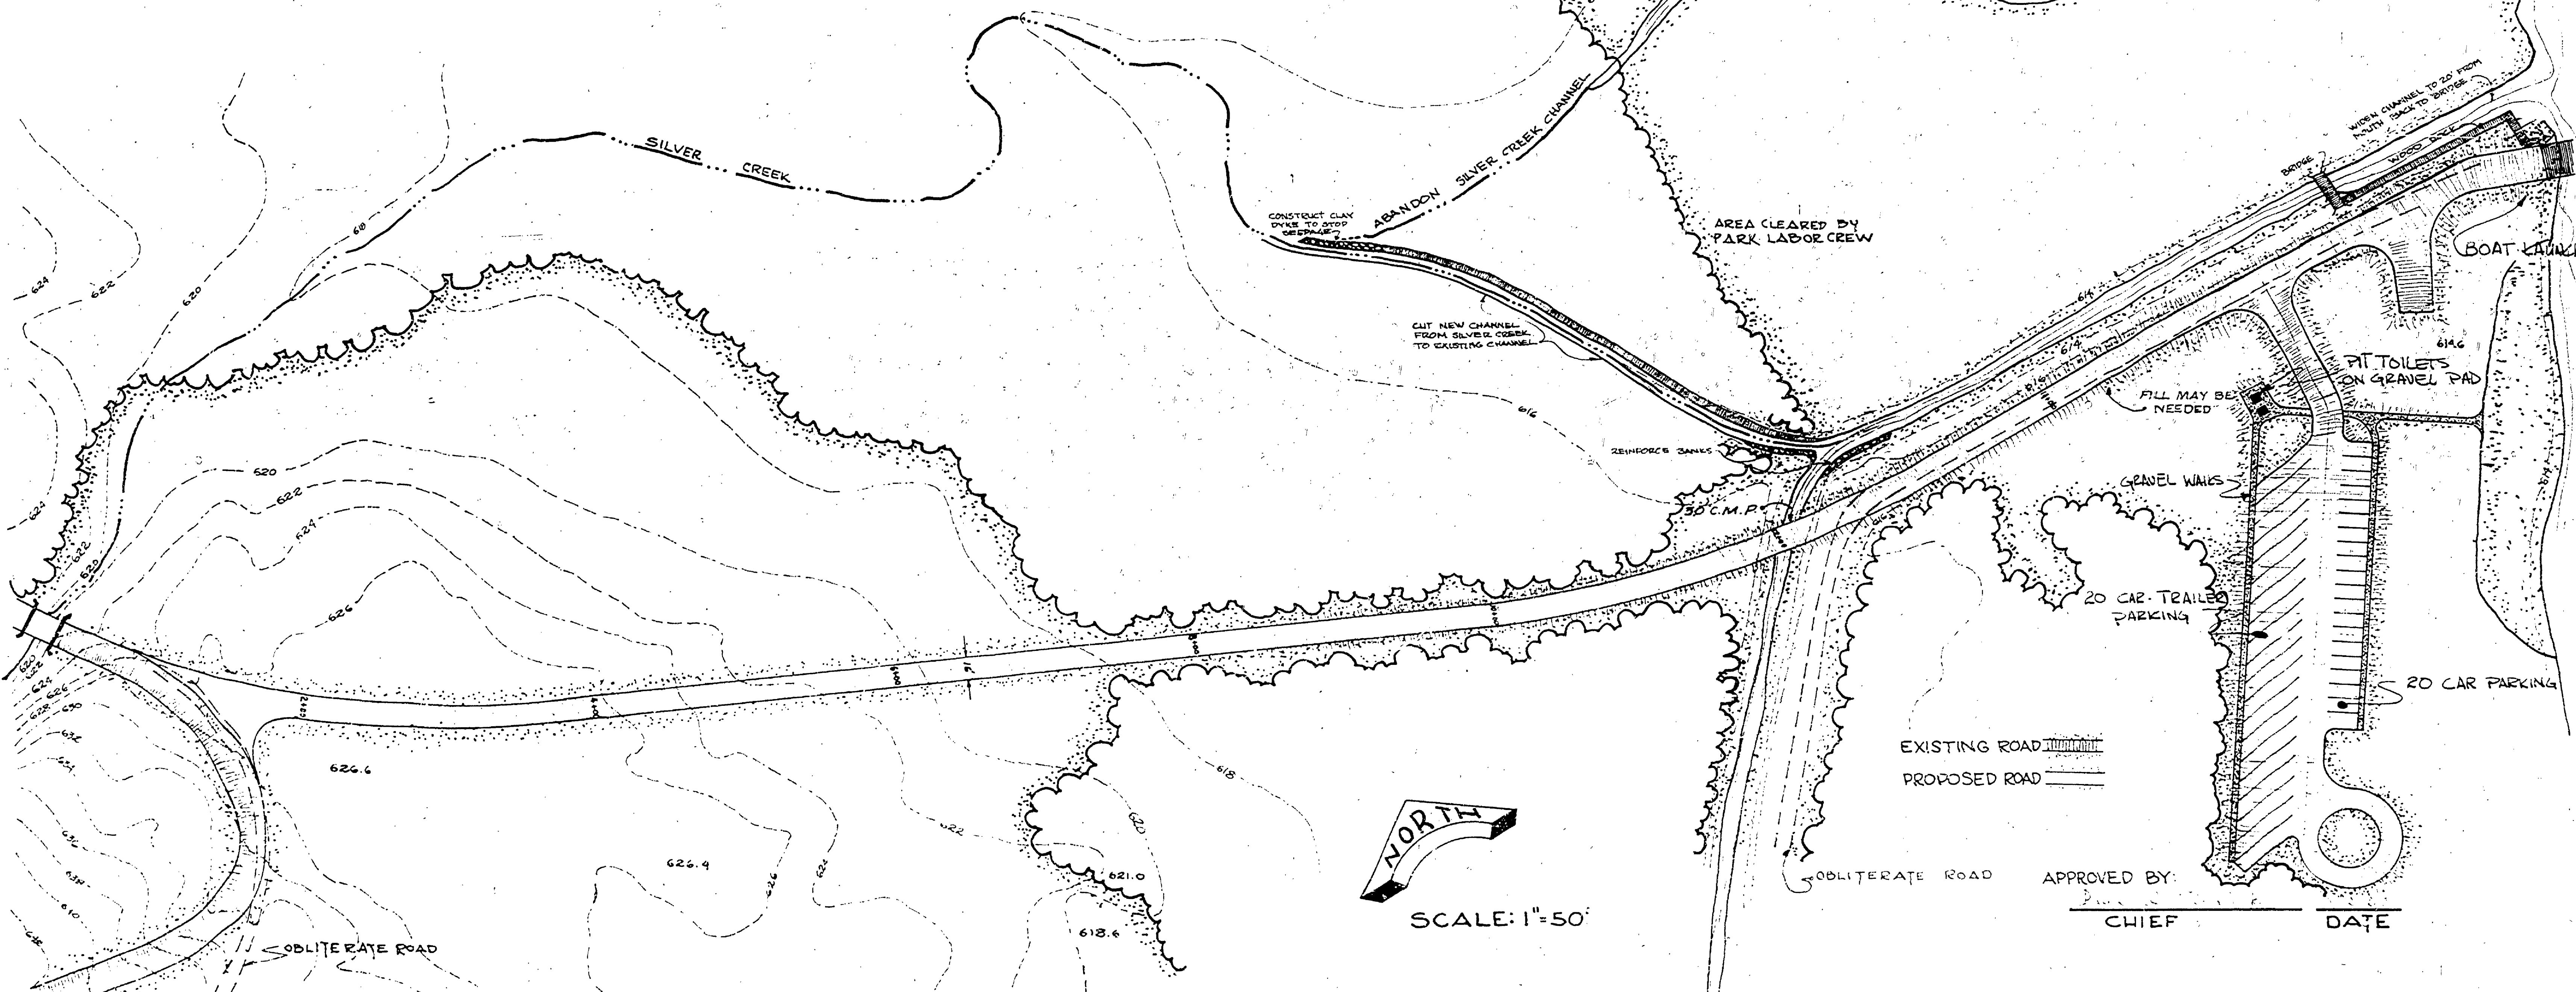

|             |             
|-------------|-------------|----------|------------|------|---------|----------|--|----------|----------|----|---|-------------------------------------|-----------------------------------|--------------------------|-----------------------|-------------------|--------------|----------------|--|
| SURVEYED BY | DESIGNED BY | DRAWN BY | CHECKED BY | NO.  | DATE    | BY       | REVISIONS                                  | NO.      | DATE     | BY | REVISIONS   | MICHIGAN DEPARTMENT OF CONSERVATION | INDIAN LAKE STATE PARK WEST SHORE | SHEET NO. _____ OF _____ | FOR PROJECT NO. _____ | BEACH DEVELOPMENT | SHEET 1 OF 2 | PLAN NO. L-106 |  |
|             | G. R. H.    | G. R. H. | L. M. C.   | 2-67 | 3-27-67 | J. D. C. | add parking lot extension (22 spaces)      | 3-20-70  | J. D. C. |    | cut new channel between silver creek and existing channel |                                     |                                   |                          |                       |                   |              |                |  |
|             |             |          |            | 2-67 | 3-27-67 | J. D. C. | all work done between 3-27-67 and 12-17-71 | 12-17-71 | J. D. C. |    | changed boat launch design                                |                                     |                                   |                          |                       |                   |              |                |  |