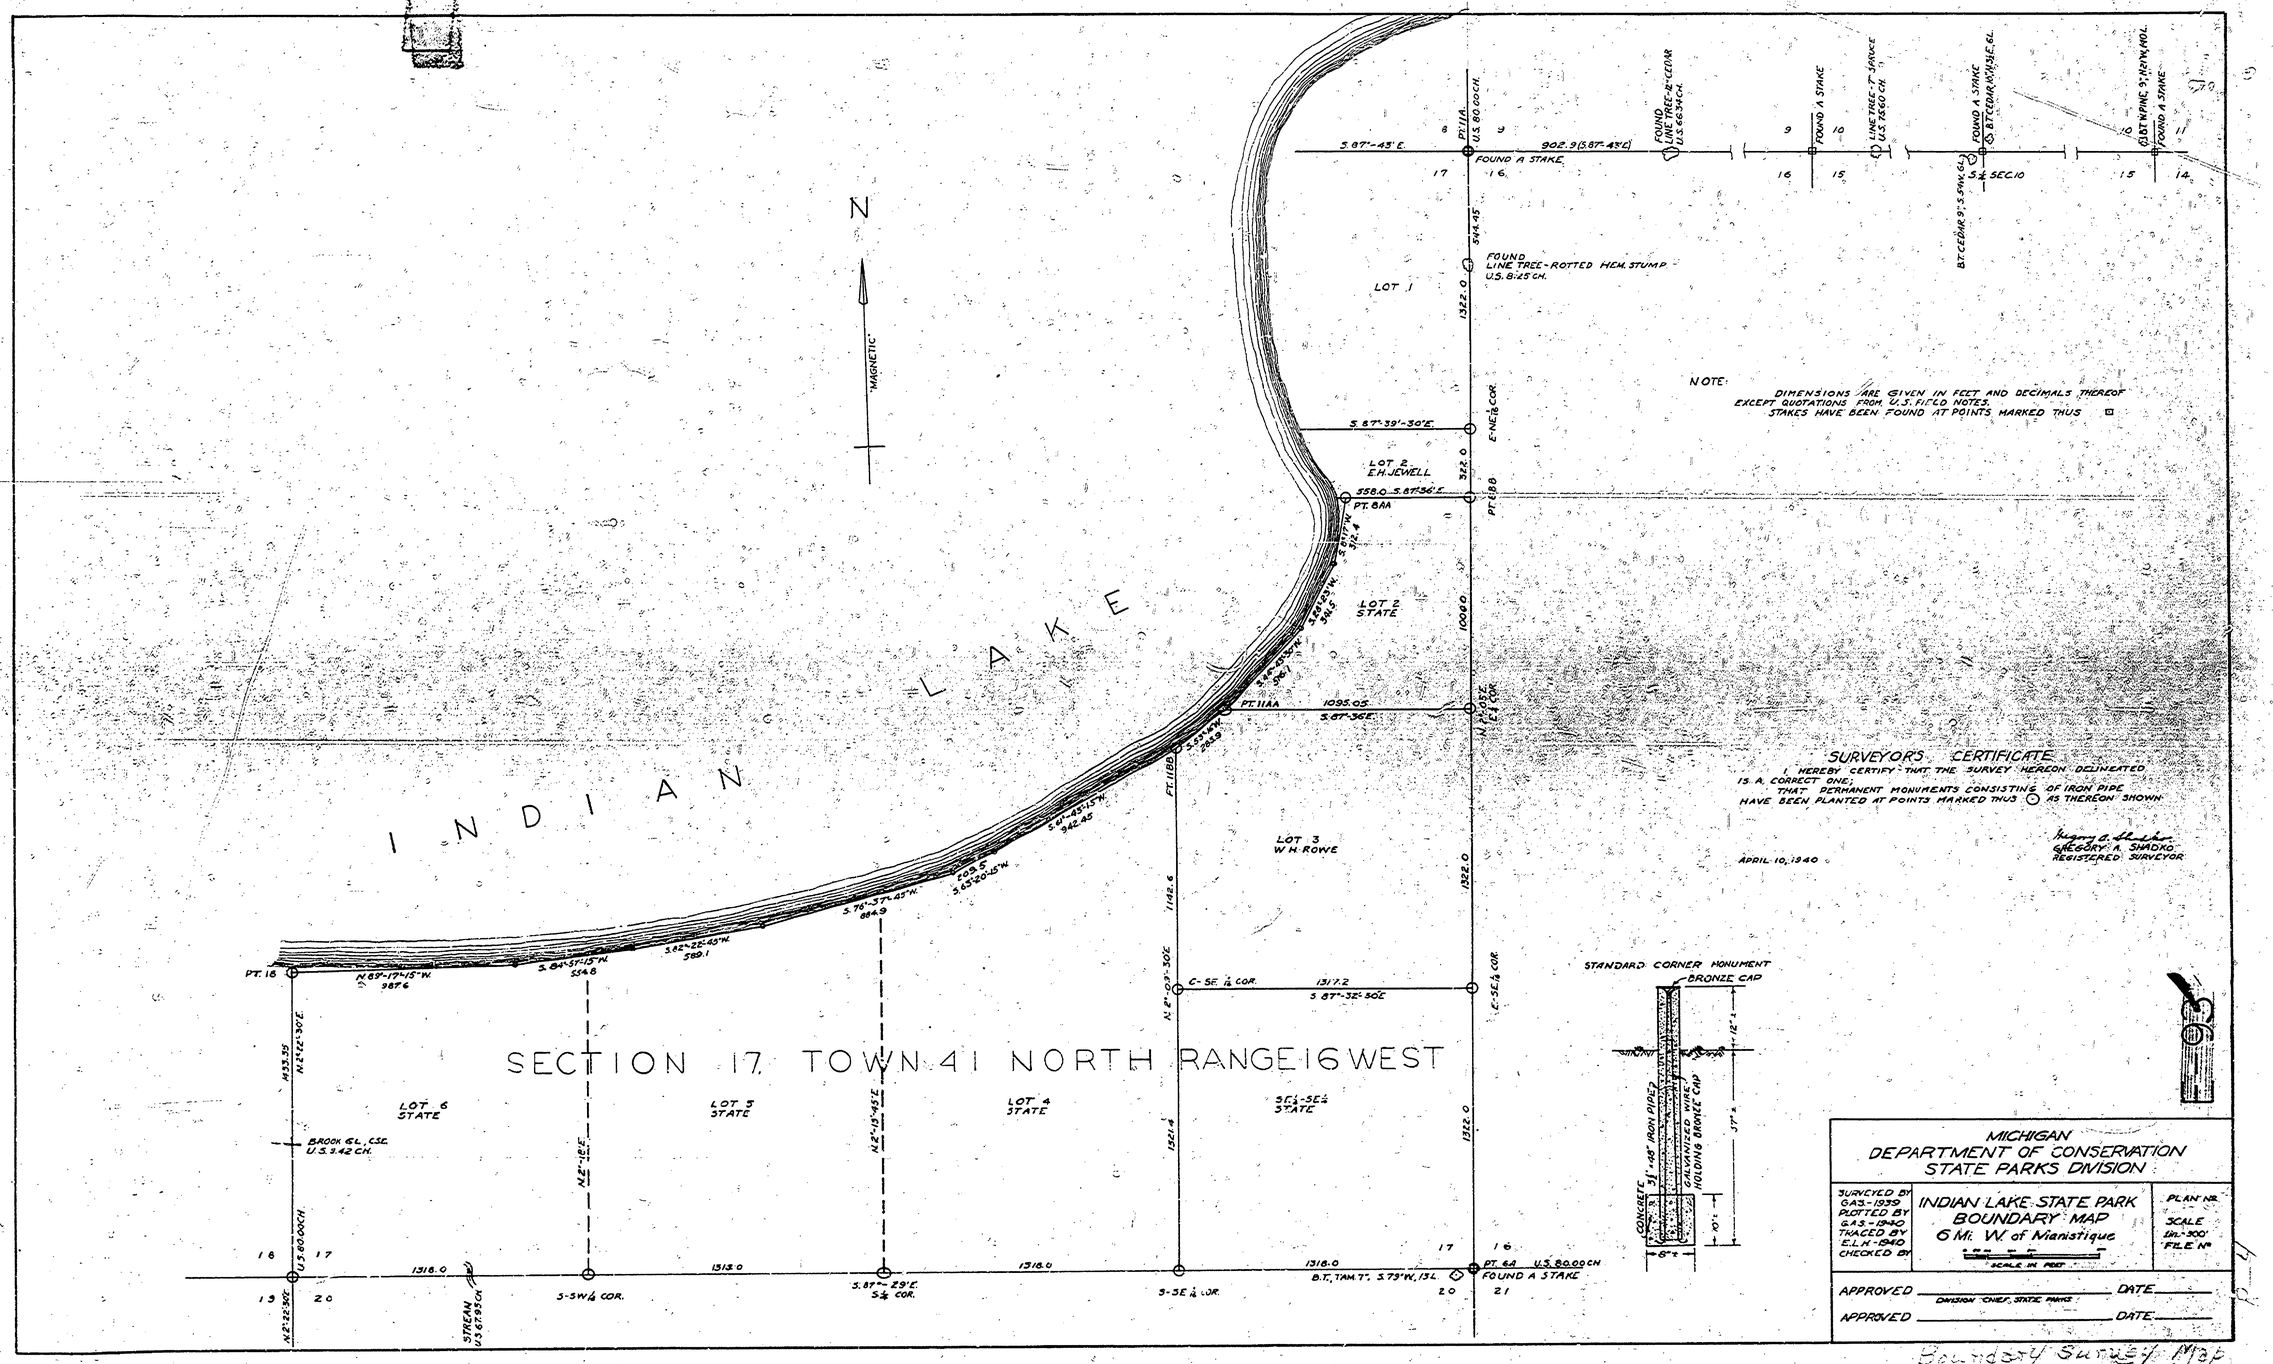

NOTE:
DIMENSIONS ARE GIVEN IN FEET AND DECIMALS THEREOF EXCEPT QUOTATIONS FROM U.S. FIELD NOTES.
STAKES HAVE BEEN FOUND AT POINTS MARKED THUS ⊡

SURVEYOR'S CERTIFICATE
I HEREBY CERTIFY THAT THE SURVEY HEREON DELINEATED IS A CORRECT ONE;
THAT PERMANENT MONUMENTS CONSISTING OF IRON PIPE HAVE BEEN PLANTED AT POINTS MARKED THUS ⊙ AS THEREON SHOWN.

Gregory A. Shadko
GREGORY A. SHADKO
REGISTERED SURVEYOR

APRIL 10, 1940

MICHIGAN
DEPARTMENT OF CONSERVATION
STATE PARKS DIVISION

SURVEYED BY G.A.S.-1939 PLOTTED BY G.A.S.-1940 TRACED BY E.L.H.-1940 CHECKED BY	INDIAN LAKE STATE PARK BOUNDARY MAP 6 Mi. W. of Manistique SCALE IN FEET	PLAN No. SCALE 1in.=300' FILE No.

APPROVED _____ DATE _____
DIVISION CHIEF, STATE PARKS
APPROVED _____ DATE _____

Boundary Survey Map