
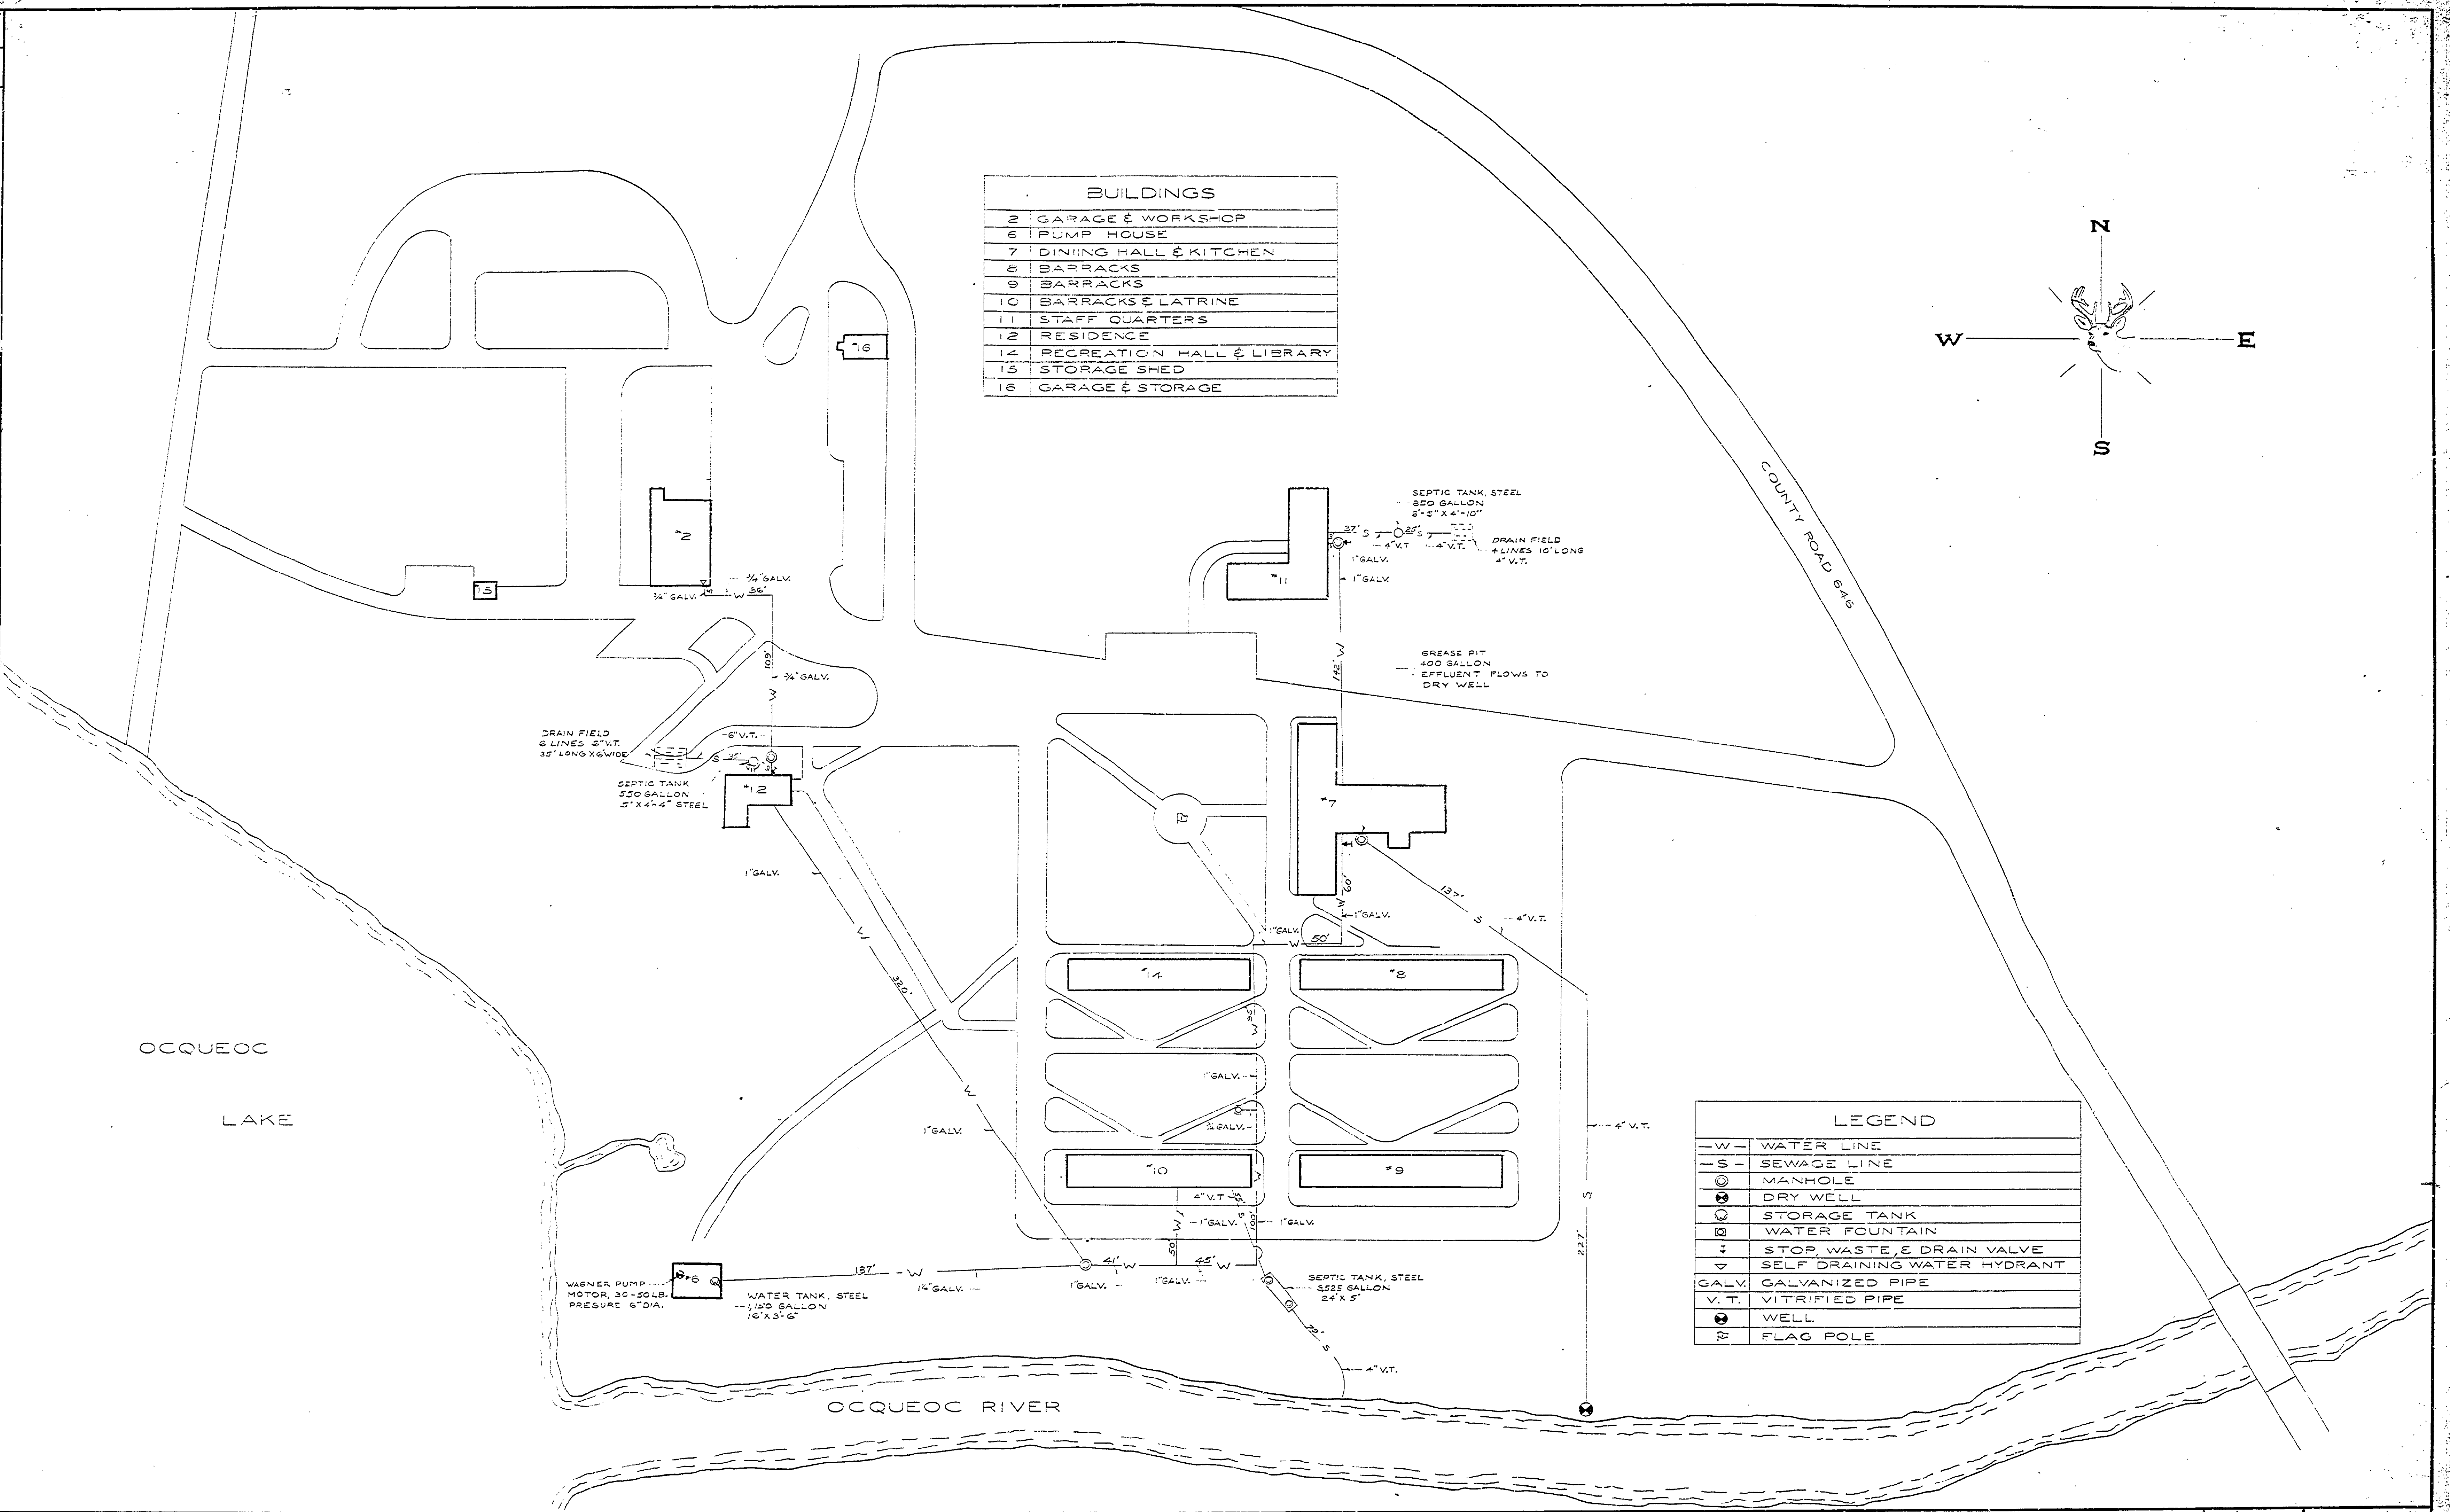


DATE	BY	NO.	DATE	BY
		1		
		2		
		3		
		4		
		5		
		6		

REVIEWED BY SECTIONS	DATE	APPROVED BY
ARCHITECTURAL	3-24-60	<i>[Signature]</i>
ENGINEERING	3-24-60	ASSISTANT CHIEF IN CHARGE
LANDSCAPE	3-24-60	OF DESIGN

DRAWN BY	DATE
R. W. Beck	12-21-59

BUILDINGS	
2	GARAGE & WORKSHOP
6	PUMP HOUSE
7	DINING HALL & KITCHEN
8	BARRACKS
9	BARRACKS
10	BARRACKS & LATRINE
11	STAFF QUARTERS
12	RESIDENCE
14	RECREATION HALL & LIBRARY
15	STORAGE SHED
16	GARAGE & STORAGE

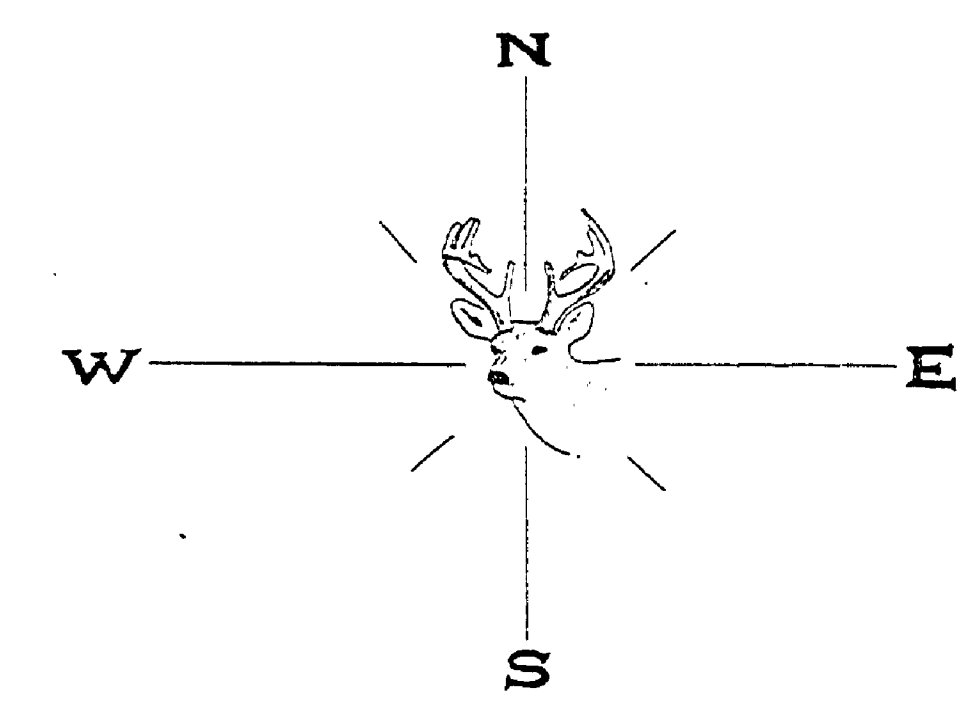

OCQUEOC OUTDOOR CENTER

SCALE 1" = 40'

MICHIGAN DEPARTMENT OF CONSERVATION PARKS AND RECREATION DIVISION

OCQUEOC OUTDOOR CENTER UTILITY MAP WATER & SEWAGE

SHEET NO. 2 OF 3

PLAN NO. U-1 R-1