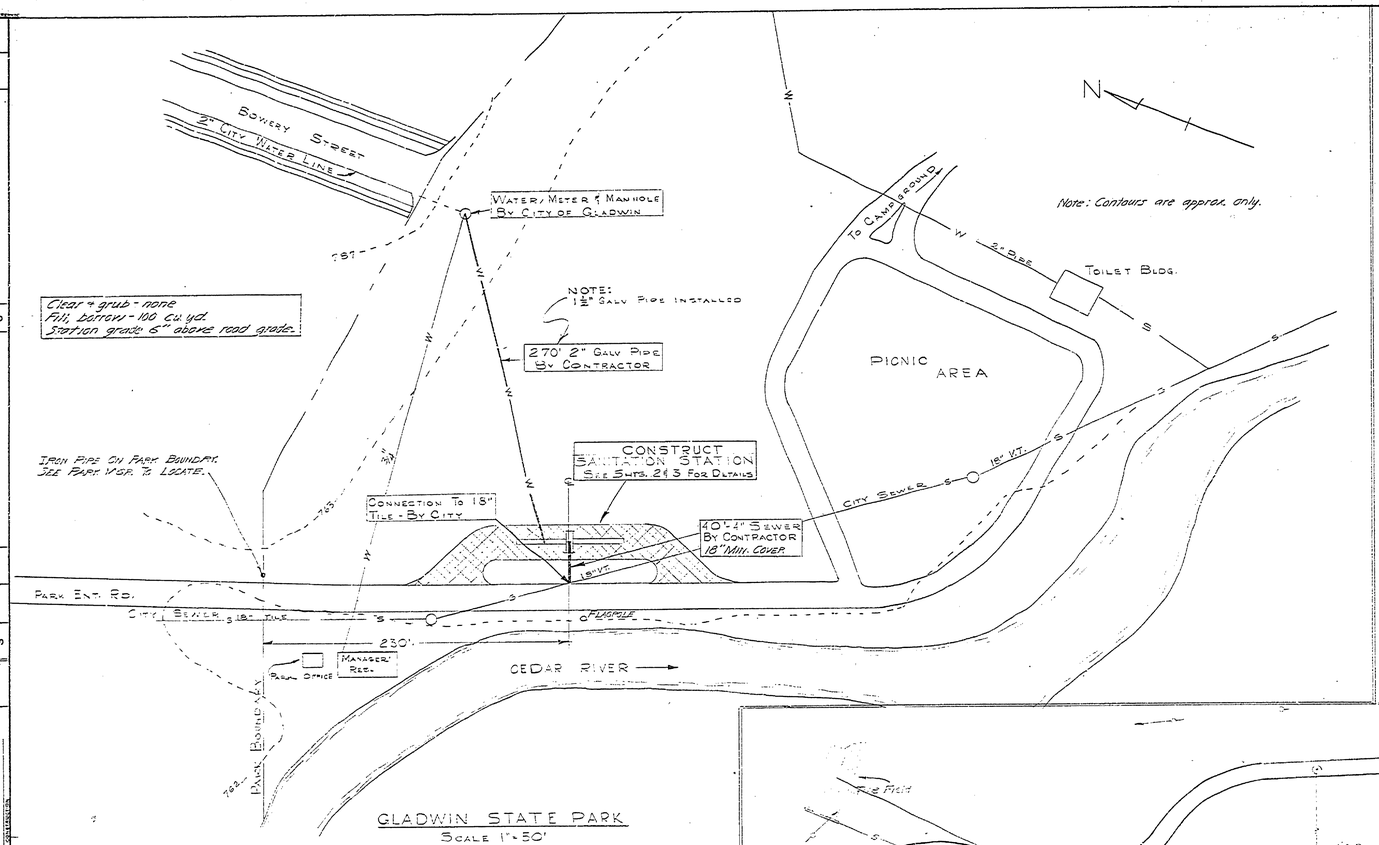

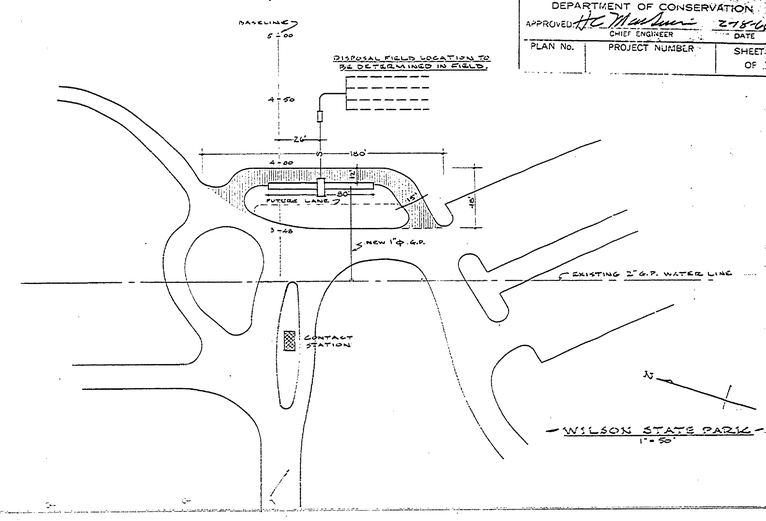

CONSERVATION COMMISSION APPROVAL
BY: _____ DATE: _____

DESIGN
RECOMMENDED FOR APPROVAL: H. J. Aarons — DESIGNER — DATE 2-15-66
RECOMMENDED FOR APPROVAL: E. J. Cortel — IN CHARGE OF DESIGN — DATE 2-15-66

SECTION APPROVAL
BY: Arthur Kane — SECTION CHIEF — DATE: 2/18/66

MICHIGAN
DEPARTMENT OF CONSERVATION
APPROVED: H. C. MacLean — CHIEF ENGINEER — DATE 2-18-66

PLAN No.	PROJECT NUMBER	SHEET: OF

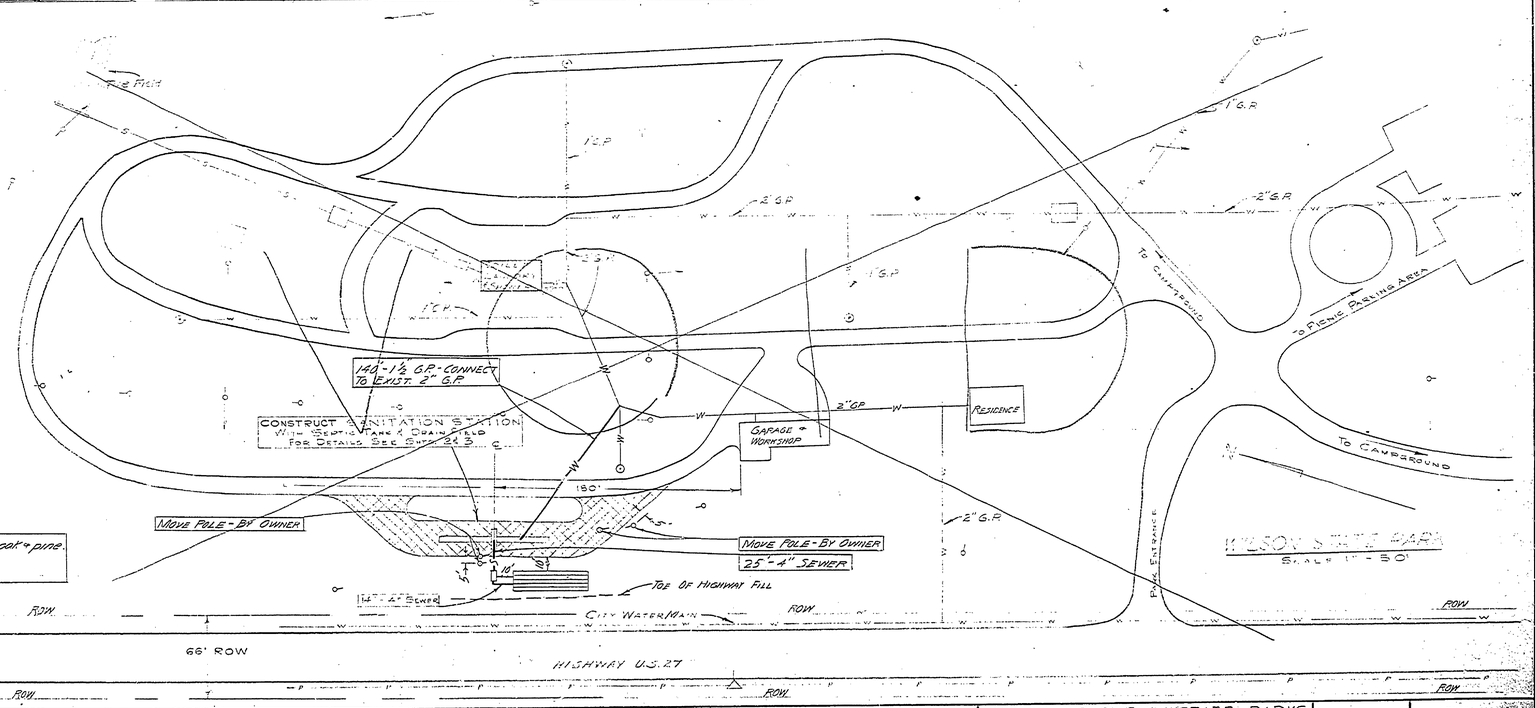

Clear & grub - Approx. 12-12" to 18" oak & pine.
Fill, borrow - 250 cu yd.
Station grade @ road grade.

DATE	BY	REVISIONS	DATE	BY
		4		
		5		
		6		

NO.	DATE	BY
1		
2		
3		

APPROVED — CHIEF OF DIVISION — CHIEF OF OPERATION — CHIEF OF PLANNING AND COORDINATION

REVIEWED	DATE
ARCHITECTURAL	
ENGINEERING	
LANDSCAPE	

		DATE
DESIGNED BY		
DRAWN BY	D. Cuckler	9-24-65
CHECKED BY	K. Janssen	1-65

MICHIGAN
DEPARTMENT OF CONSERVATION
PARKS AND RECREATION DIVISION

WILSON AND GLADWIN STATE PARKS
SANITATION STATION PLOT PLANS
CONTRACT NO. 3

SHEET NO. 4 OF 8

PLAN NO.
WILSON E-100
GLADWIN E-100