


DESIGNED BY	DATE	REVIEWED	DATE	APPROVED	DATE	NO.	DATE	BY	REVISIONS	DATE	BY
TRACED BY RNB	3-66	ARCHITECTURAL				1			4		
CHECKED BY		ENGINEERING				2			5		
		LANDSCAPE				3			6		

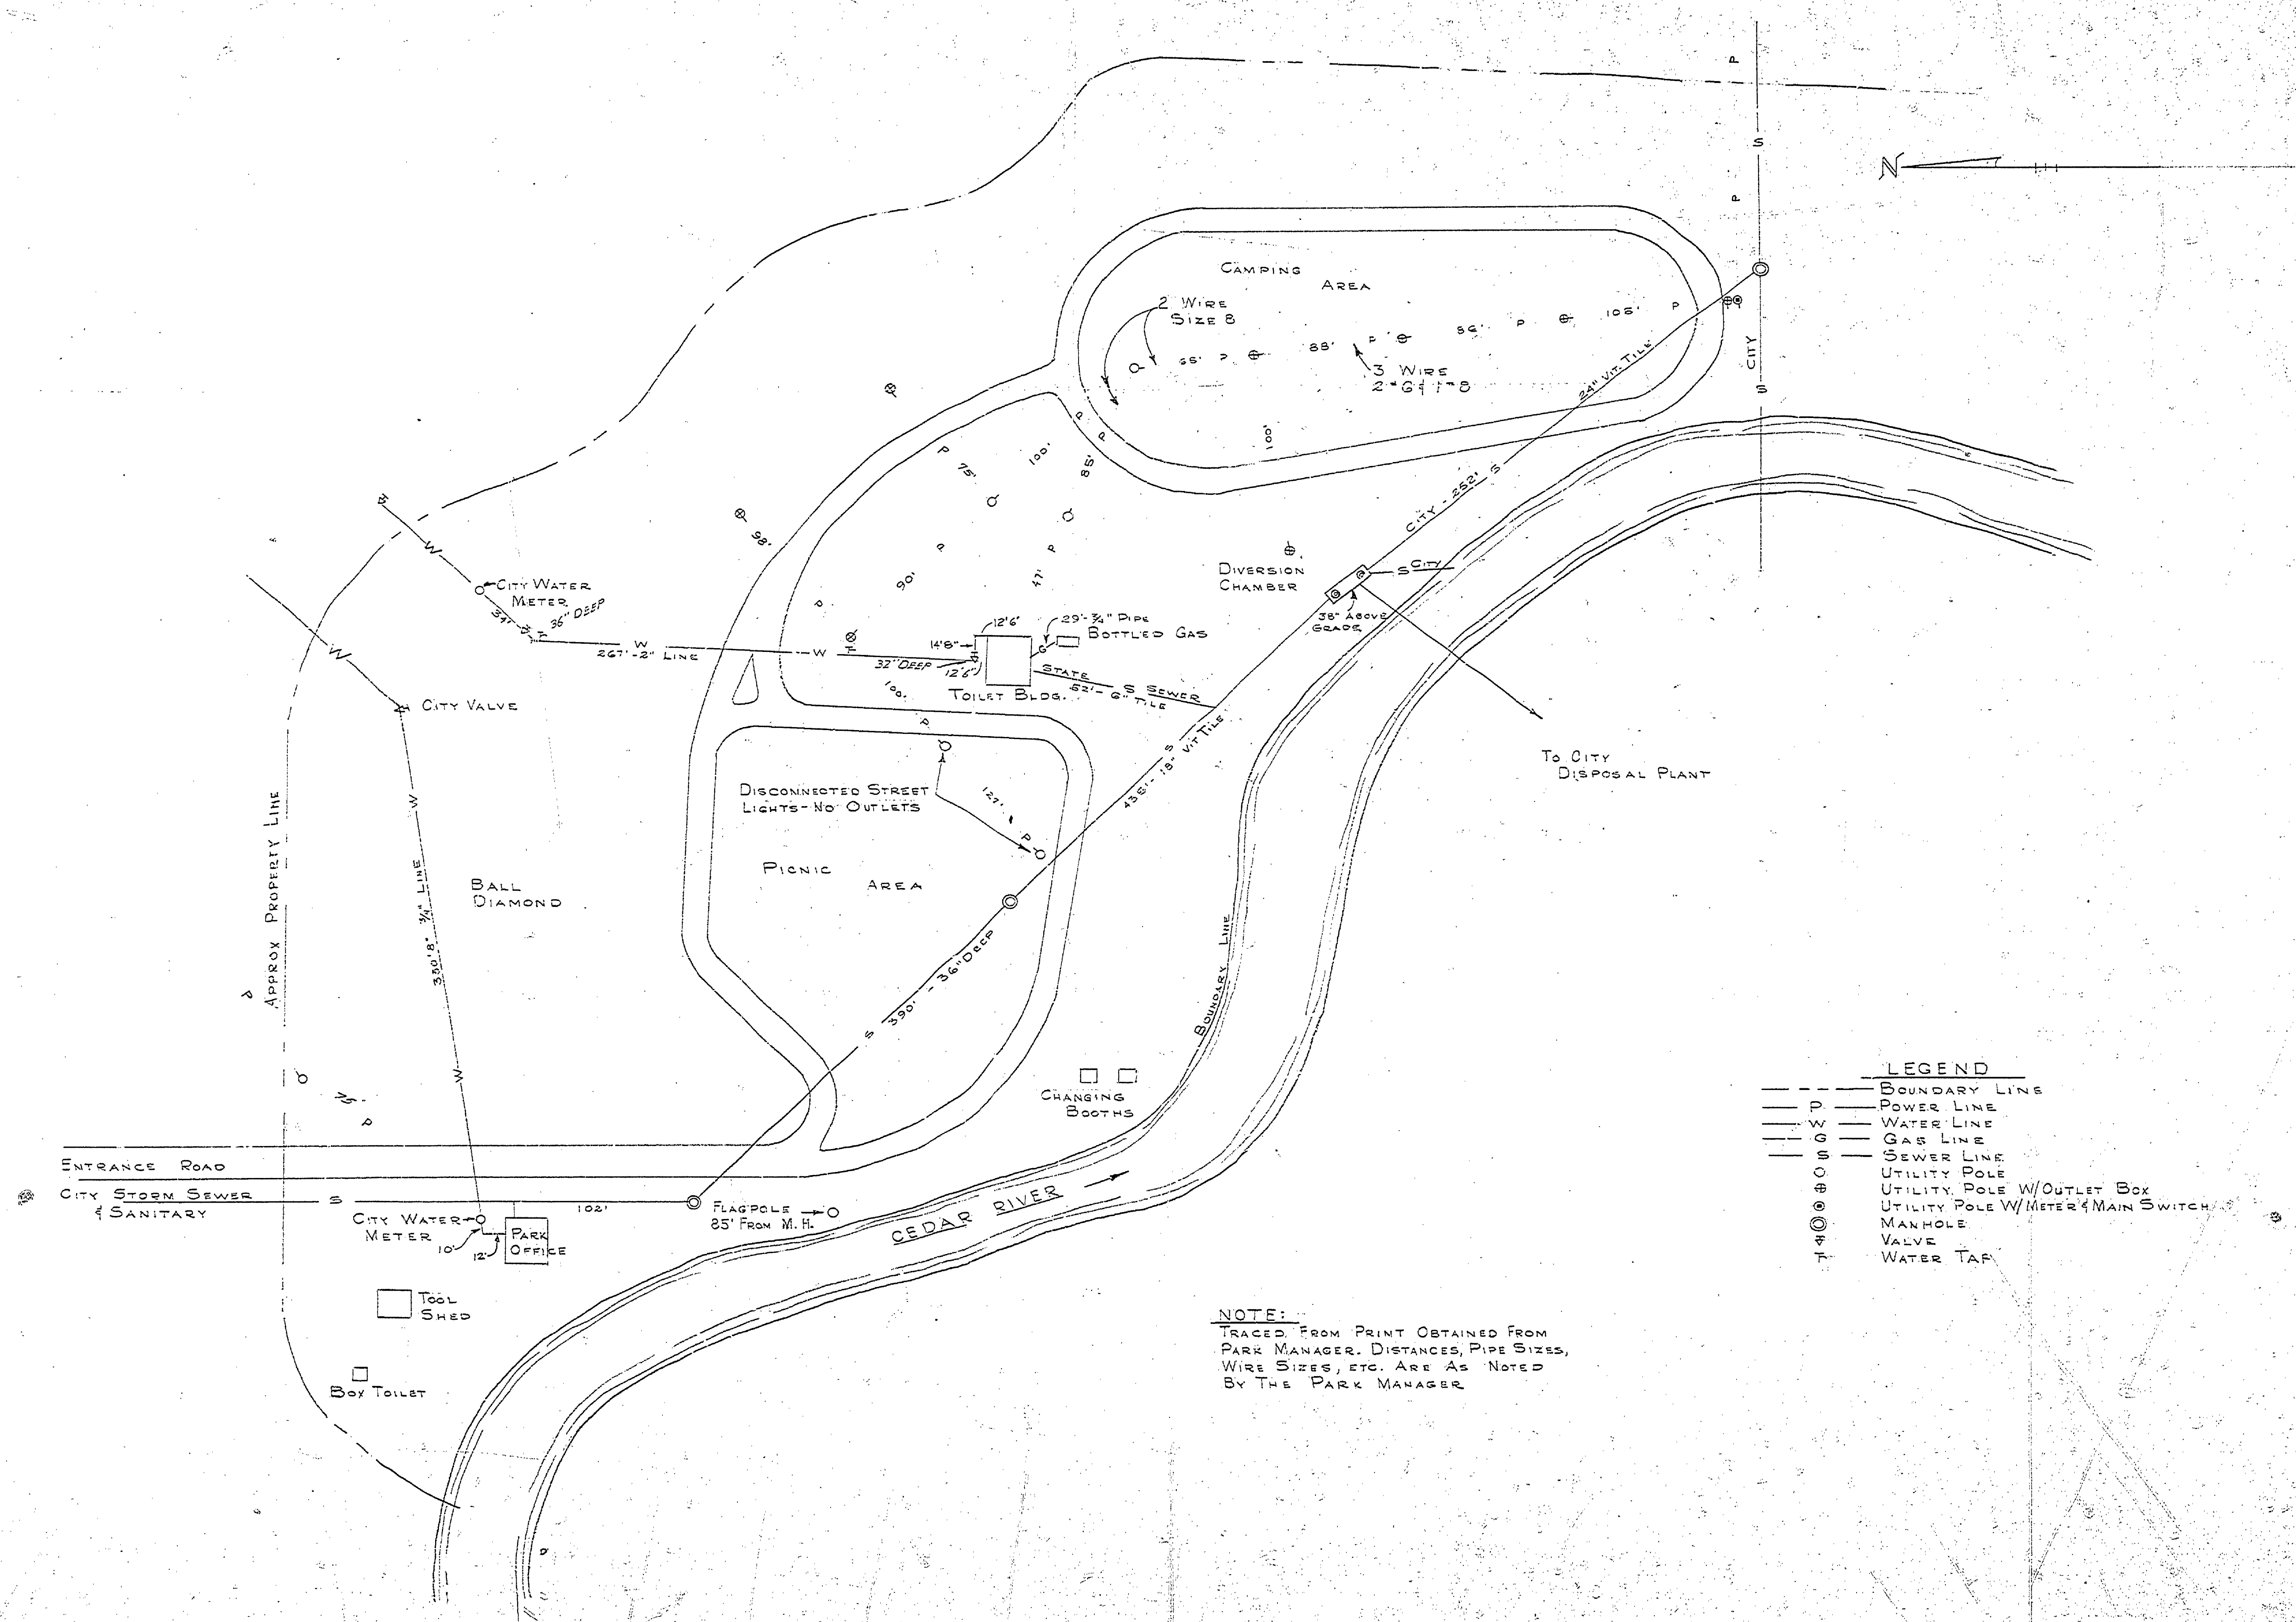

- LEGEND**
- BOUNDARY LINE
 - POWER LINE
 - WATER LINE
 - GAS LINE
 - SEWER LINE
 - UTILITY POLE
 - UTILITY POLE W/OUTLET BOX
 - UTILITY POLE W/METER & MAIN SWITCH
 - MANHOLE
 - VALVE
 - WATER TAP

NOTE:
 TRACED FROM PRINT OBTAINED FROM
 PARK MANAGER. DISTANCES, PIPE SIZES,
 WIRE SIZES, ETC. ARE AS NOTED
 BY THE PARK MANAGER.

MICHIGAN
 DEPARTMENT OF CONSERVATION
 PARKS AND RECREATION DIVISION

GLADWIN STATE PARK
 UTILITY PLAN
 No SCALE

SHEET
 NO. 1
 OF 1

PLAN NO.
 U-2