REVIEWED BY SECTIONS		DATE	APPROVED BY
ARCHITECTURAL	J.L.L.	2-13-58	
ENGINEERING	J.L.L.	2-13-58	ASSISTANT CHIEF IN CHARGE OF DESIGN
LANDSCAPE	J.L.L.	2-13-58	DATE

DRAWN BY H.W. YOUNG
TRACED BY
CHECKED BY
DATE 1-2-58

NOTE
COMPILED FROM DATA SUBMITTED BY B. O. VOGEL, CHARLES MEARS STATE PARK, DATED 10-31-57.

DWG. DASH NO.	SHEET NO.	DESCRIPTION	DATE
-1	1	INDEX - UTILITIES	
-2	1	BATHHOUSE	
-3	1	TOILET	
-4	1	GENERAL AREA	
-5	1		

NO.	DATE	BY	REVISIONS	DATE	BY
1			4		
2			5		
3			6		

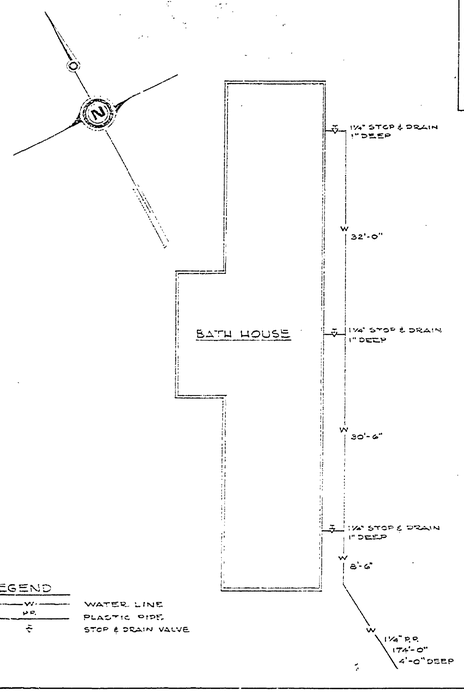

PLAN NO. -2
SCALE 1" = 10'-0"
DRAWN BY
BATHHOUSE
UTILITIES
MICHIGAN DEPT. OF CONSERVATION
CHARLES MEARS STATE PARK

PLAN NO. -4

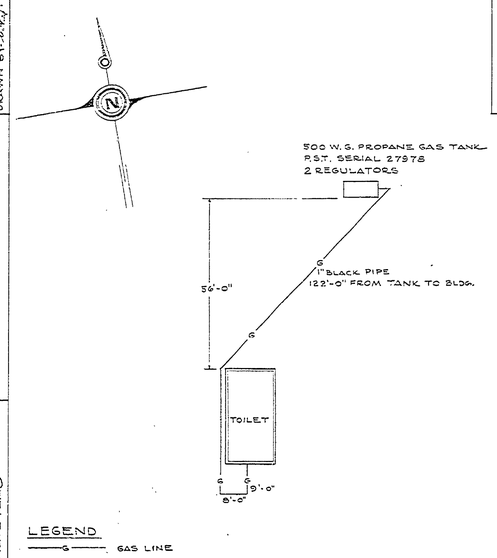

PLAN NO. -1
DRAWN BY
INDEX - UTILITIES
MICHIGAN DEPT. OF CONSERVATION
CHARLES MEARS STATE PARK

PLAN NO. -3
SCALE 1" = 20'-0"
DRAWN BY
TOILET
UTILITIES
MICHIGAN DEPT. OF CONSERVATION
CHARLES MEARS STATE PARK

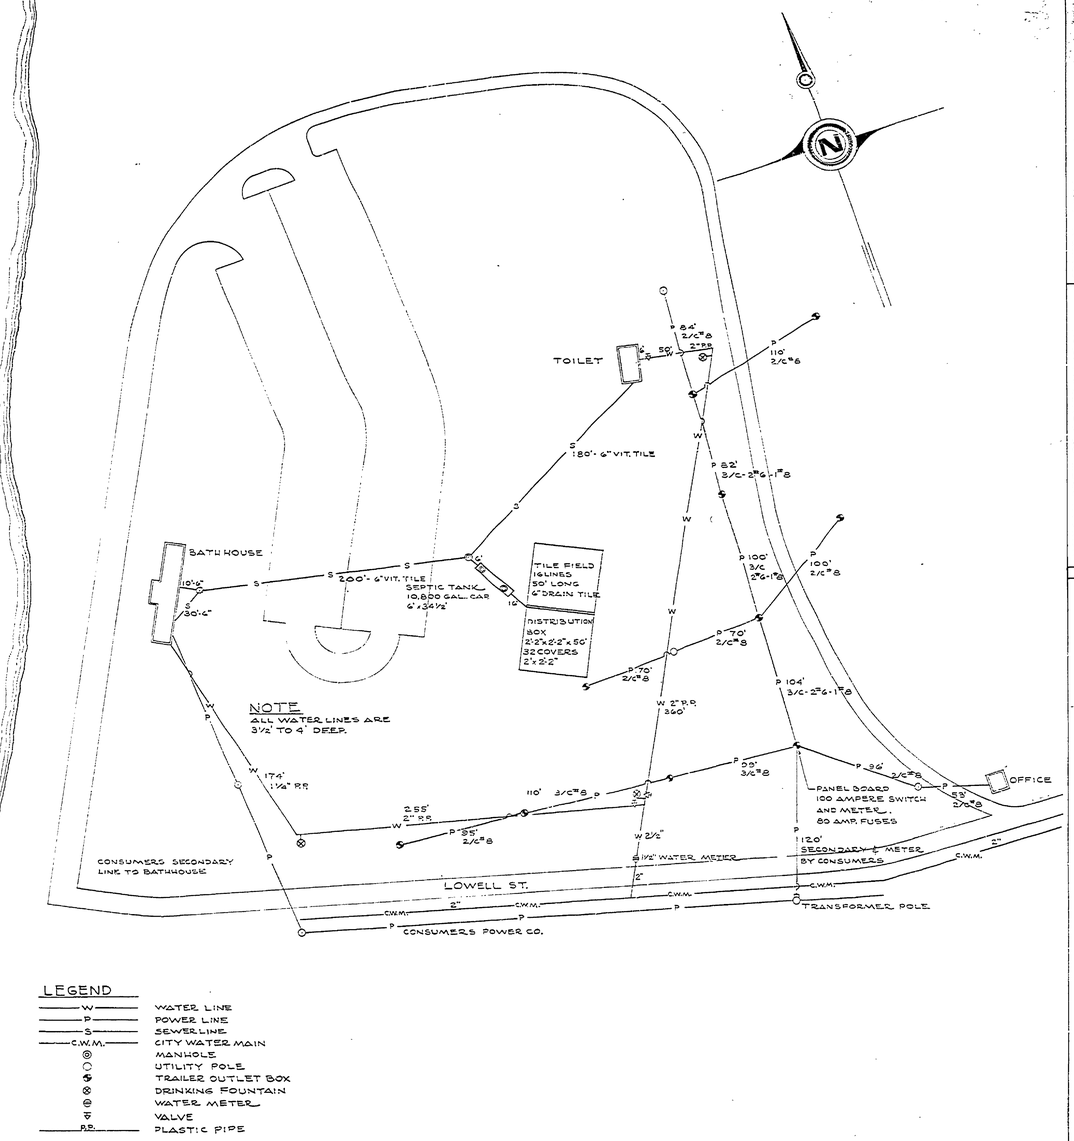

PLAN NO. -5
SCALE 1" = 150'-0"
DRAWN BY
GENERAL AREA
UTILITIES
MICHIGAN DEPT. OF CONSERVATION
CHARLES MEARS STATE PARK

MICHIGAN
DEPARTMENT OF CONSERVATION
PARKS AND RECREATION DIVISION

CHARLES MEARS STATE PARK
UTILITIES

SHEET NO. 1 OF 1

PLAN NO. U-1