


DRAWN BY H.W. YOUNG	CHECKED BY J.T.P.	REVIEWED BY SECTIONS		APPROVED BY		NO.	DATE	BY	REVISIONS
		ARCHITECTURAL	J.T.P.	2-5-58	H.C. [Signature]				
		ENGINEERING	J.T.P.	2-5-58		2			4
		LANDSCAPE	J.T.P.	2-5-58		3			5
									6


Legend

- BOUNDARY LINE
- WIRE FENCE
- RAILROAD
- POWER LINE
- WATER LINE
- SEWER LINE

- GALVANIZED PIPE
- UTILITY POLE
- UTILITY POLE / OUTLET BOX
- UTILITY POLE / TRANSFORMER
- MANHOLE
- DRINKING FOUNTAIN

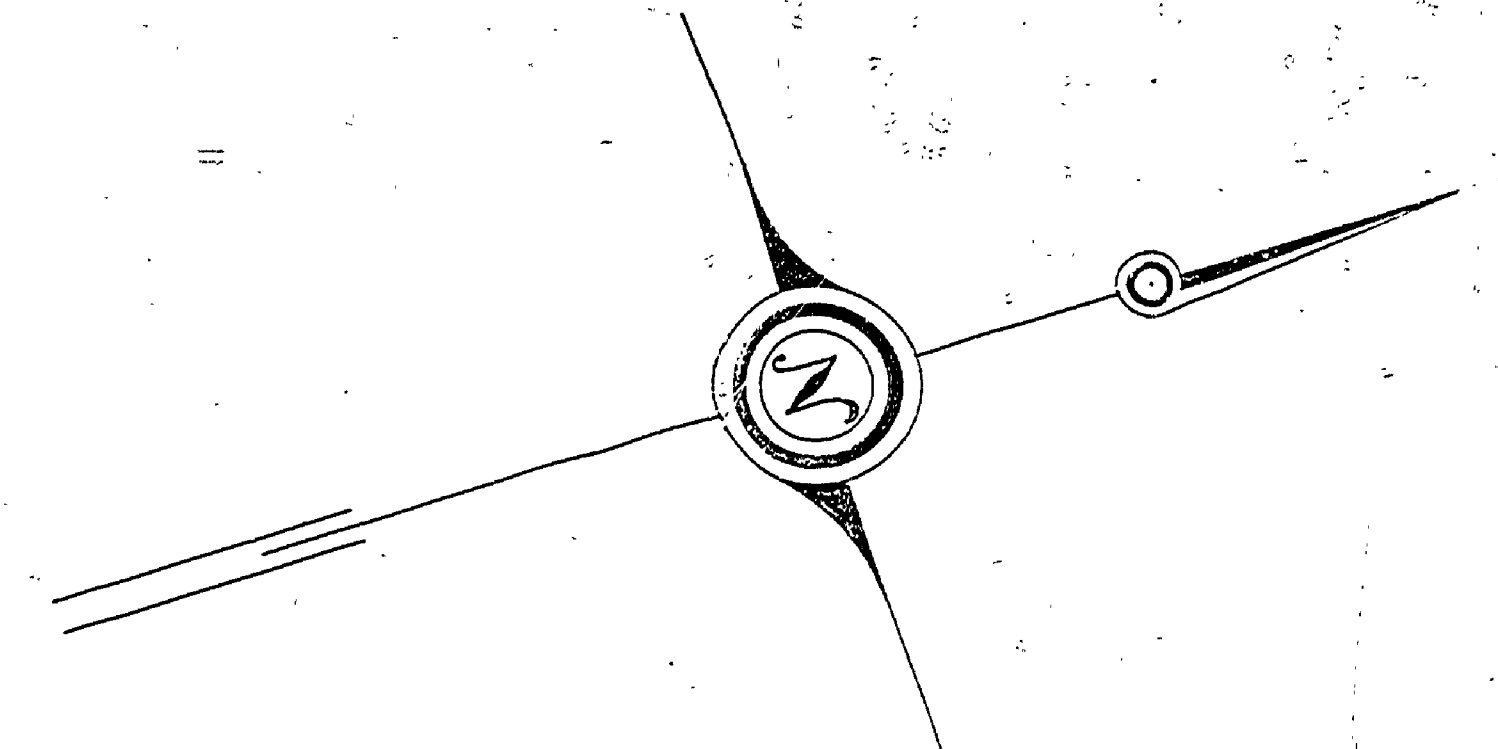

Otsego Lake

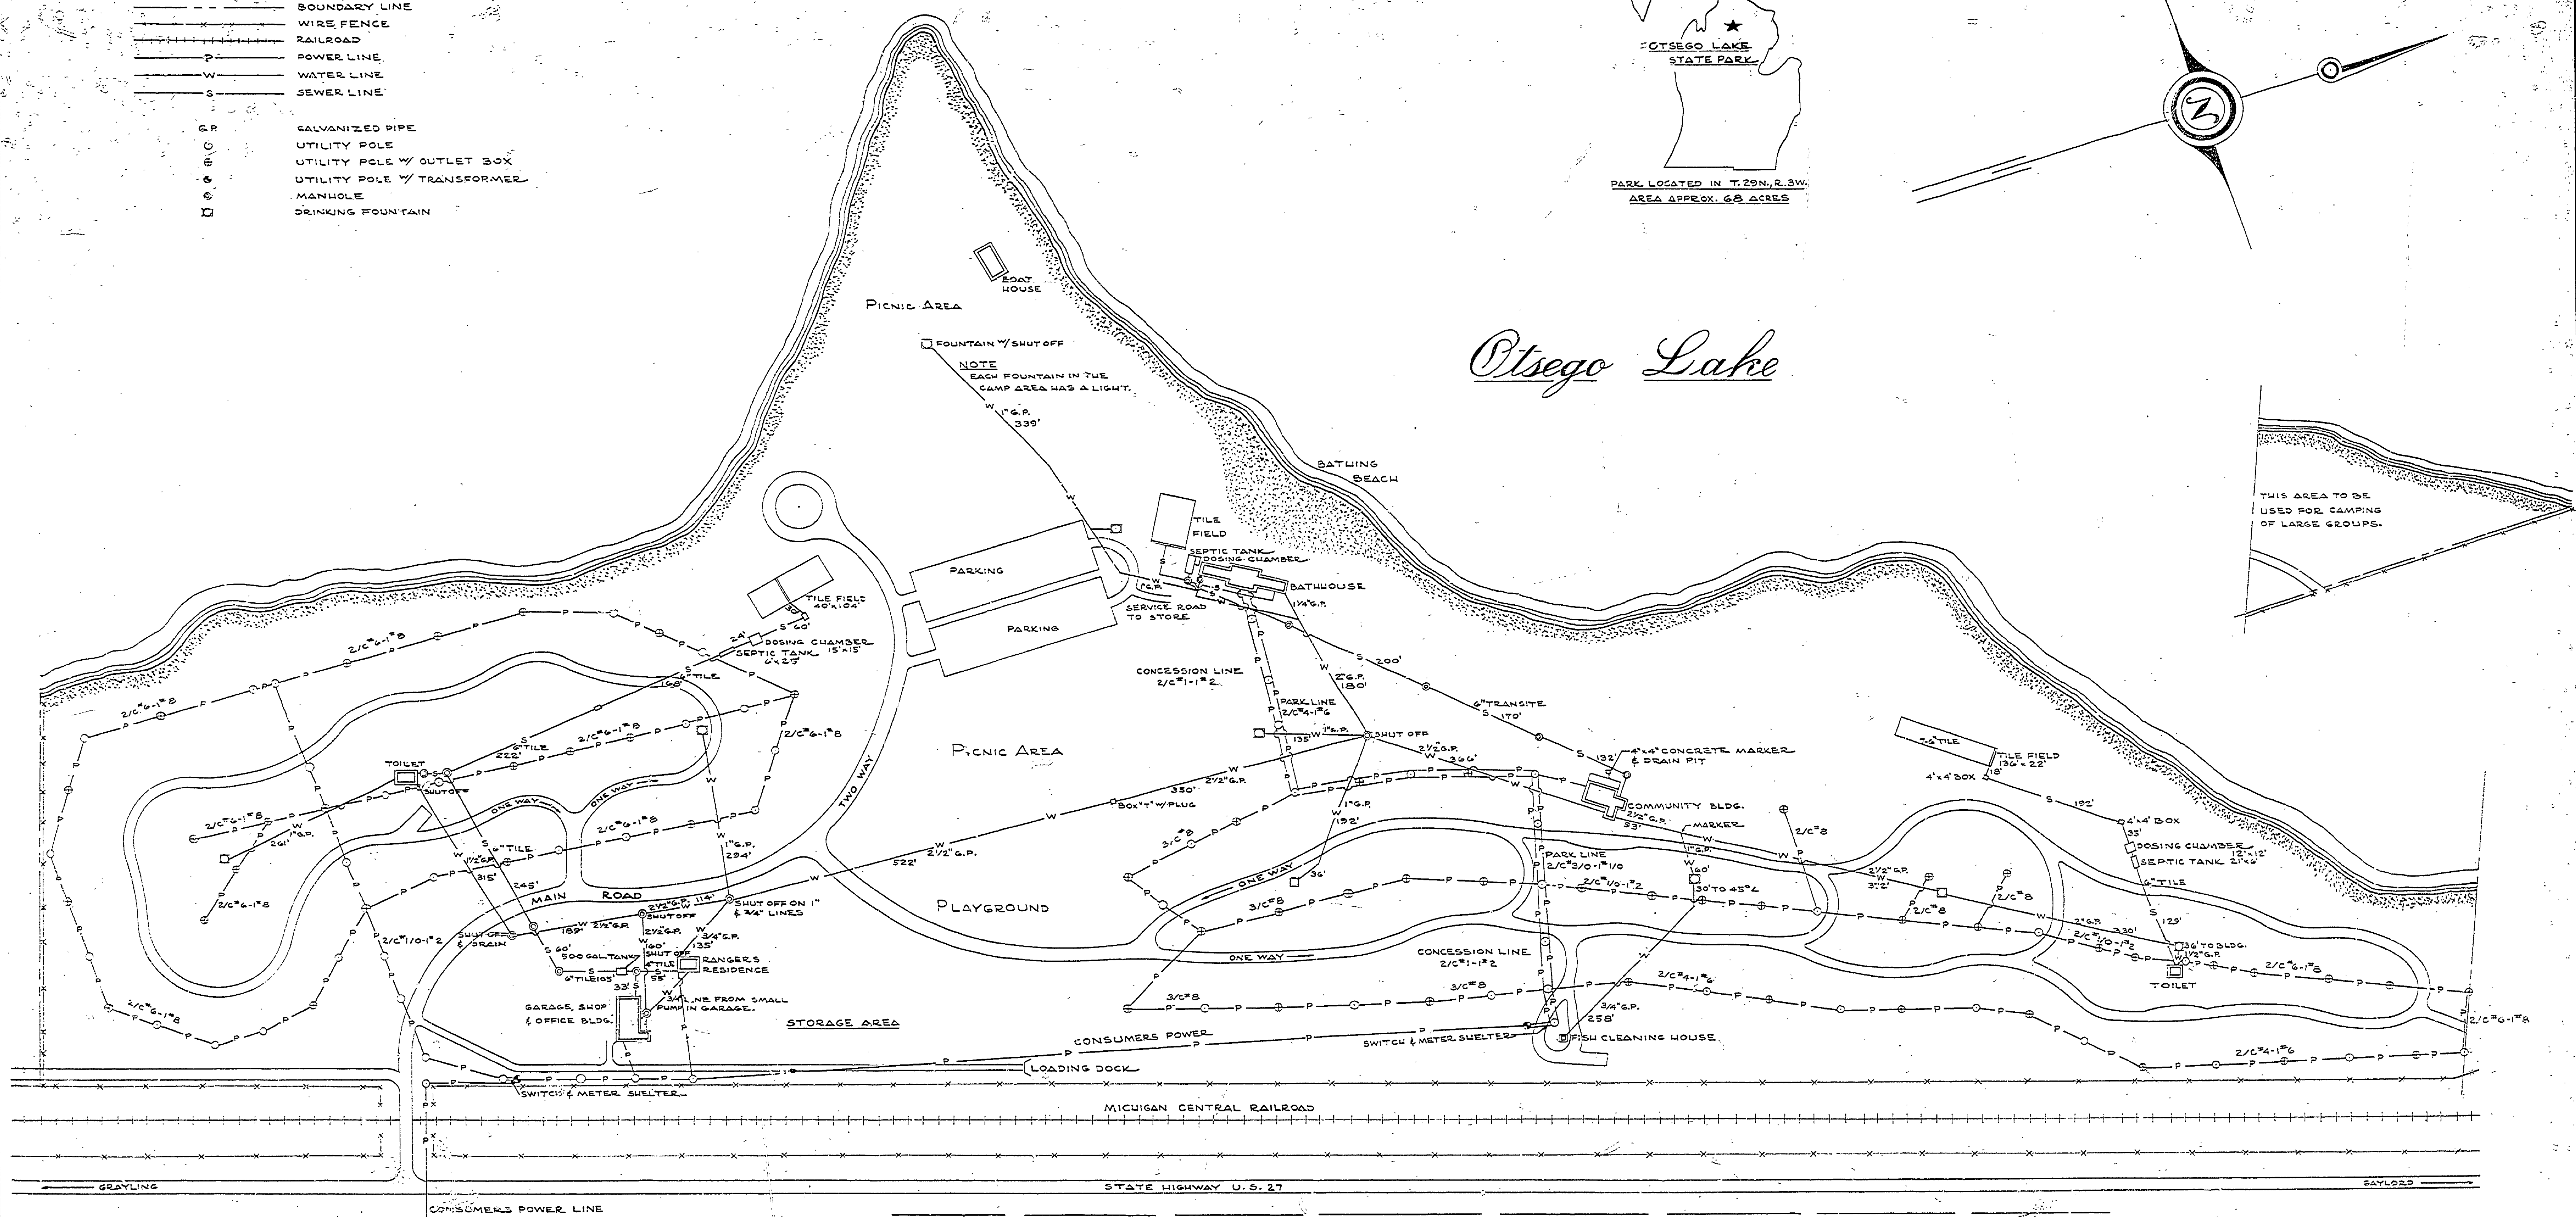

THIS AREA TO BE USED FOR CAMPING OF LARGE GROUPS.

THIS AREA NOT PROPOSED FOR DEVELOPMENT.

