COMMERCIAL BLUEPRINT SERVICE 800 11-67-

N

PLAN SCALE: 1"=50'-0"

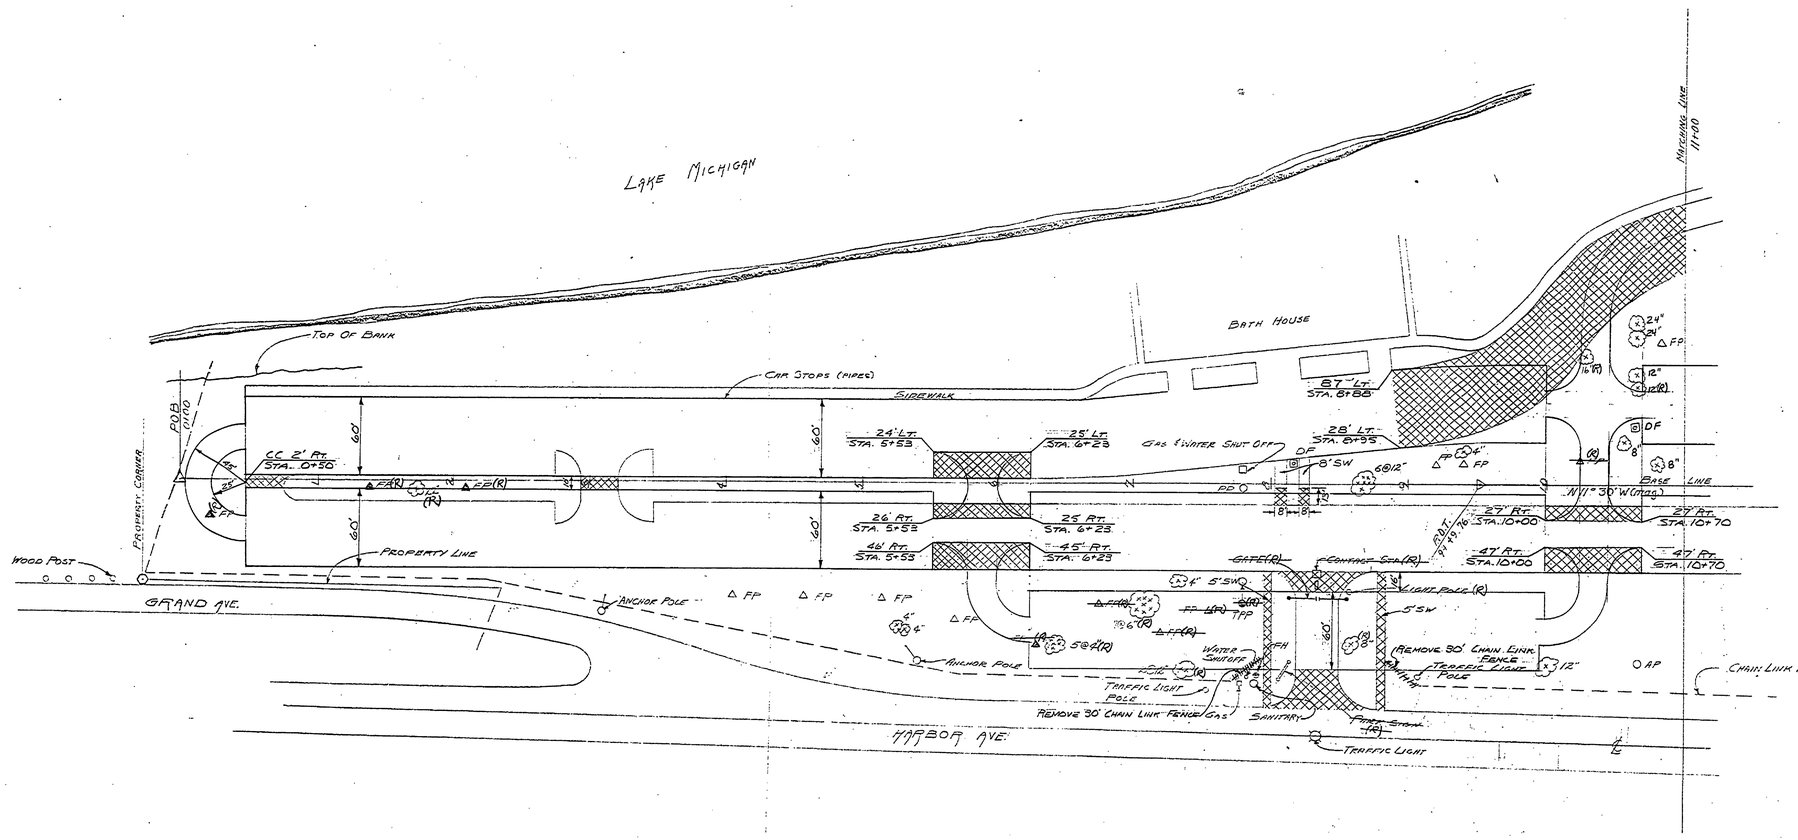

REMOVAL ITEMS THIS SHEET		
Pavement Removal	2620 yd²	#
Tree Removal 6"-12"	11 Ea.	
" " 13" and over	2 Ea.	
Fence Removal	60 lin. ft.	
~~Fire Place Removal~~	~~0 Ea.~~	N.I.C.
~~Park Sign Removal~~	~~1 Ea.~~	N.I.C.
Light Pole Removal	1 Ea.	
~~Contact Station Removal~~	~~1 Ea.~~	N.I.C.
~~Entrance Gate Removal~~	~~1 Ea.~~	N.I.C.
~~Remove & Relocate Transform. Pole~~	~~1 Ea.~~	By Power Co.
Earth Excavation	3000 yd³	

This includes 5'x5' squares

PAVEMENT TO BE REMOVED
(X)(R) TREE REMOVAL
(R) FIRE PLACE REMOVAL
(R) DRINKING FOUNTAIN REMOVAL

SURVEYED BY		DRAWN BY Lee W. Smith		NO.	DATE	BY	REVISIONS	NO.	DATE	BY	REVISIONS	MICHIGAN DEPARTMENT OF CONSERVATION	REMOVAL
DESIGNED BY		CHECKED BY		1.				3.					
	DATE		DATE	2.				4.					

SHEET NO. 2 OF 7
FOR PROJECT NO. PR-110-75-2499-061-GG

GRAND HAVEN STATE PARK
SHEET 2 OF 7 PLAN NO. E-108