


REMOVAL ITEMS THIS SHEET

Pavement Removal	7768.10 [±]
Tree Removal 6"-12"	18 Ea.
Fence Removal	240 Lin. Ft.
Fire Place Removal	6 Ea.
Drinking Fountain, Remove & Replace	2 Ea.
Power Pole, Remove & Replace	1 Ea.
Remove & Replace 24' Gate	1 Ea.
Remove & Salvage Outlet Boxes	10 Ea.
Earth Excavation	5550 Cu. Yds.

* This includes 5'x5' squares

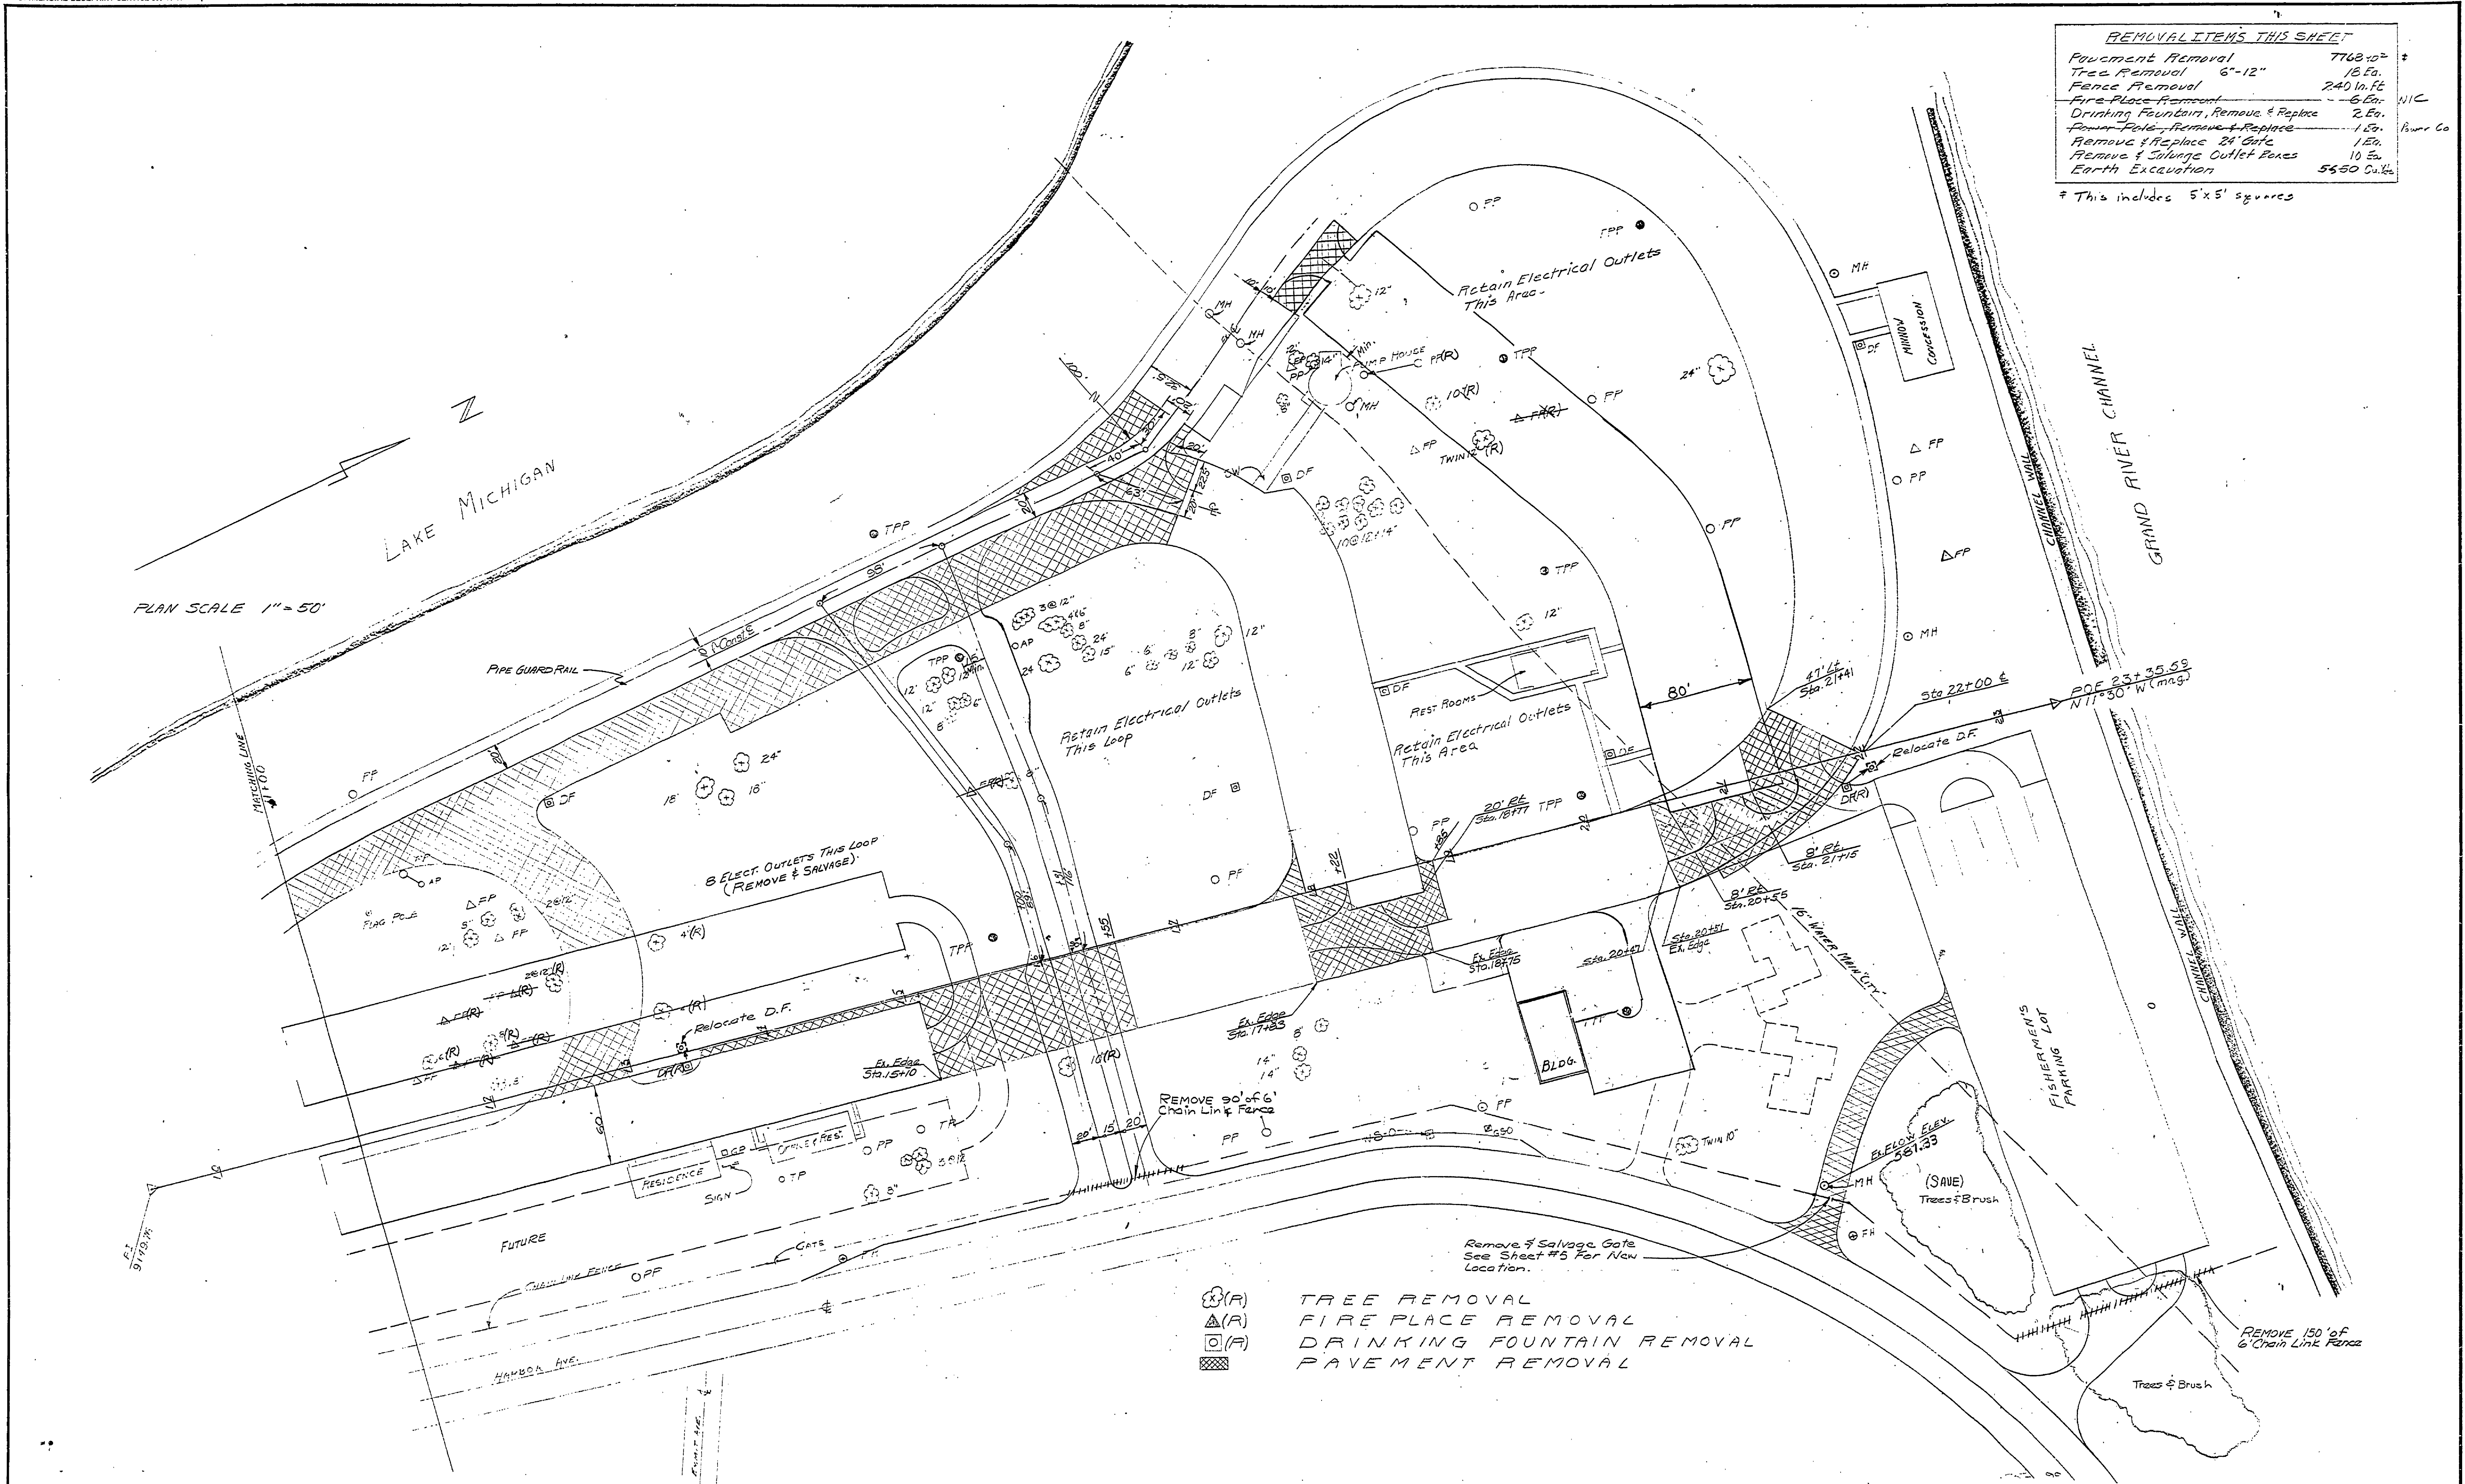

PLAN SCALE 1" = 50'

(X) (R) TREE REMOVAL
 (X) (A) FIRE PLACE REMOVAL
 (X) (D) DRINKING FOUNTAIN REMOVAL
 (X) (H) PAVEMENT REMOVAL

SURVEYED BY	DRAWN BY L.W. SMITH	NO. DATE BY REVISIONS	NO. DATE BY REVISIONS	MICHIGAN DEPARTMENT OF CONSERVATION	REMOVAL	SHEET NO. 3 OF 7	GRAND HAVEN STATE PARK
DESIGNED BY	CHECKED BY	1. 12-70 JHN Red Pk. Removal	3.			FOR PROJECT NO. PA-110-75-2429 04/CA	SHEET 3 OF 7 PLAN NO. E-108
DATE	DATE	2. 5-1-70 G/M REVISED PARKING & BLDG. SITE	4.				