


DESIGNED BY	DATE	REVIEWED	DATE	APPROVED	DATE	NO.	DATE	BY	REVISIONS	DATE	BY
DRAWN BY	5-3	ARCHITECTURAL				1			4		
CHECKED BY		ENGINEERING				2			5		
		LANDSCAPE				3			6		



LAKE MICHIGAN

GRAND RIVER CHANNEL

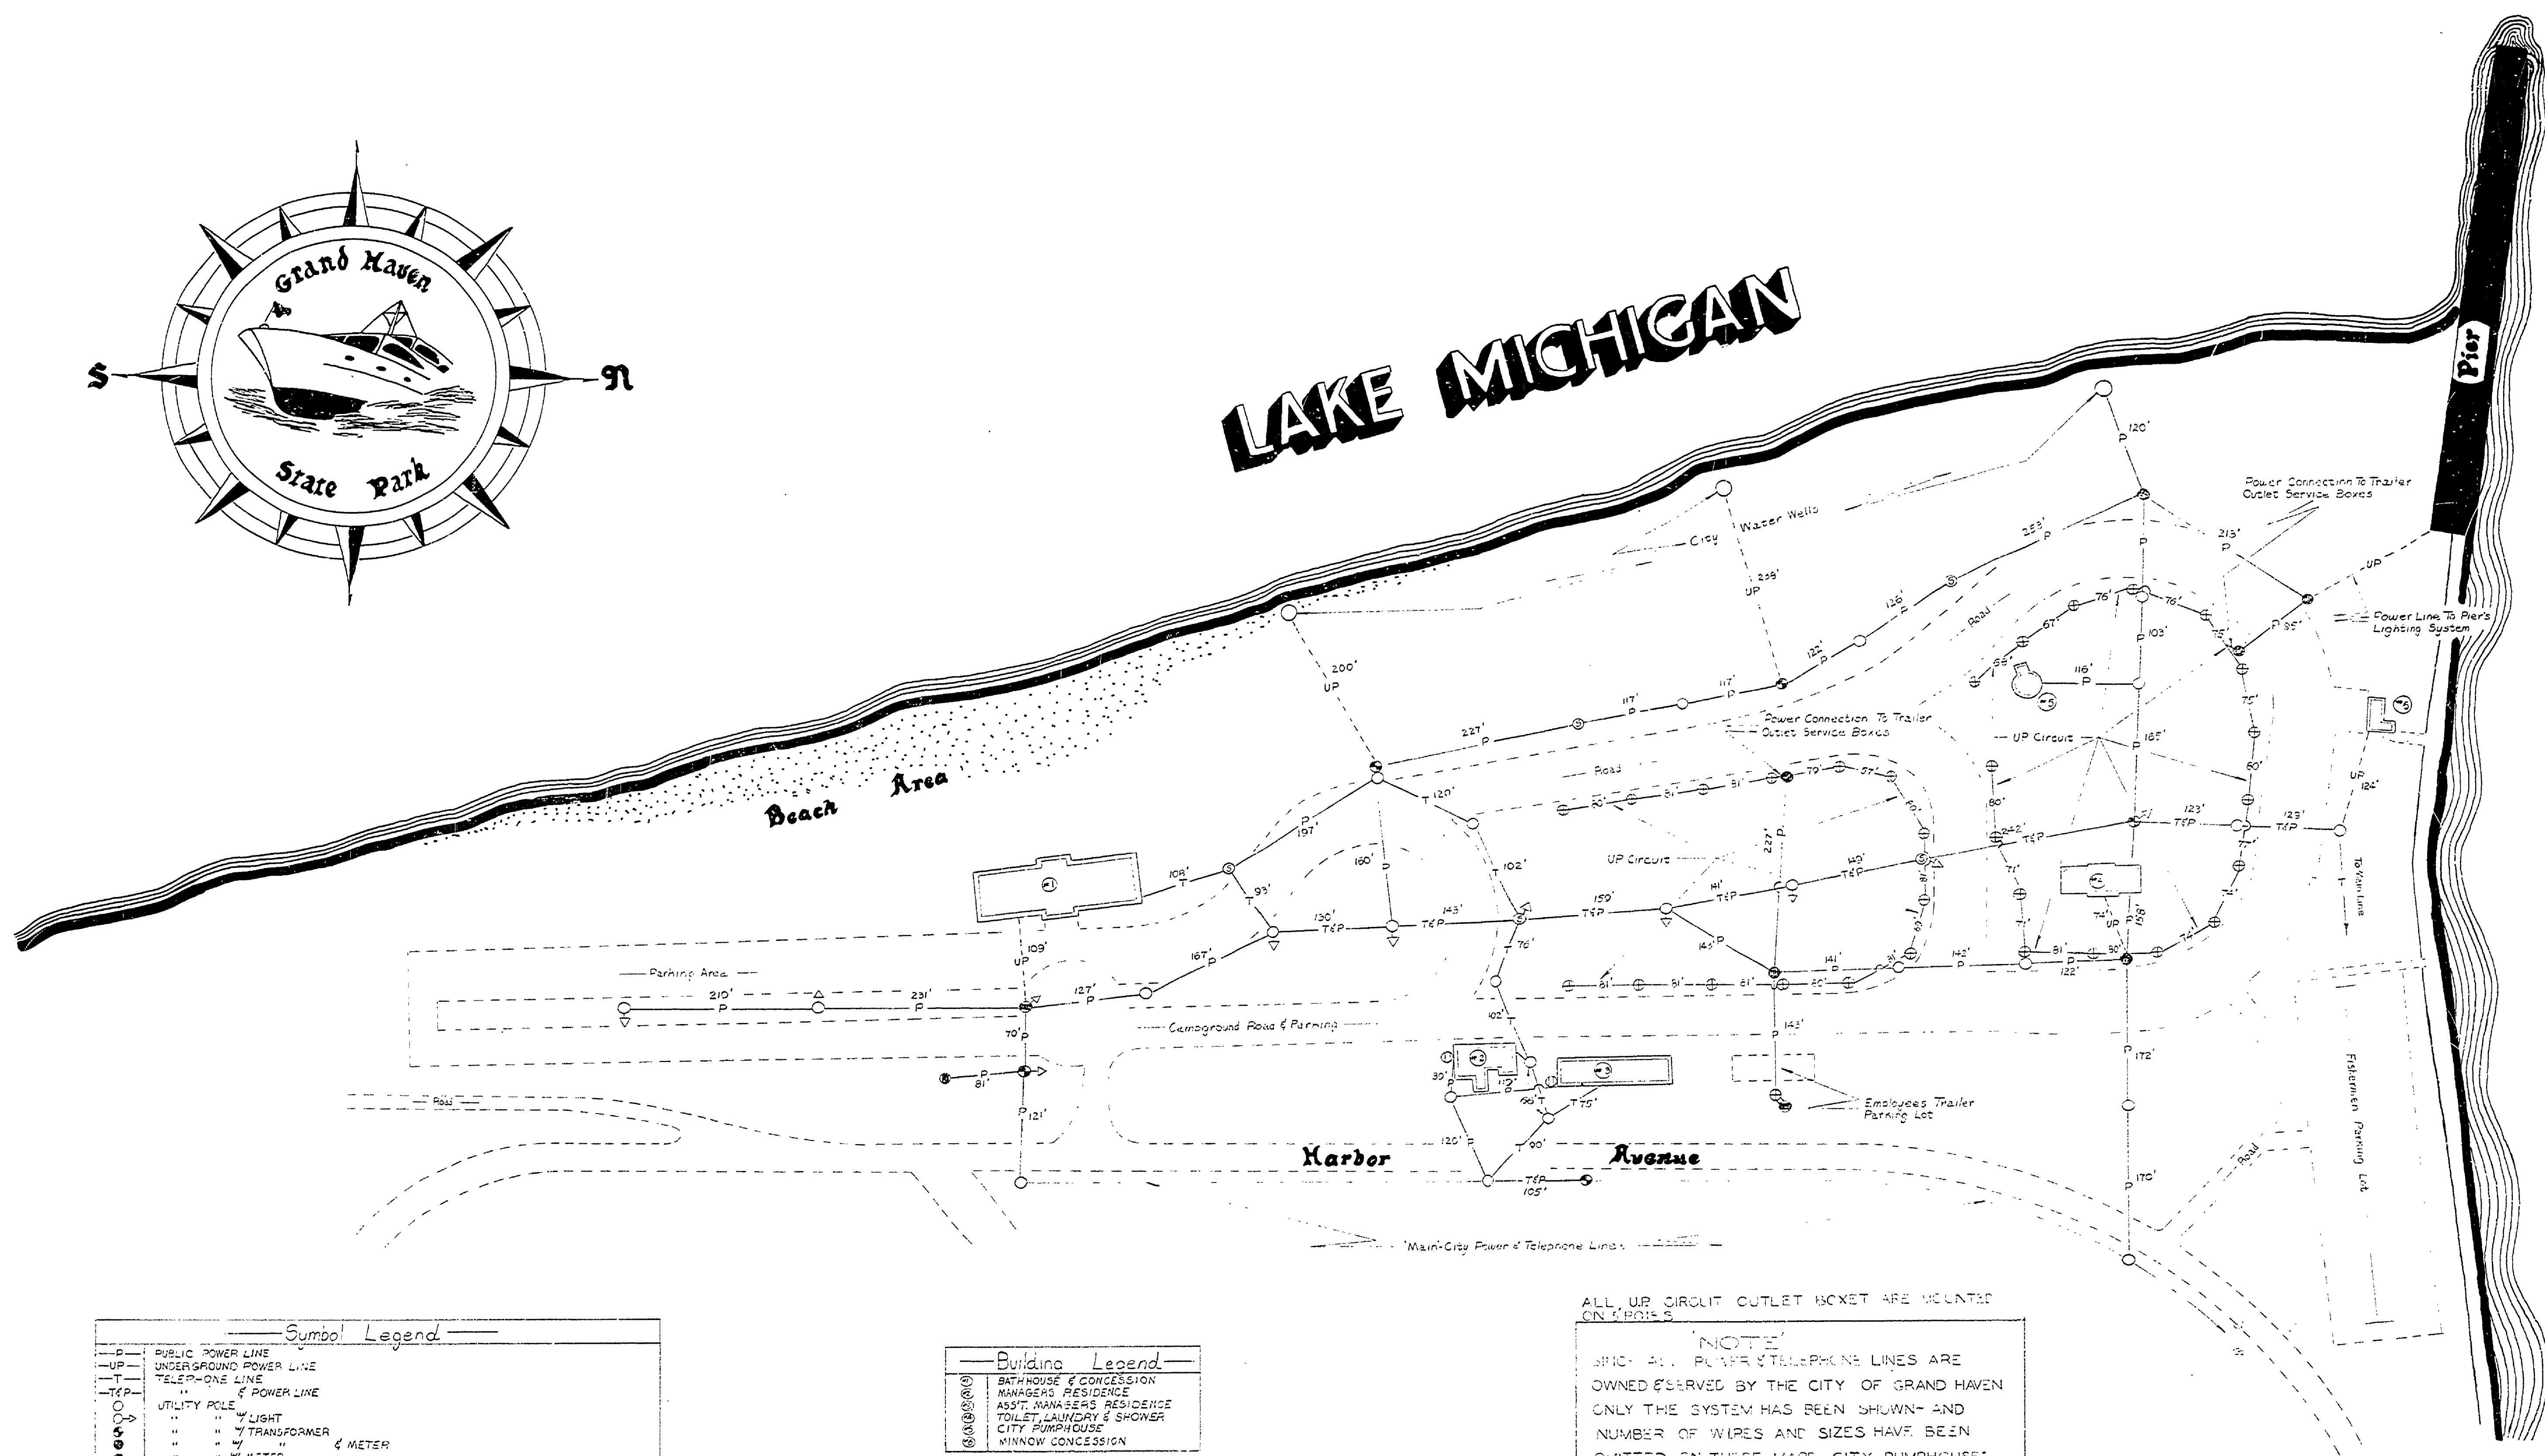

Symbol Legend

—	PUBLIC POWER LINE
-UP-	UNDERGROUND POWER LINE
-T-	TELEPHONE LINE
-T-P-	TELEPHONE & POWER LINE
○	UTILITY POLE
○	LIGHT
○	TRANSFORMER
○	METER & SWITCH
○	METER
○	OUTLET BOX
○	METER & SWITCH
○	SPEAKER
○	OUTLET BOX, METER & SWITCH
○	ELECTRIC METER

Building Legend

⊙	BATHHOUSE & CONCESSION
⊙	MANAGER'S RESIDENCE
⊙	ASST. MANAGER'S RESIDENCE
⊙	TOILET, LAUNDRY & SHOWER
⊙	CITY PUMPHOUSE
⊙	MINNOW CONCESSION

NOTE: ALL U.P. CIRCUIT OUTLET BOXES ARE MOUNTED ON PIPES.

NOTE: SINCE ALL POWER & TELEPHONE LINES ARE OWNED & SERVED BY THE CITY OF GRAND HAVEN ONLY THE SYSTEM HAS BEEN SHOWN- AND NUMBER OF WIRES AND SIZES HAVE BEEN OMITTED ON THESE MAPS. CITY PUMPHOUSE, POWER & PUMPS INSTALLED, OWNED AND MAINTAINED BY THE CITY OF GRAND HAVEN.

GRAND HAVEN STATE PARK

SCALE: 1"=100'

MICHIGAN DEPARTMENT OF CONSERVATION PARKS AND RECREATION DIVISION

GRAND HAVEN STATE PARK UTILITY MAP ELECTRICAL DISTRIBUTION SYSTEM

SHEET NO. 1 OF 3

PLAN NO. U-1