R-1638 COMMERCIAL BLUEPRINT SERVICE 5-69

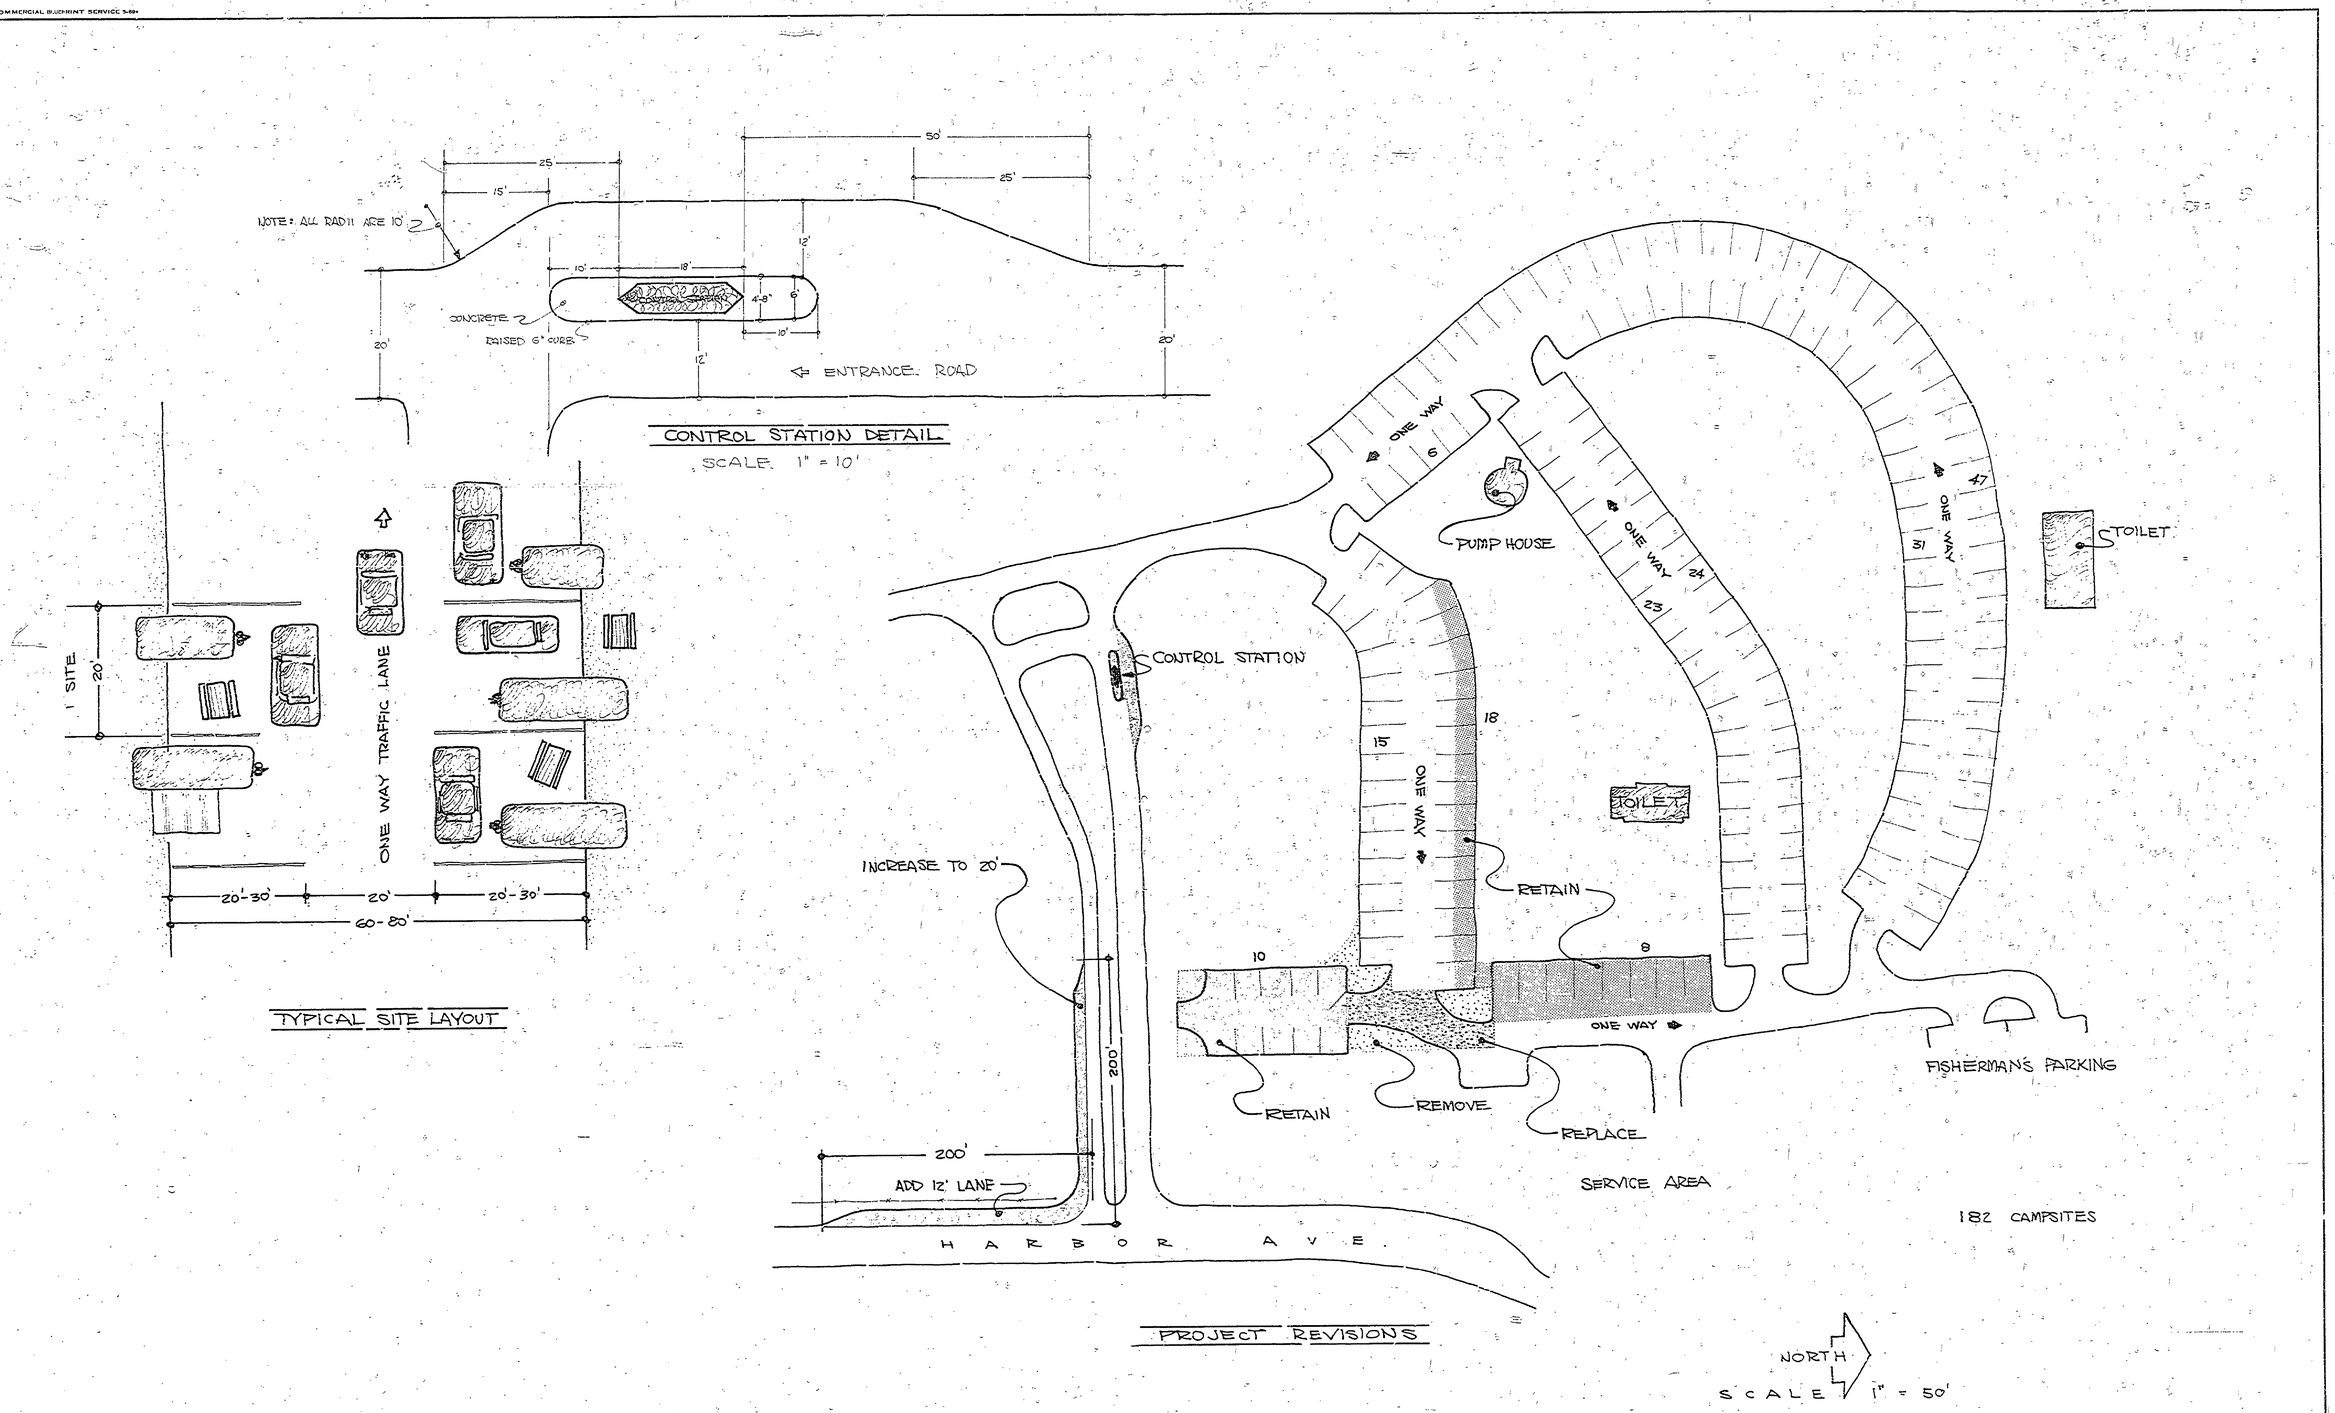

SURVEYED BY		DRAWN BY KESSLER	12/69	NO.	DATE	BY	REVISIONS	NO.	DATE	BY	REVISIONS	MICHIGAN DEPARTMENT OF NATURAL RESOURCES	GRAND HAVEN STATE PARK	AREA OR PARK	PROJECT NO. PROJECT REVISIONS
DESIGNED BY KESSLER	12/69	CHECKED BY		1.	1/29/70	HELMIC	CONTROL STATION & ENTRANCE PULL OFF	3.					SHEET TITLE	PROJECT	SHEET ___ OF ___ PLAN NO.
	DATE		DATE	2.				4.							